


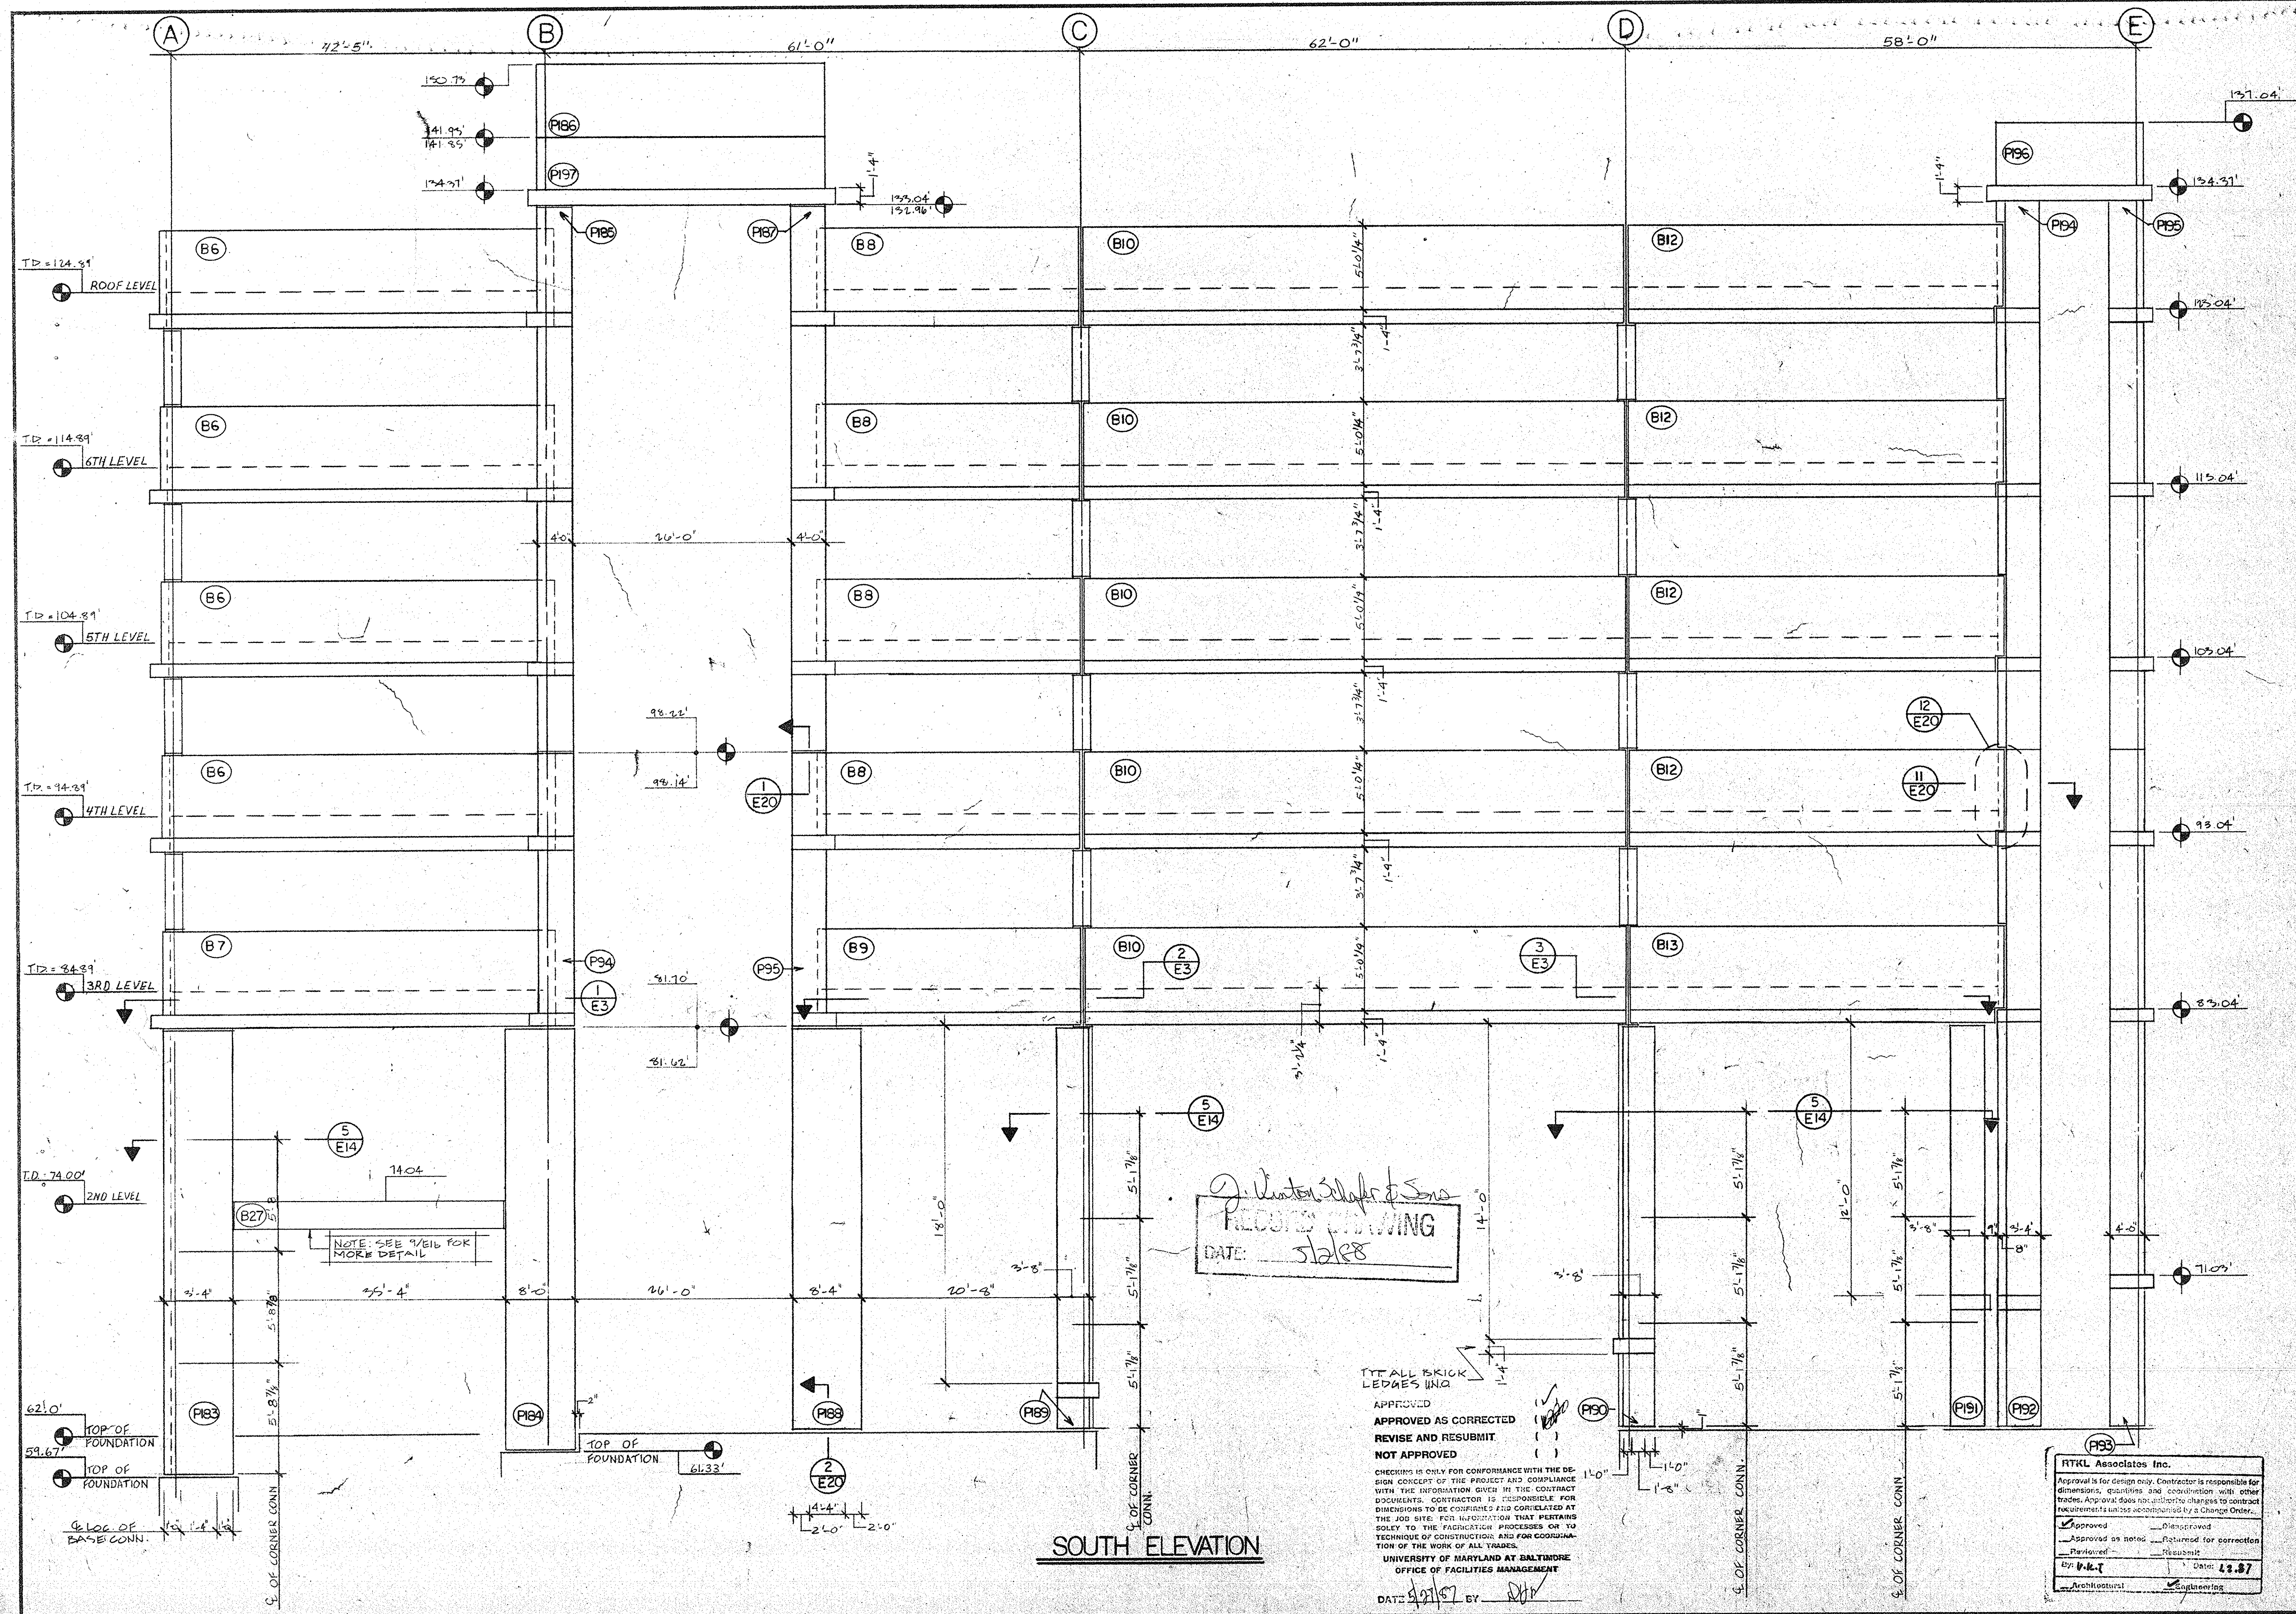

SOUTH ELEVATION

APPROVED
 APPROVED AS CORRECTED
 REVISE AND RESUBMIT.
 NOT APPROVED

CHECKS ARE ONLY FOR CONFORMANCE WITH THE DESIGN CONCEPT OF THE PROJECT AND COMPLIANCE WITH THE INFORMATION GIVEN IN THE CONTRACT DOCUMENTS. CONTRACTOR IS RESPONSIBLE FOR DIMENSIONS TO BE CORRECTED AND CORRELATED AT THE JOB SITE. FOR INFORMATION THAT PERTAINS SOLELY TO THE FABRICATOR'S PROCESS OR TO THE TECHNIQUE OF CONSTRUCTION, AND FOR COORDINATION OF THE WORK OF ALL TRADES.







UNIVERSITY OF MARYLAND AT BALTIMORE
 OFFICE OF FACILITIES MANAGEMENT

DATE: 4/27/87 BY: [Signature]

RTKL Associates Inc.
 Approval is for design only. Contractor is responsible for dimensions, quantities and coordination with other trades. Approval does not constitute changes to contract requirements unless accompanied by a Change Order.

Approved: [Signature] Date: 4.8.87
 Prepared: [Signature]
 Checked: [Signature]
 Drawn: [Signature]

PROJECT: PEARL STREET GARAGE BALTIMORE, MARYLAND		 CONCRETE BUILDING SYSTEMS 10000 WILLOW AVE. BALTIMORE, MD 21206-3646
GENERAL CONTRACTOR: ON SCHAFFERSONS DRAWING TITLE: SOUTH ELEVATION		
DRAWN: 8-8-86 BY: [Signature]	CHECKED: 8-15-86 BY: [Signature]	REVISIONS 1. 11/4/86 8-1/2" x 11-1/2" RESUBMITTED FOR APPROVAL 2. 11/4/86 8-1/2" x 11-1/2" RESUBMITTED FOR APPROVAL 3. 11/4/86 8-1/2" x 11-1/2" RESUBMITTED FOR APPROVAL 4. 11/4/86 8-1/2" x 11-1/2" RESUBMITTED FOR APPROVAL
PROJECT NO: 6003	DWG NO: E-12	

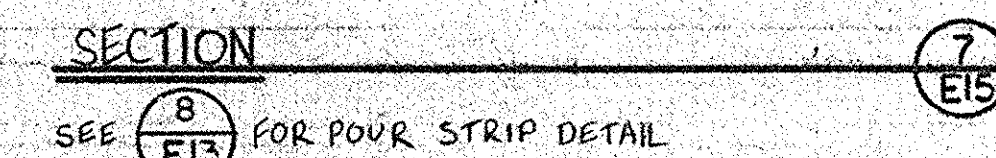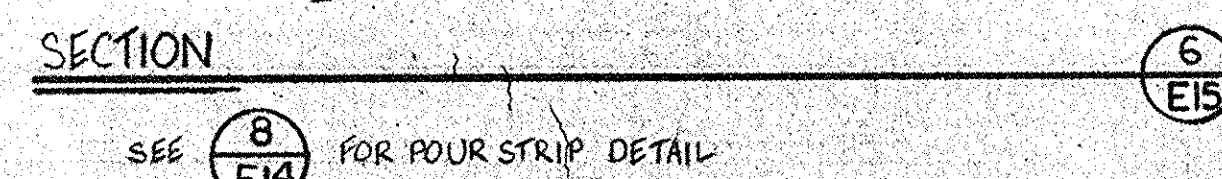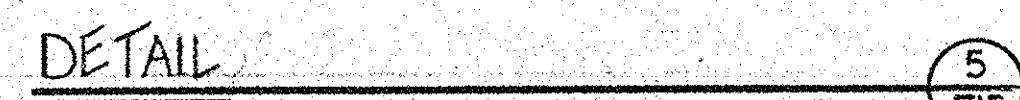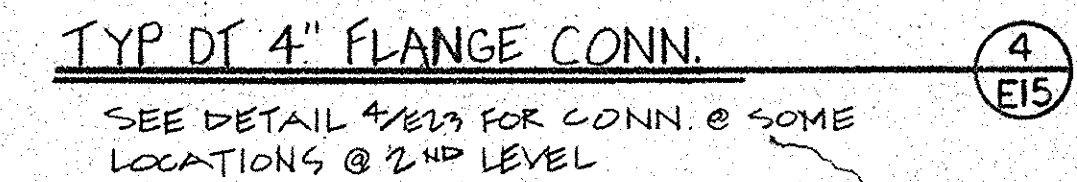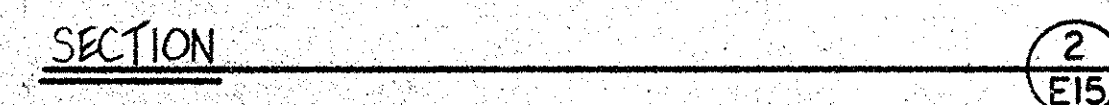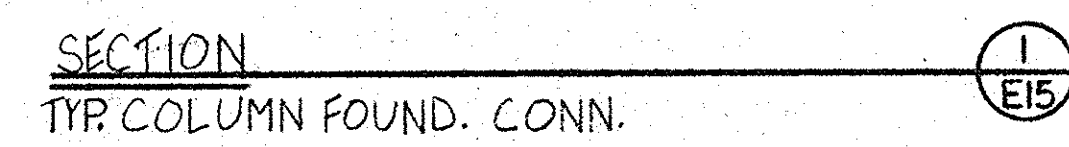

RTKL Associates Inc.

Approval is for design only. Contractor is responsible for dimensions, quantities, and coordination with trades. Approval does not authorize changes to requirements unless accompanied by a Change Order.

☒ Approved ☐ Disapproved













☐ Approved as noted ☐ Returned for _____

☐ Reviewed ☐ Rebuild

By: V.K.T. Date: _____

☐ Architectural ☒ Engineering

DRAWN:	
8-2-86	BY <u>WSE</u>
CHECKED:	
8-13-86	BY <u>GAH</u>
APPROVED:	
BY _____	
PROJECT NO.	
6003	
DWG. NO.	
<u>E-15</u>	

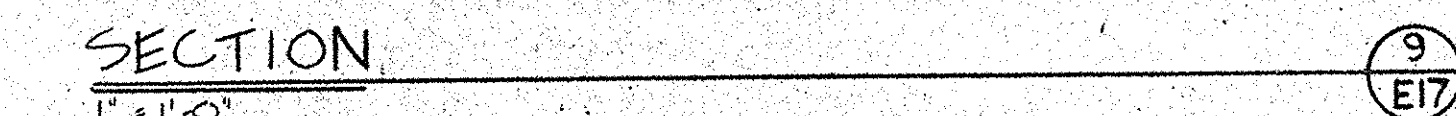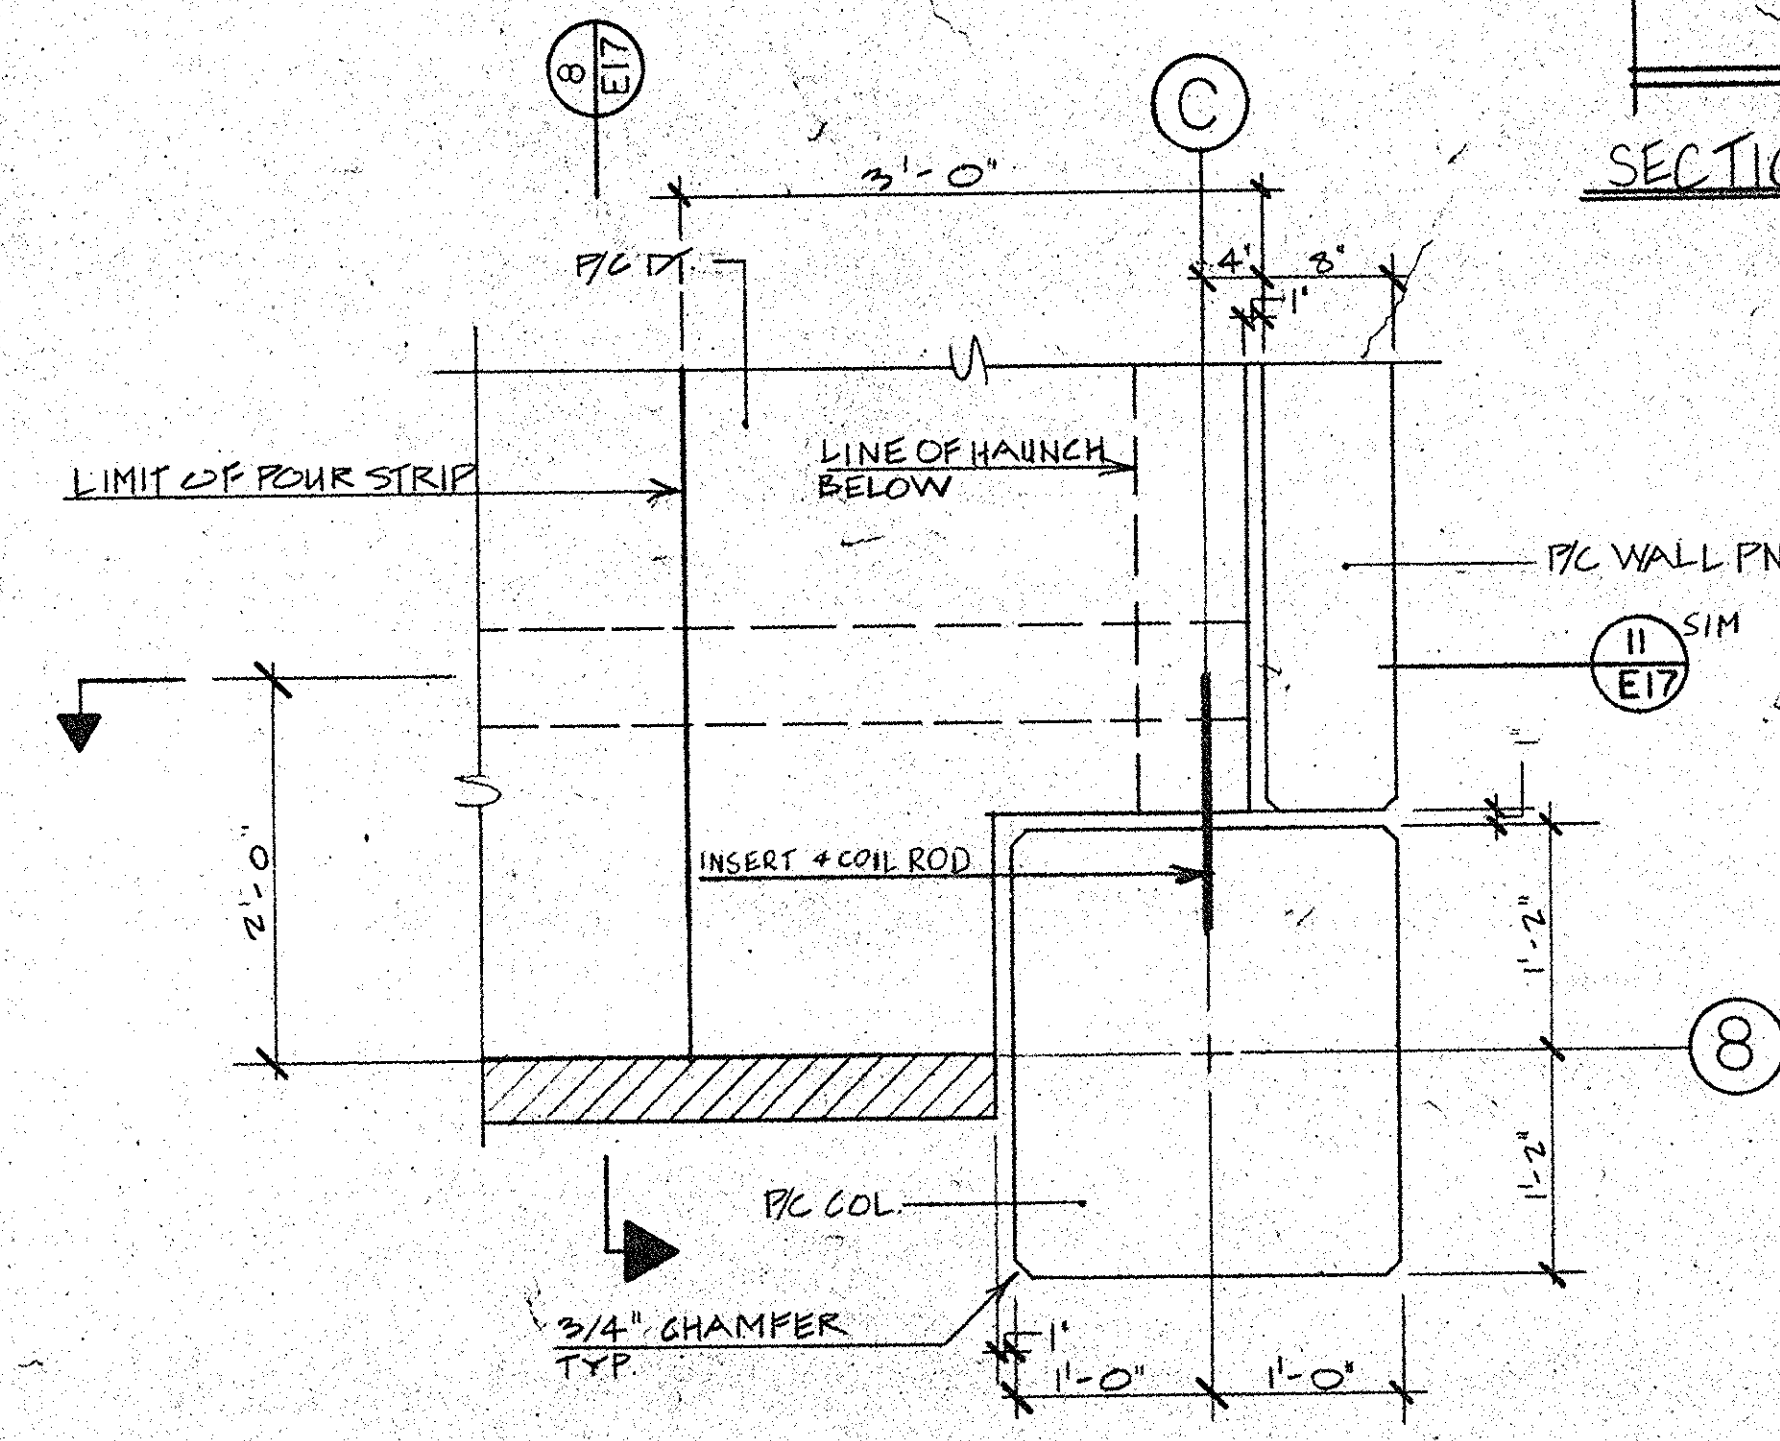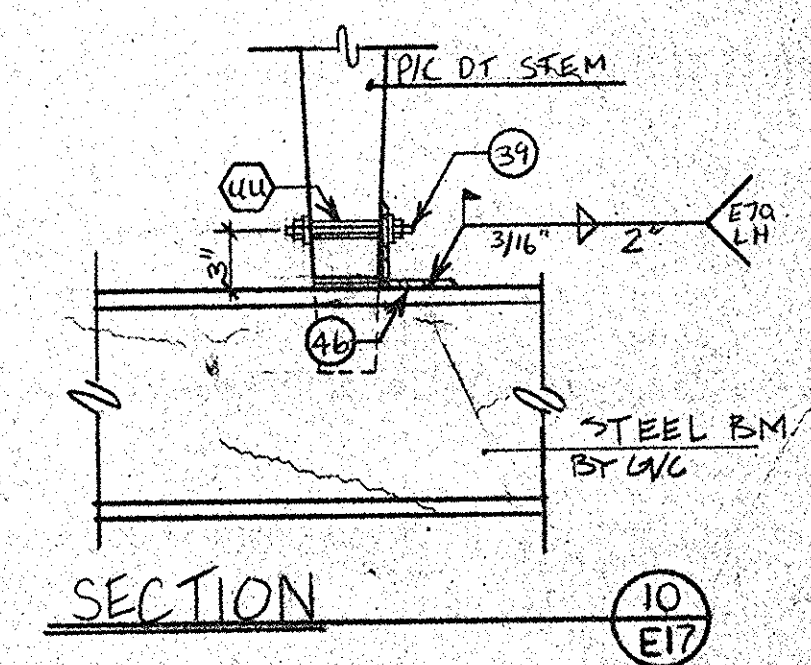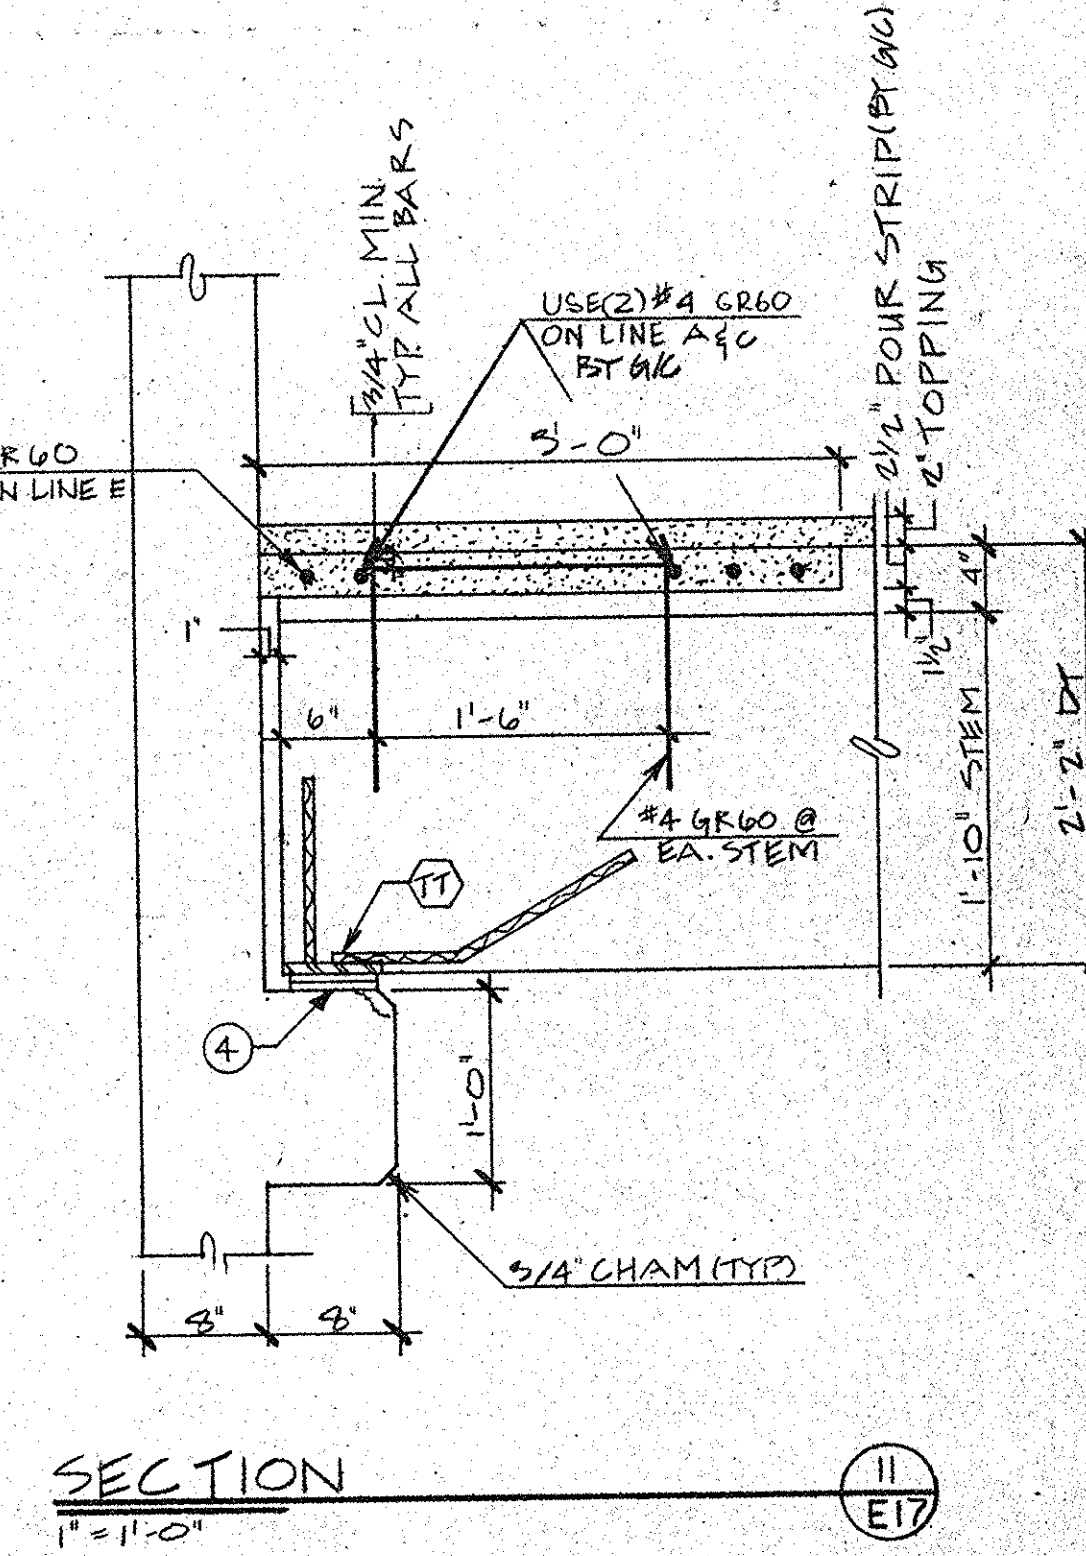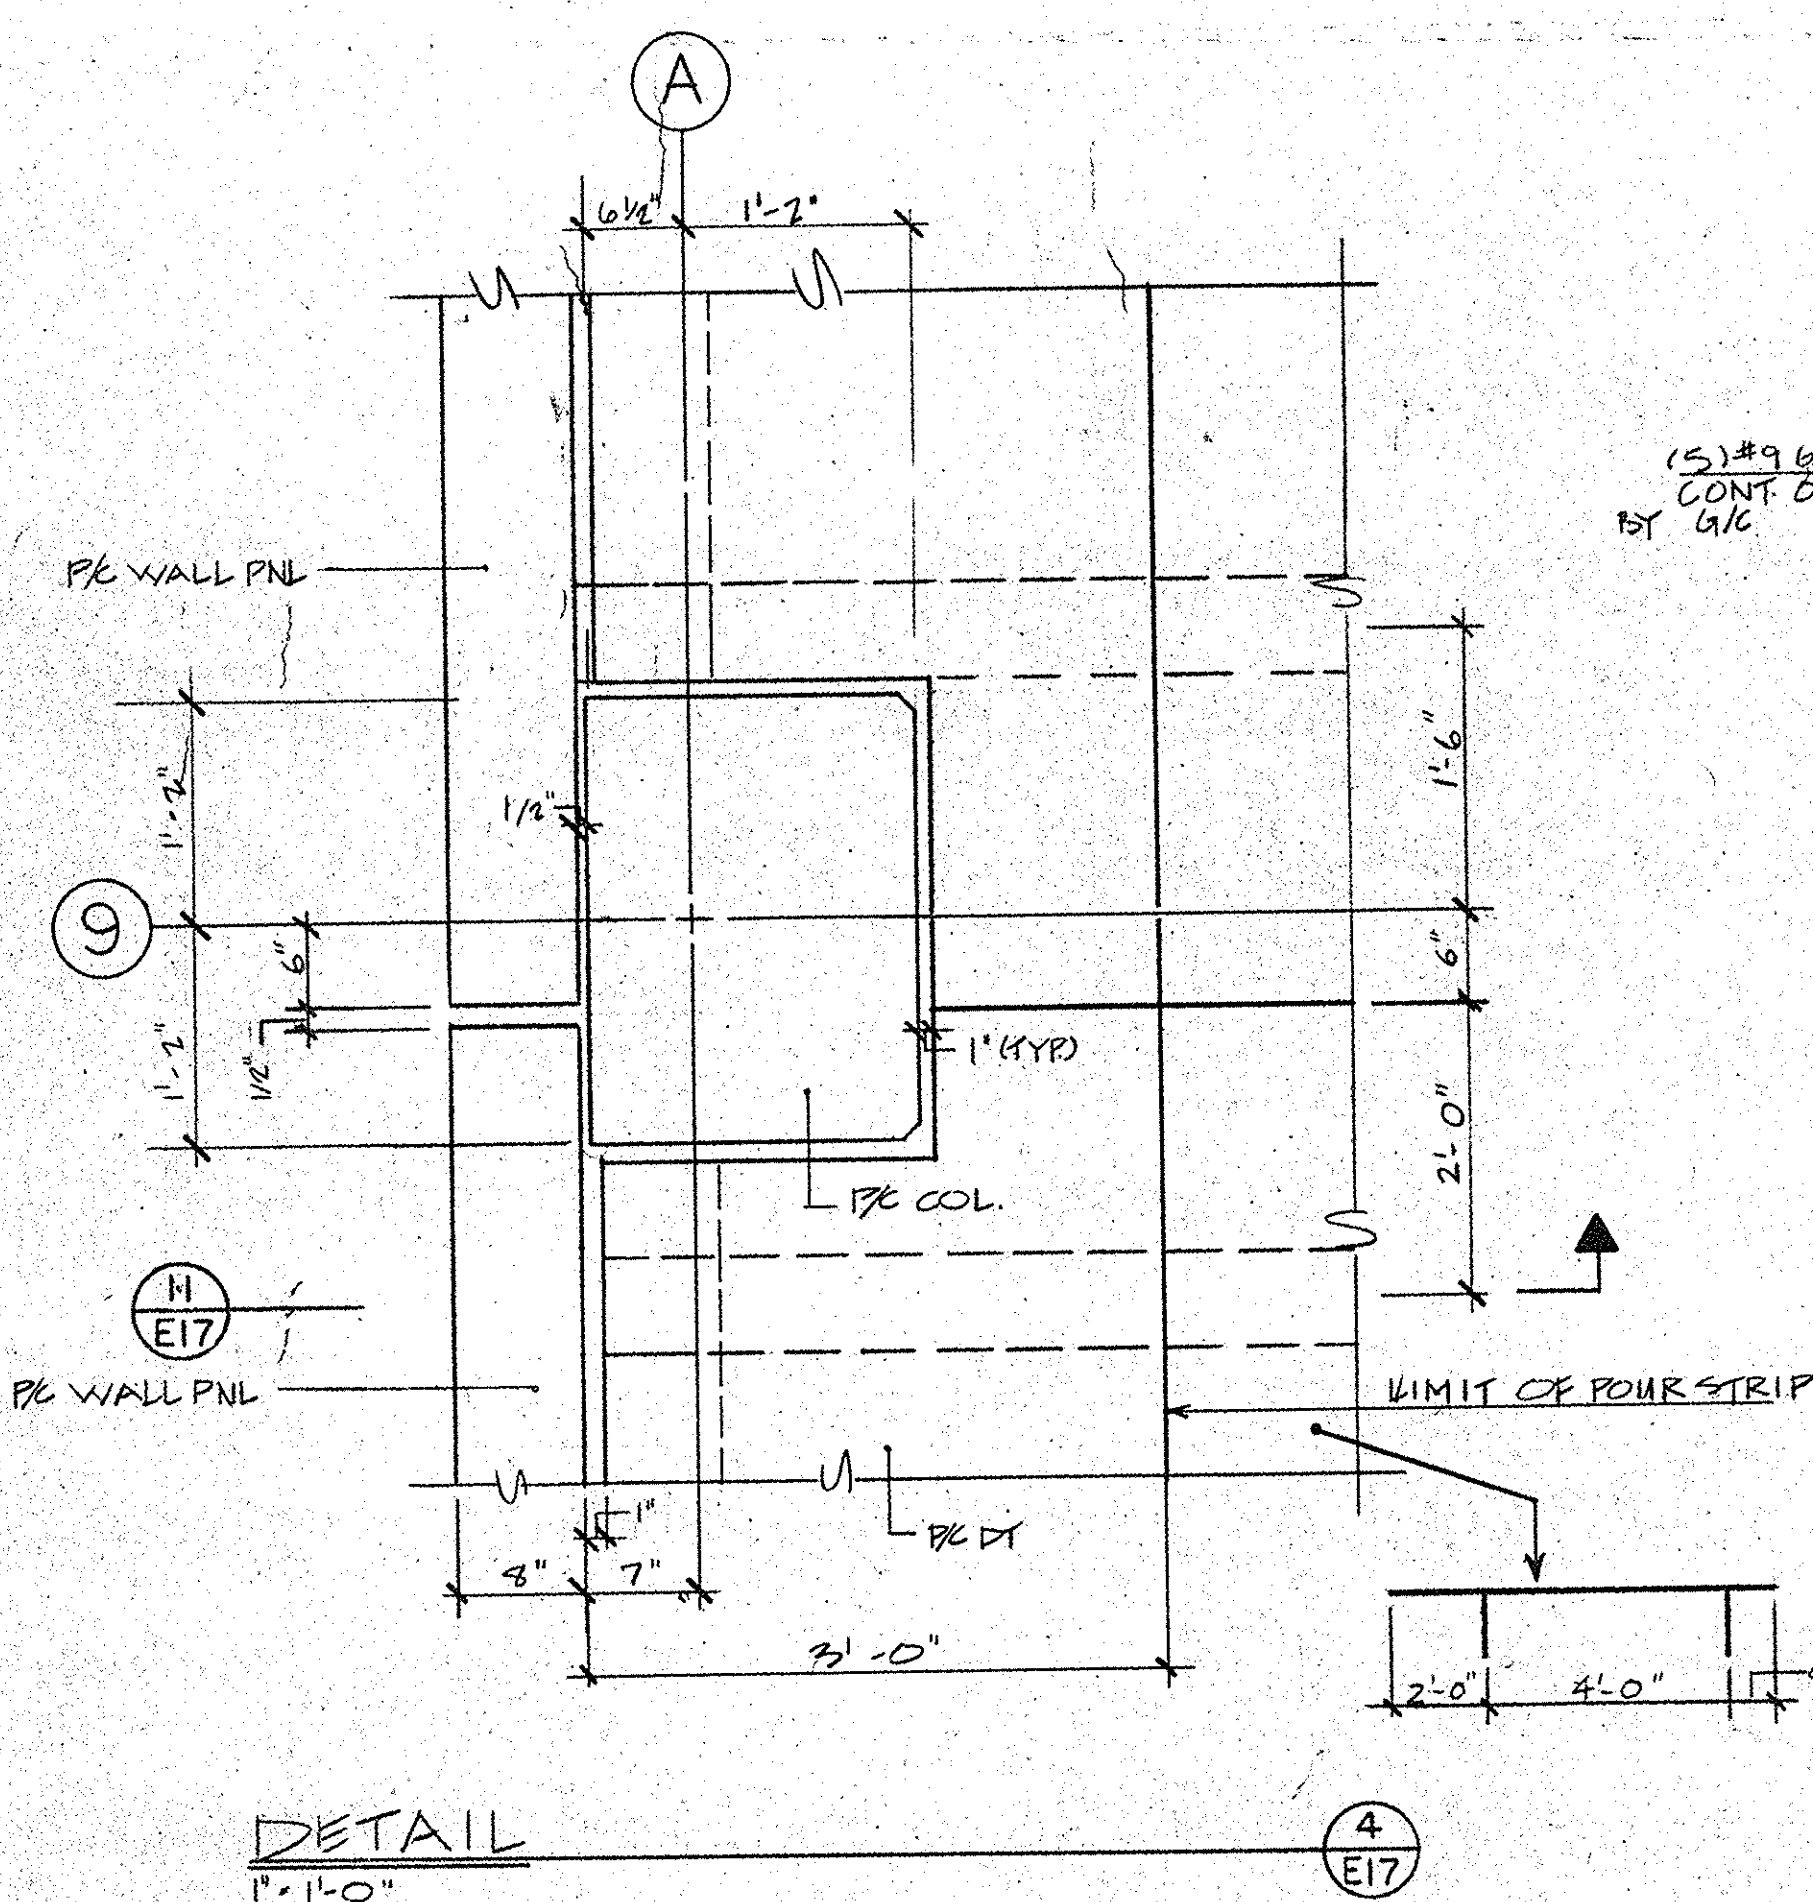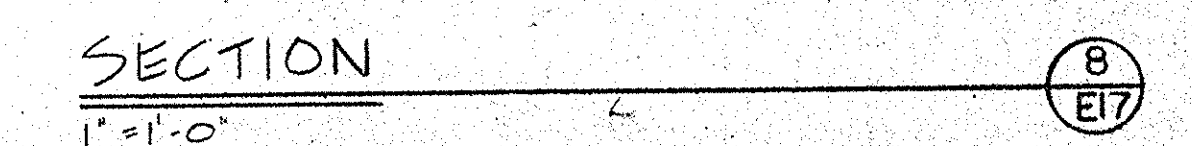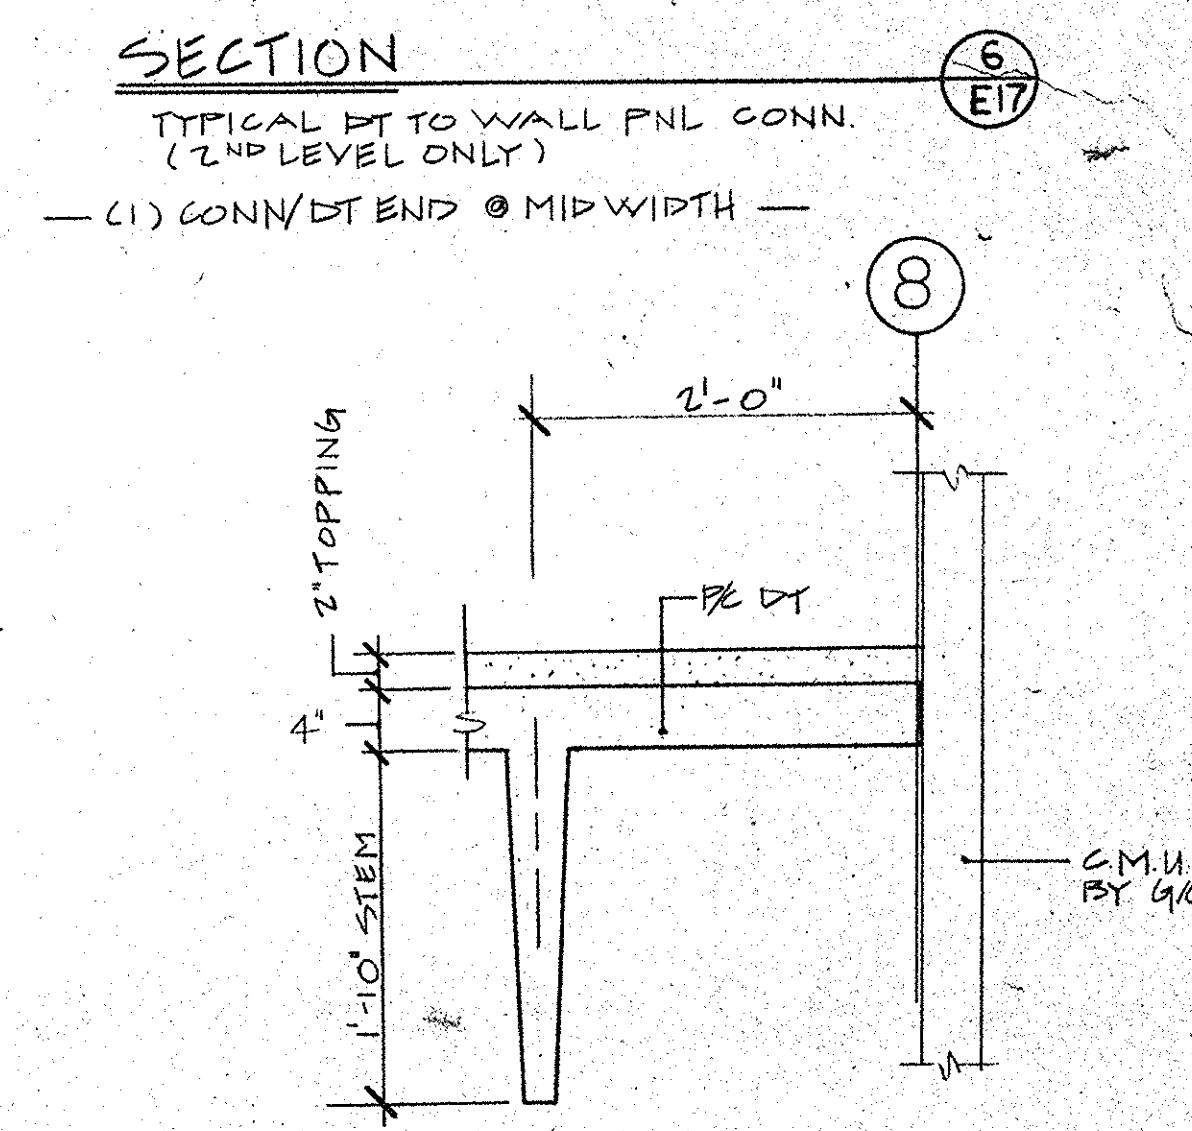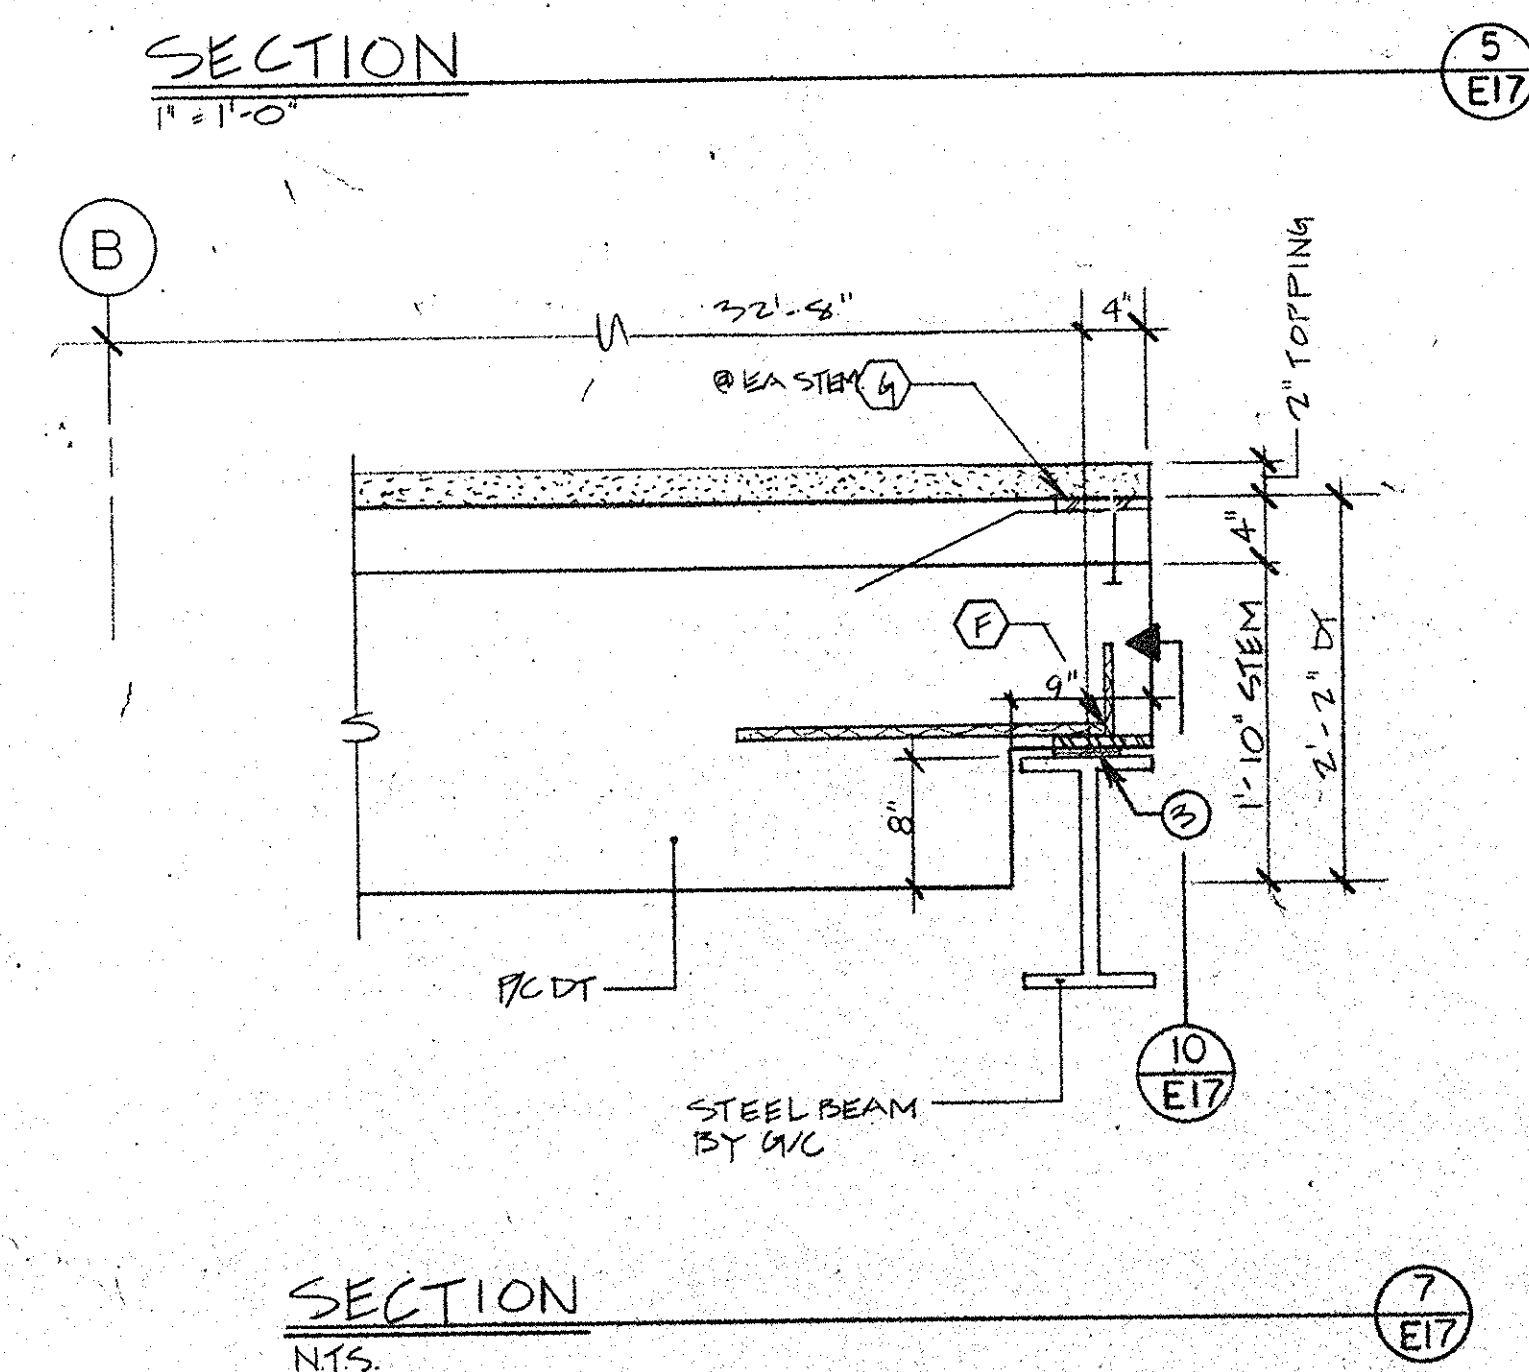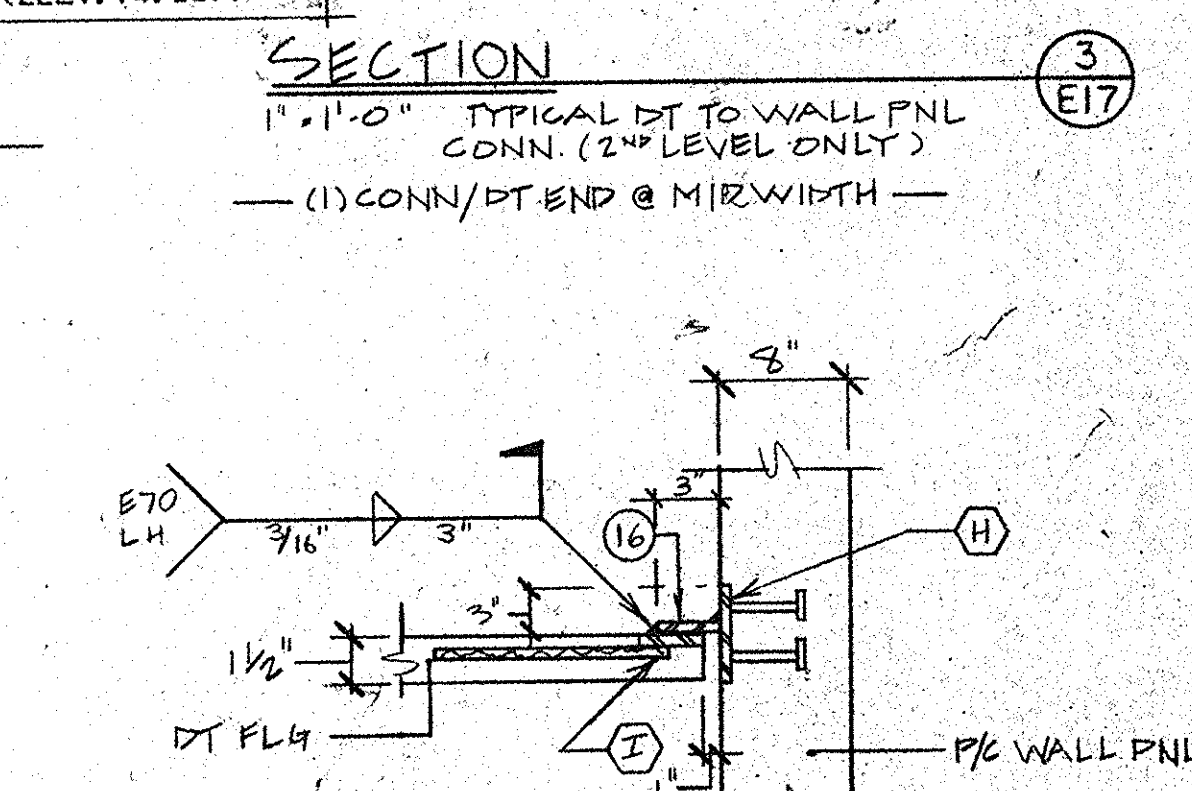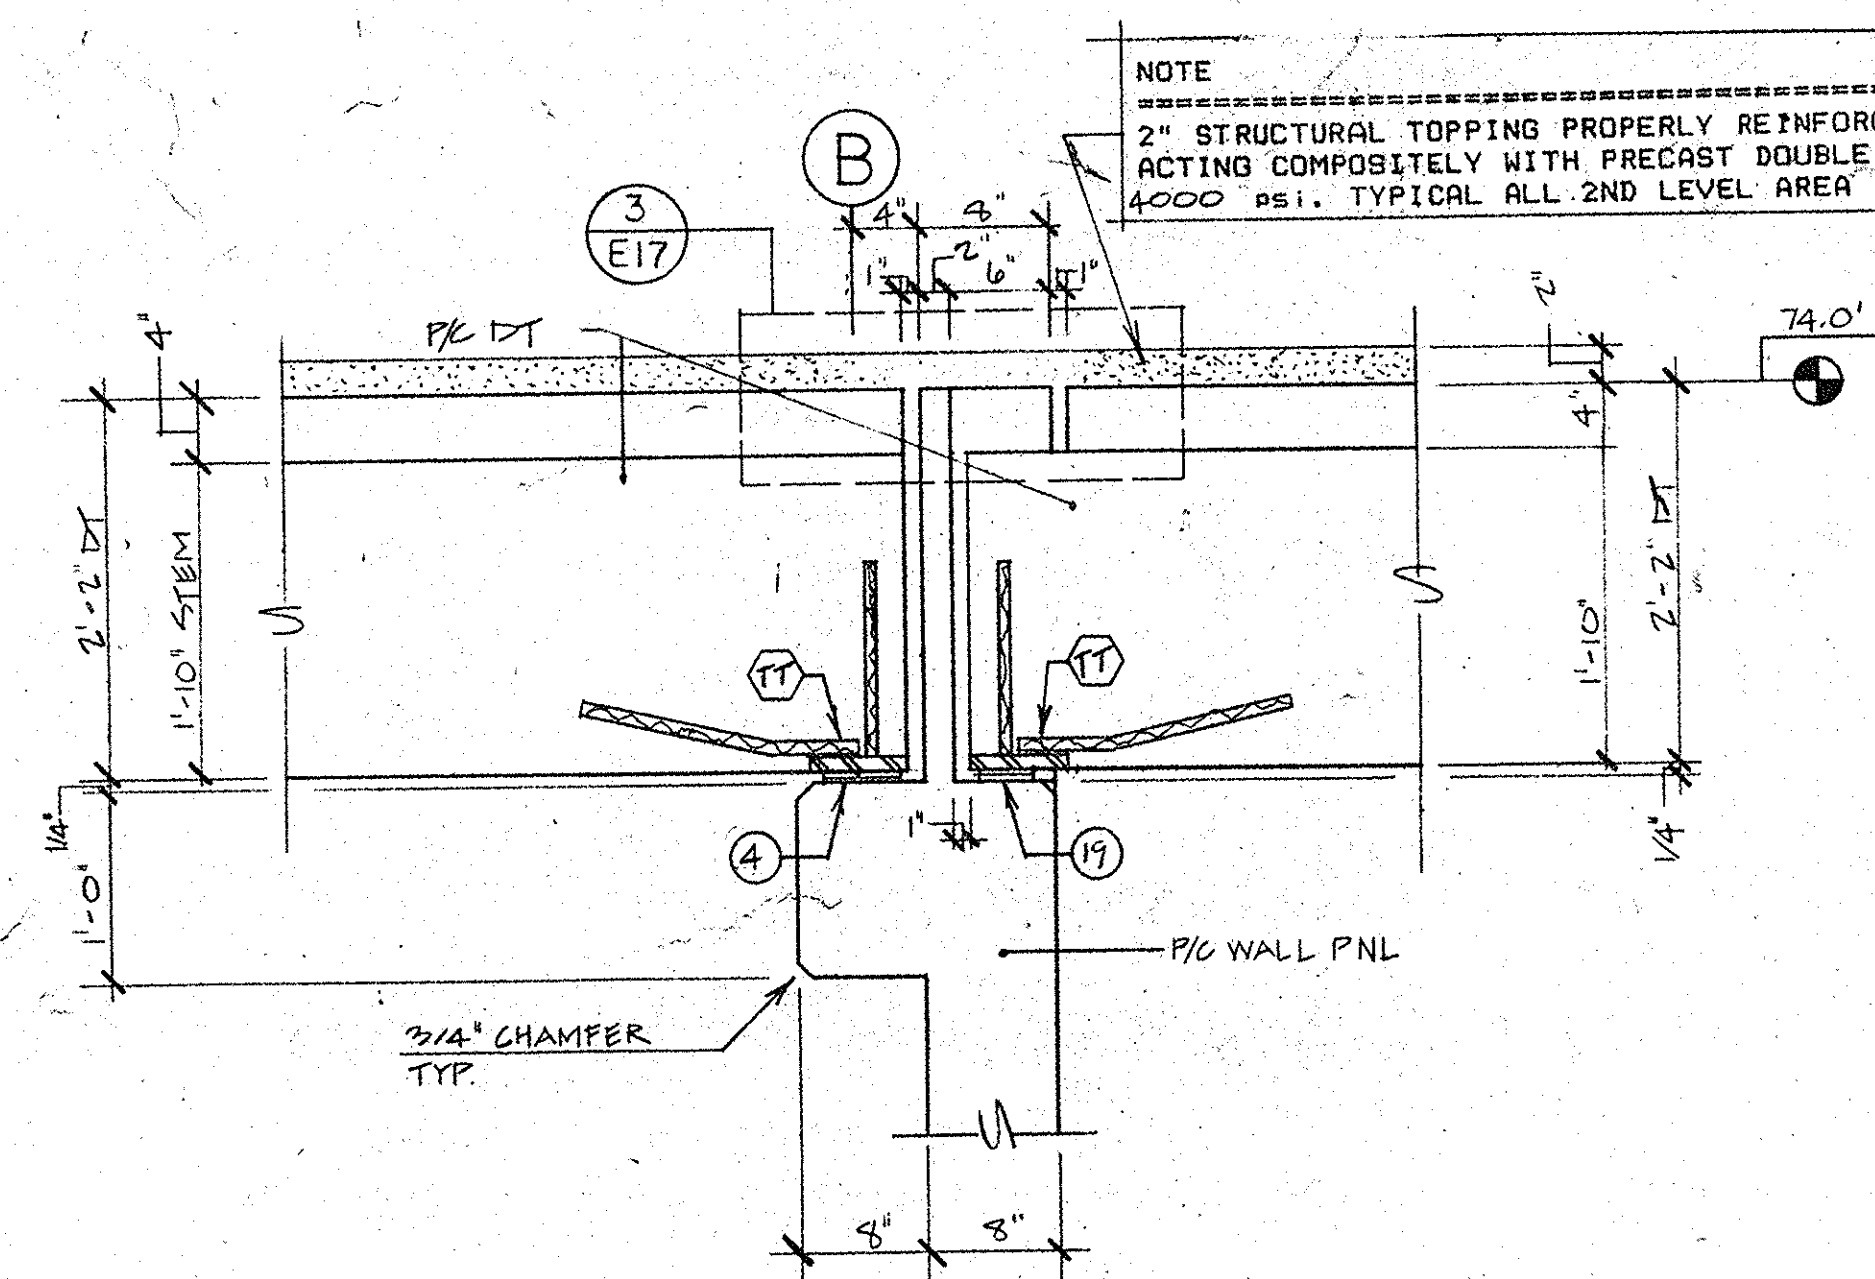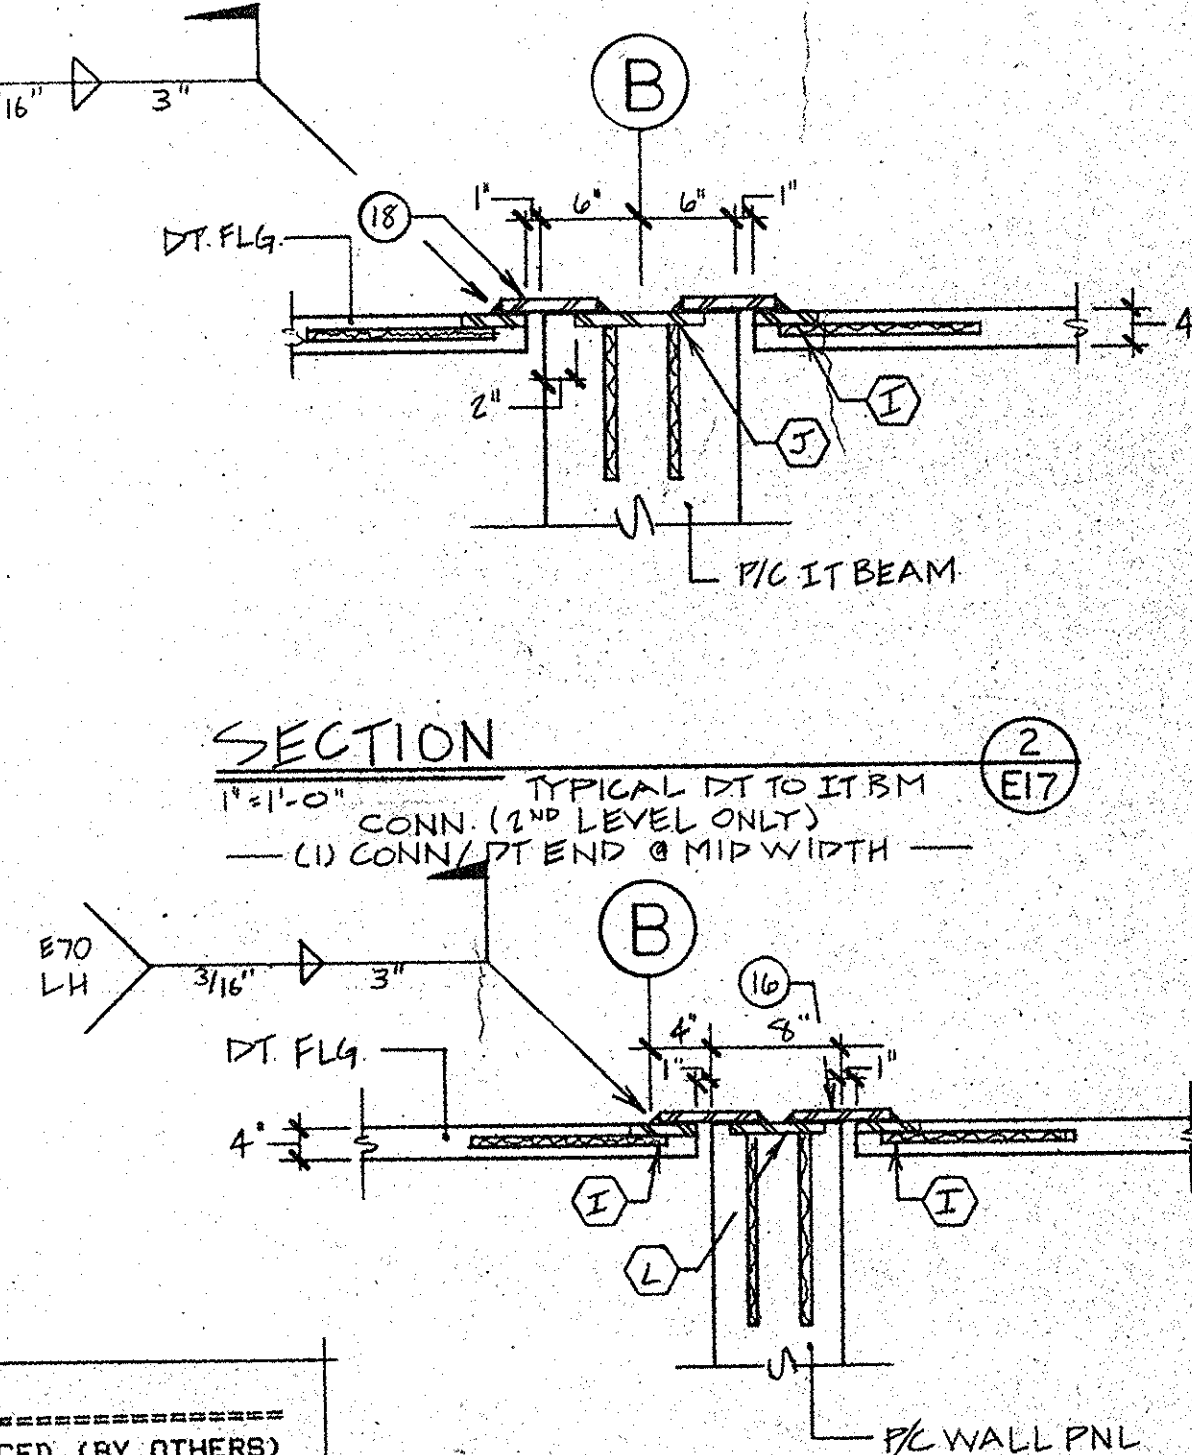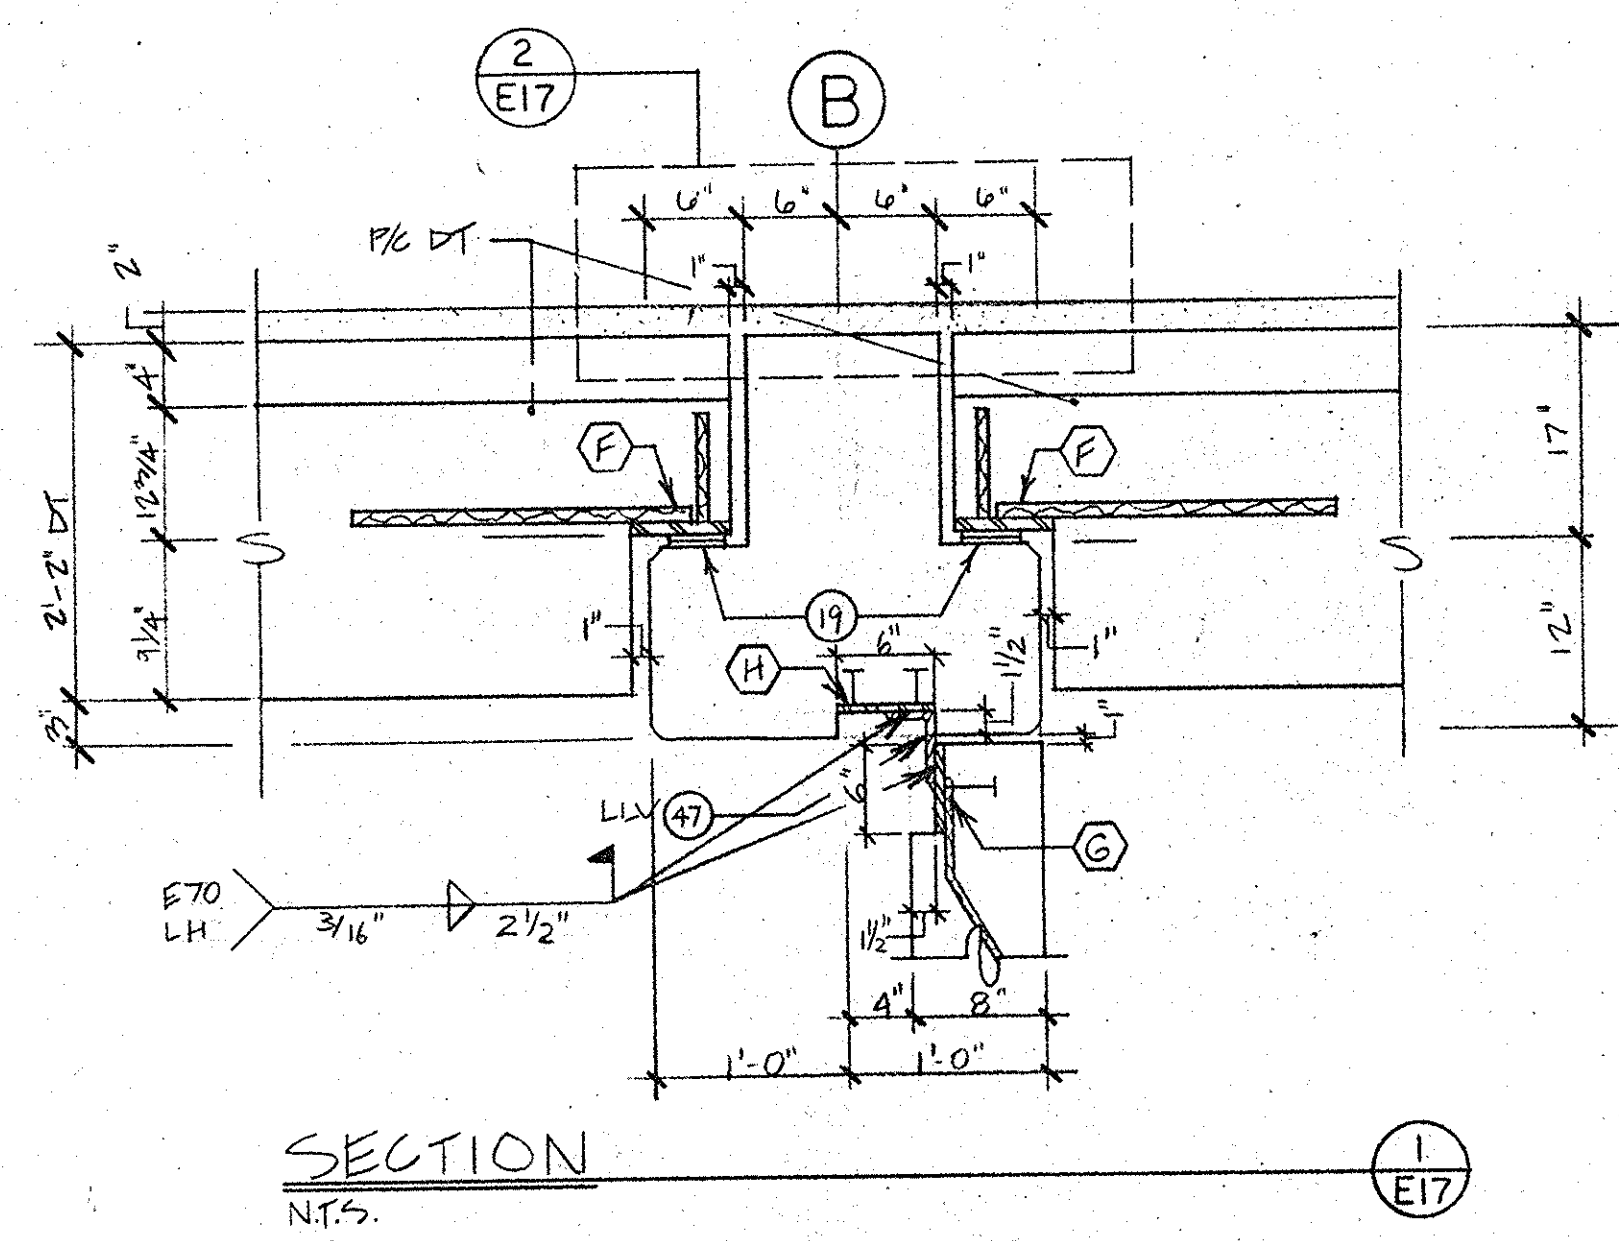

RECORD DRAWING
DATE: 5/2/88

APPROVED
APPROVED AS CORRECTED
REVISE AND RESUBMIT
NOT APPROVED

CHECKING IS ONLY FOR CONFORMANCE WITH THE DESIGN CONCEPT OF THE PROJECT AND COMPLIANCE WITH THE INFORMATION GIVEN IN THE CONTRACT DOCUMENTS. CONTRACTOR IS RESPONSIBLE FOR THE JOB SITE FOR INFORMATION AND CORRELATION OF THE INFORMATION TO THE FIELD. THE CONTRACTOR IS RESPONSIBLE FOR THE COORDINATION OF THE WORK OF ALL TRADES.

UNIVERSITY OF MARYLAND AT BALTIMORE
OFFICE OF FACILITIES MANAGEMENT

DATE 5/2/88 BY NBN







RTKL Associates Inc.
Approval is for design only. Contractor is responsible for dimensions, materials and construction with other trades. Approval does not constitute a warranty or requirement unless accompanied by a Change Order.

Approved: [Signature]
Approved as noted: [Signature]
By: NBN
Architectural

Checked: [Signature]
By: GKH
Engineer

PROJECT NO. 6003
DWG NO. E-17

PROJECT: PEARL STREET GARAGE BALTIMORE, MARYLAND		DRAWING TITLE: SECTIONS & DETAILS	
CONCRETE BUILDING SYSTEMS		REVISION/ACTION	
10/8-1/8		1. REVISED PER APPROVED DRAWINGS DATED 5-2-88. 2. 3-4-88. 3. 5-2-88. 4. 5-2-88. 5. 5-2-88. 6. 5-2-88. 7. 5-2-88. 8. 5-2-88. 9. 5-2-88. 10. 5-2-88. 11. 5-2-88. 12. 5-2-88. 13. 5-2-88. 14. 5-2-88. 15. 5-2-88. 16. 5-2-88. 17. 5-2-88. 18. 5-2-88. 19. 5-2-88. 20. 5-2-88. 21. 5-2-88. 22. 5-2-88. 23. 5-2-88. 24. 5-2-88. 25. 5-2-88. 26. 5-2-88. 27. 5-2-88. 28. 5-2-88. 29. 5-2-88. 30. 5-2-88. 31. 5-2-88. 32. 5-2-88. 33. 5-2-88. 34. 5-2-88. 35. 5-2-88. 36. 5-2-88. 37. 5-2-88. 38. 5-2-88. 39. 5-2-88. 40. 5-2-88. 41. 5-2-88. 42. 5-2-88. 43. 5-2-88. 44. 5-2-88. 45. 5-2-88. 46. 5-2-88. 47. 5-2-88. 48. 5-2-88. 49. 5-2-88. 50. 5-2-88. 51. 5-2-88. 52. 5-2-88. 53. 5-2-88. 54. 5-2-88. 55. 5-2-88. 56. 5-2-88. 57. 5-2-88. 58. 5-2-88. 59. 5-2-88. 60. 5-2-88. 61. 5-2-88. 62. 5-2-88. 63. 5-2-88. 64. 5-2-88. 65. 5-2-88. 66. 5-2-88. 67. 5-2-88. 68. 5-2-88. 69. 5-2-88. 70. 5-2-88. 71. 5-2-88. 72. 5-2-88. 73. 5-2-88. 74. 5-2-88. 75. 5-2-88. 76. 5-2-88. 77. 5-2-88. 78. 5-2-88. 79. 5-2-88. 80. 5-2-88. 81. 5-2-88. 82. 5-2-88. 83. 5-2-88. 84. 5-2-88. 85. 5-2-88. 86. 5-2-88. 87. 5-2-88. 88. 5-2-88. 89. 5-2-88. 90. 5-2-88. 91. 5-2-88. 92. 5-2-88. 93. 5-2-88. 94. 5-2-88. 95. 5-2-88. 96. 5-2-88. 97. 5-2-88. 98. 5-2-88. 99. 5-2-88. 100. 5-2-88. 101. 5-2-88. 102. 5-2-88. 103. 5-2-88. 104. 5-2-88. 105. 5-2-88. 106. 5-2-88. 107. 5-2-88. 108. 5-2-88. 109. 5-2-88. 110. 5-2-88. 111. 5-2-88. 112. 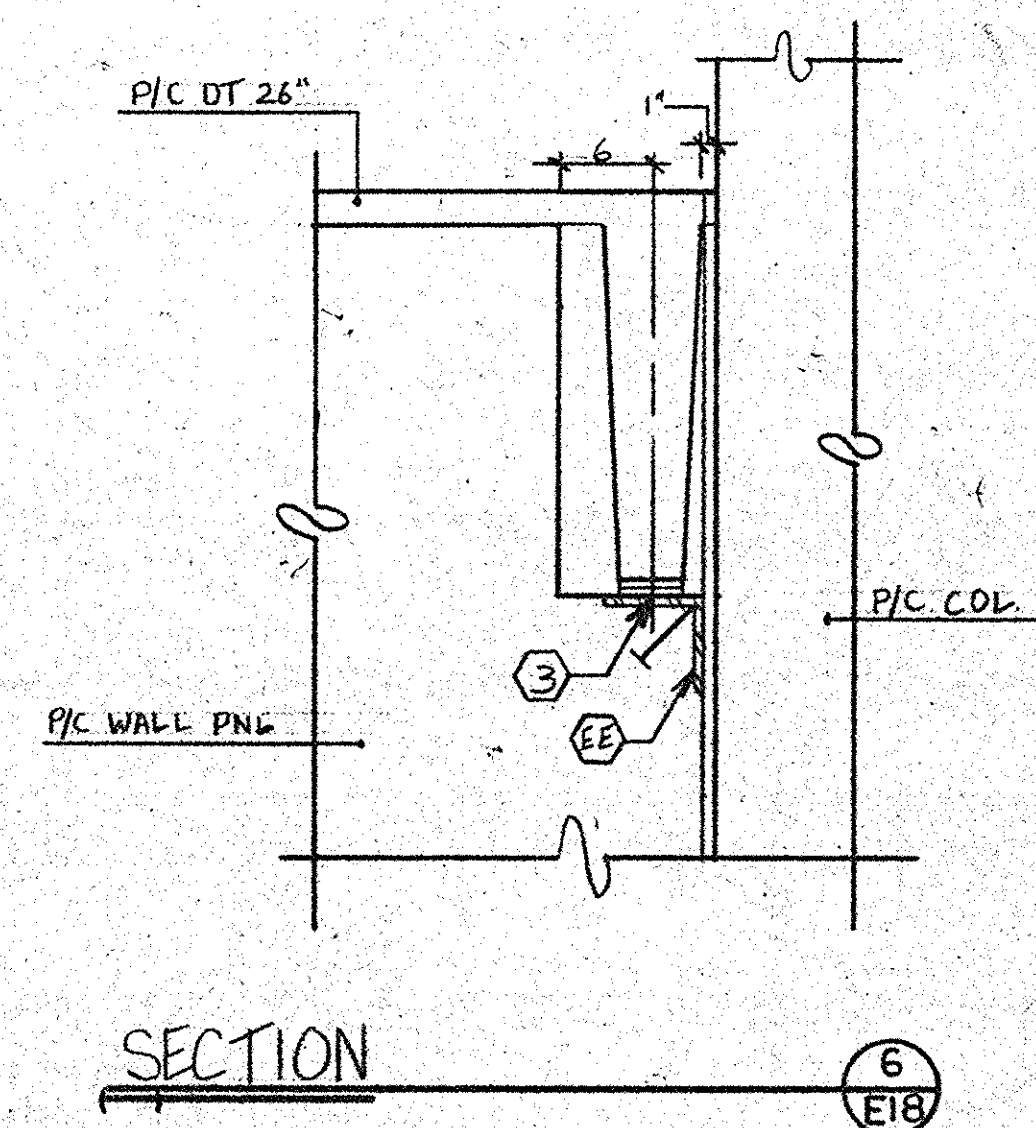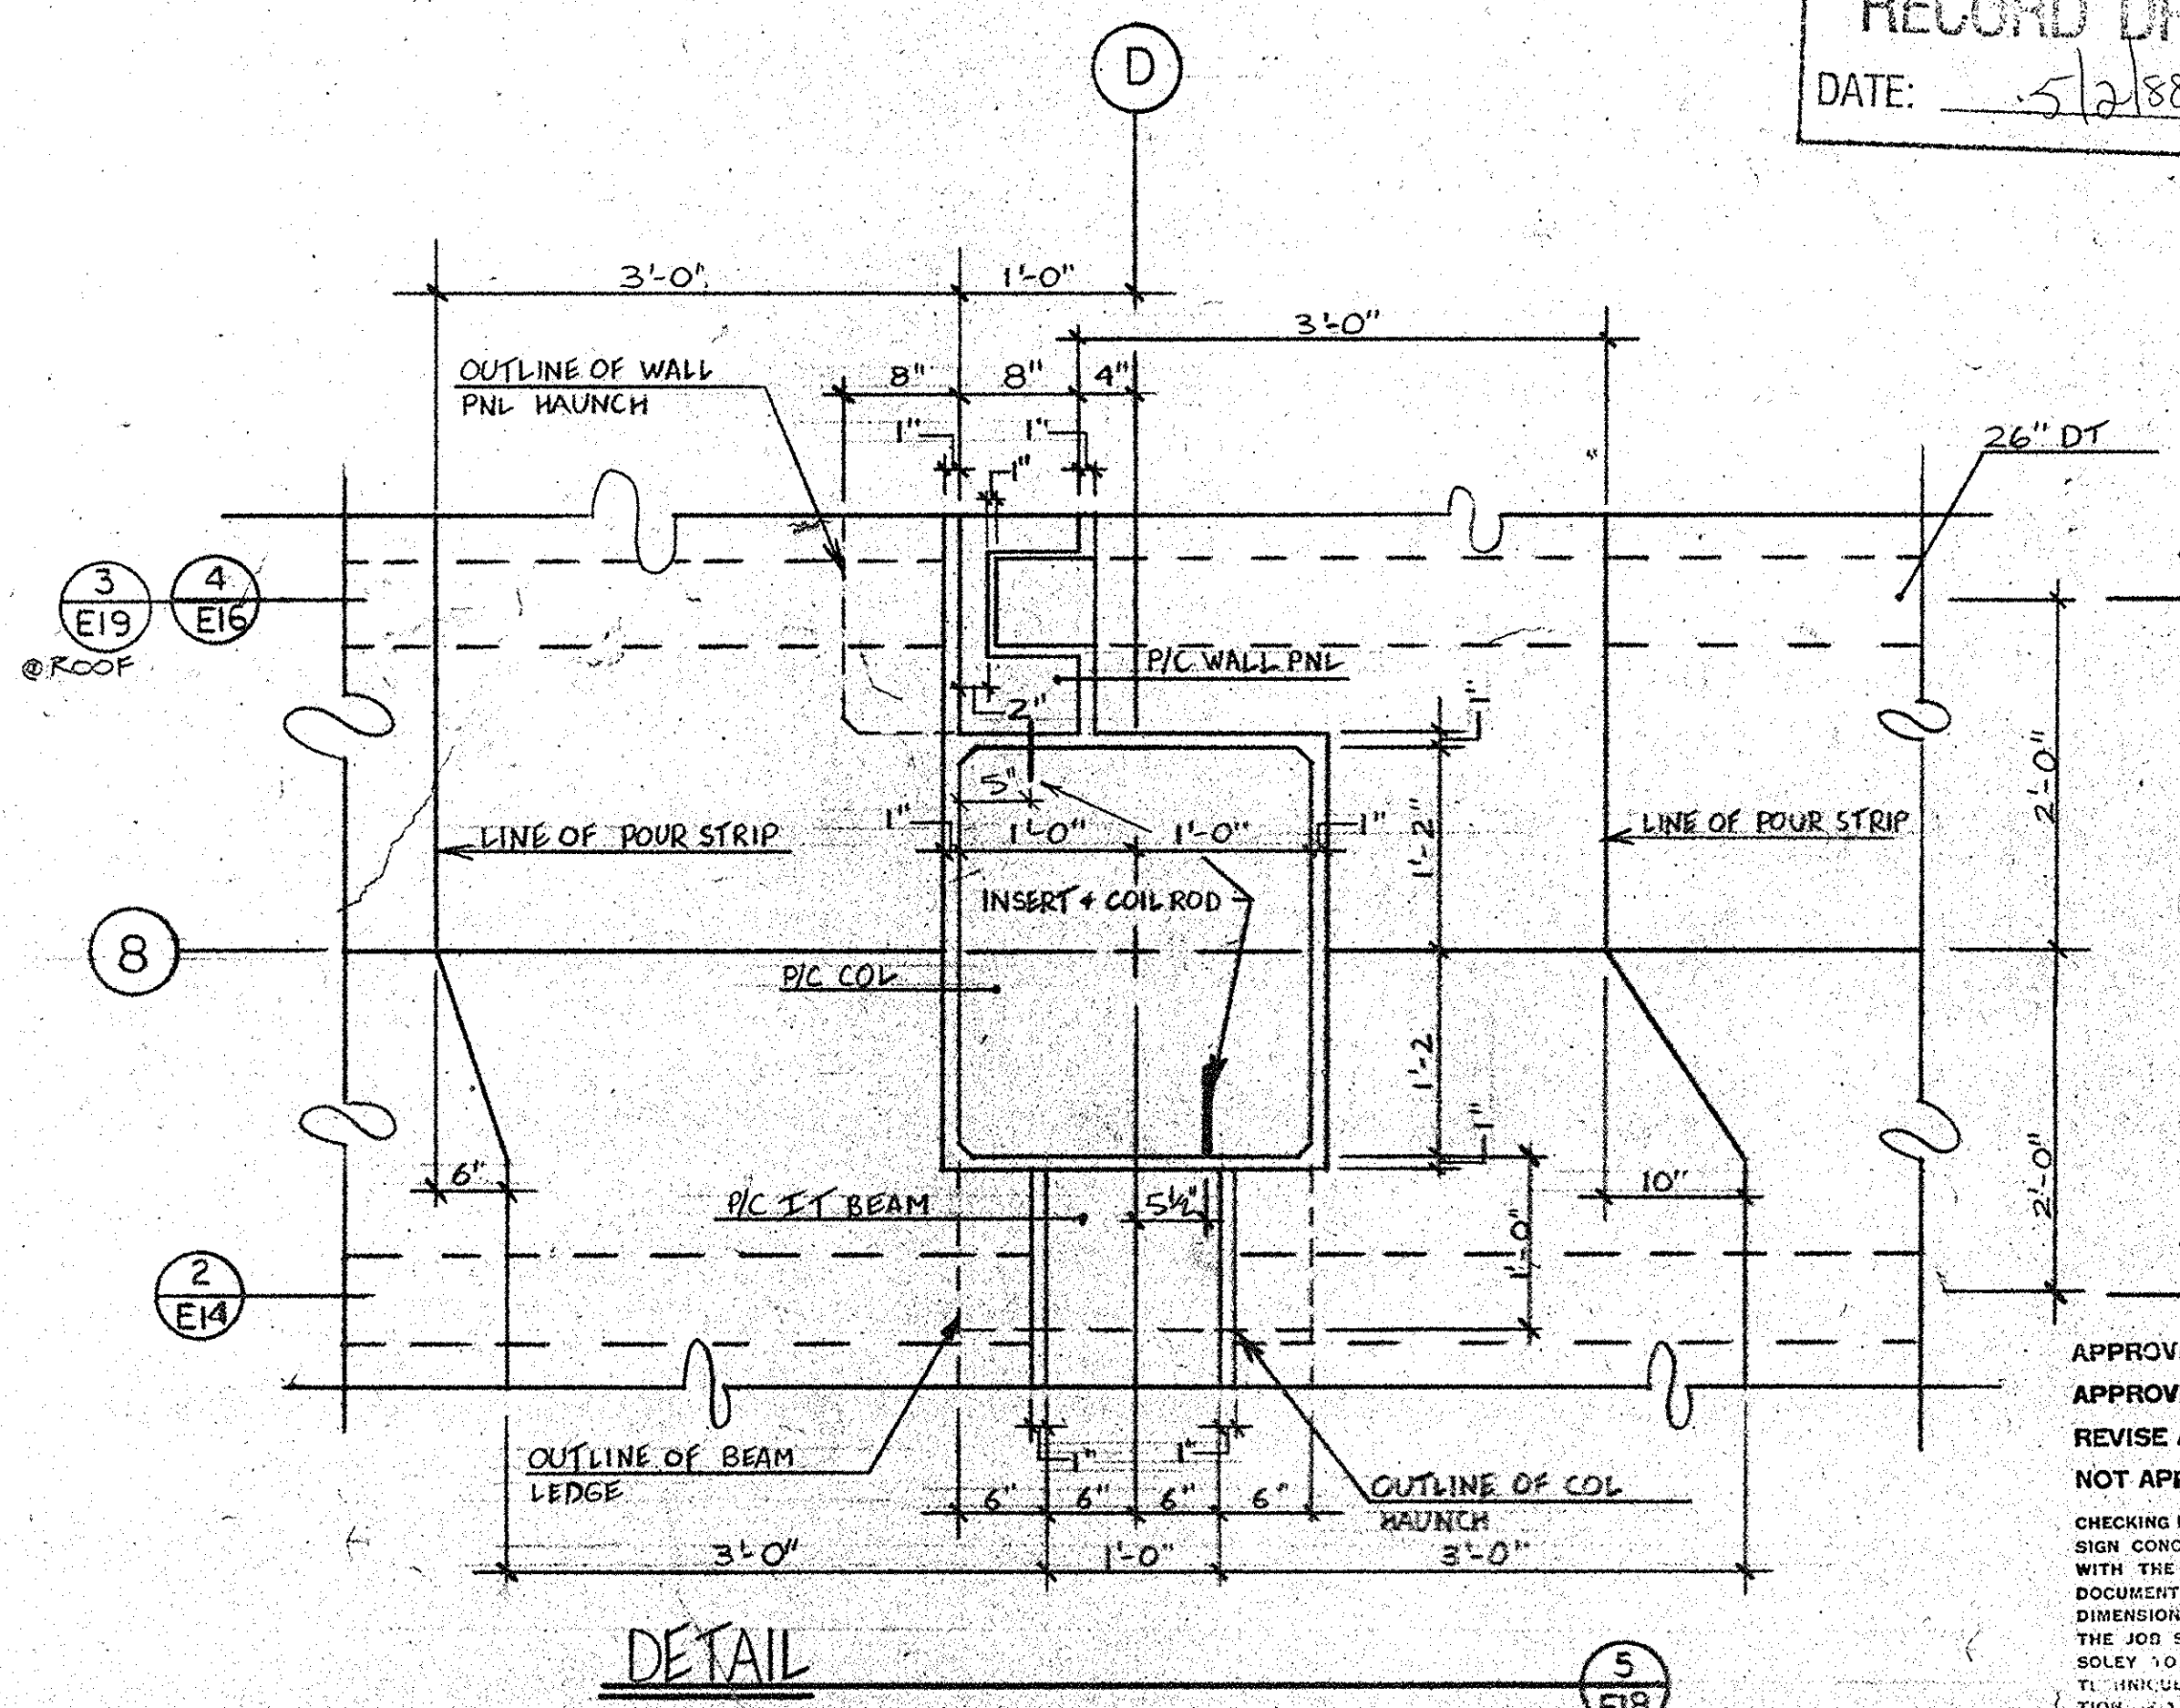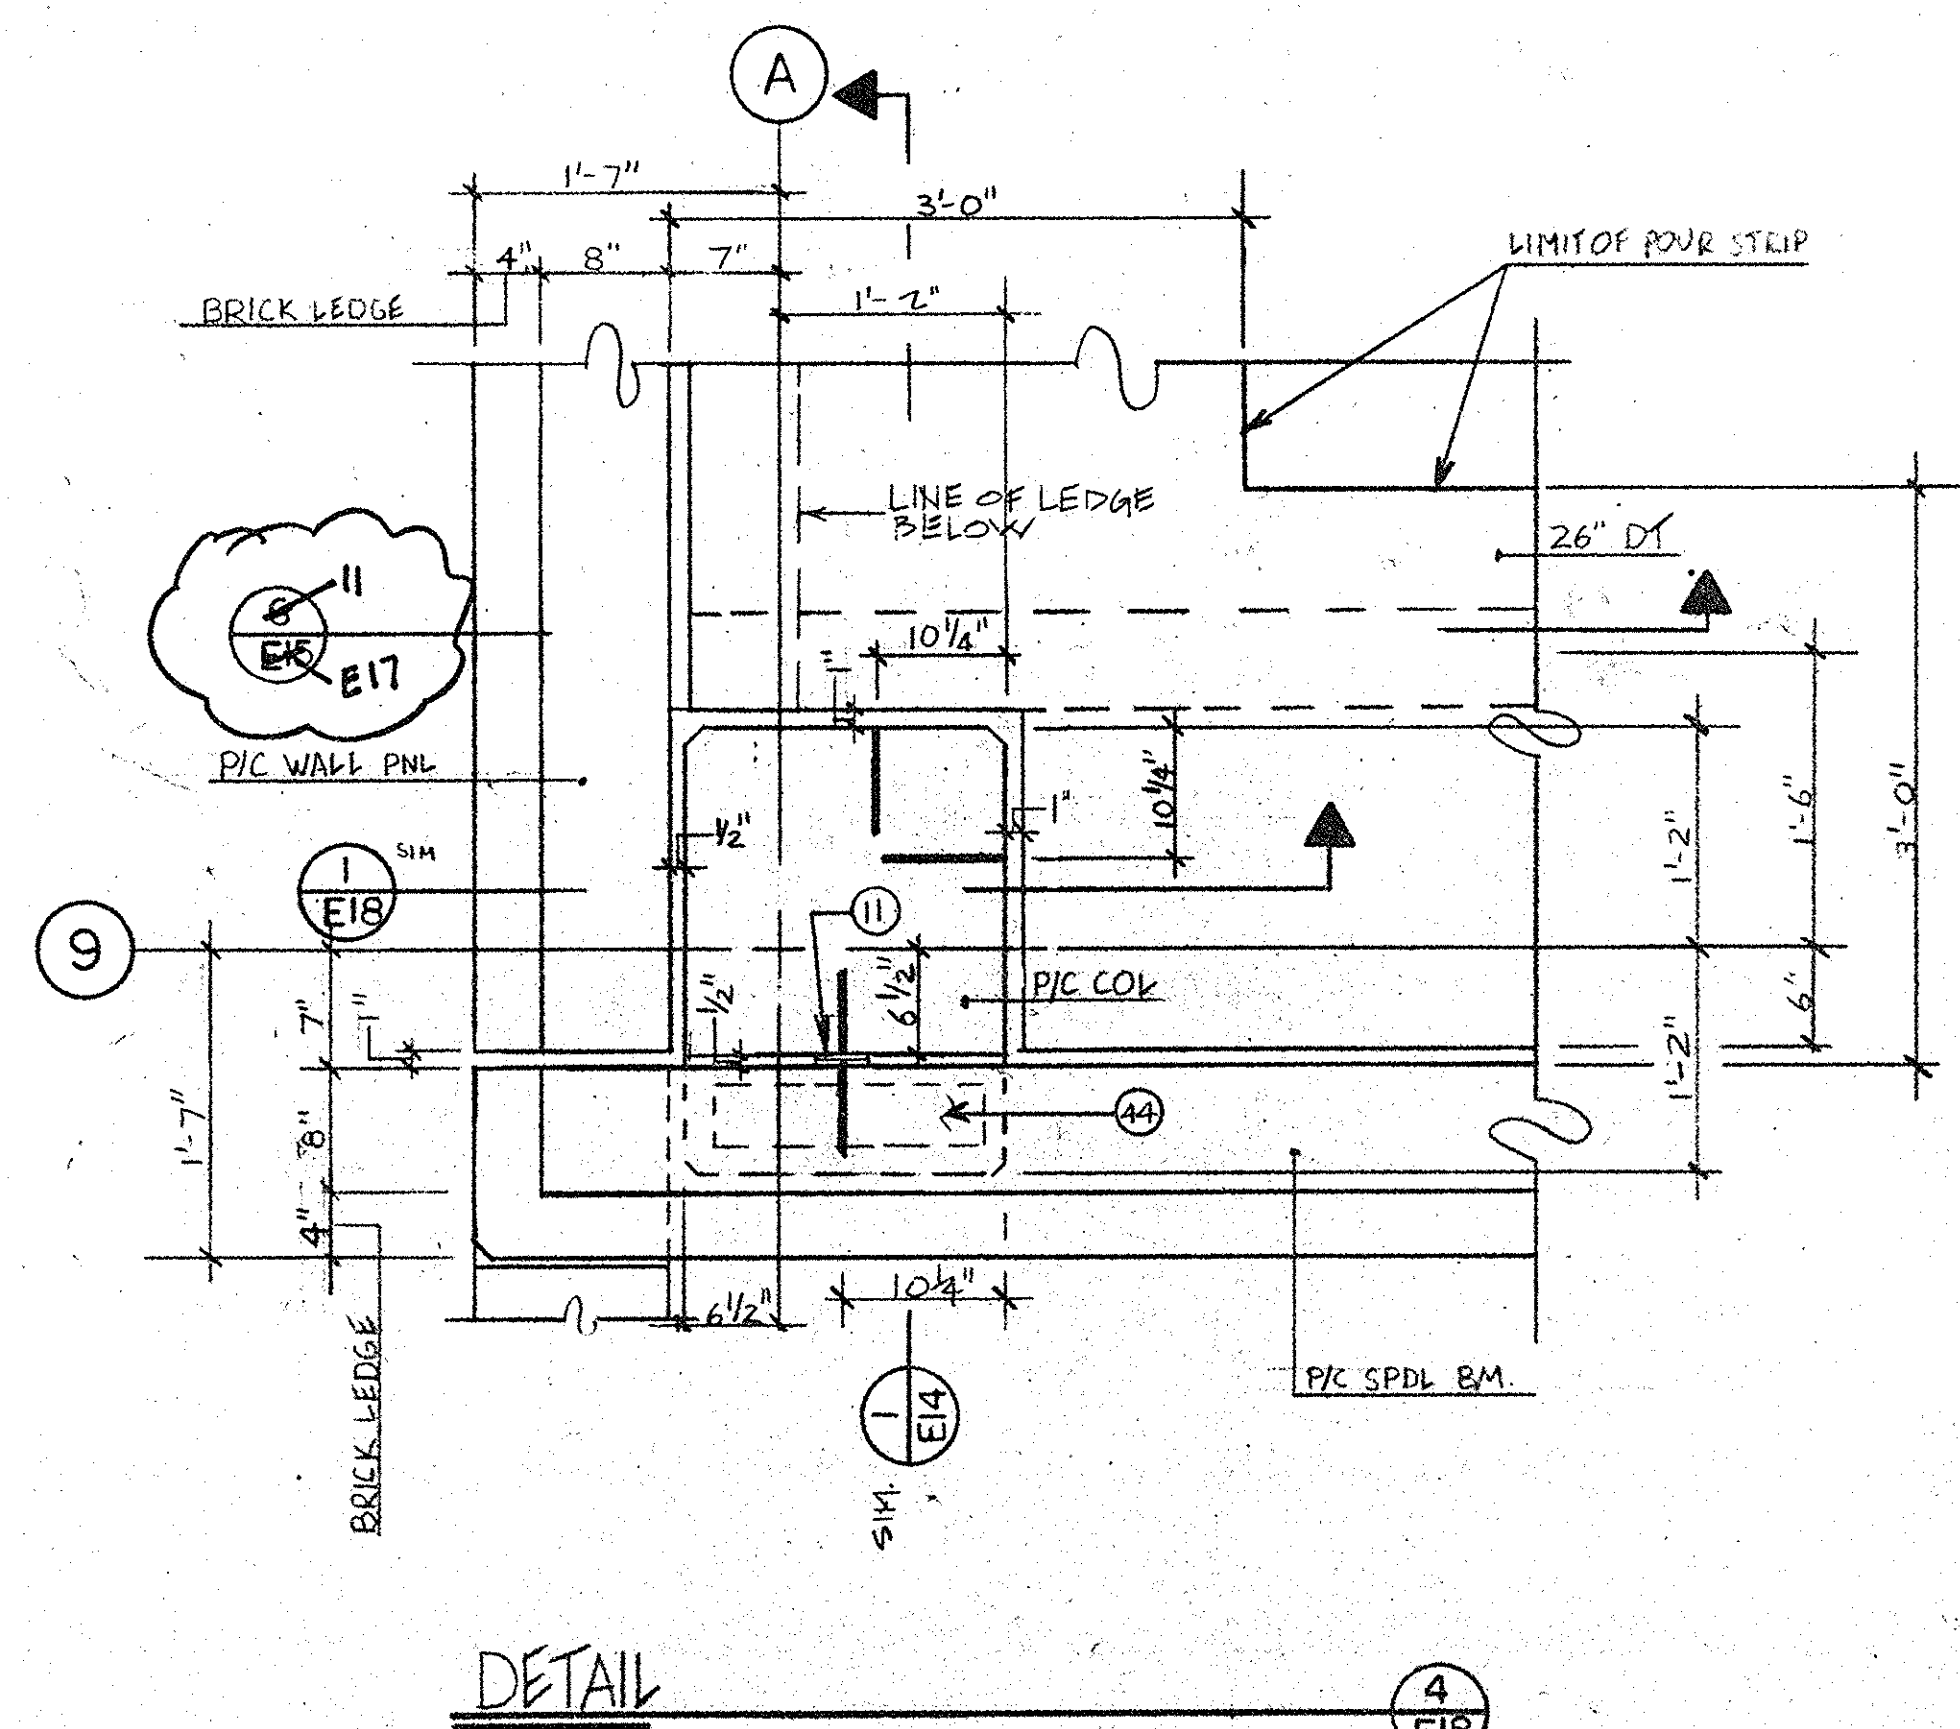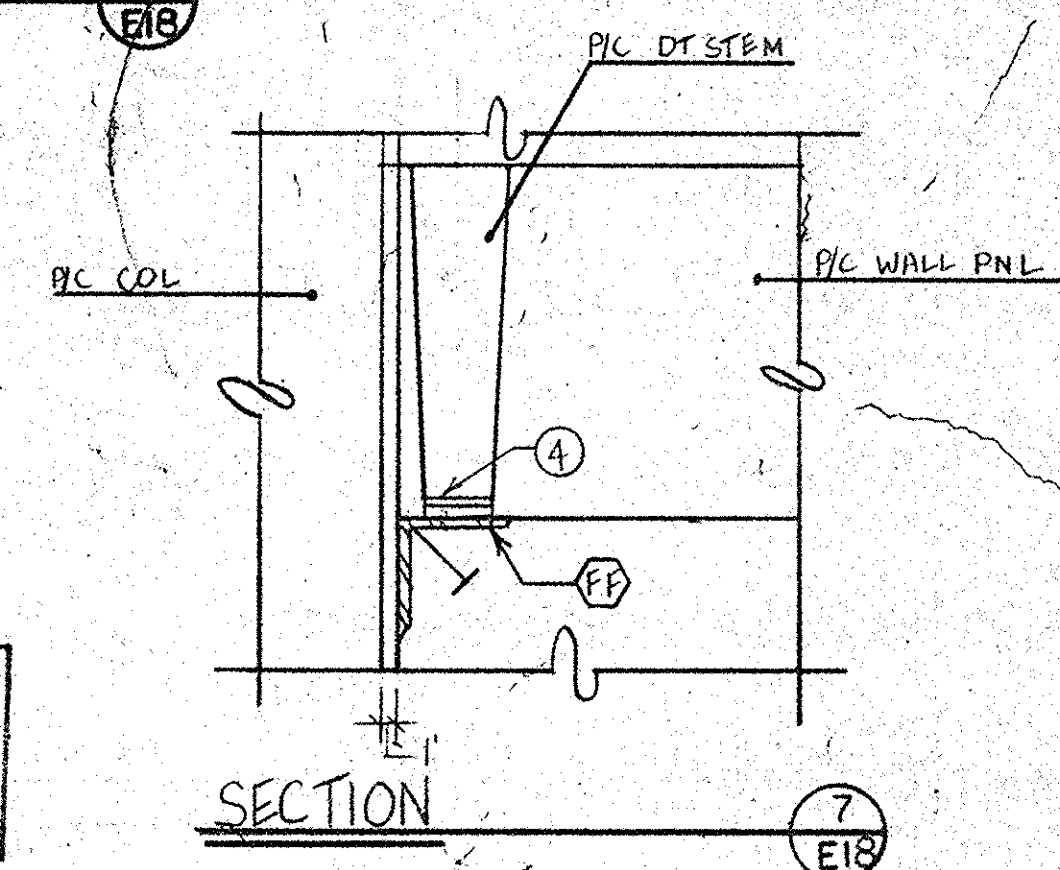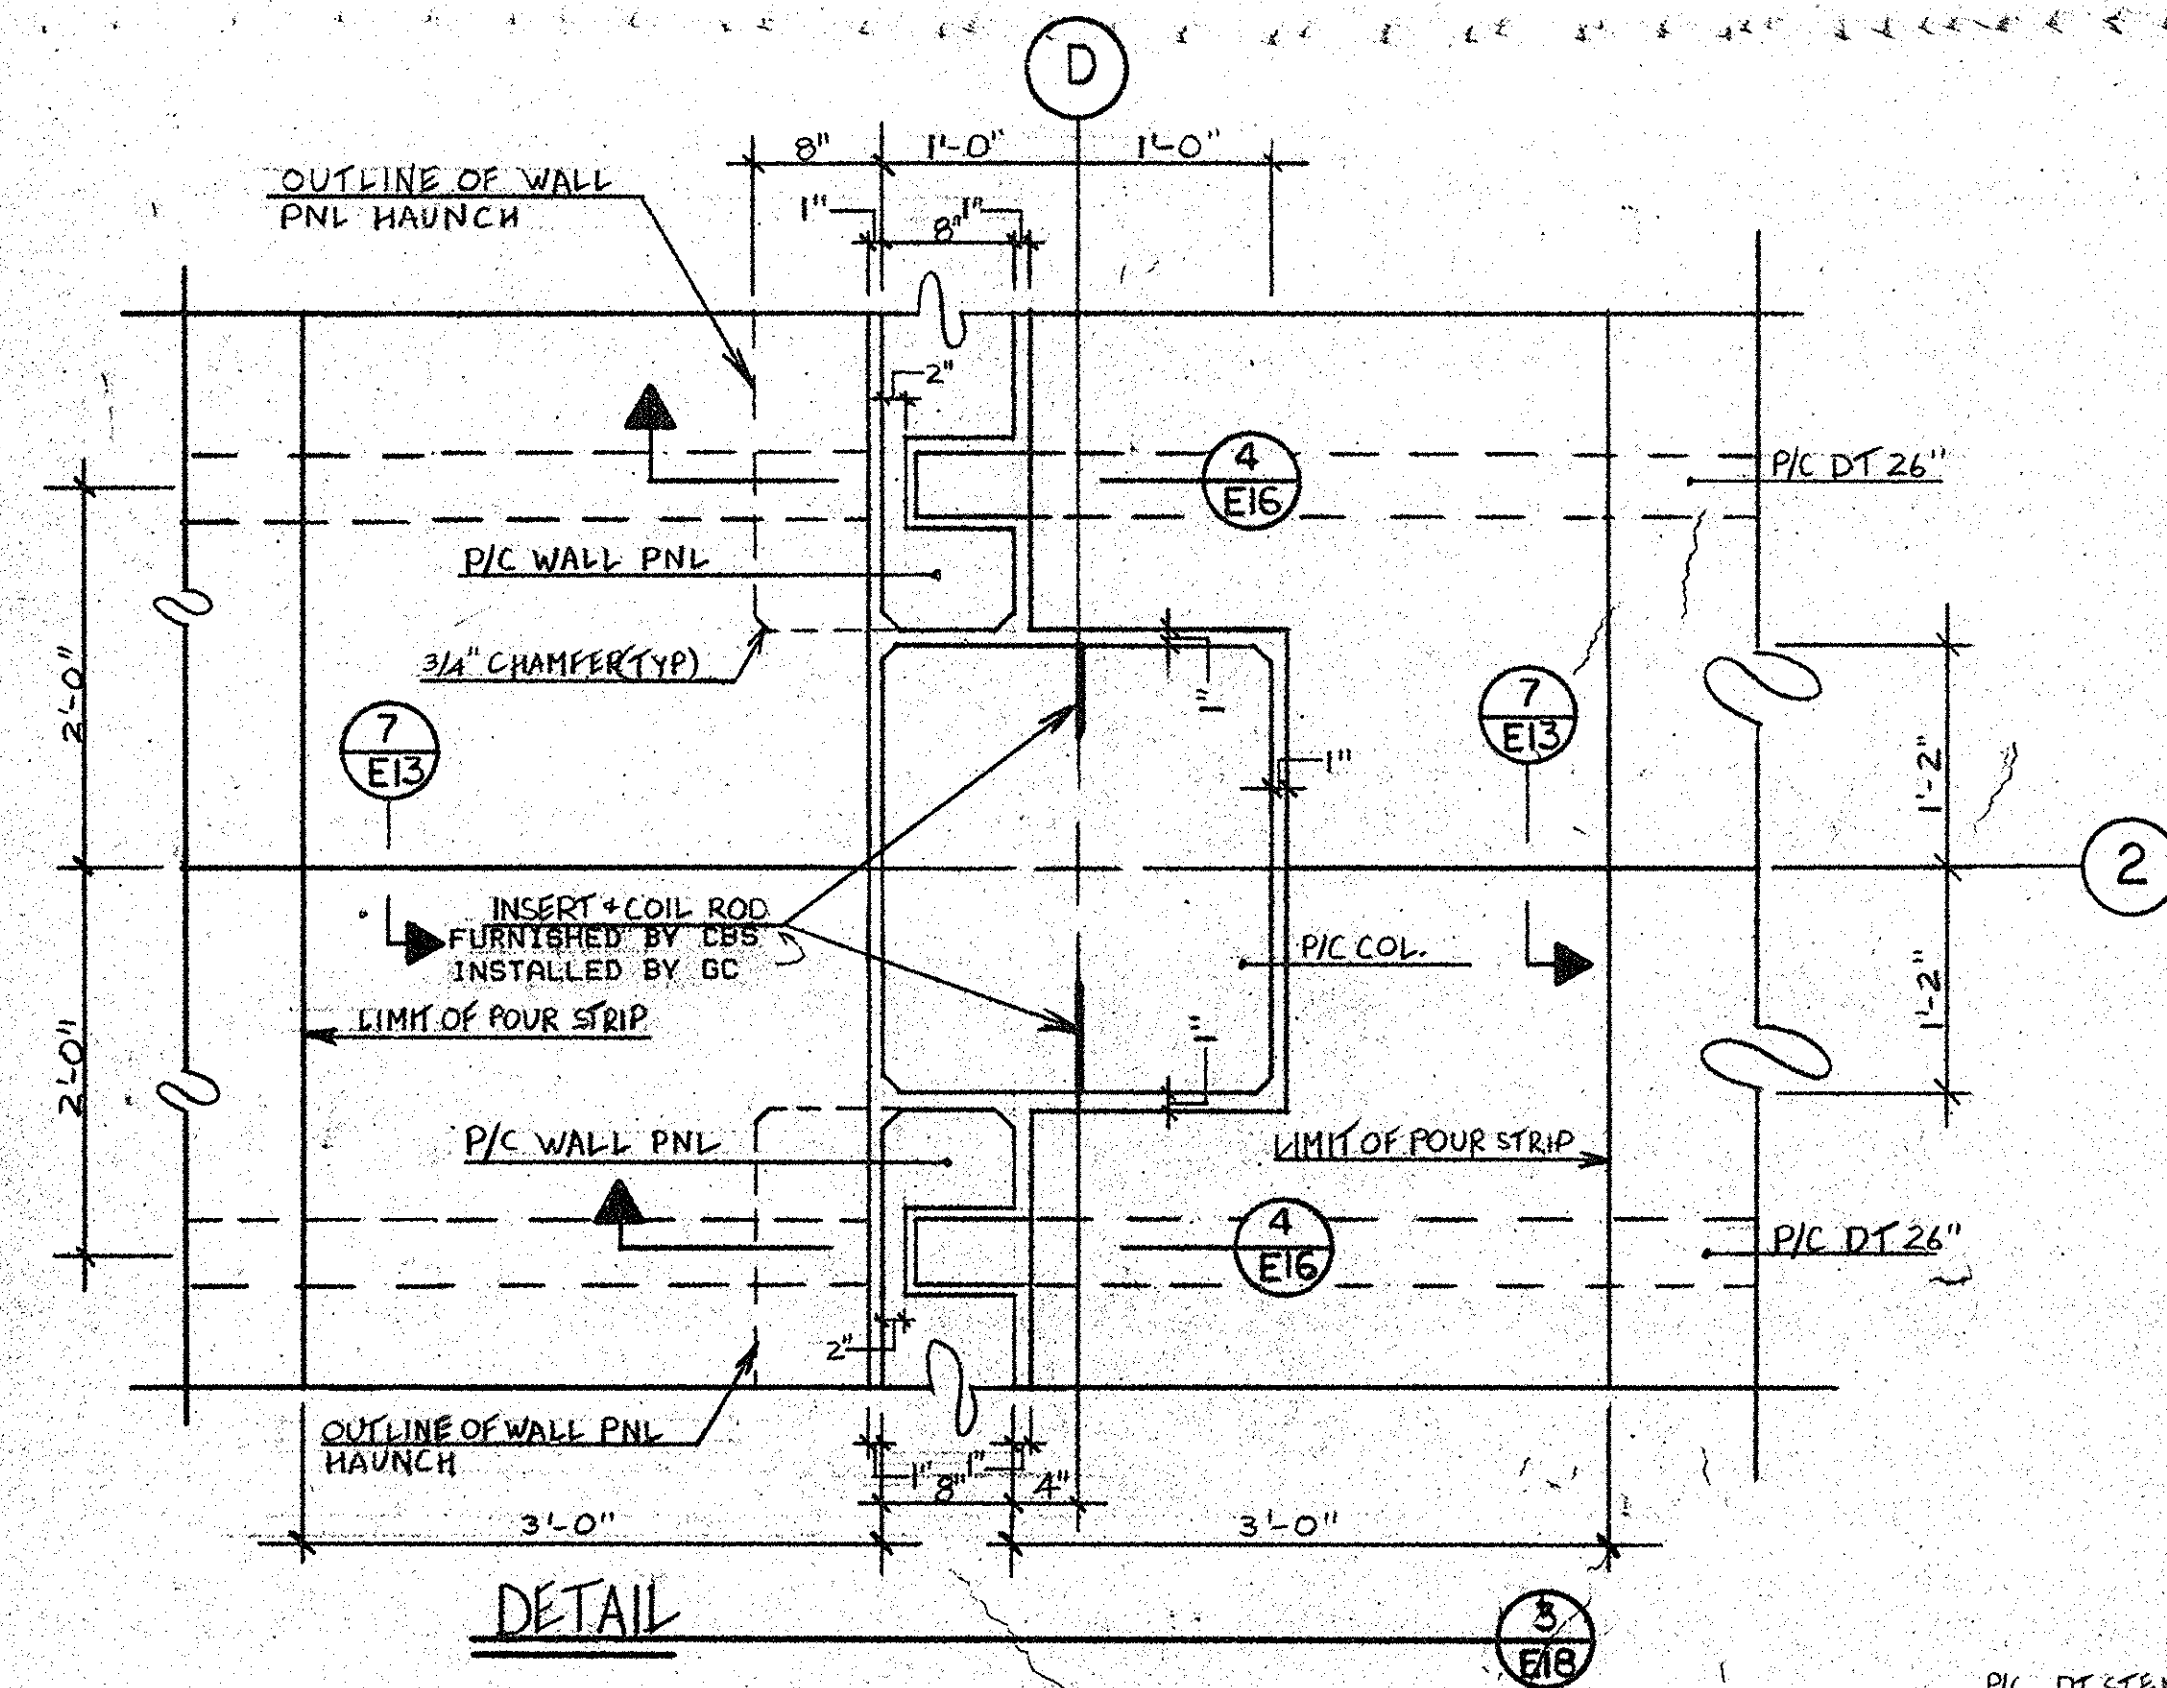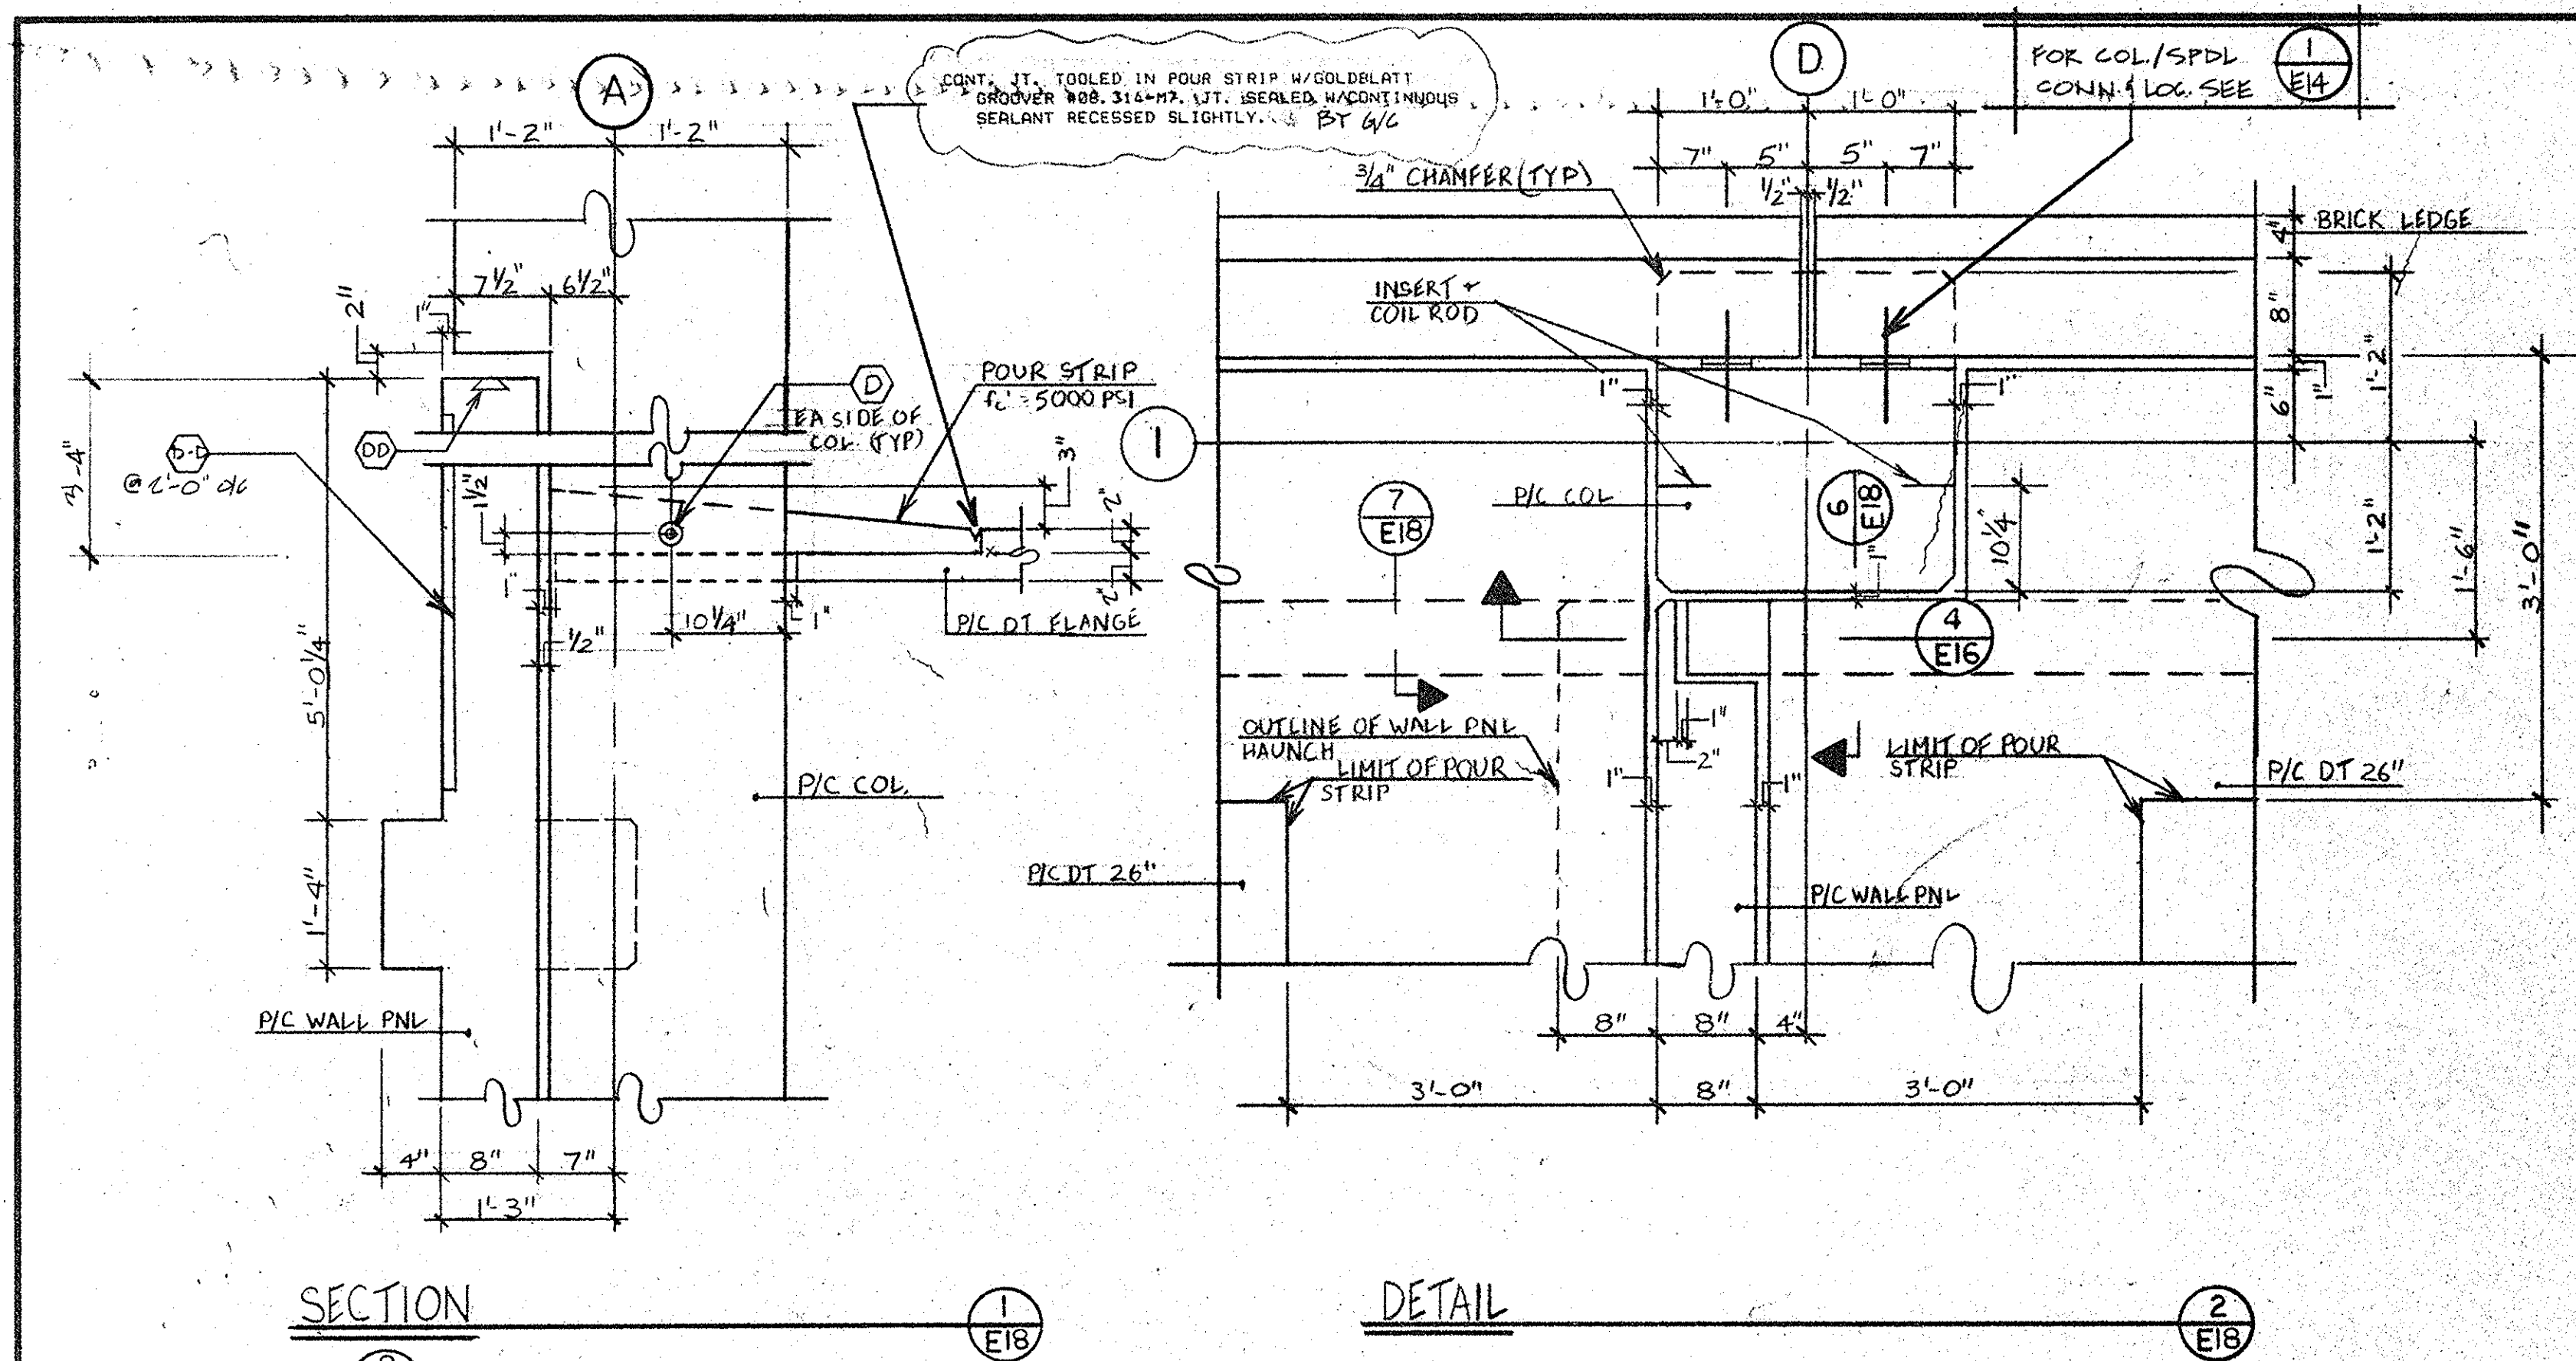

RECORD DRAWING
DATE: 5/2/88



APPROVED
APPROVED AS CORRECTED
REVISE AND RESUBMIT
NOT APPROVED

CHECKING IS ONLY FOR CONFORMANCE WITH THE DESIGN CONCEPT OF THE PROJECT AND COMPLIANCE WITH THE INFORMATION GIVEN IN THE CONTRACT DOCUMENTS. CONTRACTOR IS RESPONSIBLE FOR DIMENSIONS TO BE CONFIRMED AND CORRELATED AT THE JOB SITE. FOR INFORMATION THAT PERTAINS SOLELY TO THE EXECUTION OF THE WORK, THE CONTRACTOR SHALL CONSULT WITH THE ARCHITECT. DATE: 5/2/88

RTKL Associates Inc.
Approval is for sign only. Contractor is responsible for dimensions, quantities and coordination with other trades. Approved does not constitute a change to contract requirements unless accompanied by a Change Order.
Approved as noted
Not approved for correction
Approved
Not approved
Date: 5.5.87
Architectural
Engineering

PROJECT	PEARL STREET GARAGE BALTIMORE, MARYLAND
DESIGNER	J. VINTON SCHAFERSONS
ARCHITECT	RTKL
DRAWING TITLE	SECTIONS & DETAILS
DRAWN	B-B-26
CHECKED	5-16-86
APPROVED	5-16-86
PROJECT NO.	6003
DWG. NO.	E-18

REVISIONS PER APPROVED DRAWINGS POSTED
1 11/2/86 8-24-86 1-10-88-RESUBMITTED FOR
2 11/2/86 8-24-86 1-10-88-RESUBMITTED FOR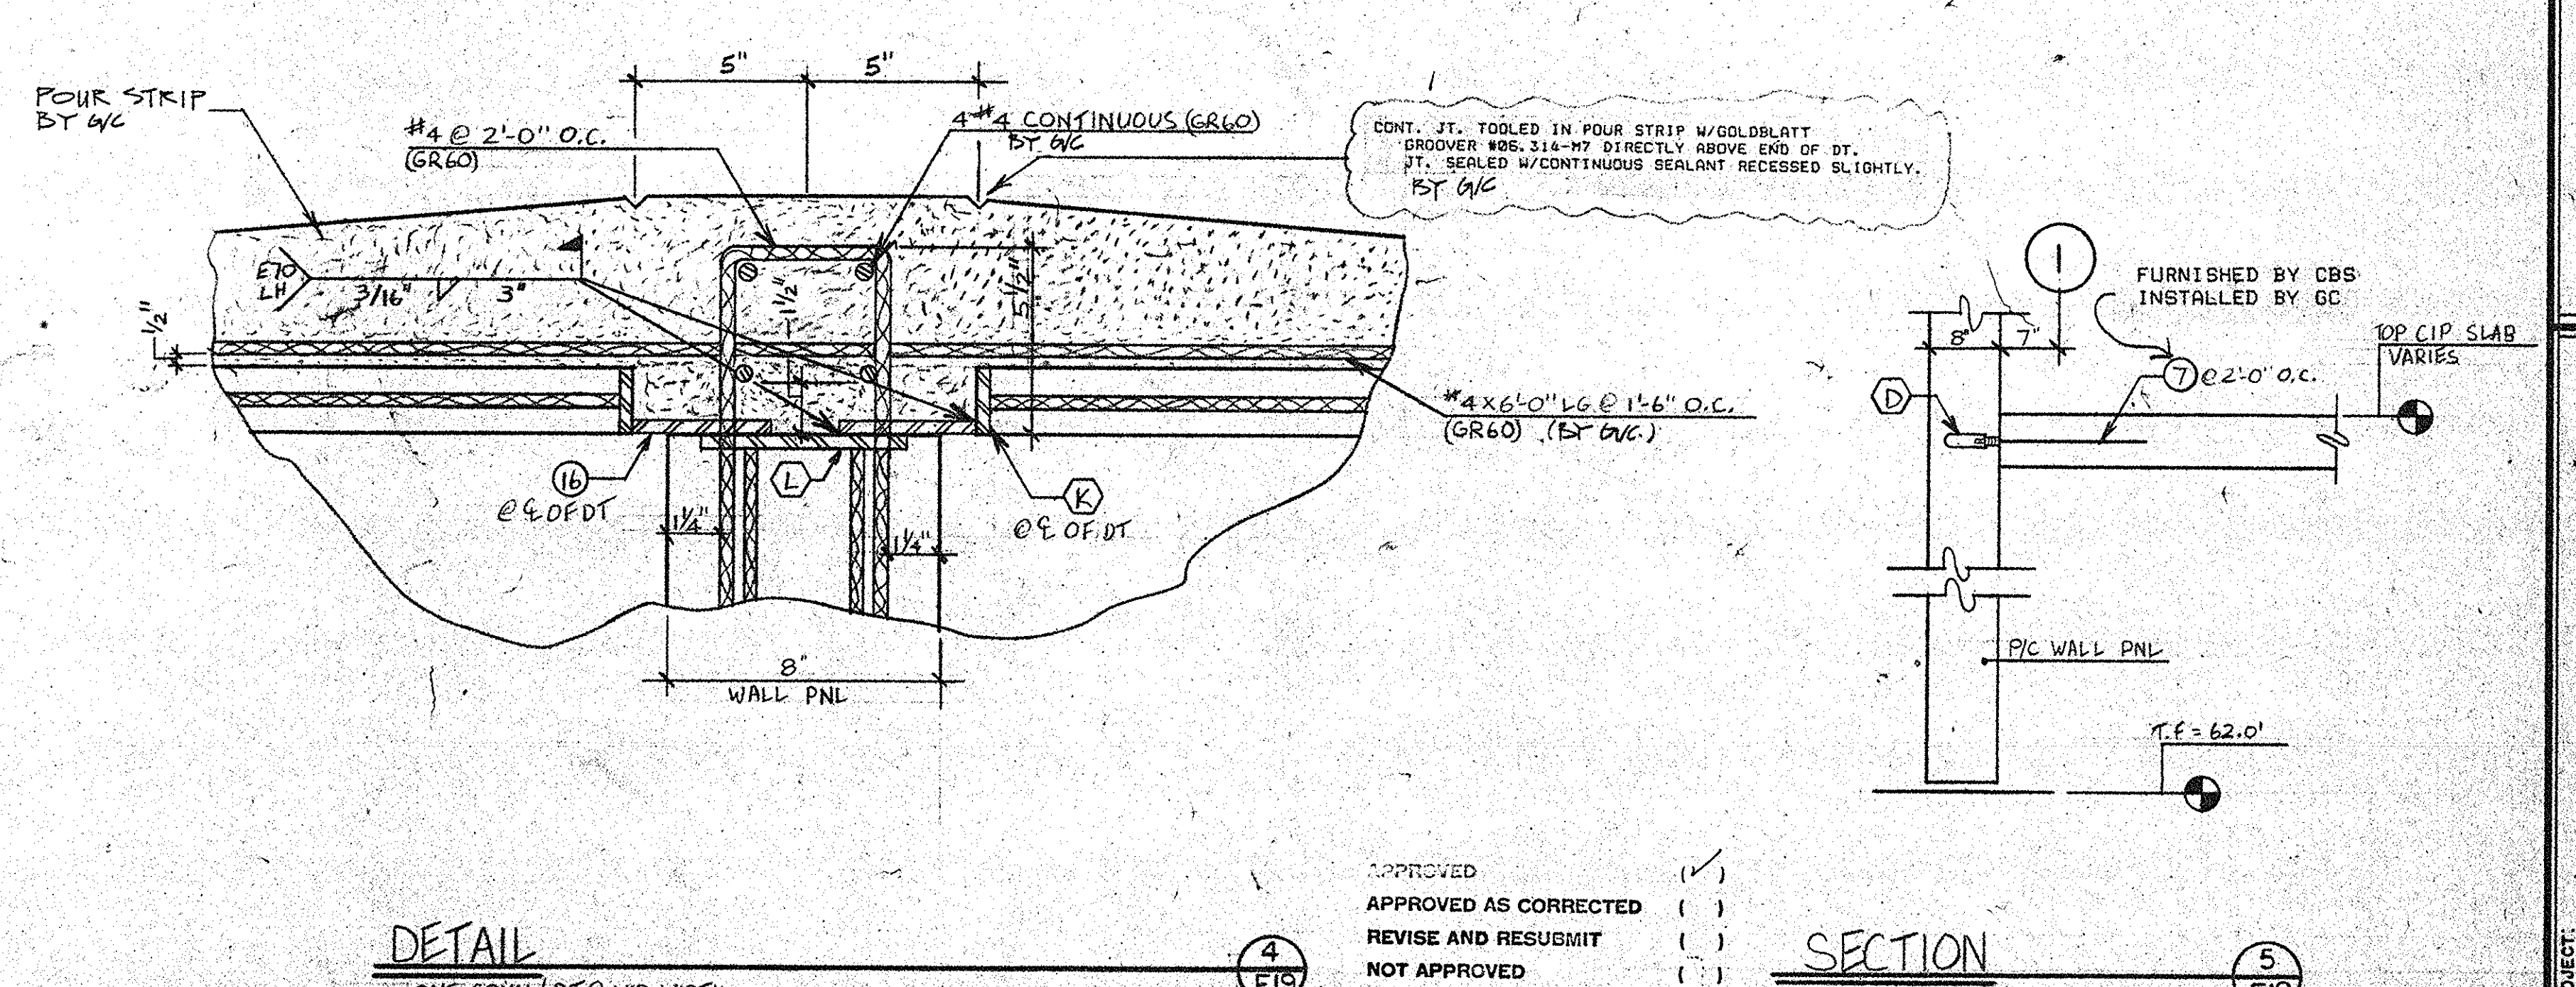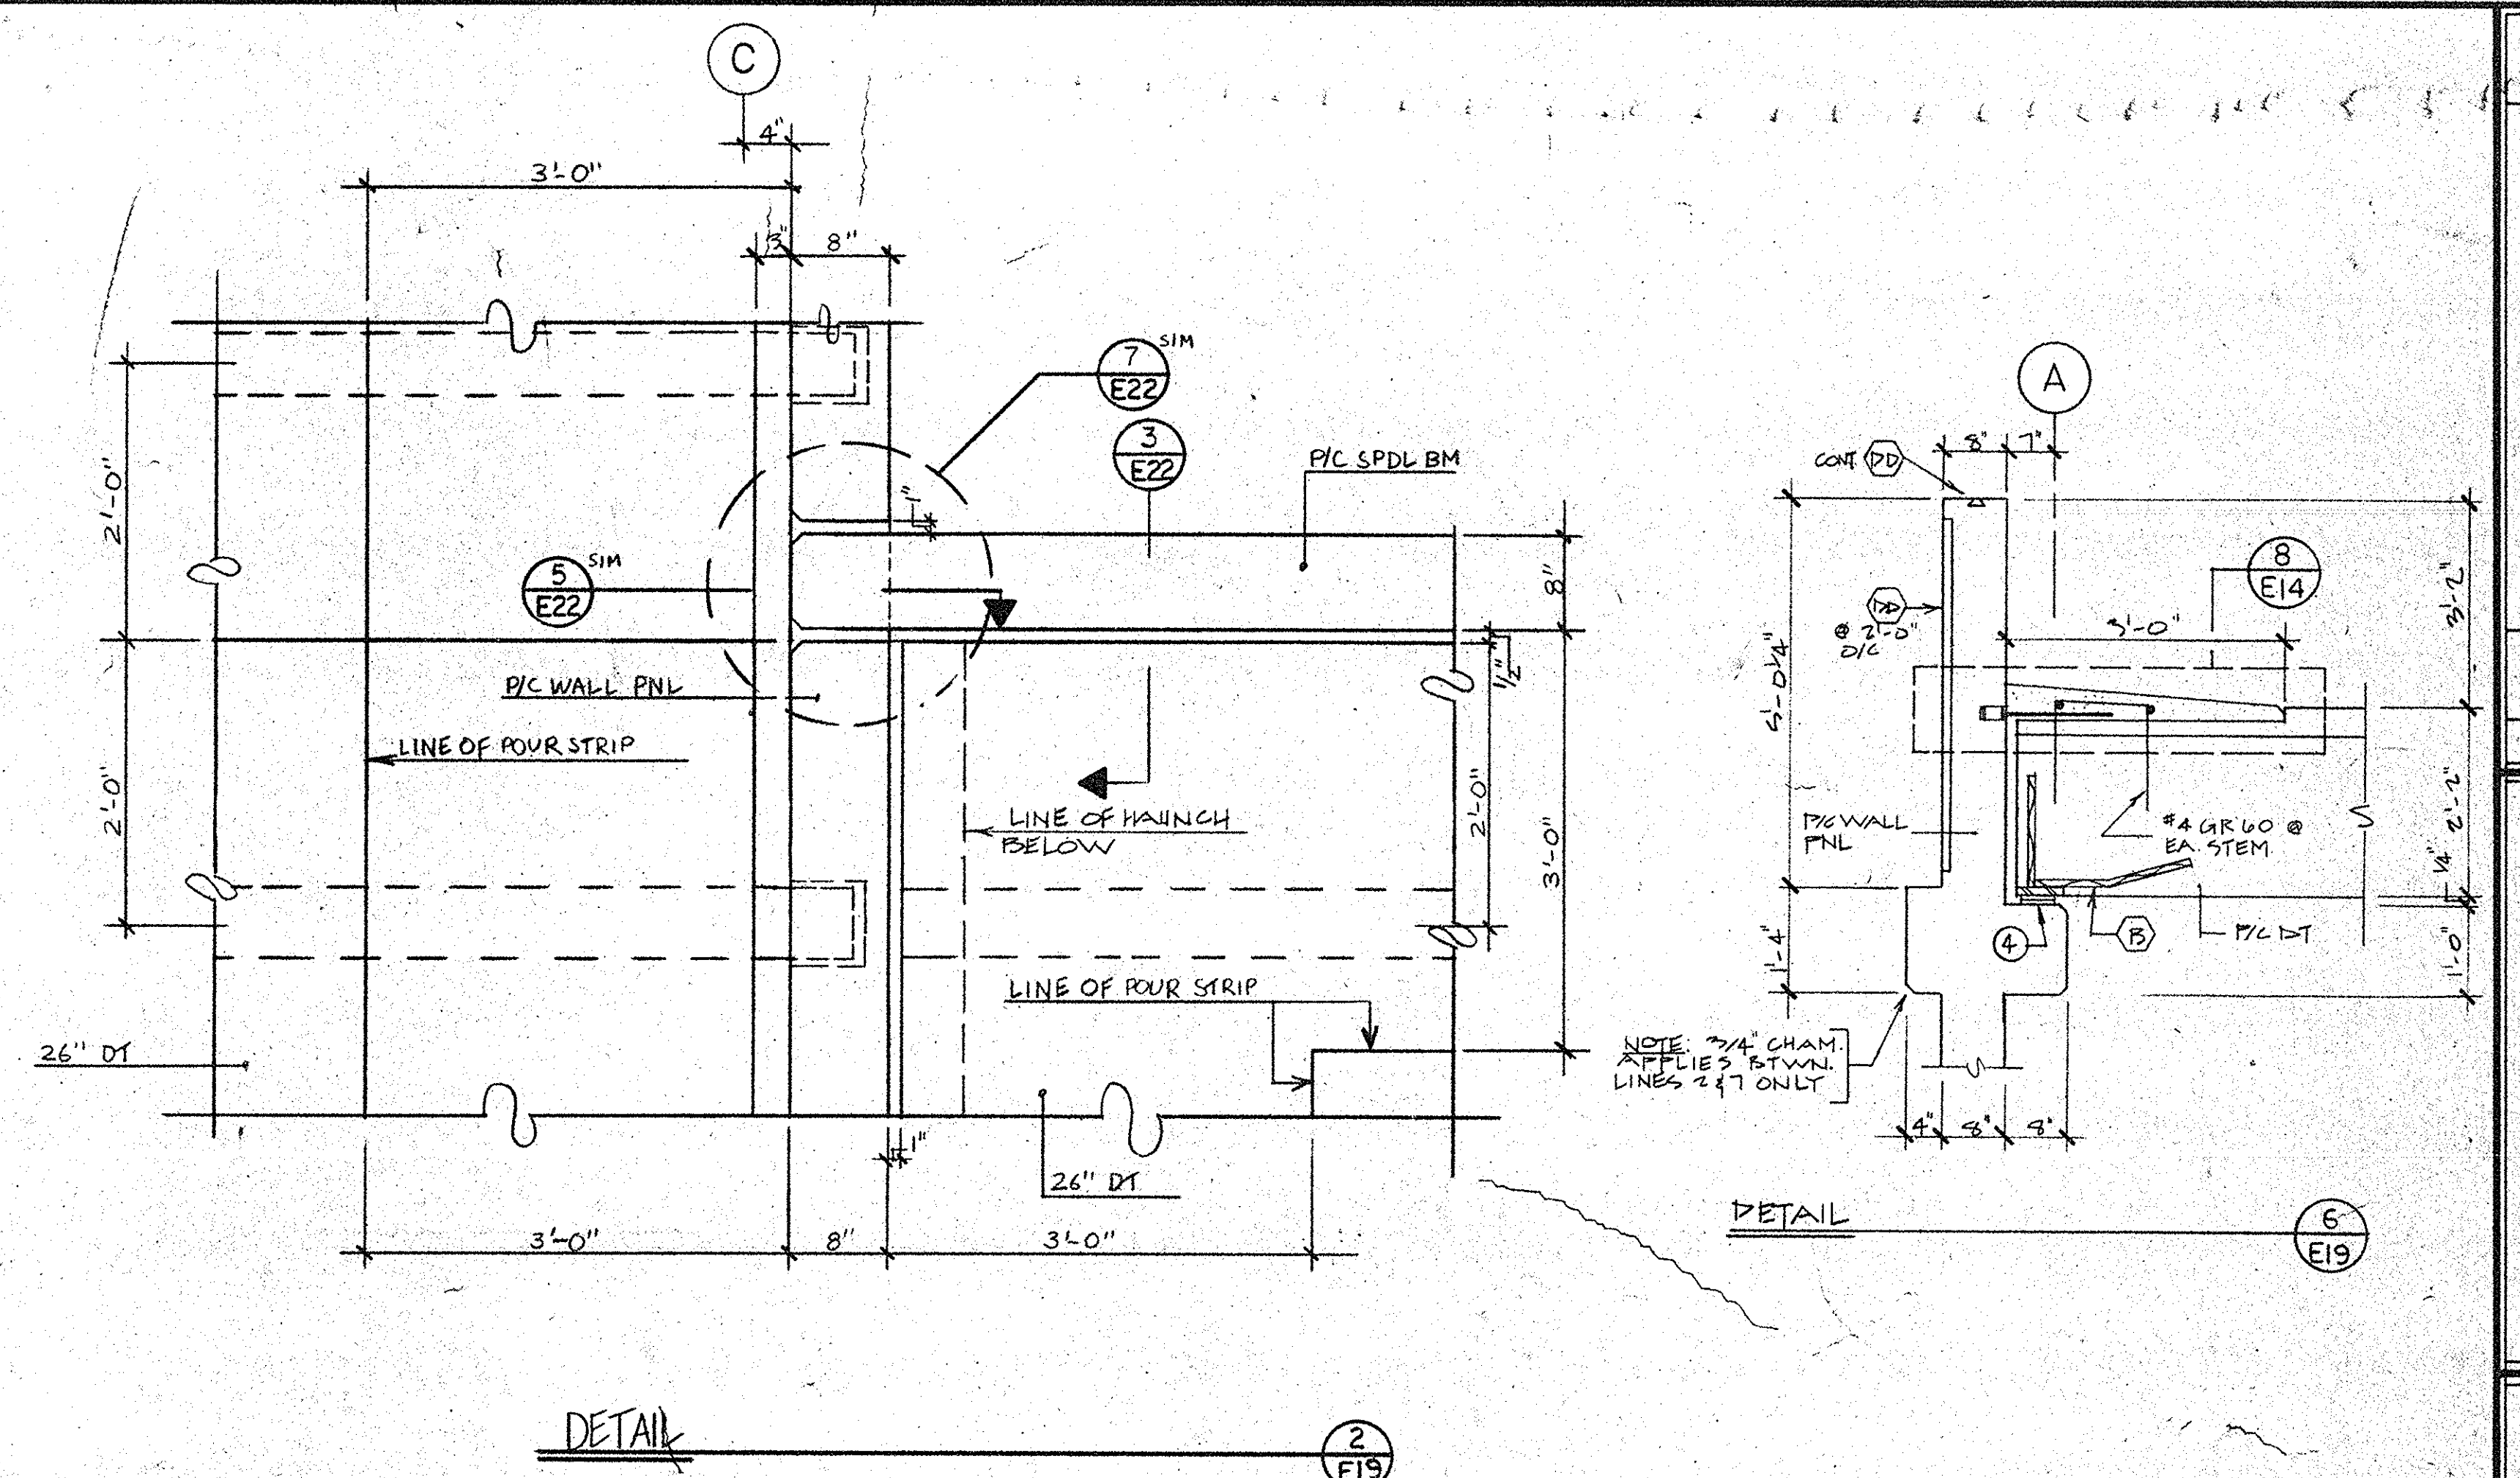
J. Vinton Schafer & Sons
RECORD DRAWING
DATE: 5/2/88

APPROVED (✓)
 APPROVED AS CORRECTED ()
 REVISE AND RESUBMIT ()
 NOT APPROVED ()

CHECKING IS ONLY FOR CONFORMANCE WITH THE
 SIGN CONCEPT OF THE PROJECT AND GOVERN
 WITH THE INFORMATION GIVEN IN THE CONTRACT
 DOCUMENTS. CONTRACTOR IS RESPONSIBLE
 DIMENSIONS BE CONFIRMED AND CORRELATED
 THE JOB SITE. FOR INFORMATION THAT PERTAIN
 TO THE PREDICATION PROCESSES OR
 TECHNIQUE CONSTRUCTIONS, AND FOR COMPLETION
 OF THE WORK OF ALL TRADES.

UNIVERSITY OF MARYLAND AT BALTIMORE

DATE: 5/27/87 BY: [Signature]

RTKL Associated Inc.

Approval is for design only. Contractor is responsible for dimensions, quantities and coordination with all trades. Approval does not authorize changes to contract requirements unless accompanied by a Change Order.

☒ Approved	☐ Disapproved
☐ Approved as noted	☐ Returned for correction
☐ Rejected	☐ Resubmit

By: **V.K.Z.** Date: **1.2.97**

☐ Architectural	☒ Engineering
--	---

[illegible]

PROJECT:		PEARL STREET GARAGE BALTIMORE, MARYLAND	
DRAWN:		R.B.R.G. BY <i>JSK</i>	
CHECKED:		4-15-80 BY <i>GAH</i>	
APPROVED:		BY	
GENERAL CONTRACTOR:		J. VINTON SCHAFERSONS	
ARCHITECT:		JOEL	
CONSTRUCTION:		DOMINIC T. STELL	
PROJECT NO.:		6003	
DWG. NO.:		E-20	



**CONCRETE
BUILDING
SYSTEMS**


PO BOX 488 DEL MAR, CAL
92008-0488 (619) 346-6060




**PCI
CERTIFIED
PLANT**

1018-19


NO.	DATE	REVISION/SECTION
2	11-22-80	REVISED PER APPROVED DRAWINGS DATED 11-22-80. RE-REQUISITED FOR FINAL APPROVAL.
1	8-25-80	SENT TO ARCHITECT FOR APPROVAL.
	8-24	

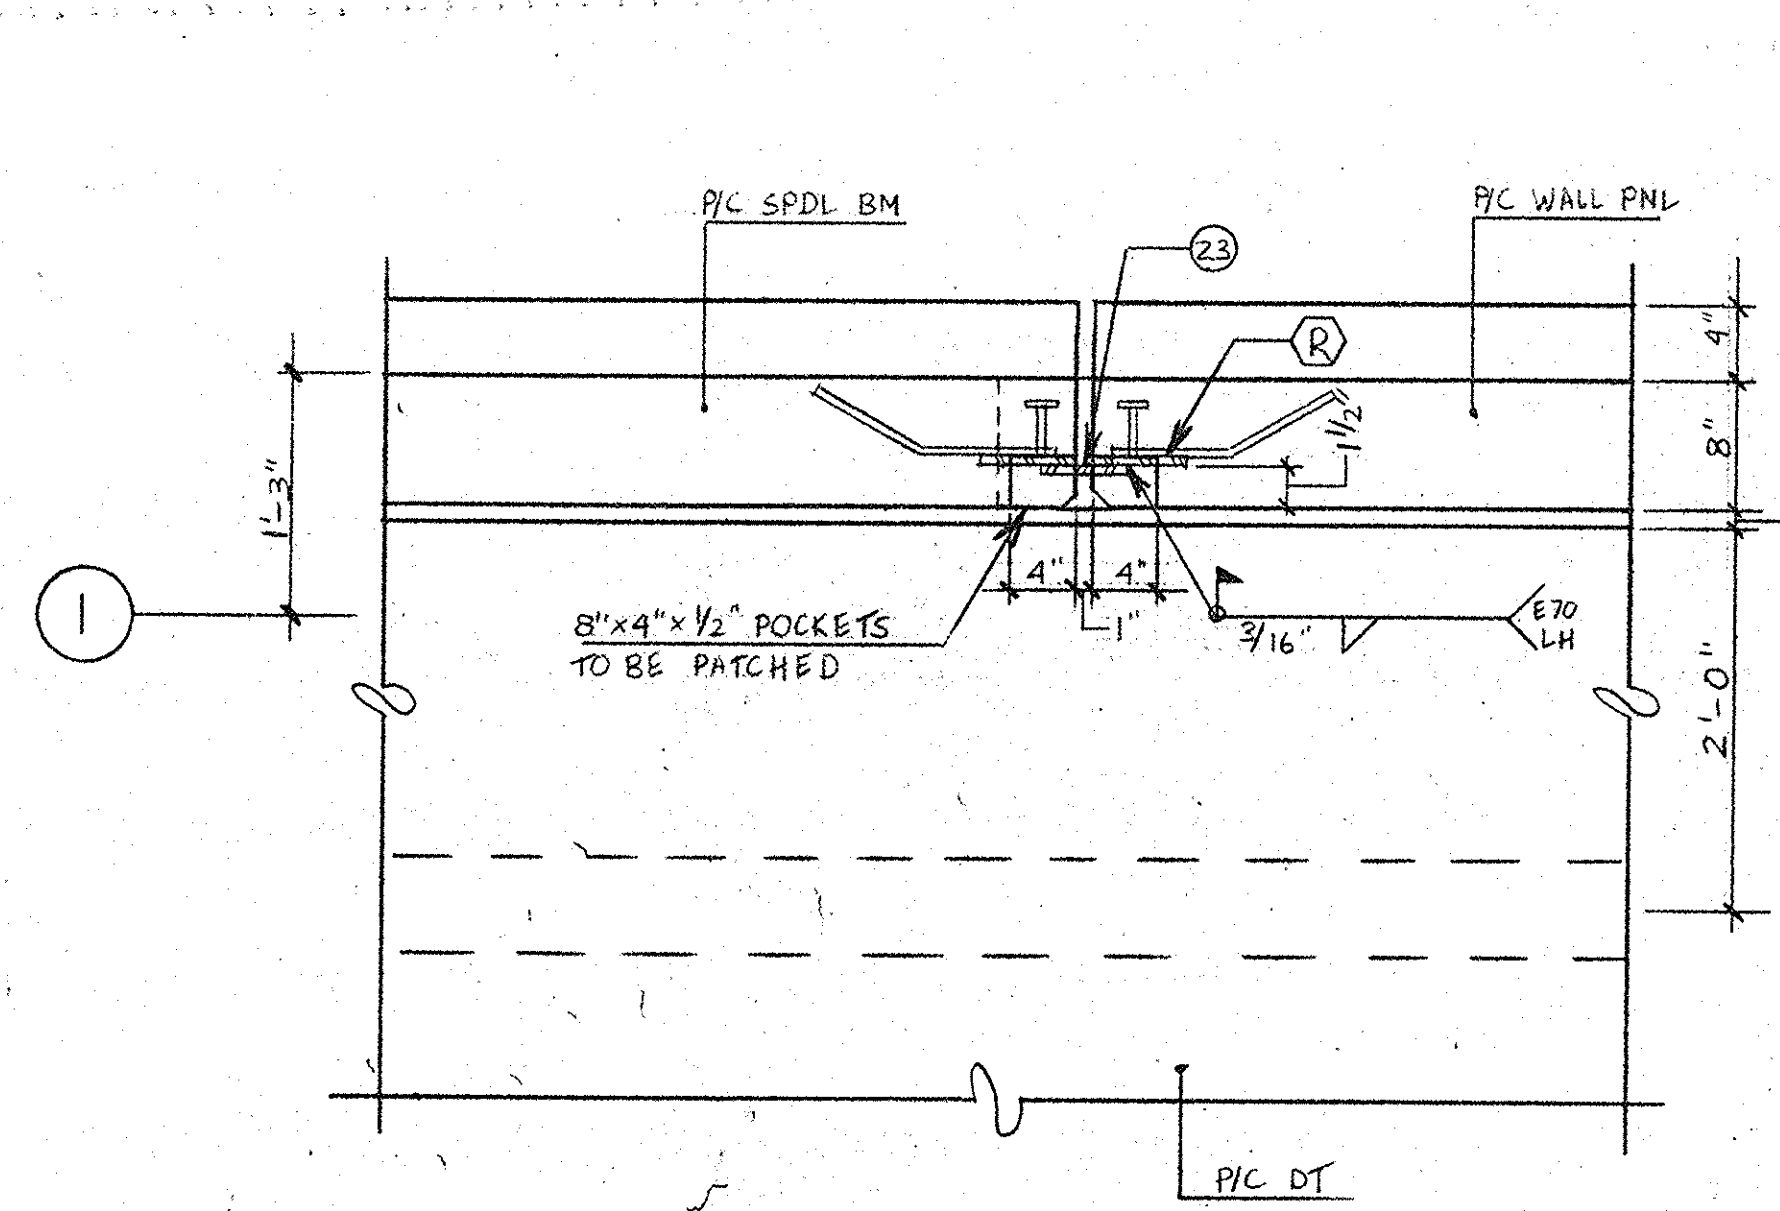


SECTION

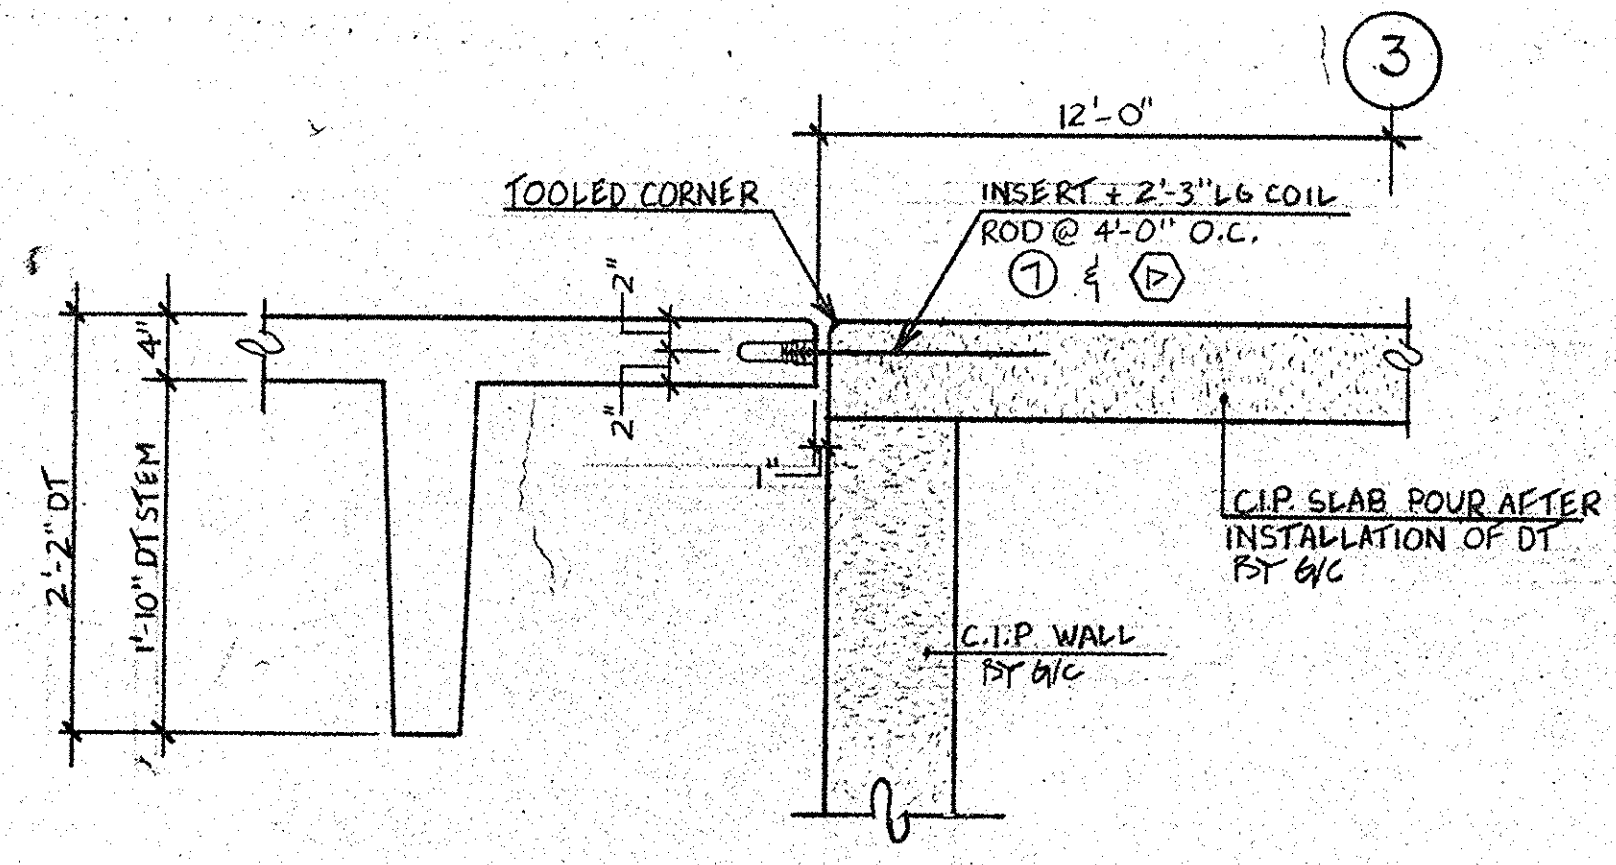


SECTION

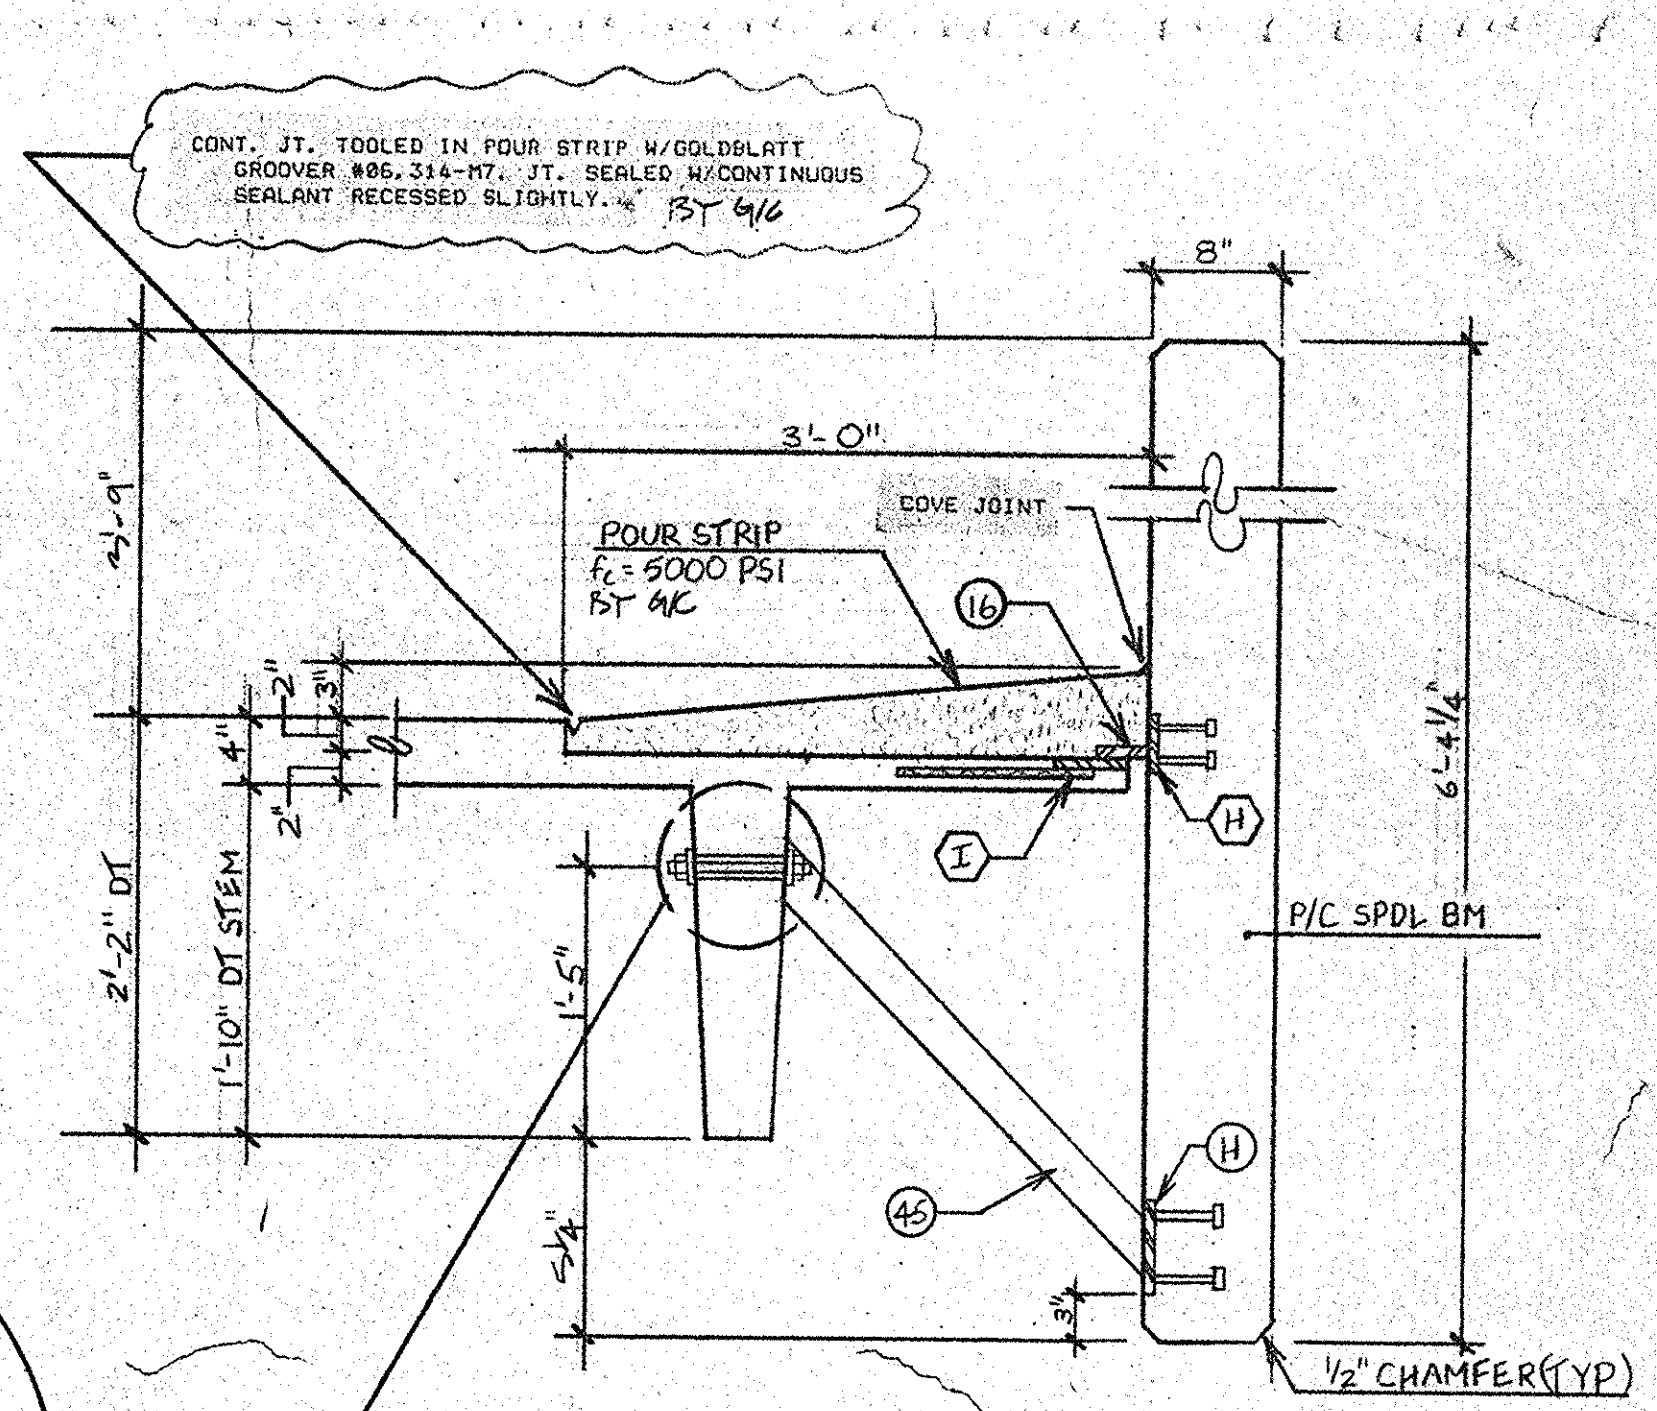


SECTION

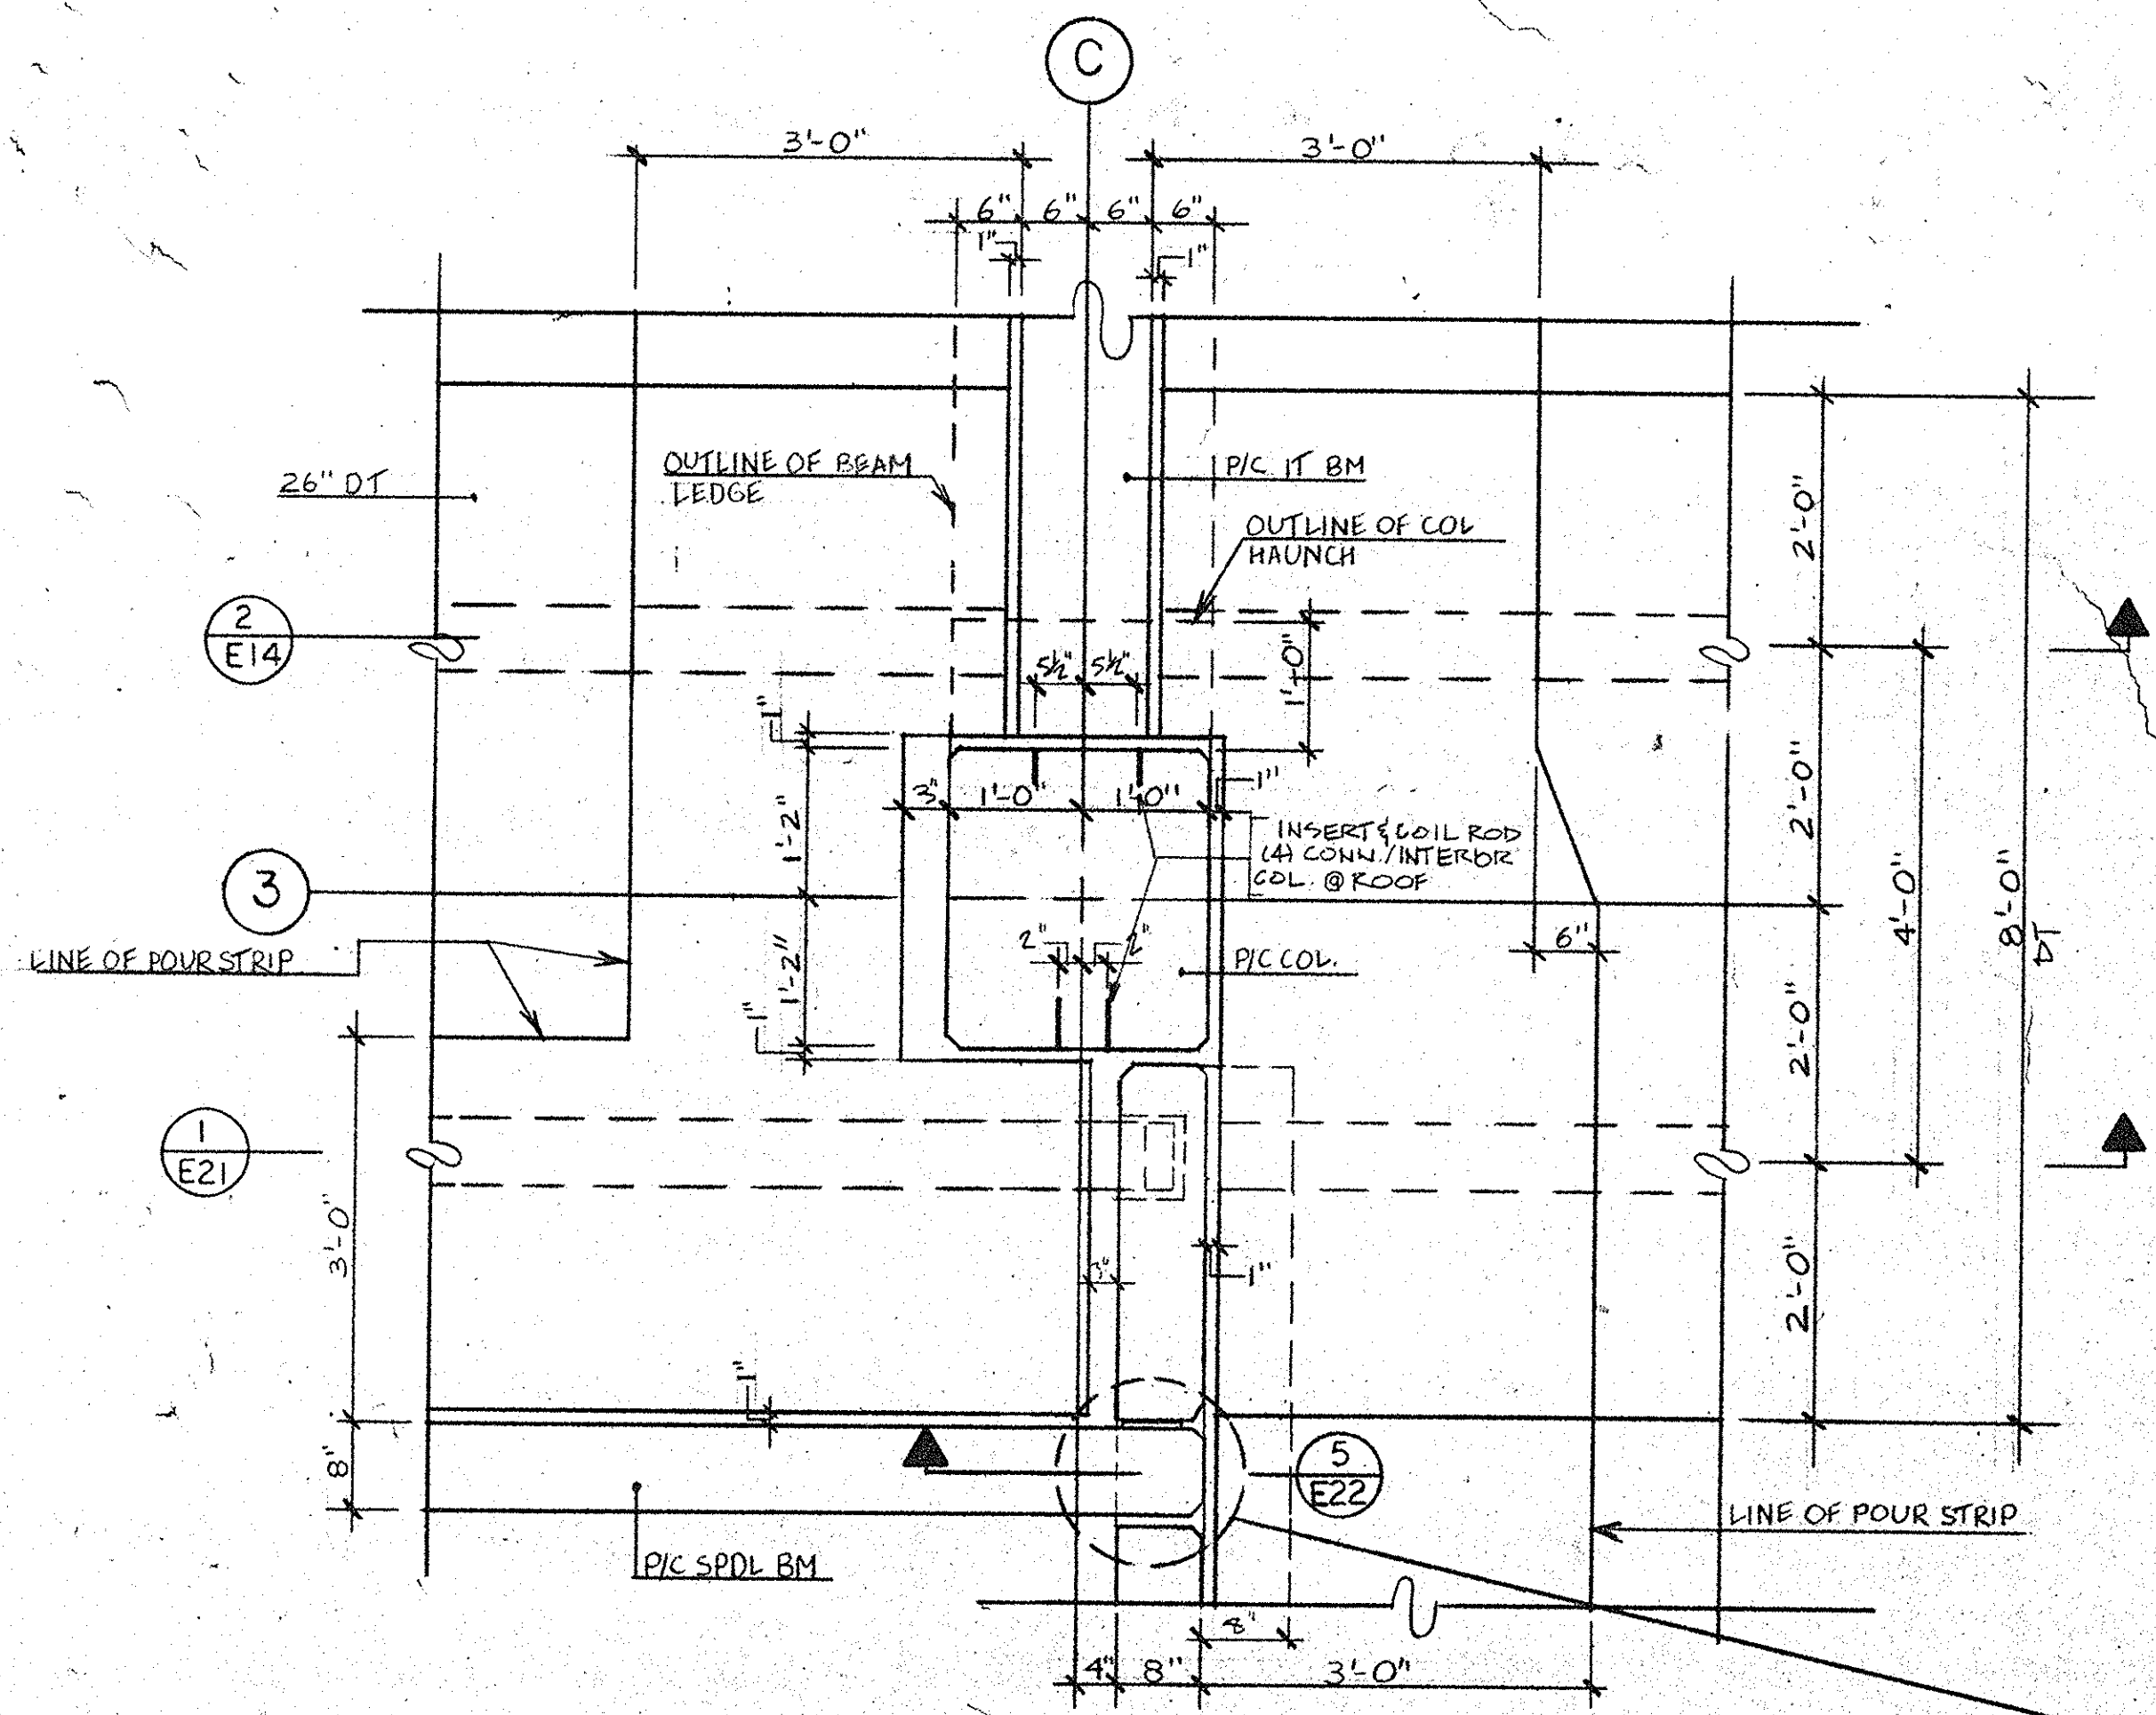


DETAIL

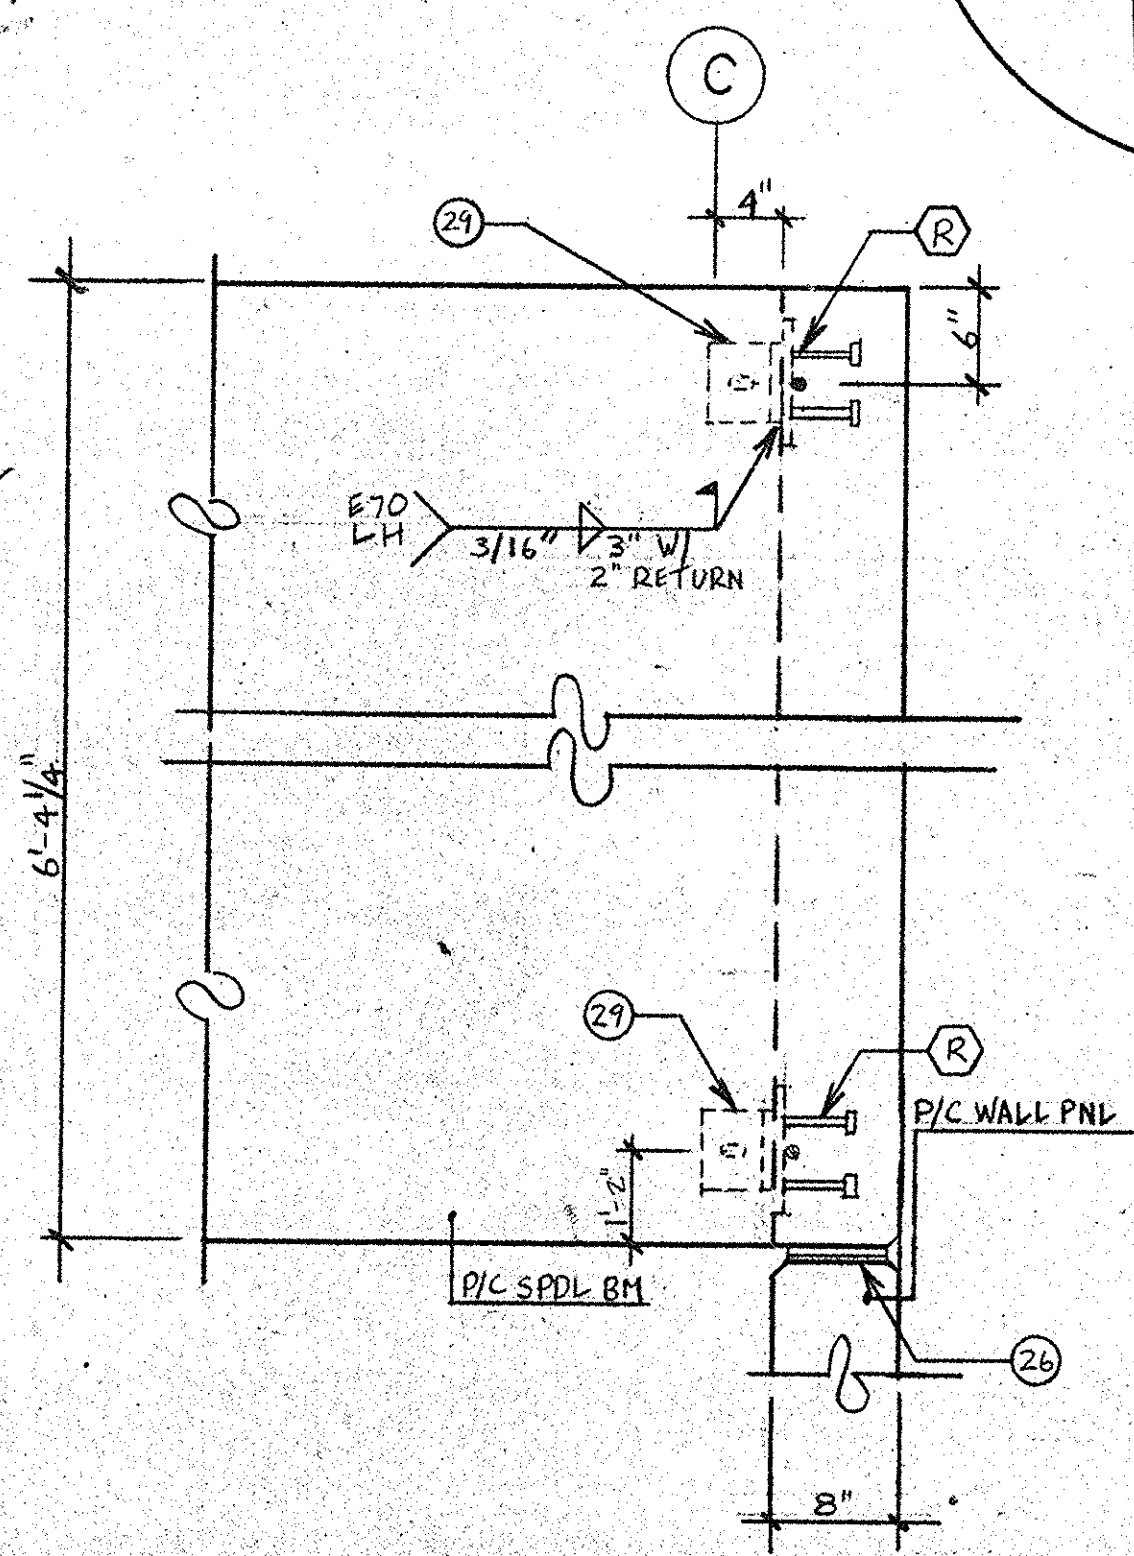

SECTION

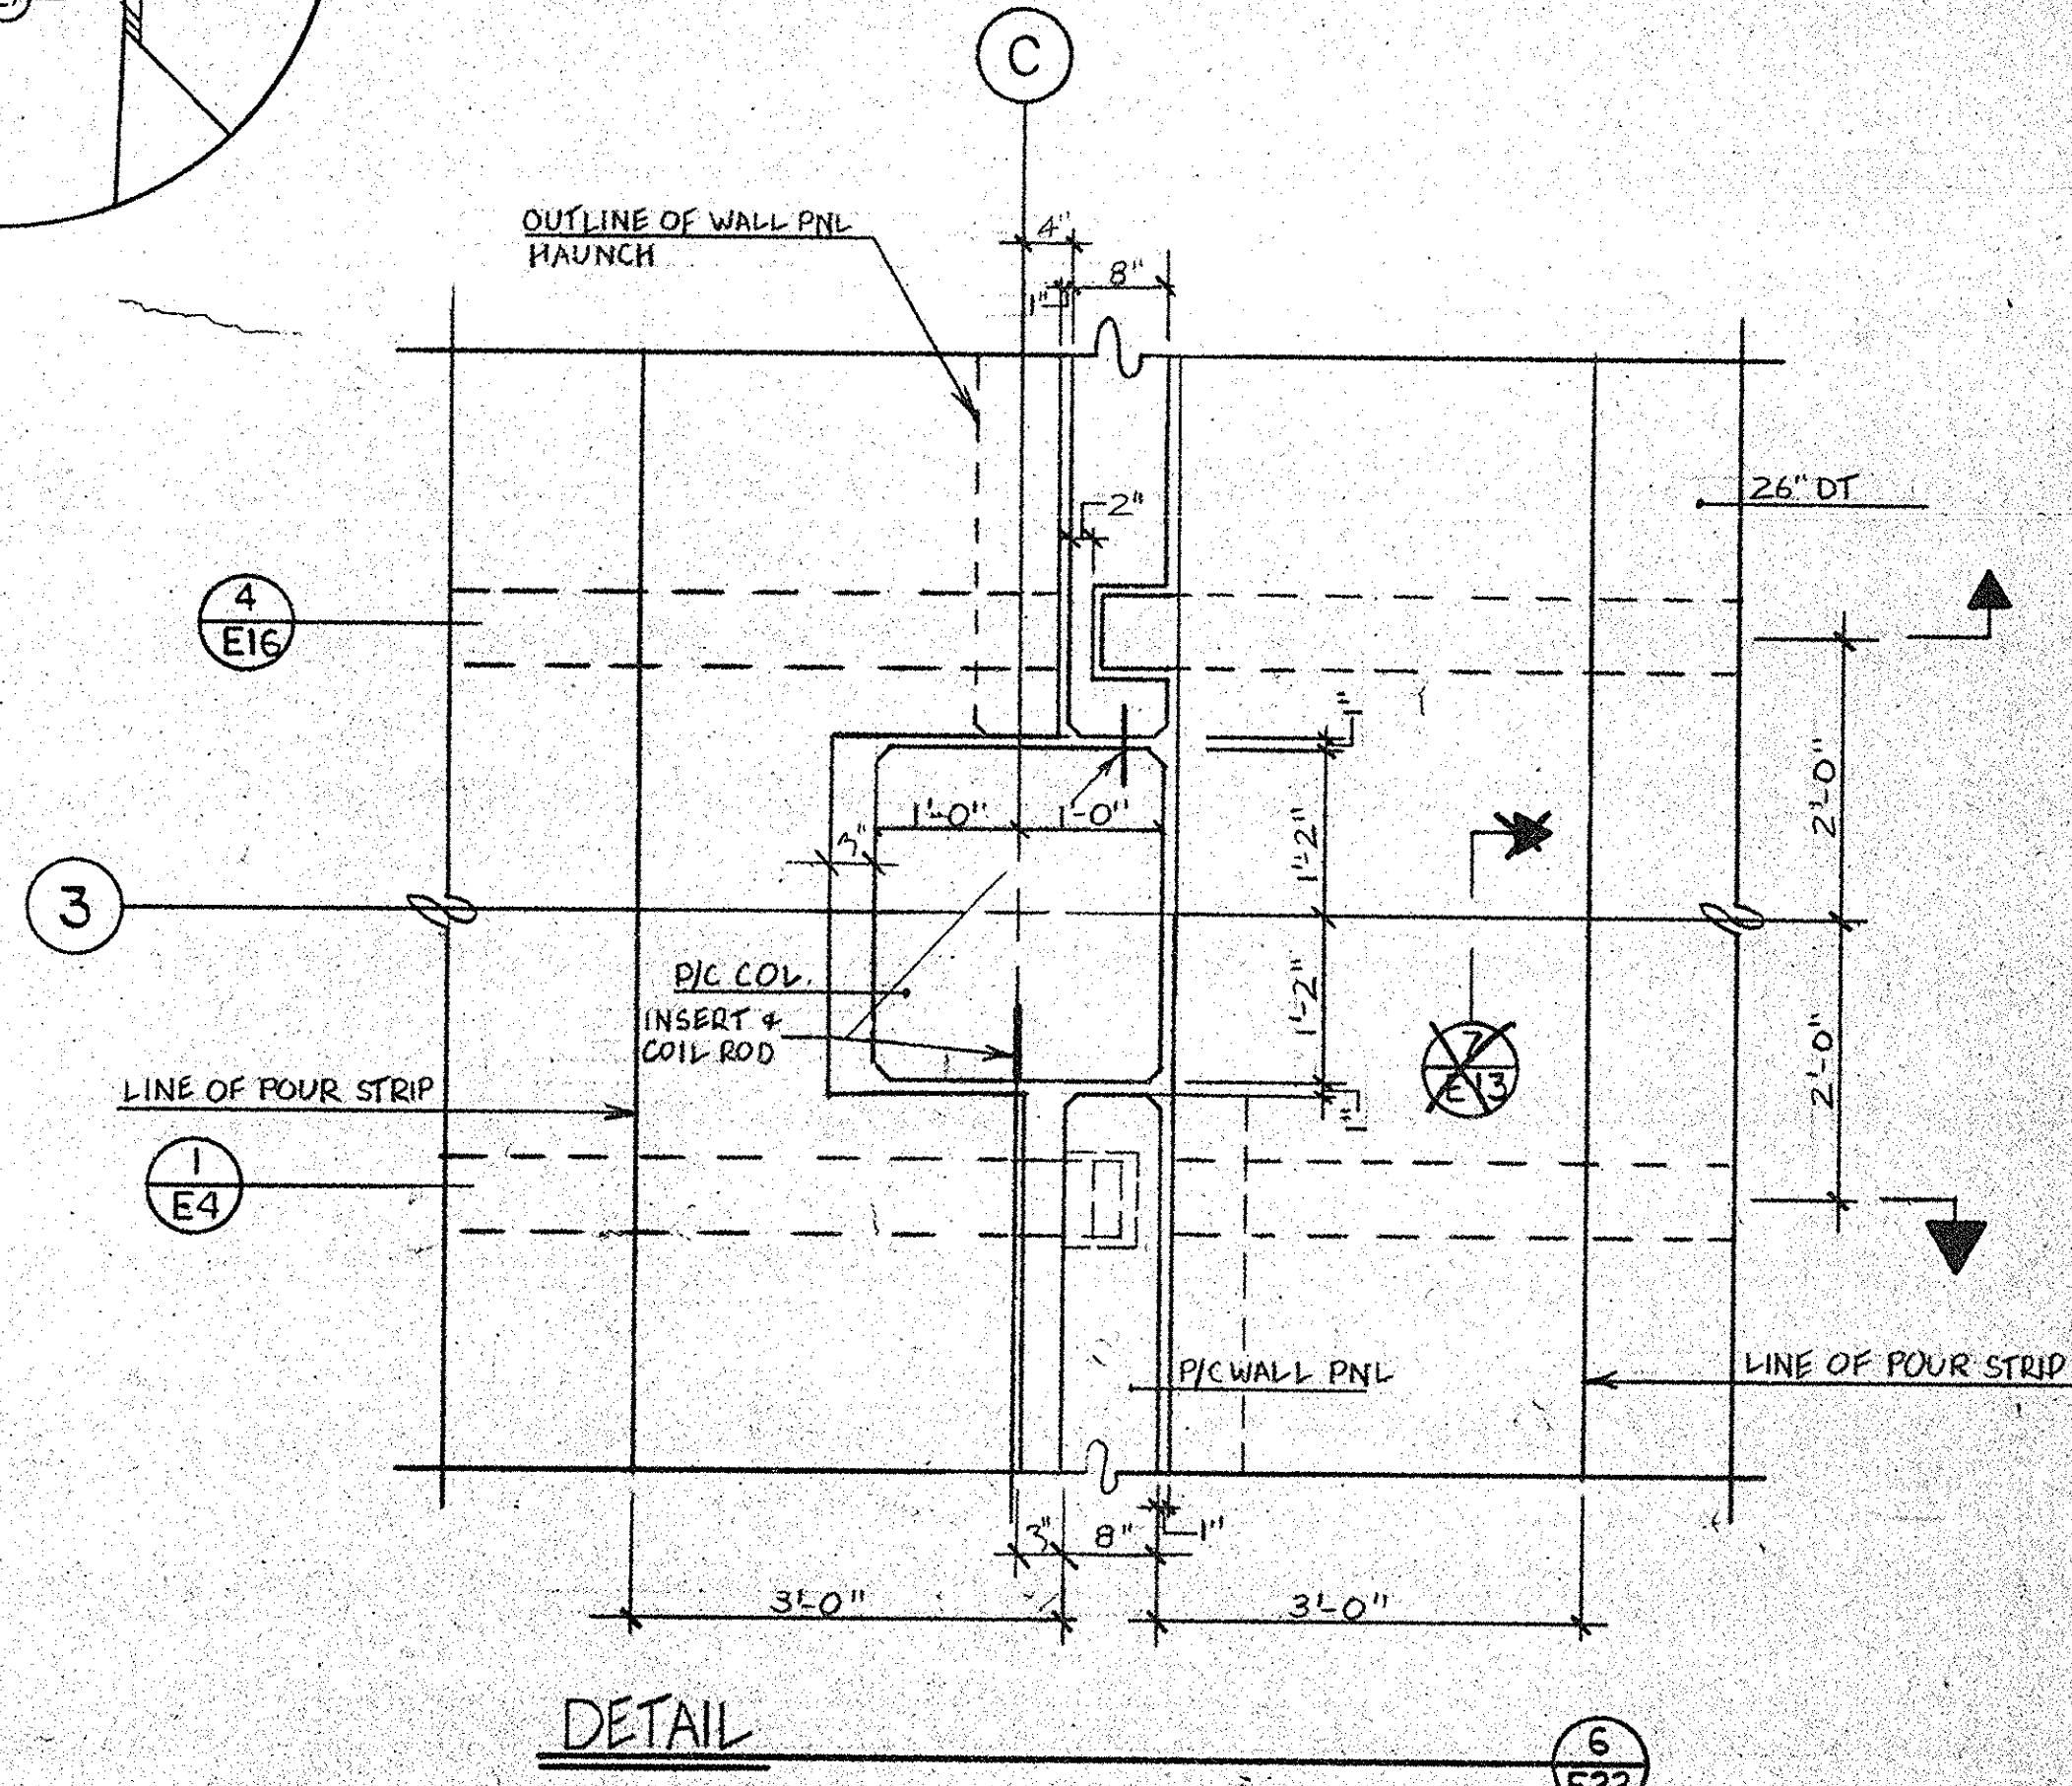

DETAIL

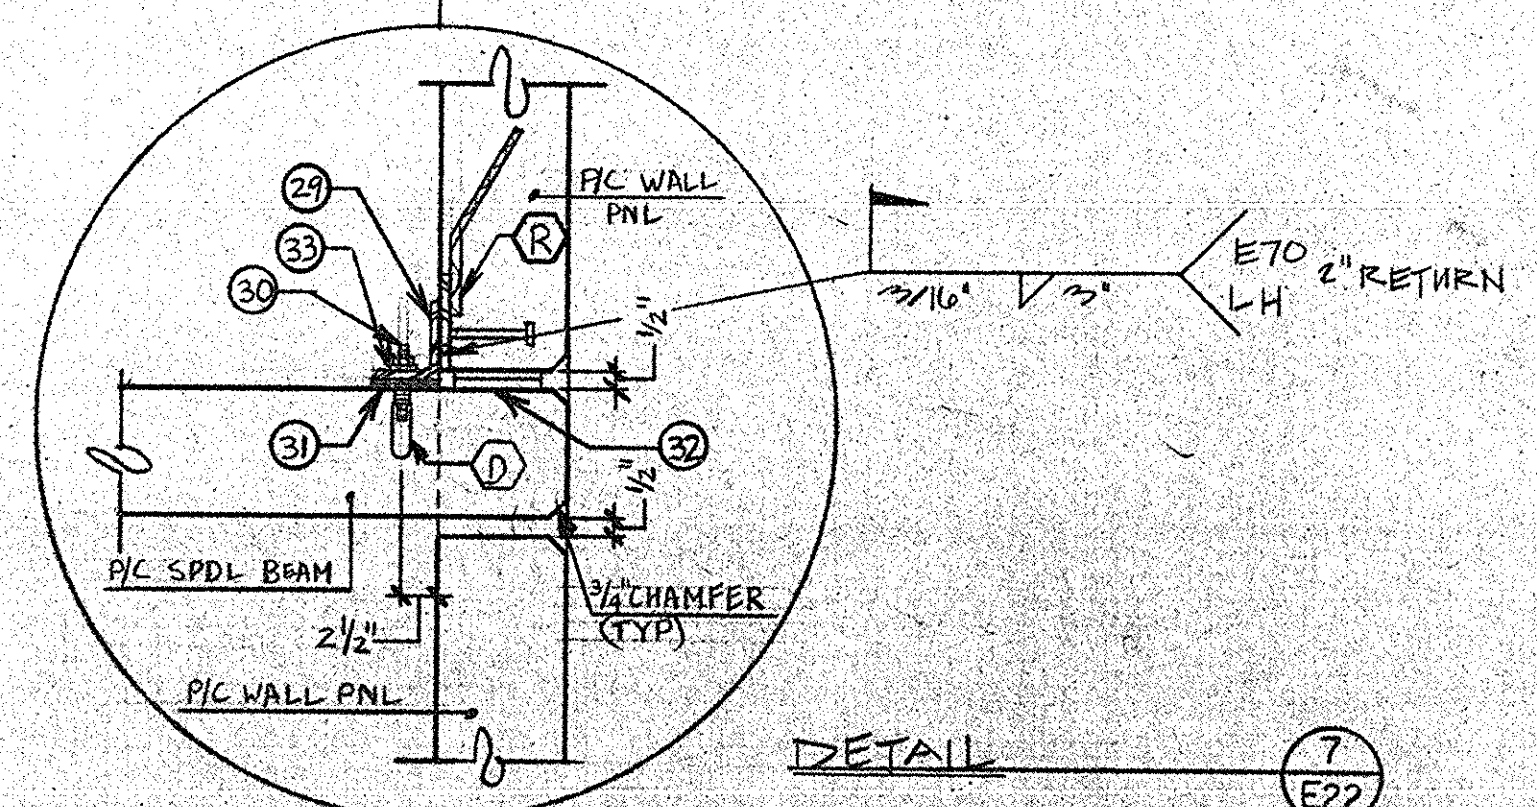

DETAIL

APPROVED AS CORRECTED ()
 REVISE AND RESUBMIT ()
 NOT APPROVED ()

CHECKING IS ONLY FOR CONFORMANCE WITH THE DESIGN CONCEPT OF THE PROJECT AND COMPLIANCE WITH THE INFORMATION GIVEN IN THE CONTRACT DOCUMENTS. CONTRACTOR IS RESPONSIBLE FOR DIMENSIONS TO BE CONFIRMED AND CORRELATED AT THE JOB SITE. FOR INFORMATION THAT PERTAINS SOLELY TO THE FABRICATION PROCESSES OR TO TECHNICAL CONSTRUCTION AND FOR COORDINATION OF THE WORK OF ALL TRADES.

UNIVERSITY OF MARYLAND AT BALTIMORE
 OFFICE OF FACILITIES MANAGEMENT

DATE: 5/17/87


RECORD DRAWING
 DATE: 5/2/88

RTKL Associates Inc.
 Approved for design only. Contractor is responsible for dimensions, quantities and coordination with other trades. Approver does not authorize changes to contract requirements unless a separate order is a change order.

Approved as noted. Approved for correction. Approved for revision.

By: [Signature] Date: 11.87
 Title: [Signature] Engineering

REVISIONS 1. 11-2-86 REVISED PER APPROVED DRAWINGS DATED 10-24-86 & 11-17-86. REVISIONS FOR FINAL APPROVAL SENT TO ARCH FOR APPROVAL 11/2/86 2. 11-2-86		NO. DATE 1 11-2-86 2 11-2-86 3 11-2-86
PROJECT: PEARL STREET GARAGE BALTIMORE, MARYLAND ARCHITECT: RTKL J. VINTON SCHAFFERSONS DRAWING TITLE: SECTIONS & DETAILS		
DRAWN: [Signature] CHECKED: [Signature] PROJECT NO.: 6003 DWG. NO.: E-22		

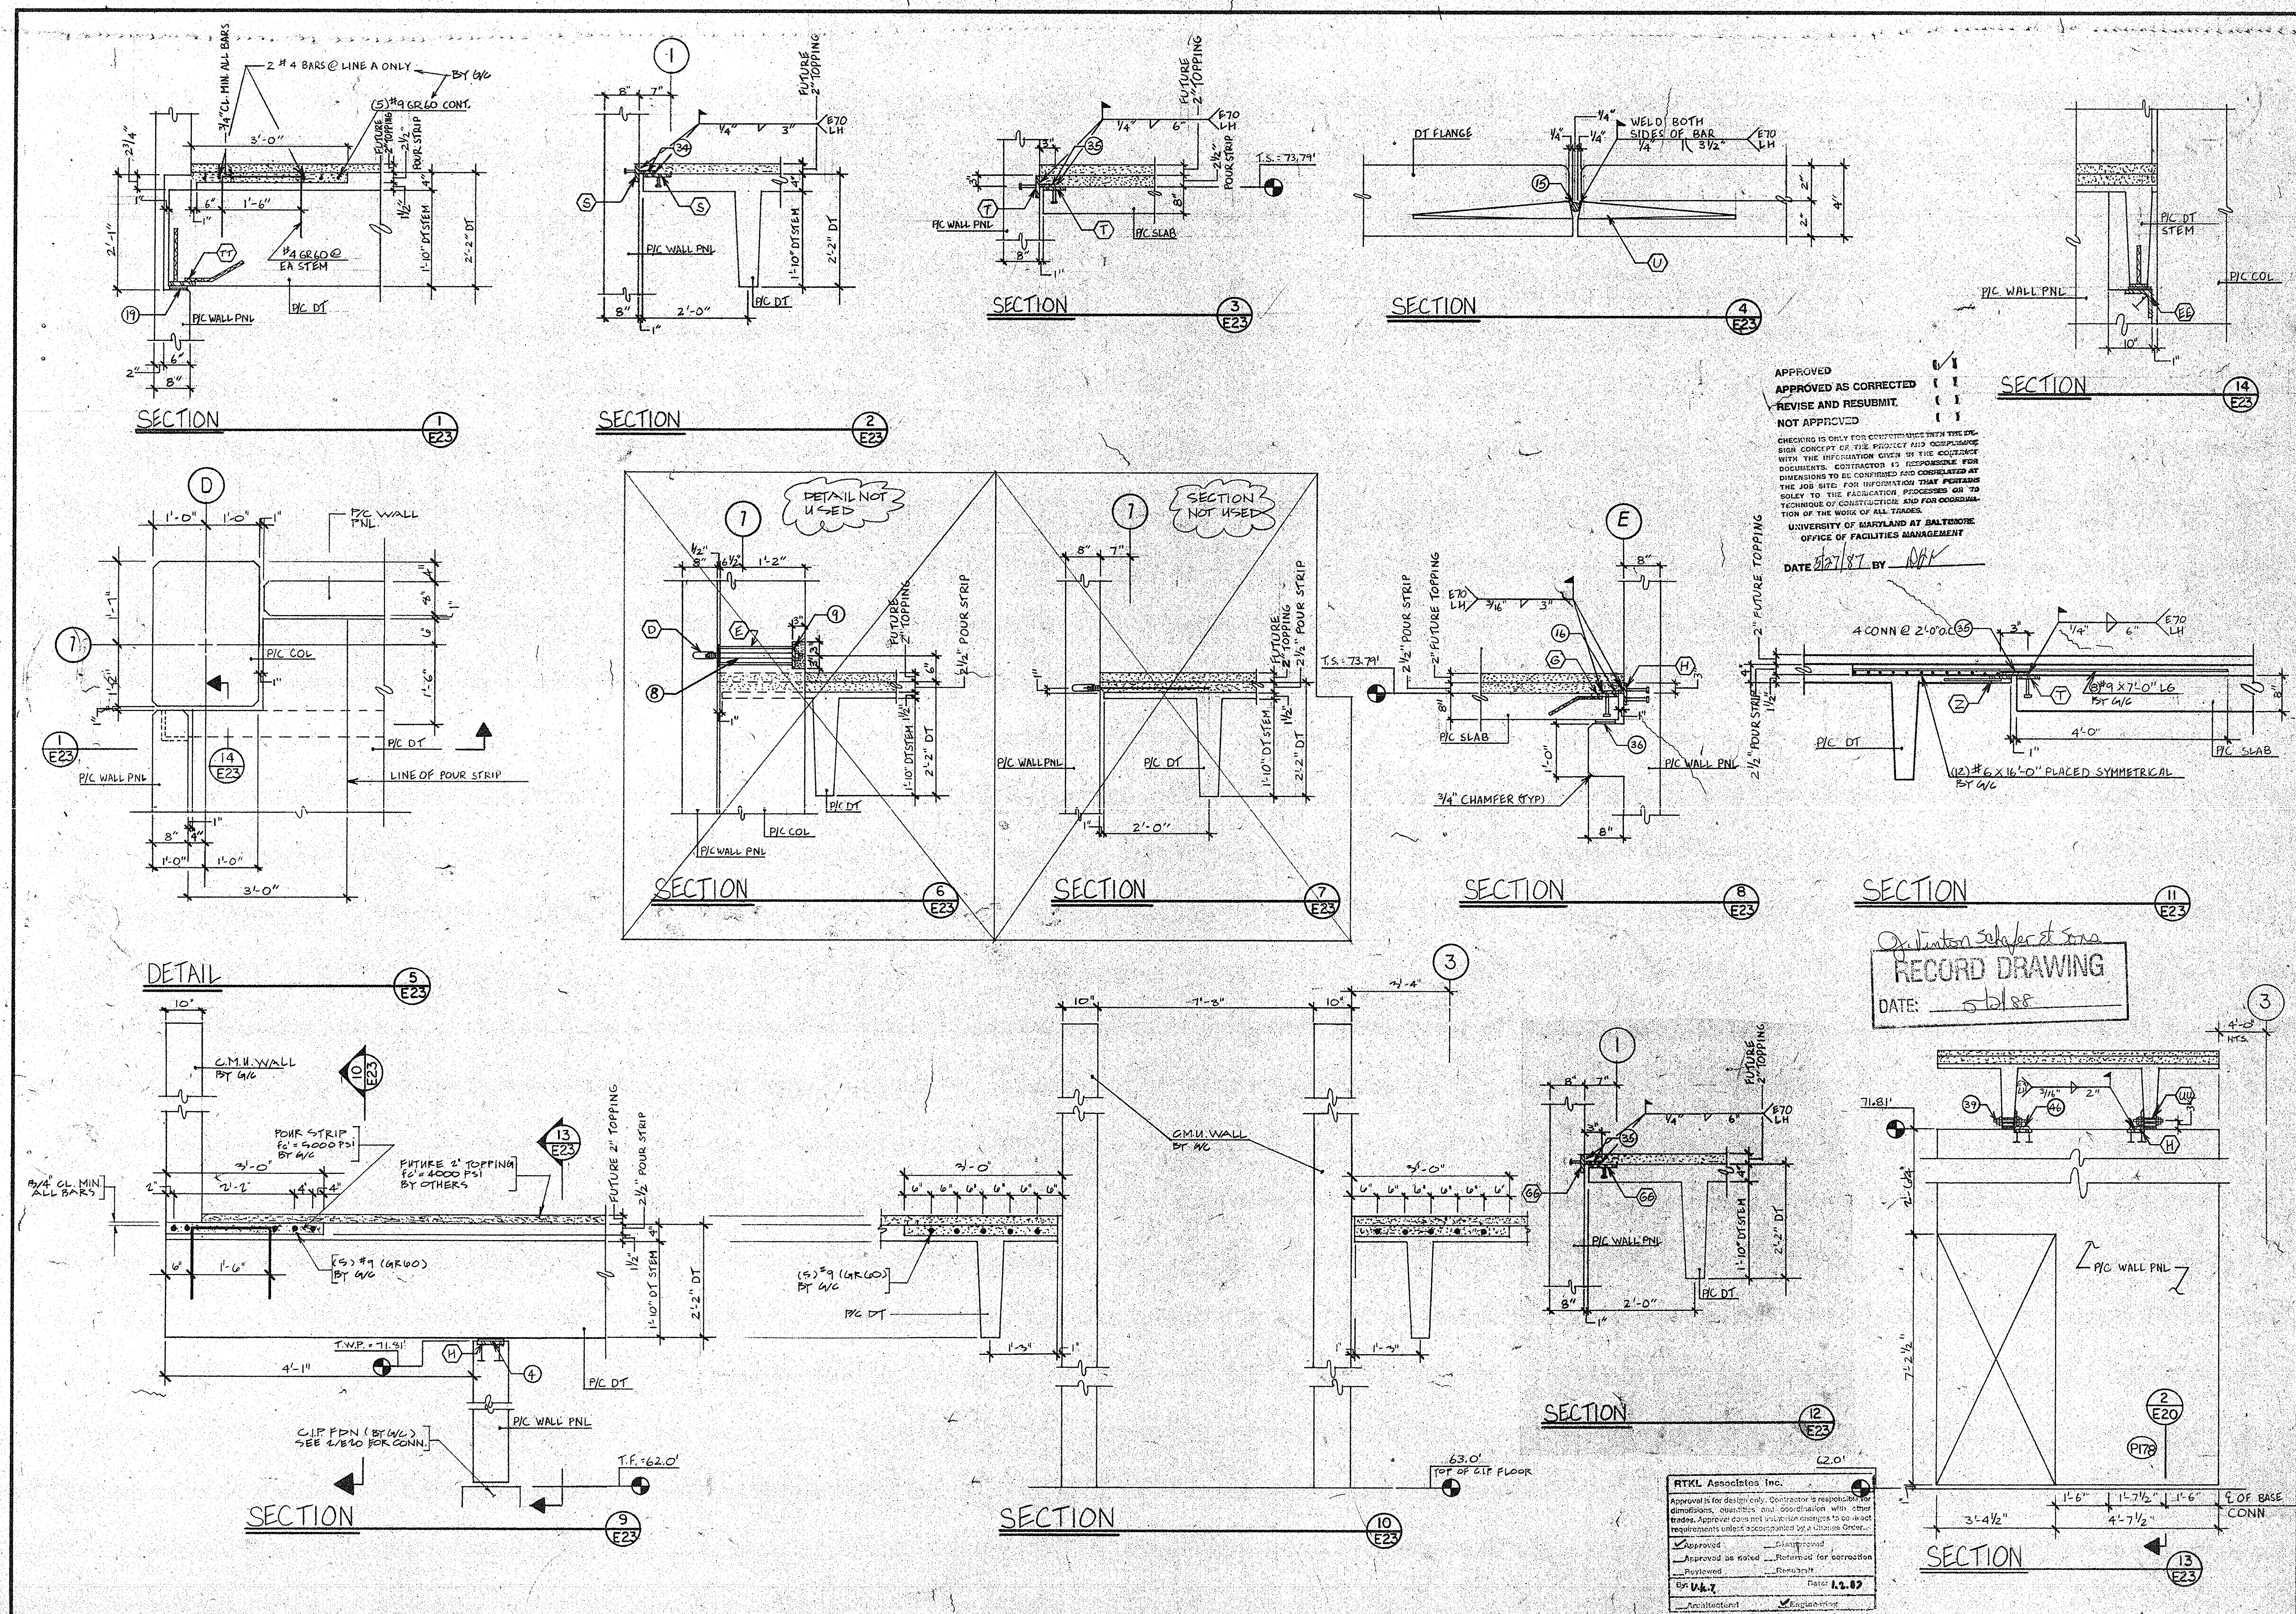

APPROVED AS CORRECTED
REVISE AND RESUBMIT.
NOT APPROVED

6/1
1/1
1/1

CHECKING IS ONLY FOR COMPLIANCE WITH THE DESIGN CONCEPT OF THE PROJECT AND COMPLIANCE WITH THE INFORMATION GIVEN IN THE DOCUMENTS. CONTRACTOR IS RESPONSIBLE FOR DIMENSIONS TO BE CONFIRMED AND COORDINATED AT THE JOB SITE FOR INFORMATION THAT PERTAINS TO THE FABRICATION PROCESSES GO TO SOLELY TO THE FABRICATOR AND FOR COORDINATION OF THE WORK OF ALL TRADES.

UNIVERSITY OF MARYLAND AT BALTIMORE
OFFICE OF FACILITIES MANAGEMENT

DATE 2/27/87 BY [Signature]

Optimization Schaefer & Sons
RECORD DRAWING
DATE: 5/1/88

RTKL Associates, Inc.
Approved for design only. Contractor is responsible for dimensions, quantities and coordination with other trades. Approval does not constitute an endorsement or a guarantee of the design or construction of the project. The contractor shall be responsible for the construction of the project.

Approved as noted. Returned for correction. Resubmitted. Reapproved.

By: [Signature] Date: 11.1.87





Amended/Amendment

PROJECT NO.	6003
DWG. NO.	E-23
PROJECT	PEARL STREET GARAGE BALTIMORE, MARYLAND
ARCHITECT	RTKL
DESIGNER	J. VINTON SCHAEFER & SONS
DATE	5/1/88
REVISION	1. 2/27/87 BY [Signature]
REVISION	2. 11/22/87 BY [Signature]
REVISION	3. 11/22/87 BY [Signature]
REVISION	4. 11/22/87 BY [Signature]
REVISION	5. 11/22/87 BY [Signature]
REVISION	6. 11/22/87 BY [Signature]
REVISION	7. 11/22/87 BY [Signature]
REVISION	8. 11/22/87 BY [Signature]
REVISION	9. 11/22/87 BY [Signature]
REVISION	10. 11/22/87 BY [Signature]
REVISION	11. 11/22/87 BY [Signature]
REVISION	12. 11/22/87 BY [Signature]
REVISION	13. 11/22/87 BY [Signature]
REVISION	14. 11/22/87 BY [Signature]

1018-5

CONCRETE BUILDING SYSTEMS
PC BOX 48, DELAWARE CITY, MD 20646-0048
1984-80 302.946.3645

RTKL ASSOCIATES, INC.
1018-5

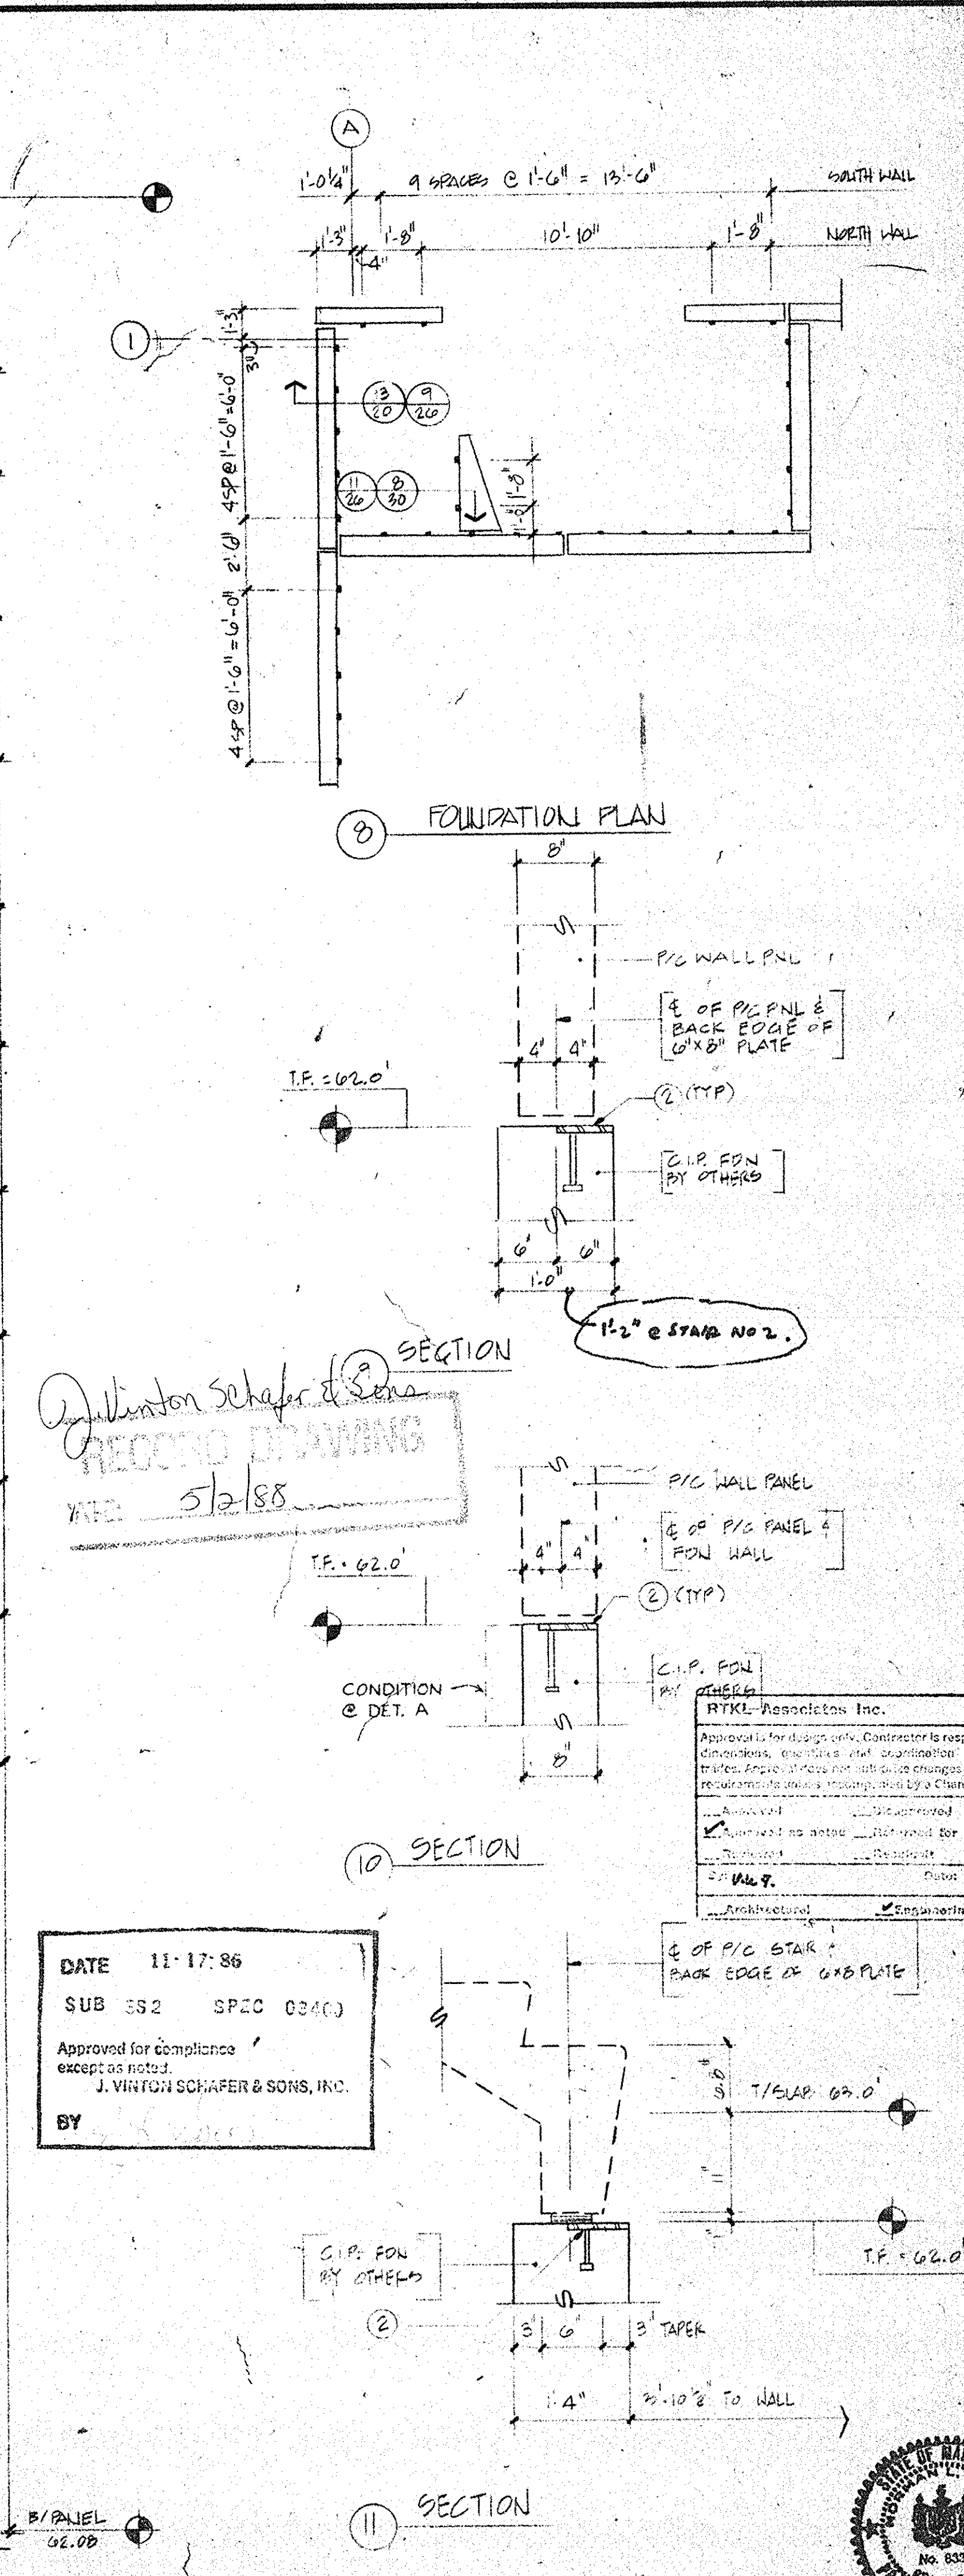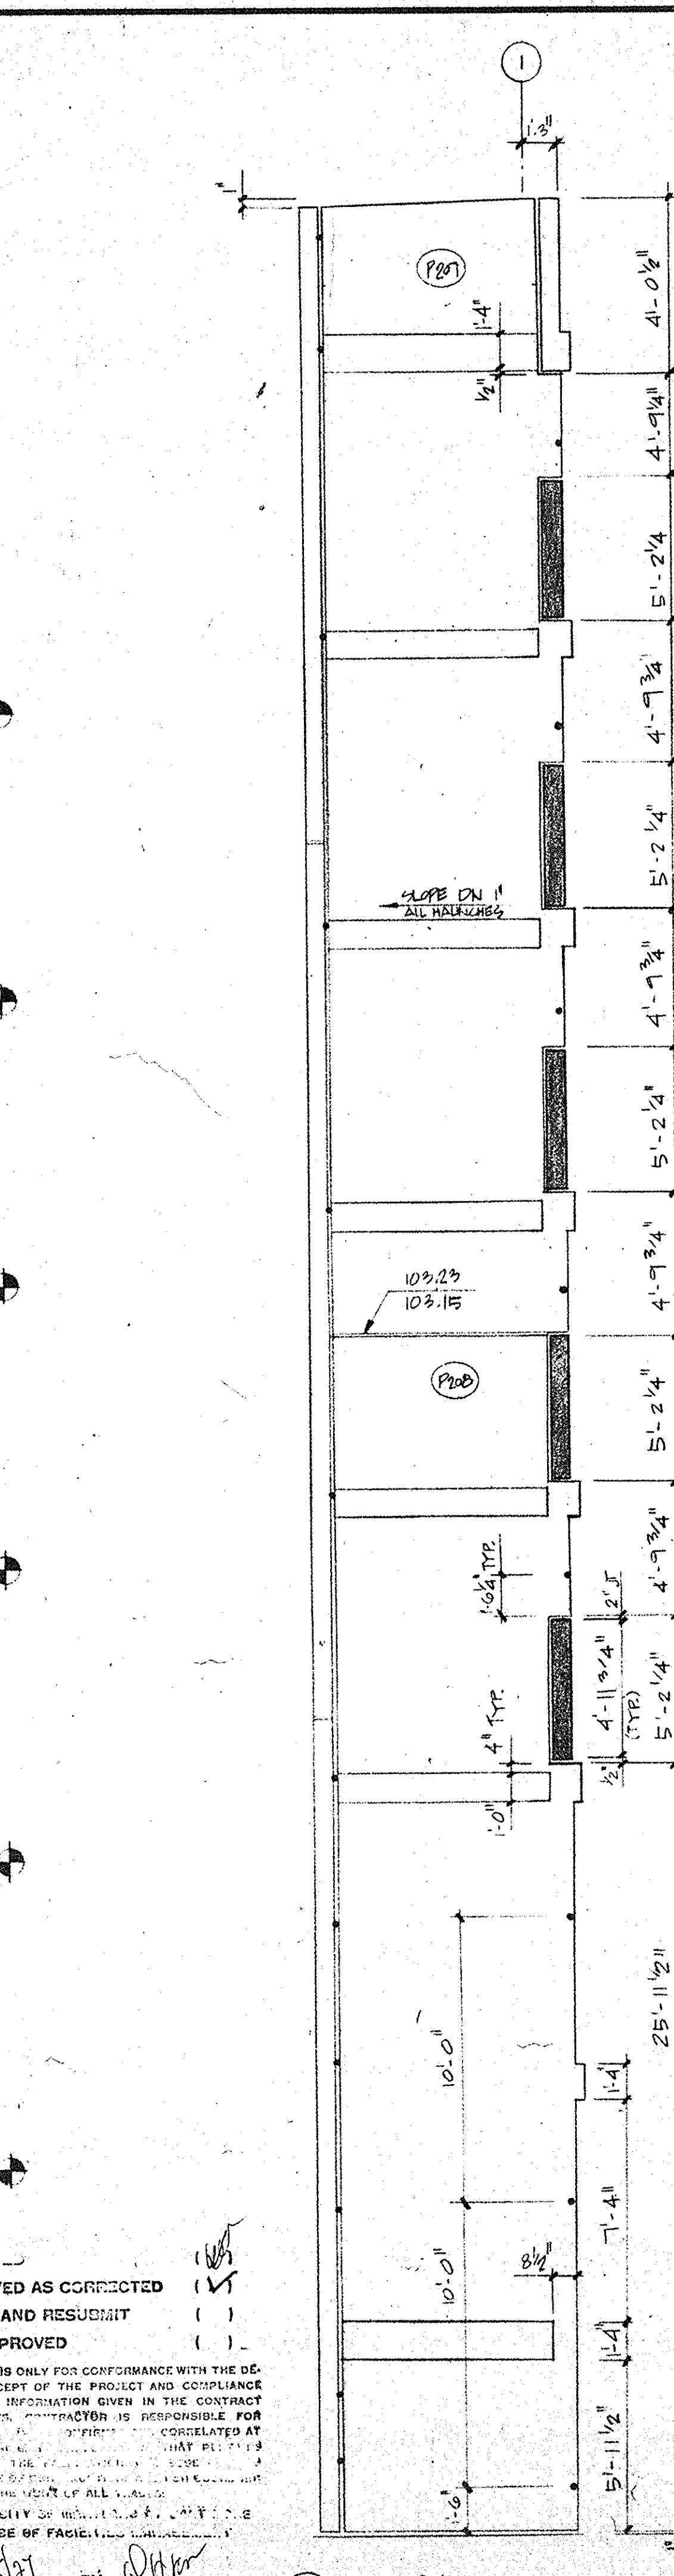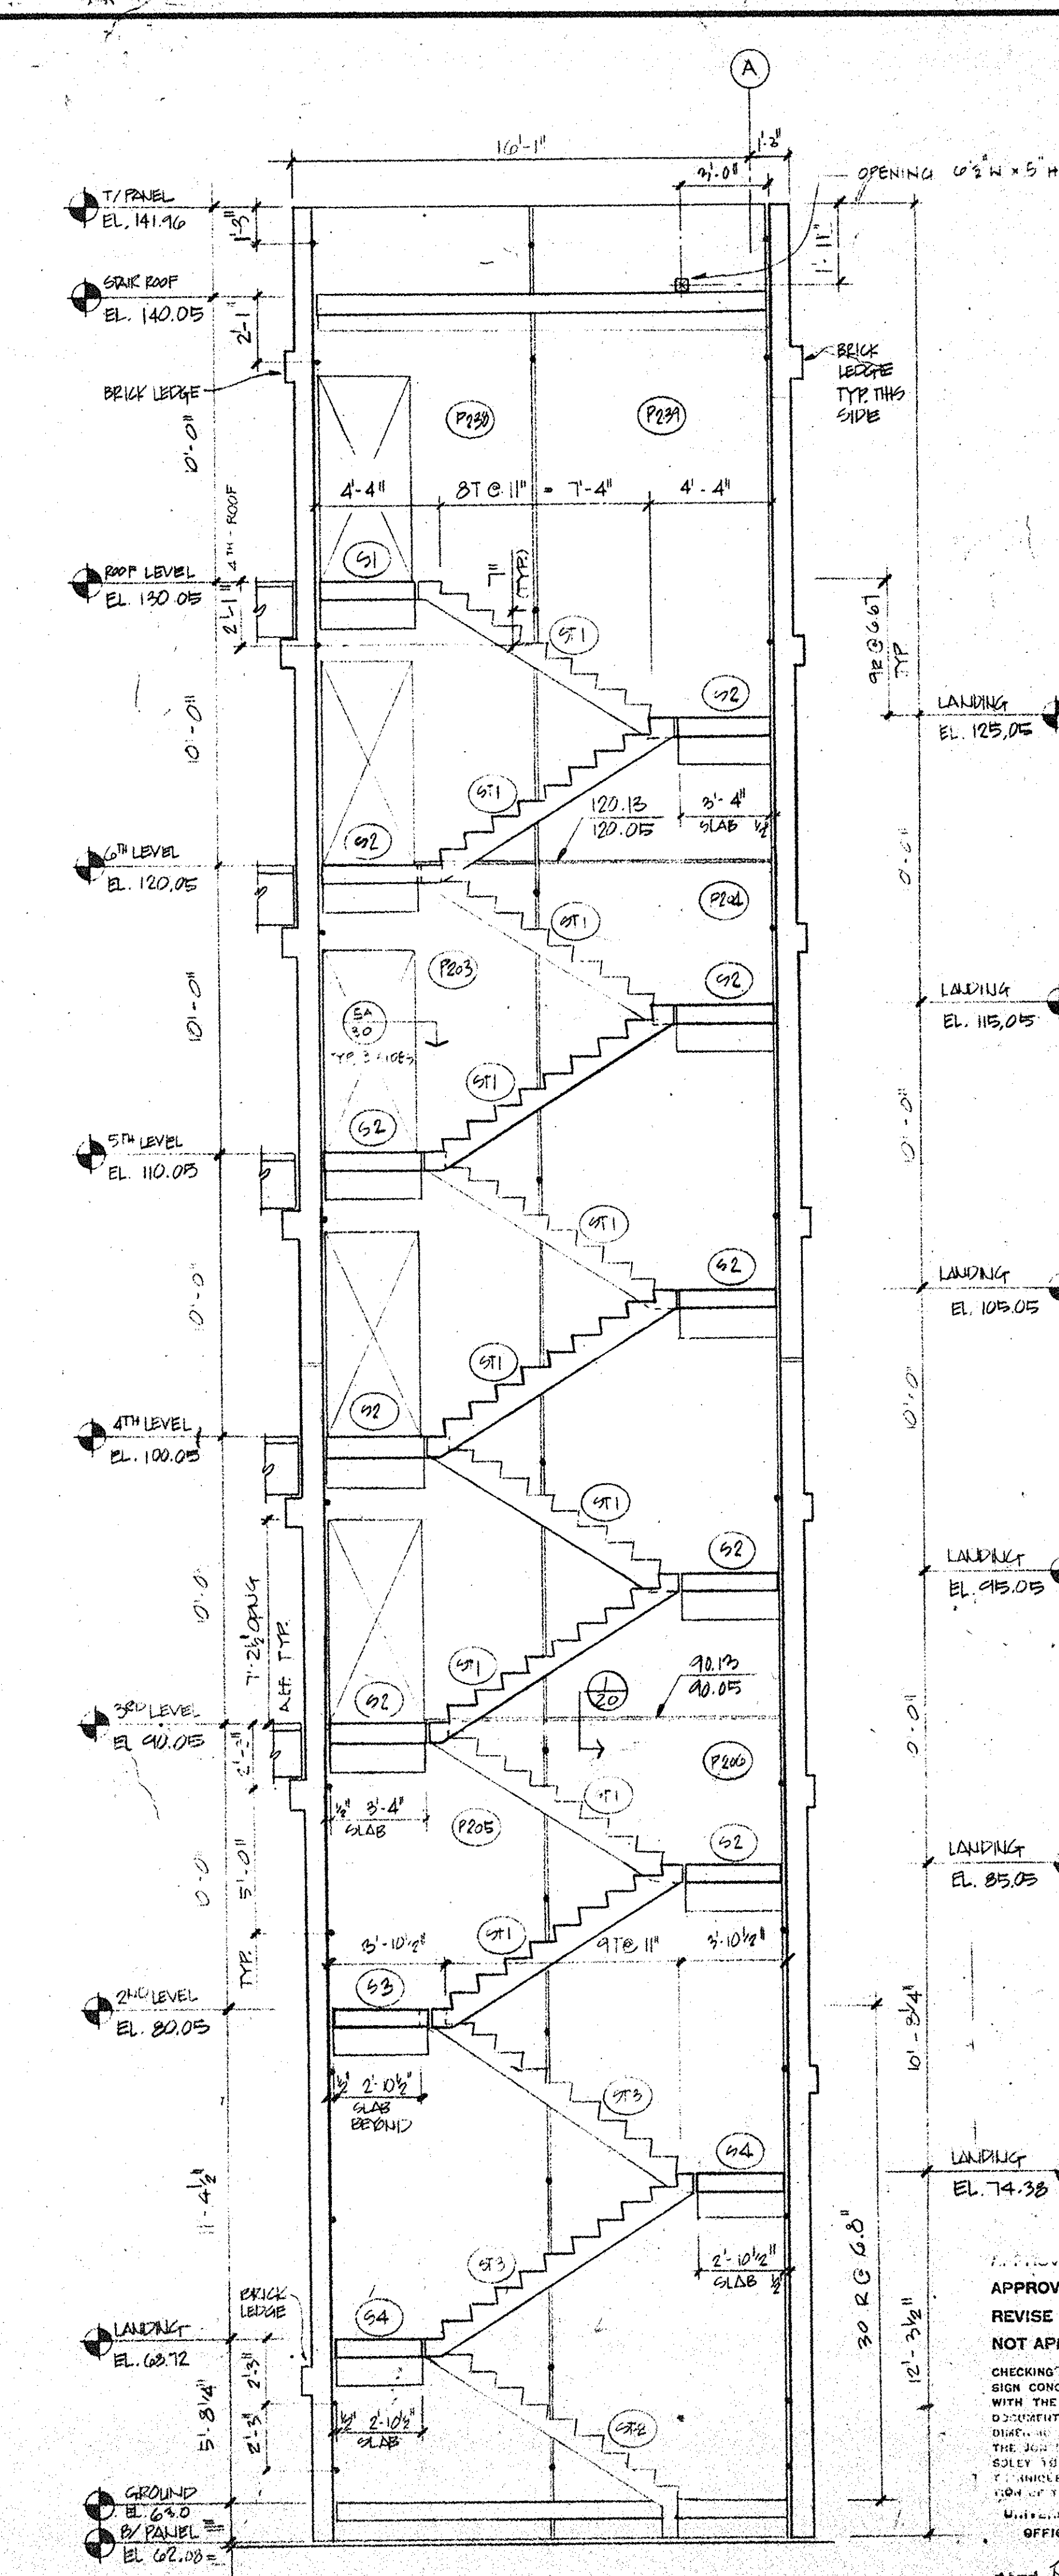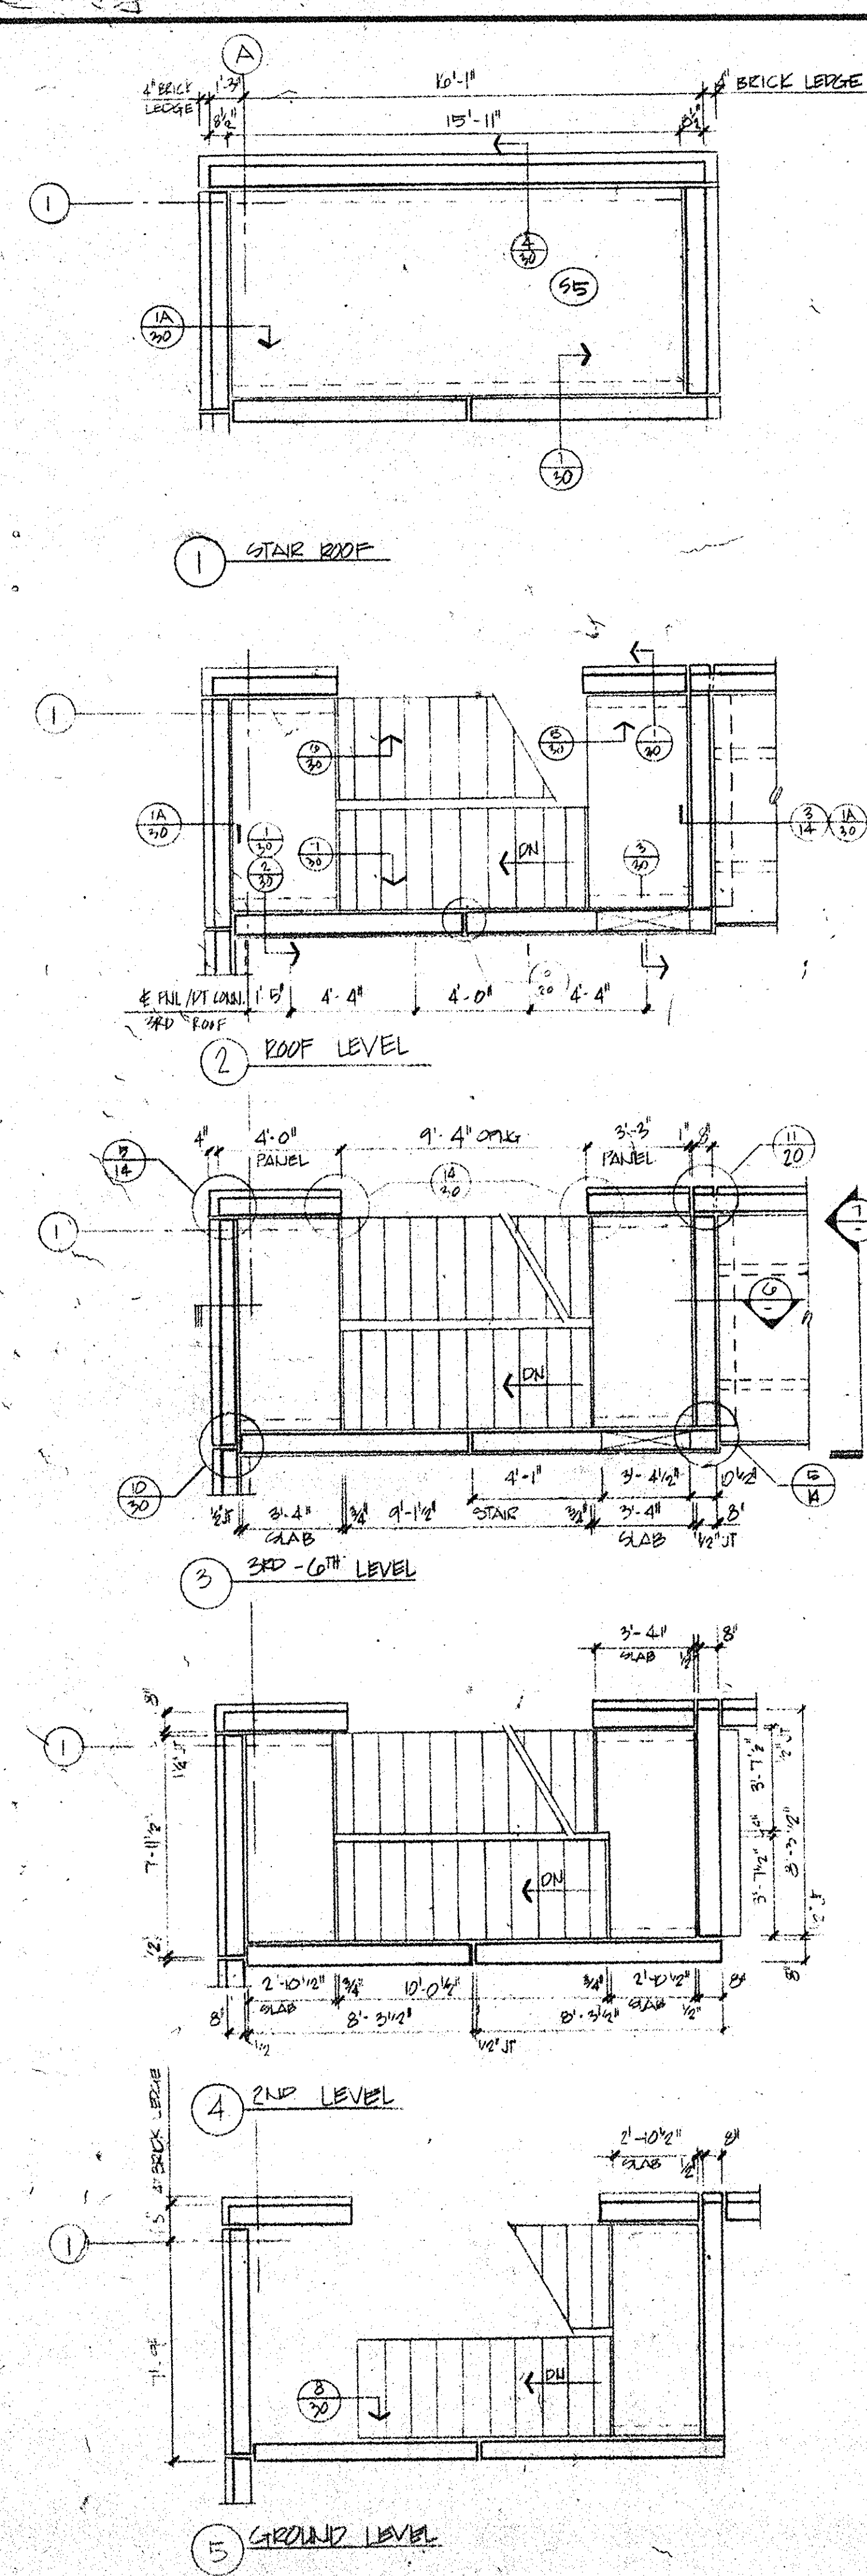

THE CONSULTING ENGINEERS GROUP, INC.
1701 E. Lomb Avenue, Glenview, Illinois 60025-3172
Tel: 847/845-1000
Fax: 847/845-1001

NO.	DATE	DESCRIPTION	BY
1	11/17/86	ISSUED FOR PERMIT	JVS
2	11/17/86	ISSUED FOR PERMIT	JVS
3	11/17/86	ISSUED FOR PERMIT	JVS
1018-55

PCI
CERTIFIED
PLANT

CONCRETE
BUILDING
SYSTEMS

DATE 11-17-86
SUB 352 **SPC** 034(1)
APPROVED FOR COMPLIANCE
EXCEPT AS NOTED
J. VINTON SCHAFER & SONS, INC.
BY

PROJECT: PEARL STREET GARAGE
BALTIMORE, MARYLAND

DESIGNED BY: J. VINTON SCHAFER & SONS, INC.

DRAWN BY: J. VINTON SCHAFER & SONS, INC.

CHECKED BY: J. VINTON SCHAFER & SONS, INC.

APPROVED BY: J. VINTON SCHAFER & SONS, INC.

PROJECT NO.: 10003

DWG. NO.: E-26

SECTION 10

SECTION 11

SECTION 12

SECTION 100