


SAIL CLOTH FACTORY

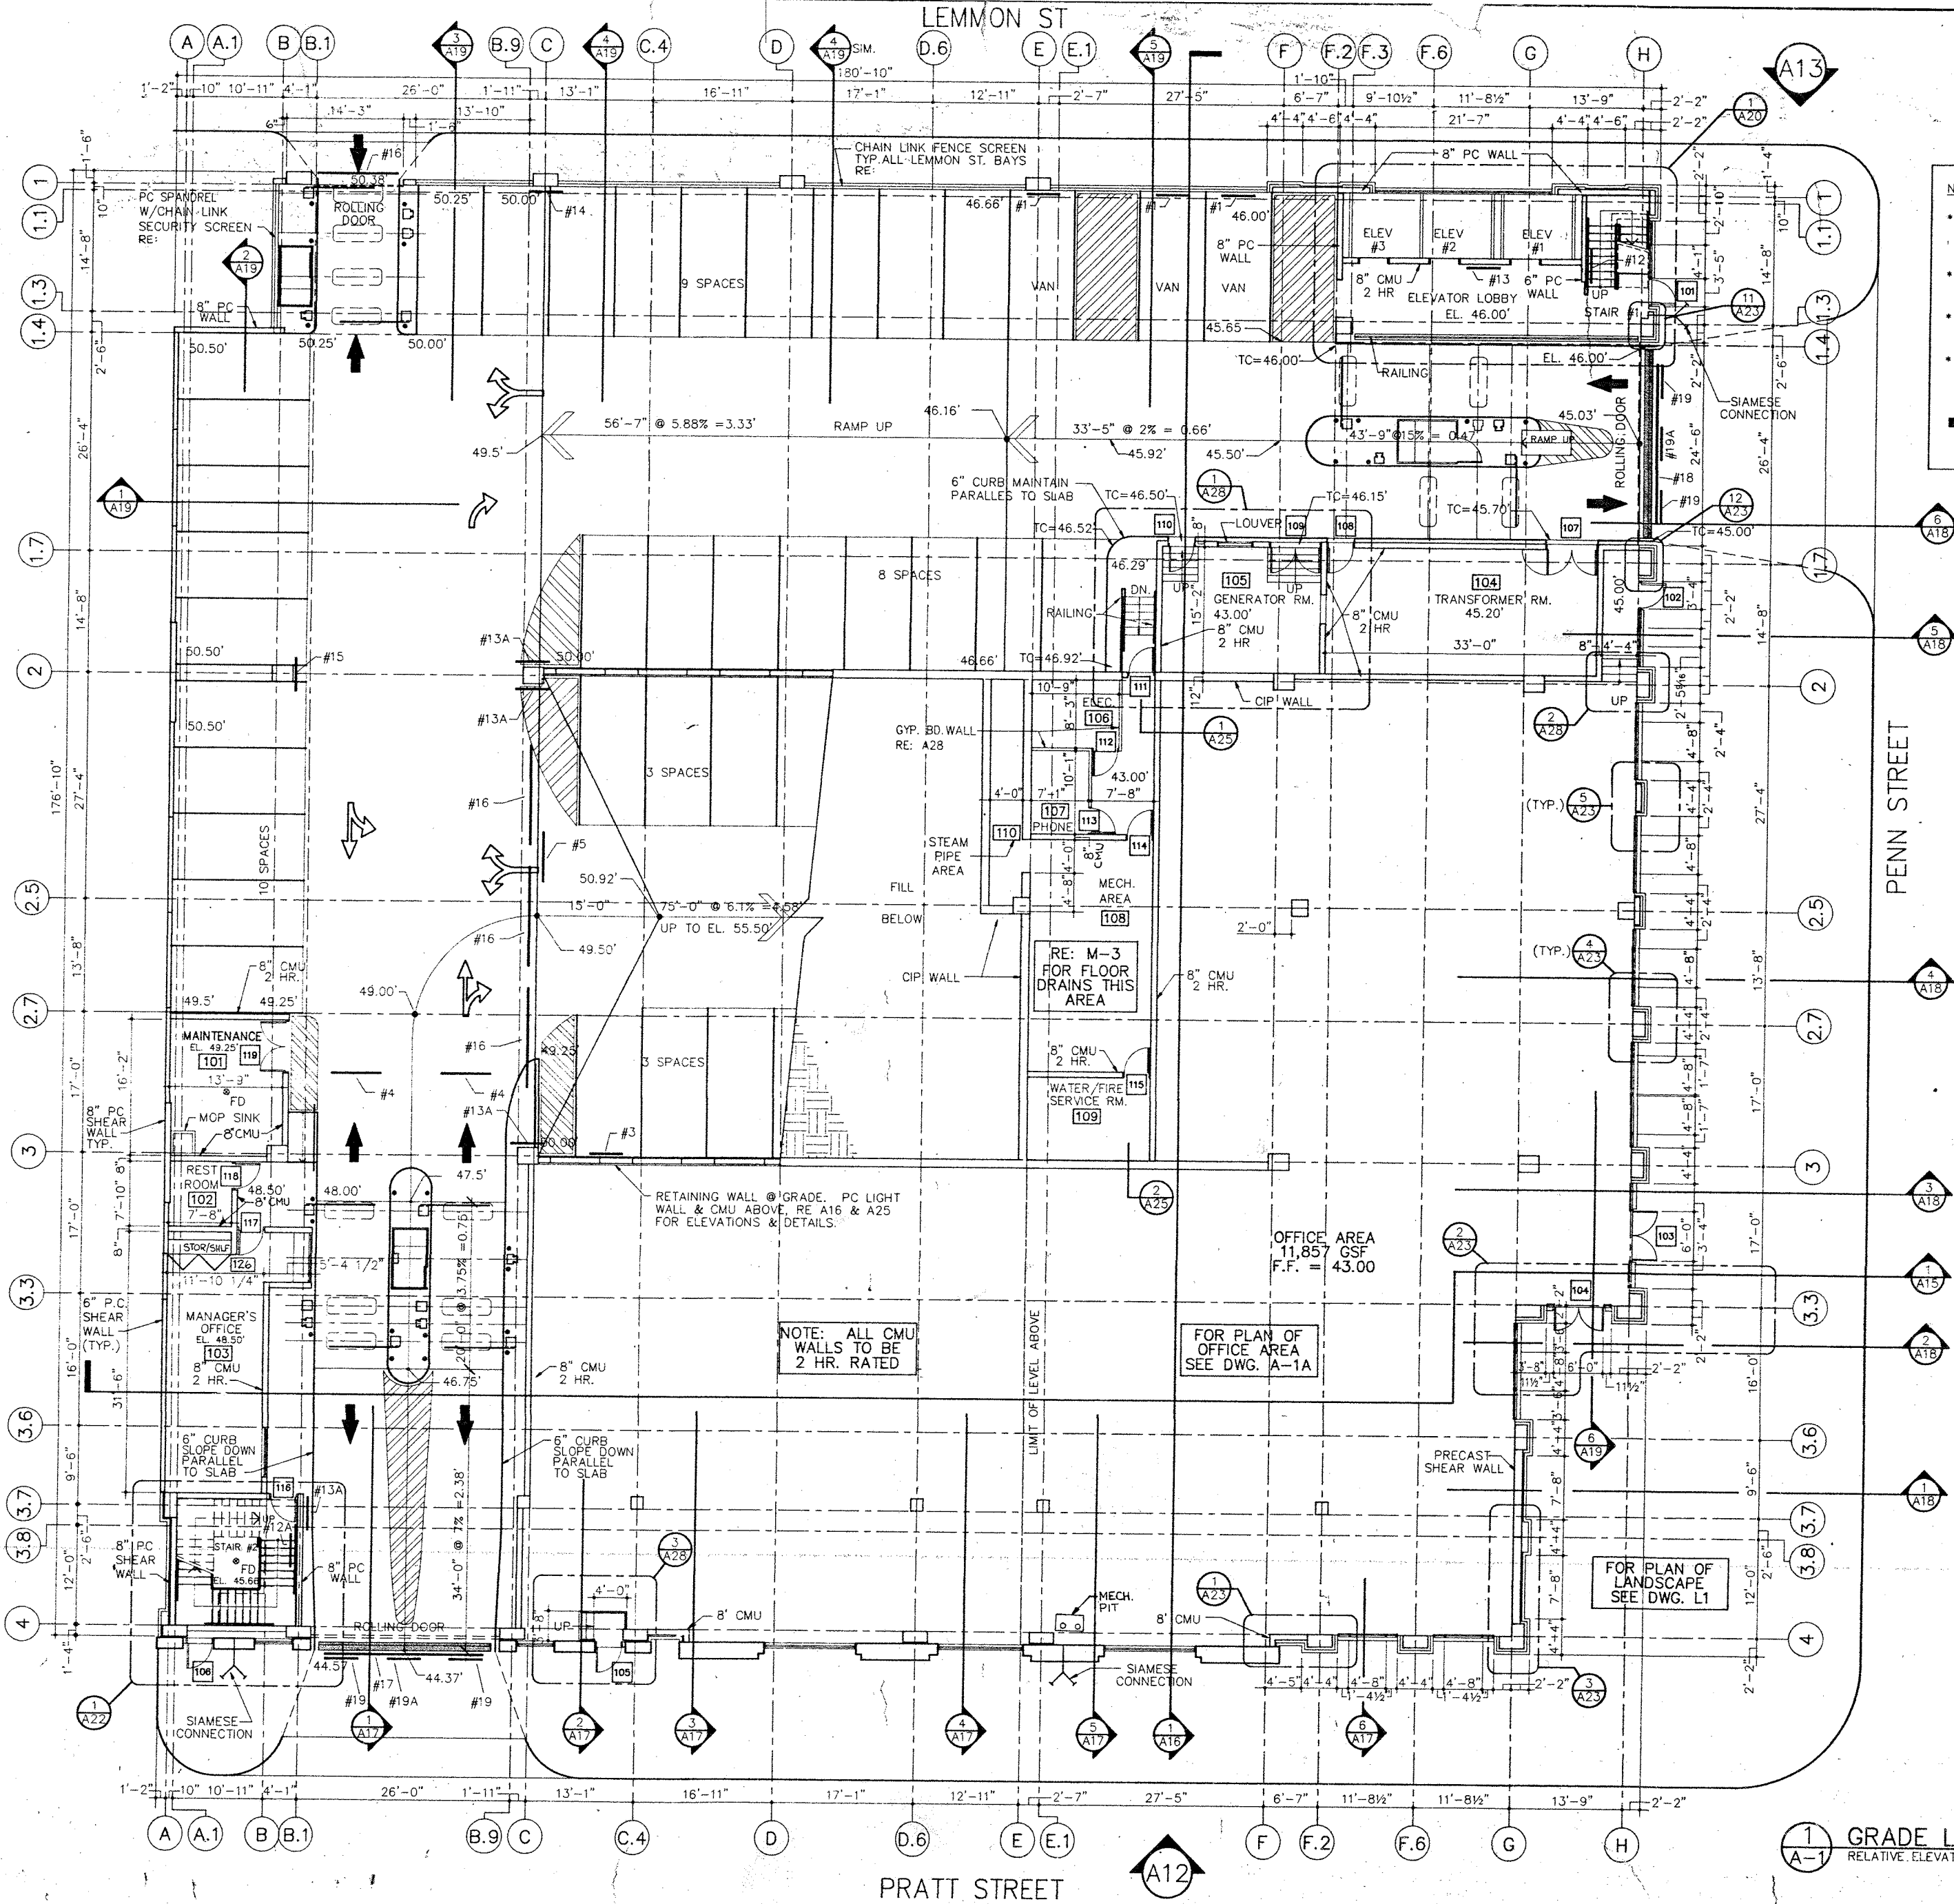

- NOTES:
- FOR CORNER GUARD, PIPE GUARD RAILING & MISC. METAL DETAILS RE: A-26 & A-27
 - FOR STRIPING & SIGNAGE DETAILS RE: SG-1 & SG-2
 - FOR EQUIPMENT LAYOUT DETAILS RE: EQ-1
 - FOR ENTRANCE & ROLLING GRILLE DETAILS OF THE PRATT ST. PORTAL RE: A-29
- ARROWS SHOWN THIS ARE FOR INDICATION ONLY & SHOULD NOT BE PAINTED ON SLABS.

NOTE: ALL CMU WALLS TO BE 2 HR. RATED

FOR PLAN OF OFFICE AREA SEE DWG. A-1A

FOR PLAN OF LANDSCAPE SEE DWG. L1

1 GRADE LEVEL PLAN
A-1 RELATIVE ELEVATION = 146.00

WHITING-TURNER
CONTRACTING COMPANY
DESIGN ASSOCIATES
ARCHITECTS ENGINEERS

PENN STREET PARKING FACILITY
UNIVERSITY OF MARYLAND AT BALTIMORE

NO.	DATE	BY

REVISIONS

GRADE LEVEL PLAN


DRAWING NO. A-1

SCALE: 1/8" = 1'-0"

DATE: JUNE, 1993

PROJECT NO. 4-543

DESIGN DRAWN CHKD. K.T. L.B. S.

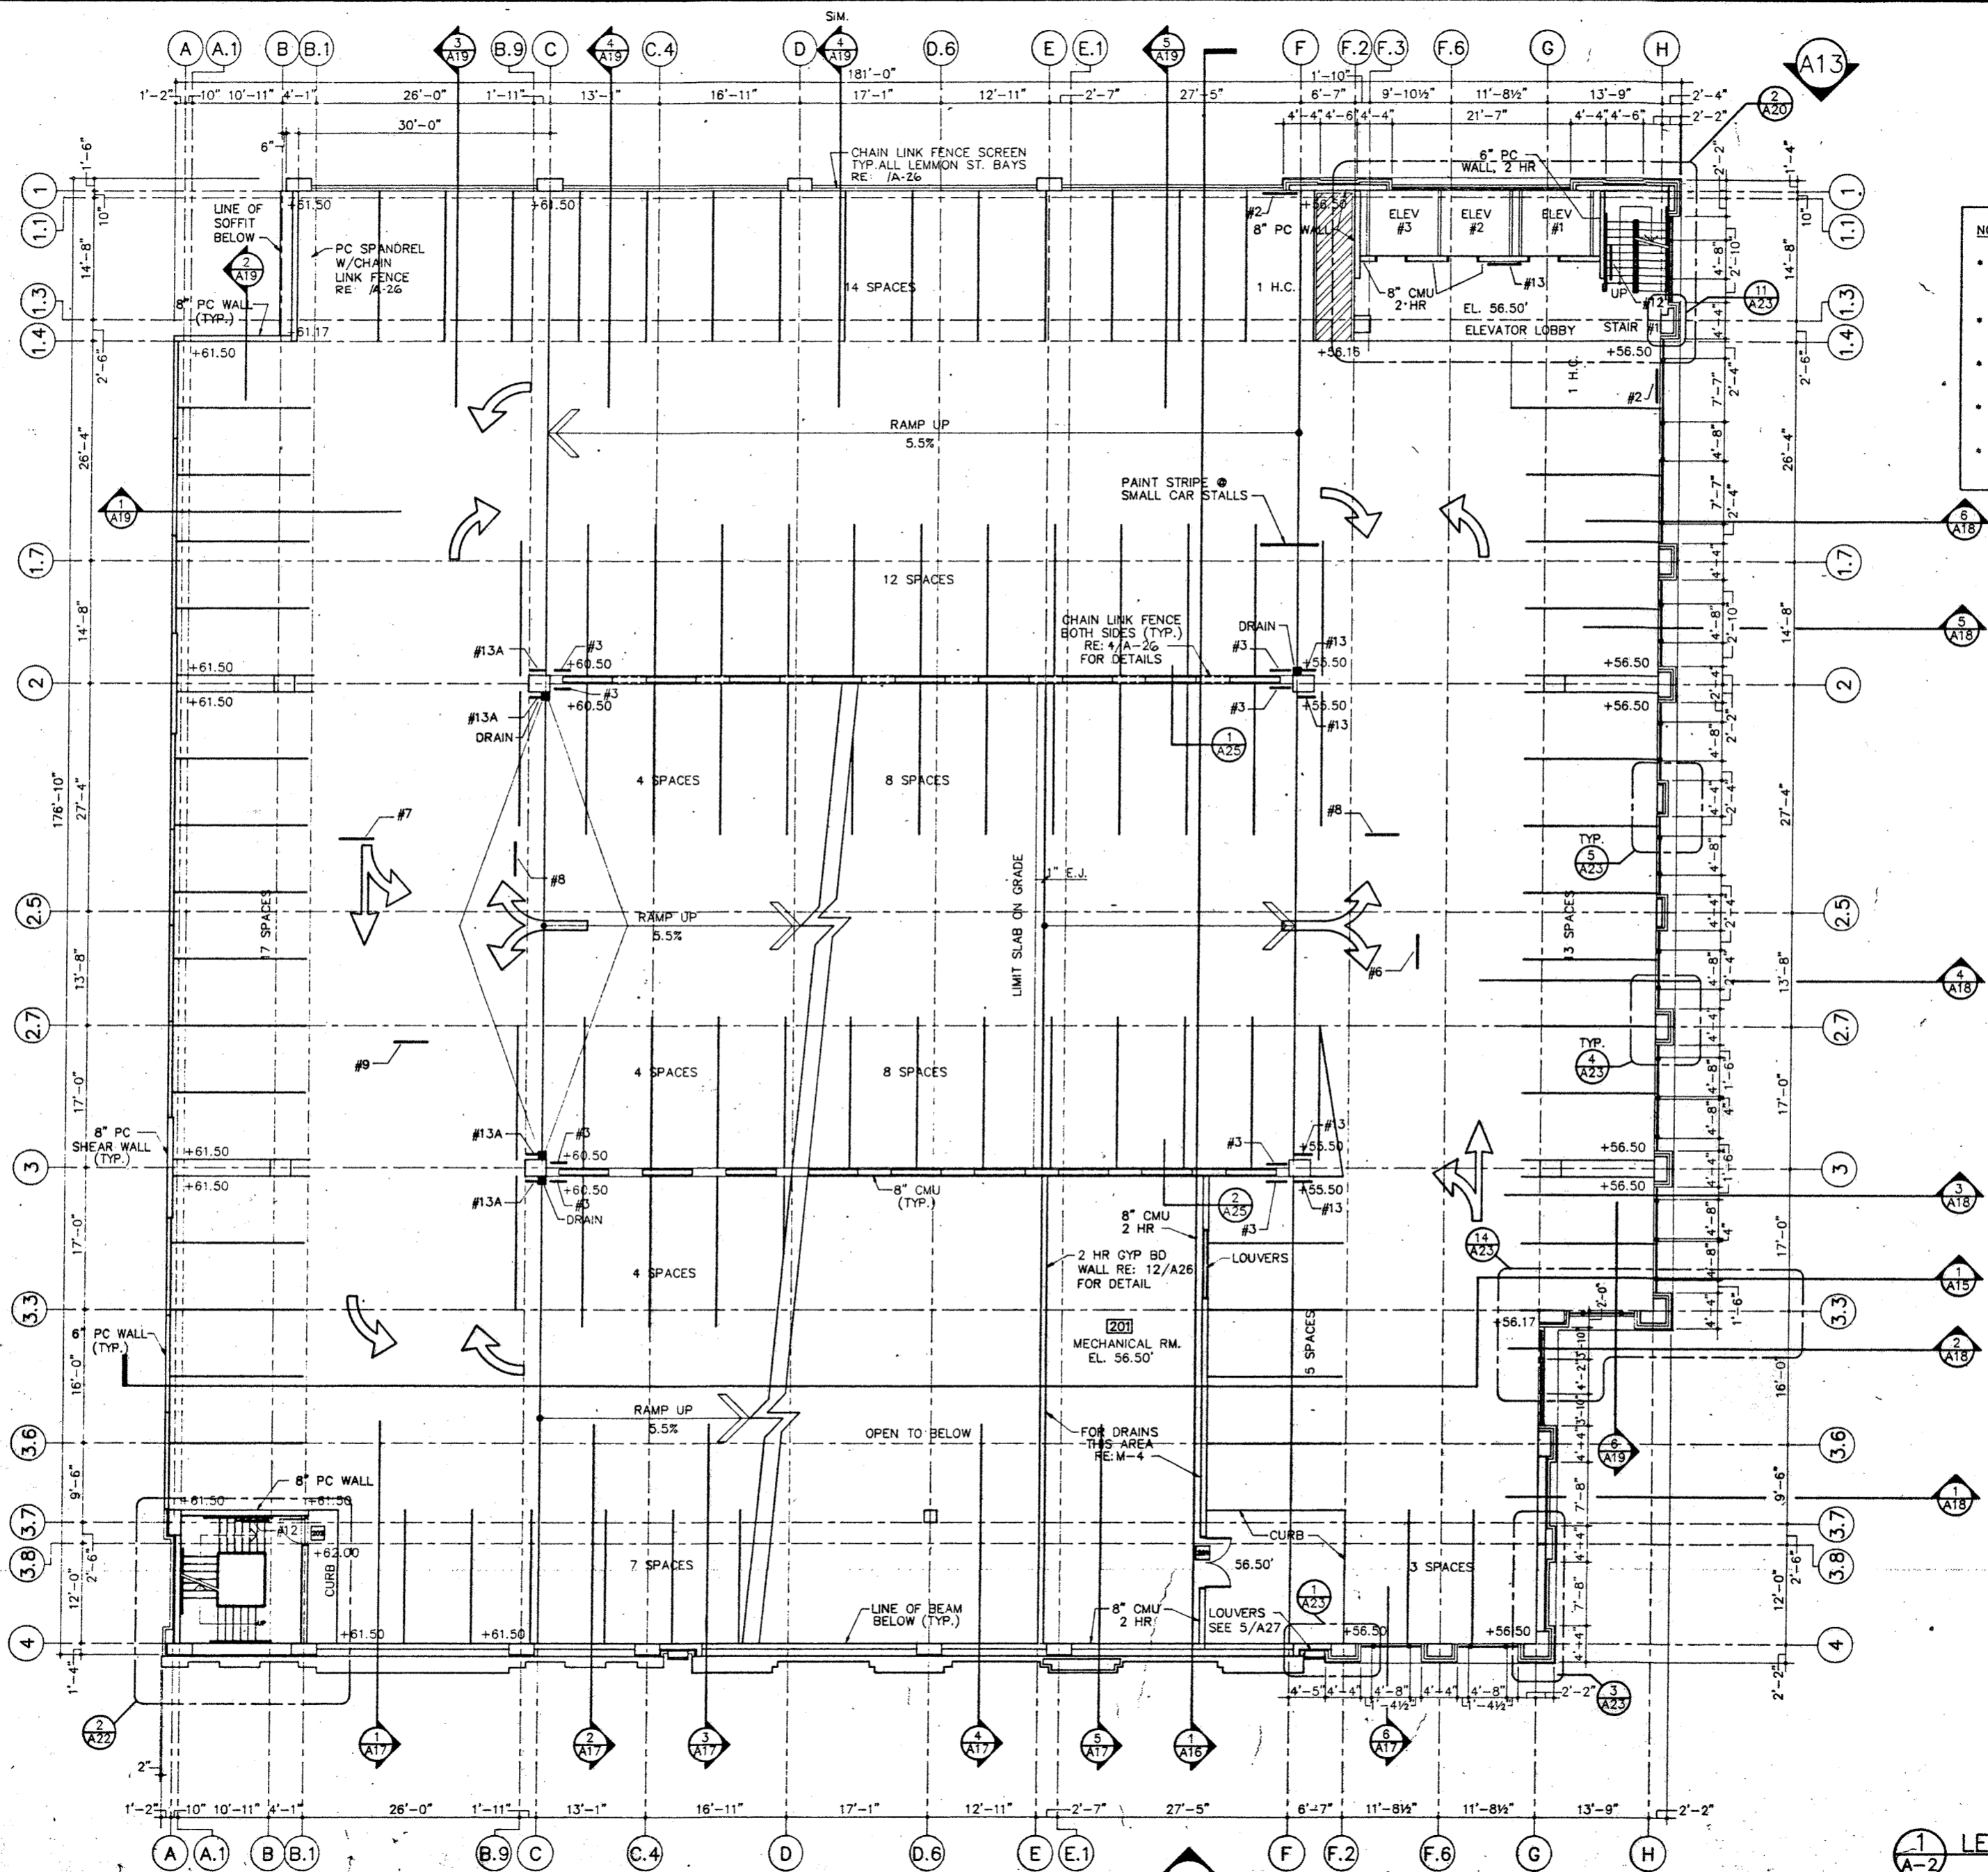

- NOTES:**
- FOR CORNER GUARD, PIPE GUARD RAILING & MISC. METAL DETAILS RE: A-26 & A-27
 - FOR STRIPING & SIGNAGE DETAILS RE: SG-1 & SG-2
 - FOR EQUIPMENT LAYOUT DETAILS RE: EQ-1
 - FOR CORNER GUARDS RE: 11/A-27
 - FOR PIPE GUARDS RE: 11/A-27

WHITING-TURNER
CONTRACTING COMPANY
DESIGN ASSOCIATES
ARCHITECTS ENGINEERS

PENN STREET PARKING FACILITY
UNIVERSITY OF MARYLAND AT BALTIMORE




LEVEL 2 PLAN
A-2

NO.	DATE	BY
REVISIONS		
LEVEL 2 PLAN		
DRAWING NO. A-2		
SCALE: 1/8" = 1'-0"		
DATE: JUNE 1993		
PROJECT NO. J-343		
DESIGN S.S.	DRAWN I.B.	CHECKED C.H.K.A.

PENN STREET PARKING FACILITY
UNIVERSITY OF MARYLAND AT BALTIMORE

- NOTES:
- FOR CORNER GUARD, PIPE GUARD RAILING & MISC. METAL DETAILS RE: A-26 & A-27
 - FOR STRIPING & SIGNAGE DETAILS RE: SG-1 & SG-2
 - FOR EQUIPMENT LAYOUT DETAILS RE: EQ-1

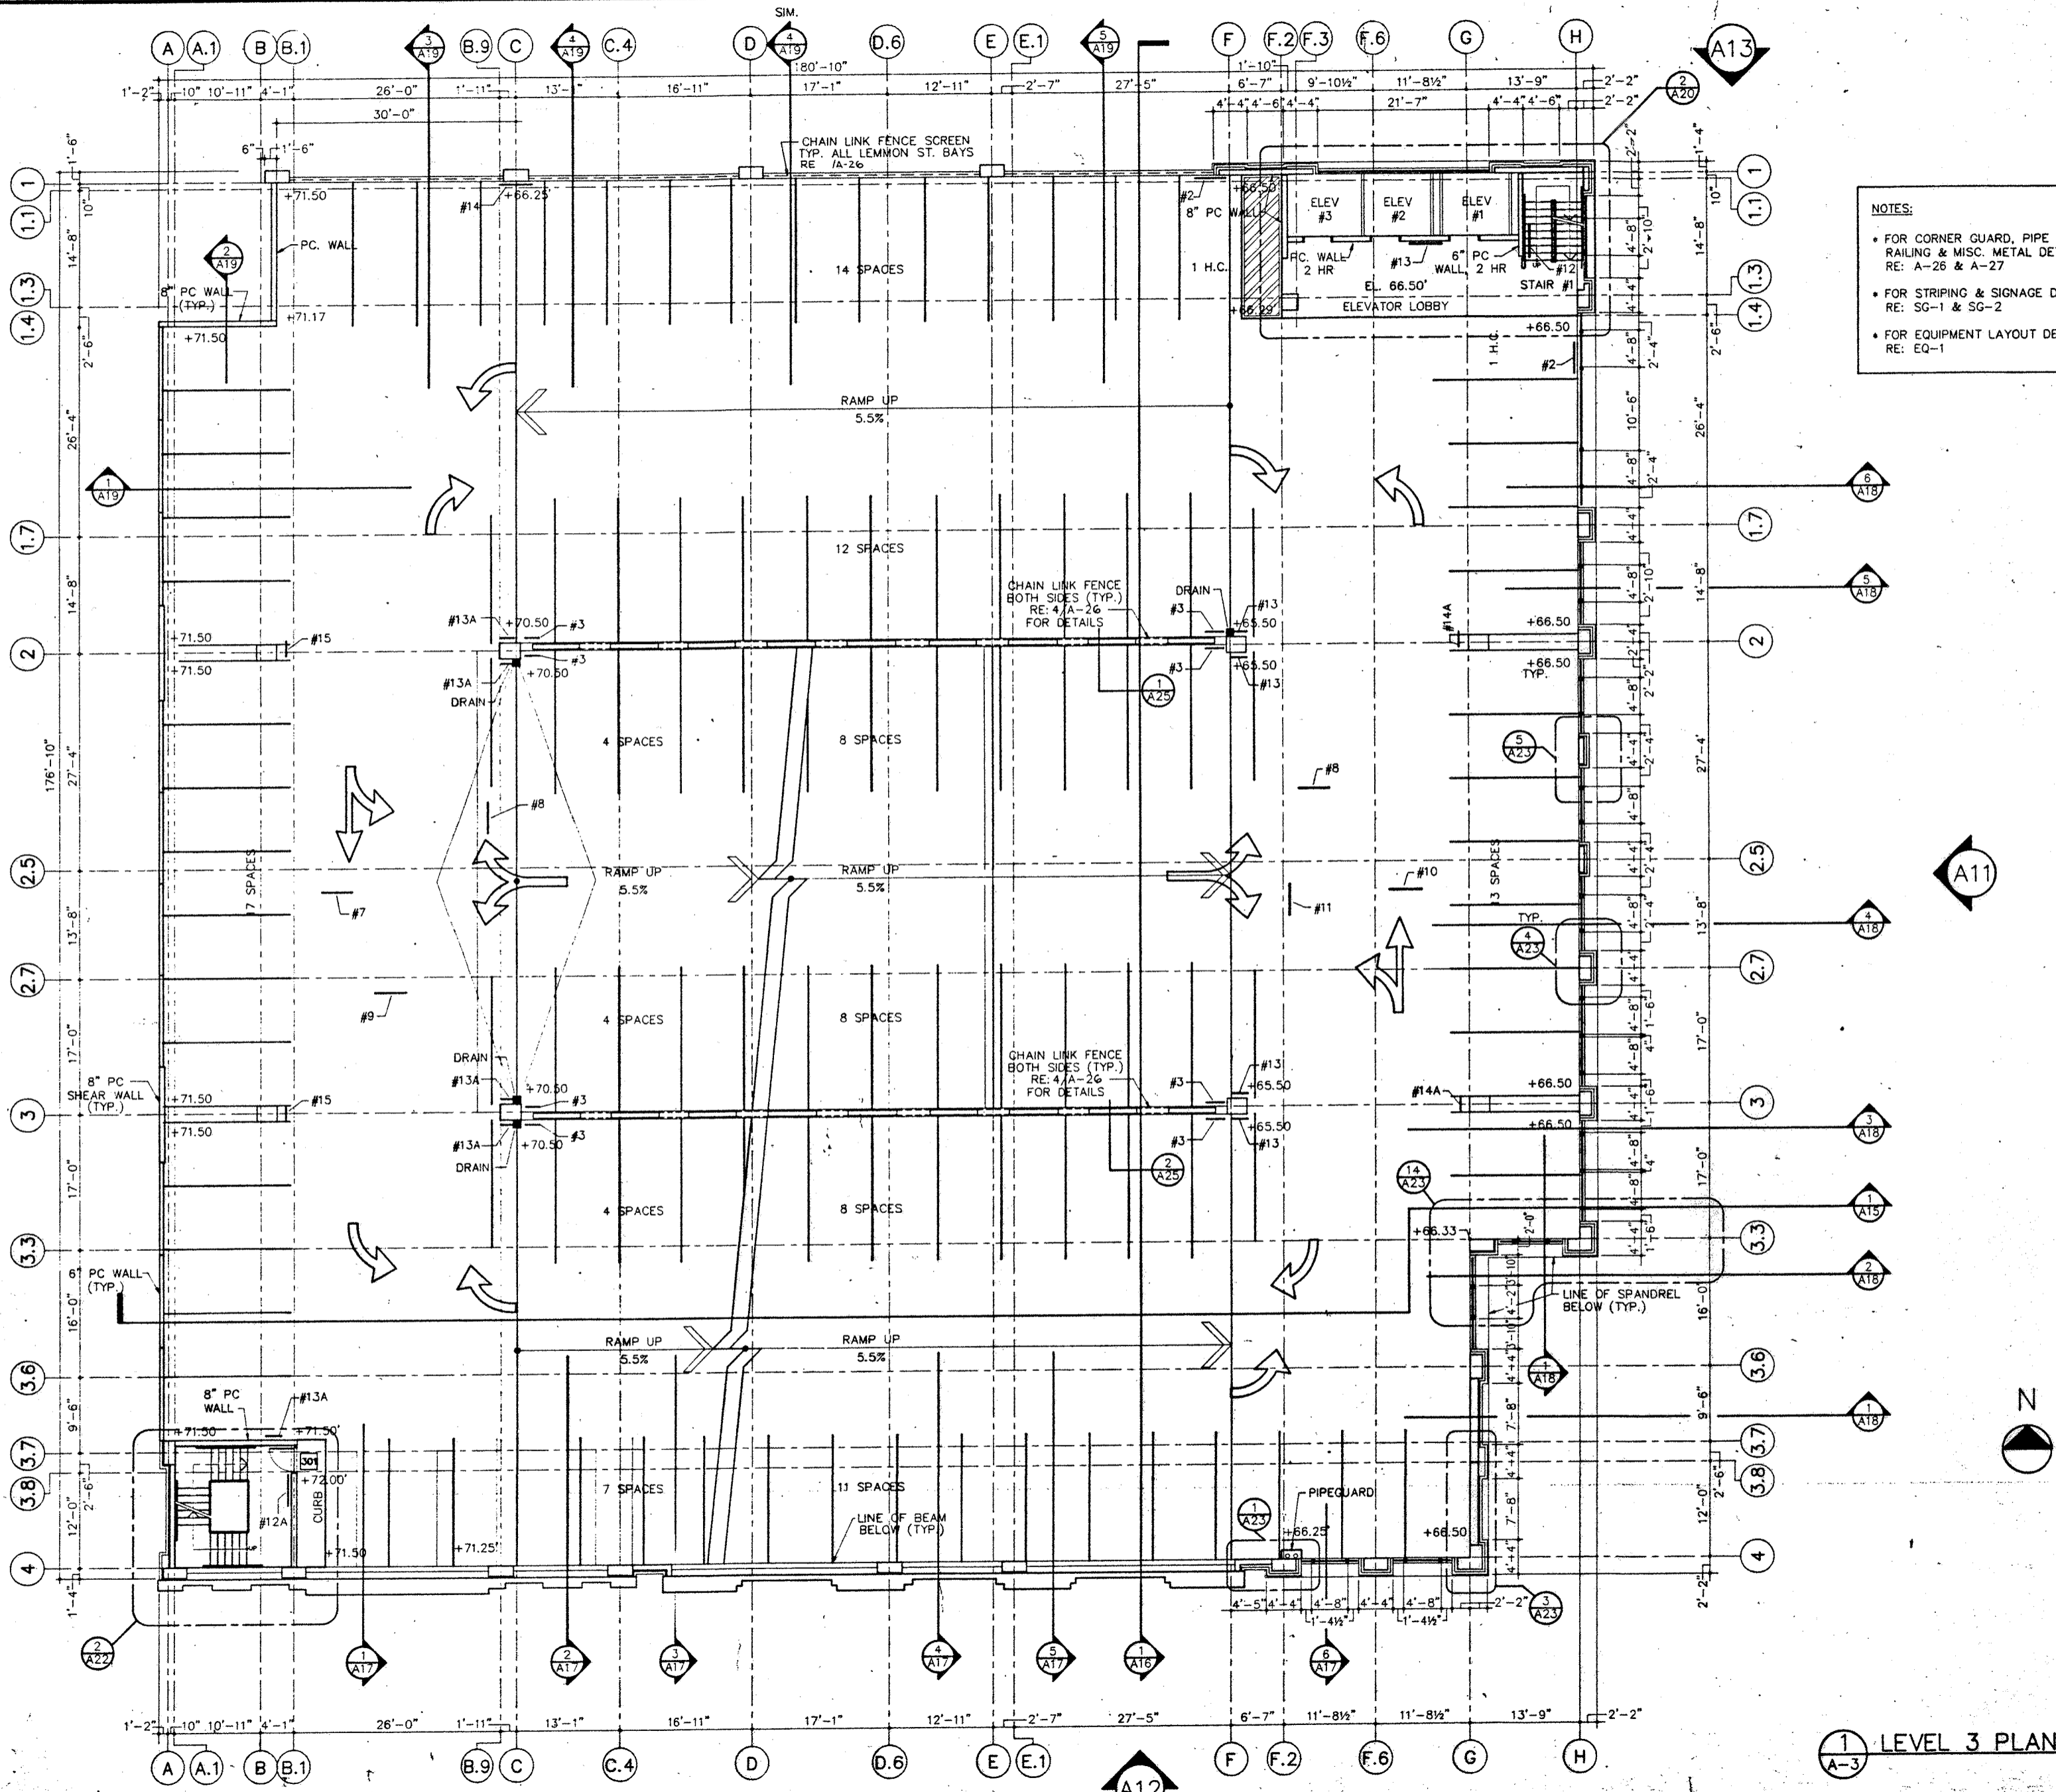


1 LEVEL 3 PLAN
A-3

NO.	DATE	BY
REVISIONS		
LEVEL 3 PLAN		
DRAWING NO. A-3		
SCALE: 1/8"=1'-0"		
DATE: JUNE 1993		
PROJECT NO. J-343		
DESIGN	DRAWN	CHKD.
S.S.	I.B.	S.S.

PENN STREET PARKING FACILITY
UNIVERSITY OF MARYLAND AT BALTIMORE


- NOTES:
- FOR CORNER GUARD, PIPE GUARD RAILING & MISC. METAL DETAILS RE: A-26 & A-27
 - FOR STRIPING & SIGNAGE DETAILS RE: SG-1 & SG-2
 - FOR EQUIPMENT LAYOUT DETAILS RE: EQ-1

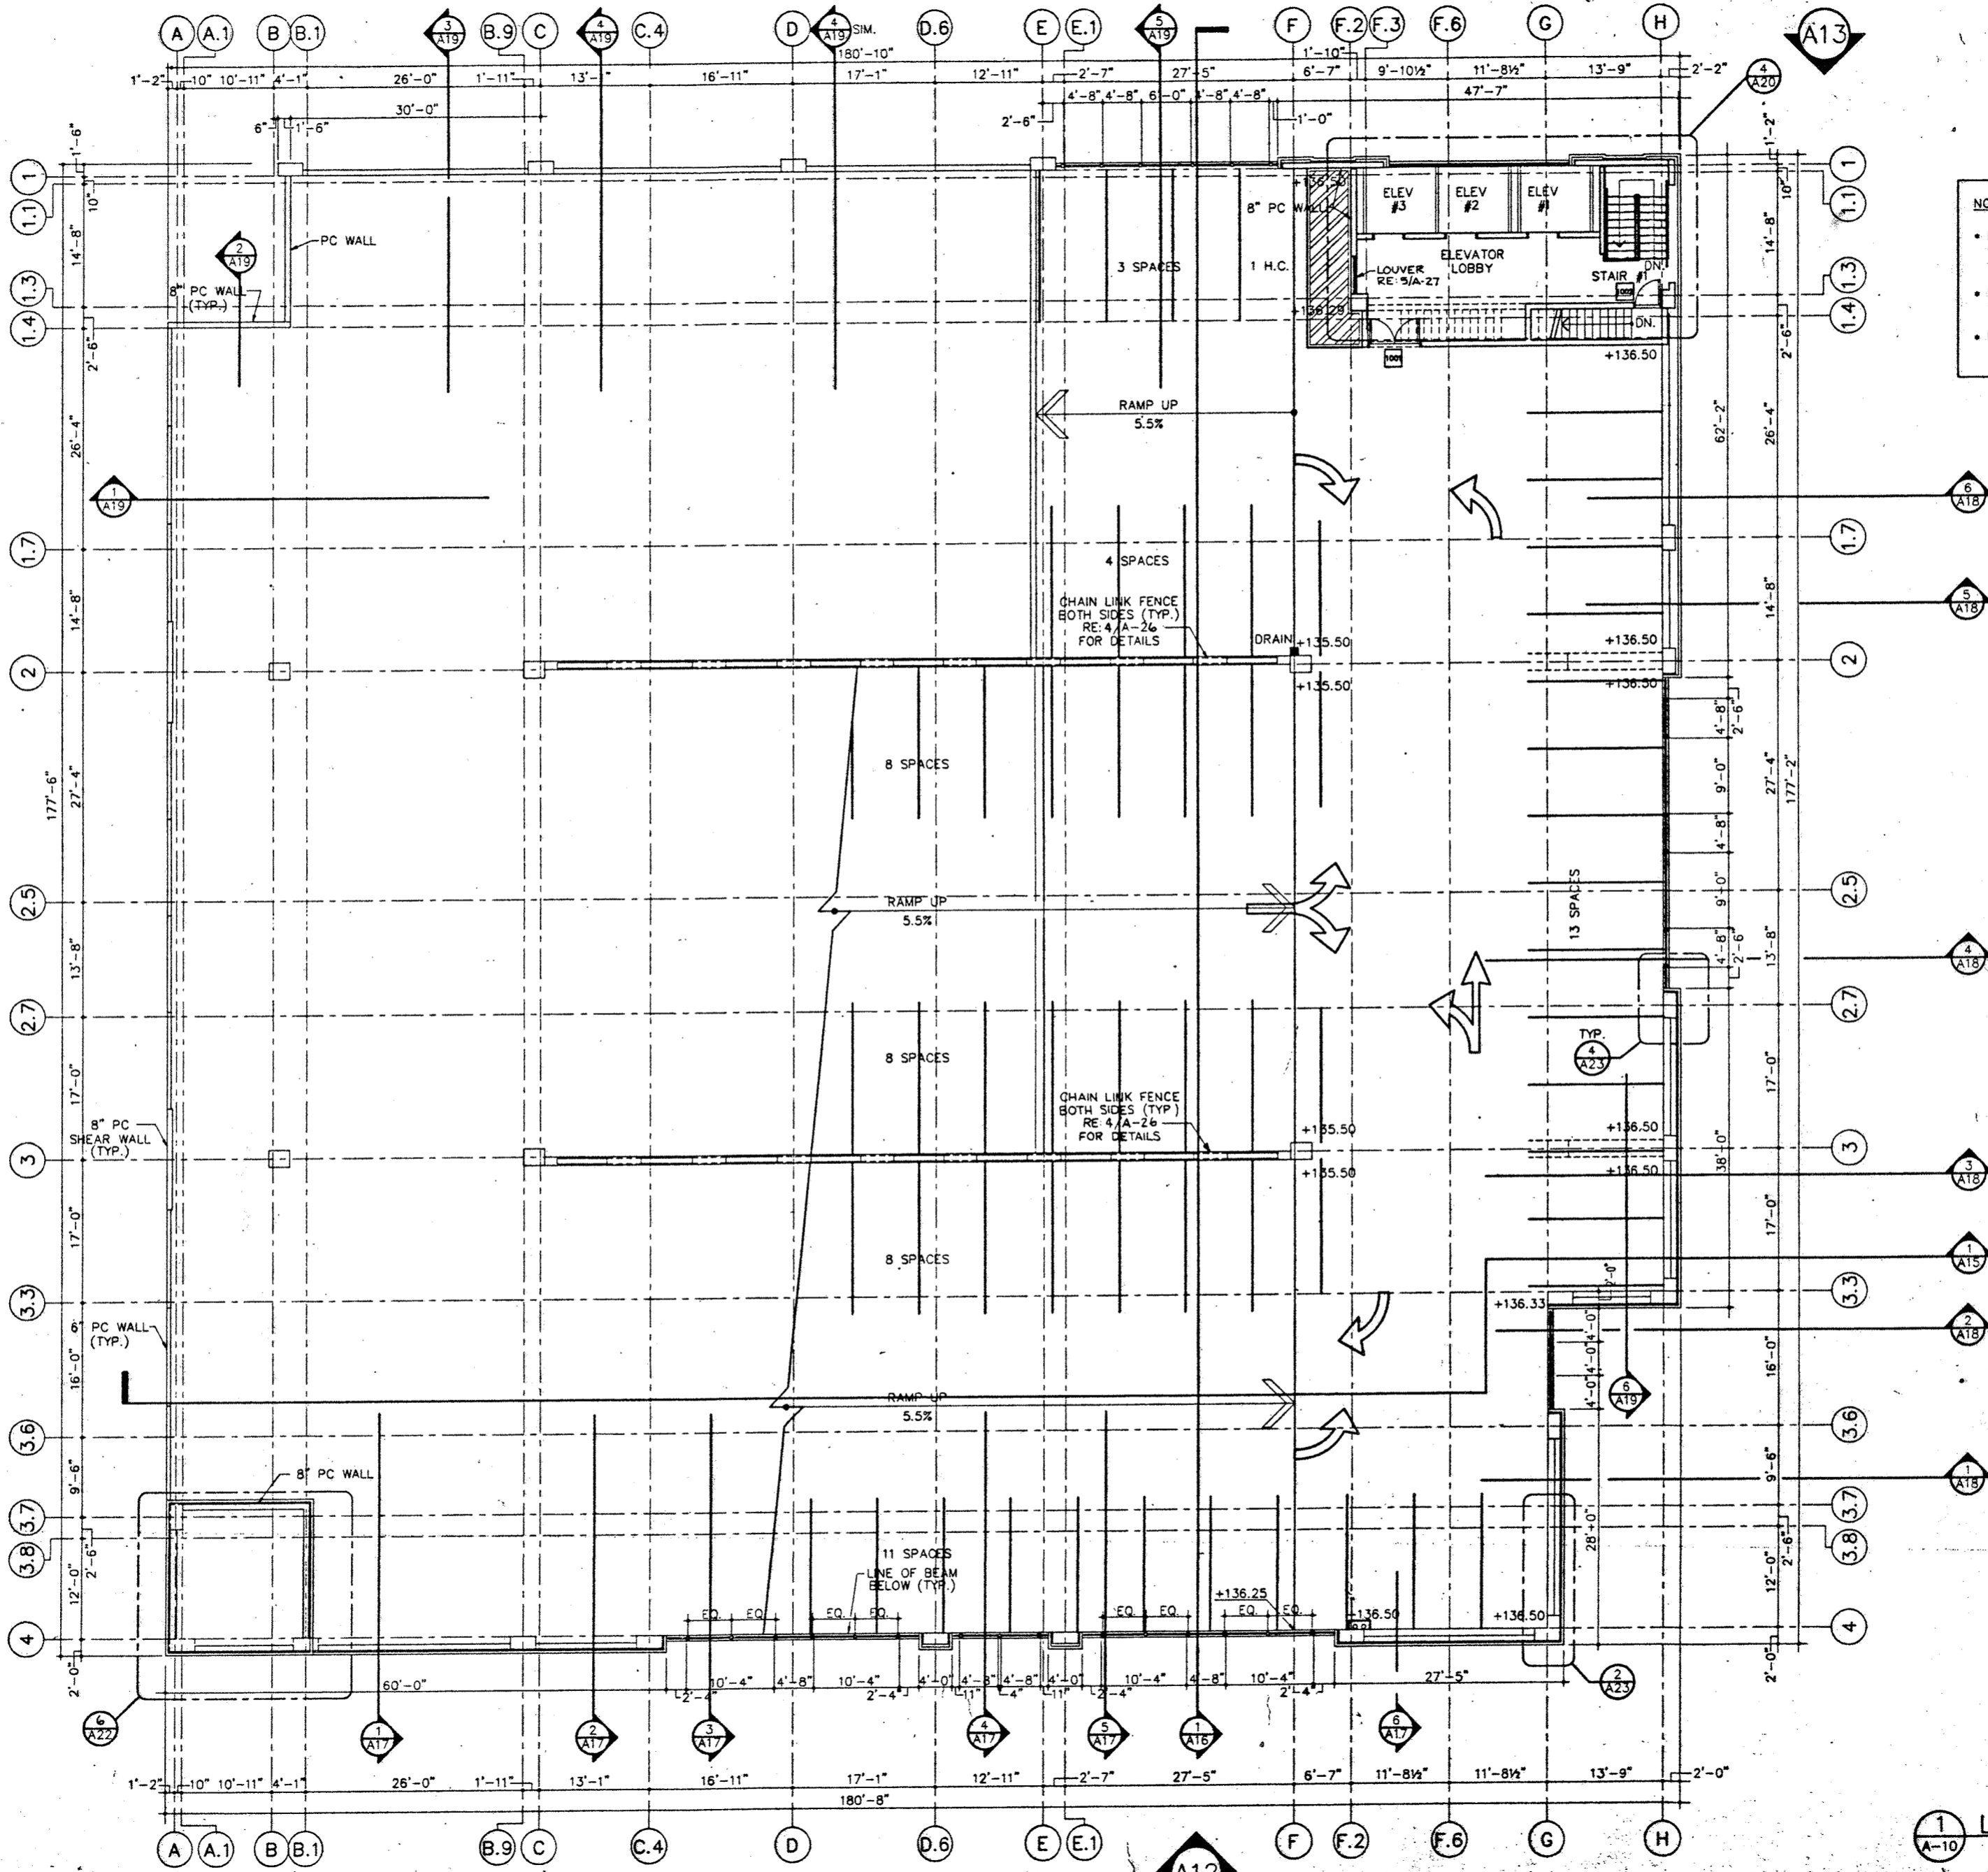


1 LEVEL 10 PLAN
A-10

NO.	DATE	BY
REVISIONS		
LEVEL 10 PLAN		
DRAWING NO. A-10		
SCALE: 1/8"=1'-0"		
DATE: JUNE 1993		
PROJECT NO. J-343		
DESIGN	DRAWN	CHKD.
S.S.	L.B.	S.S.


3543-3

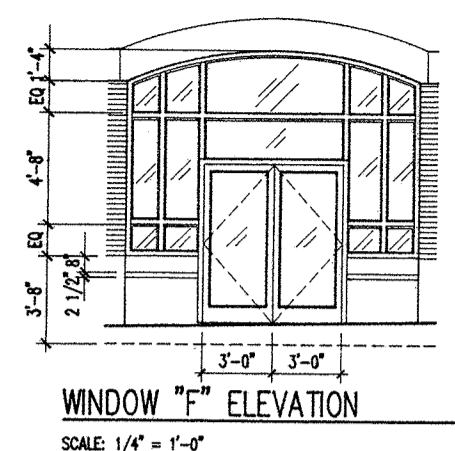


WINDOW "F" ELEVATION
SCALE: 1/4" = 1'-0"

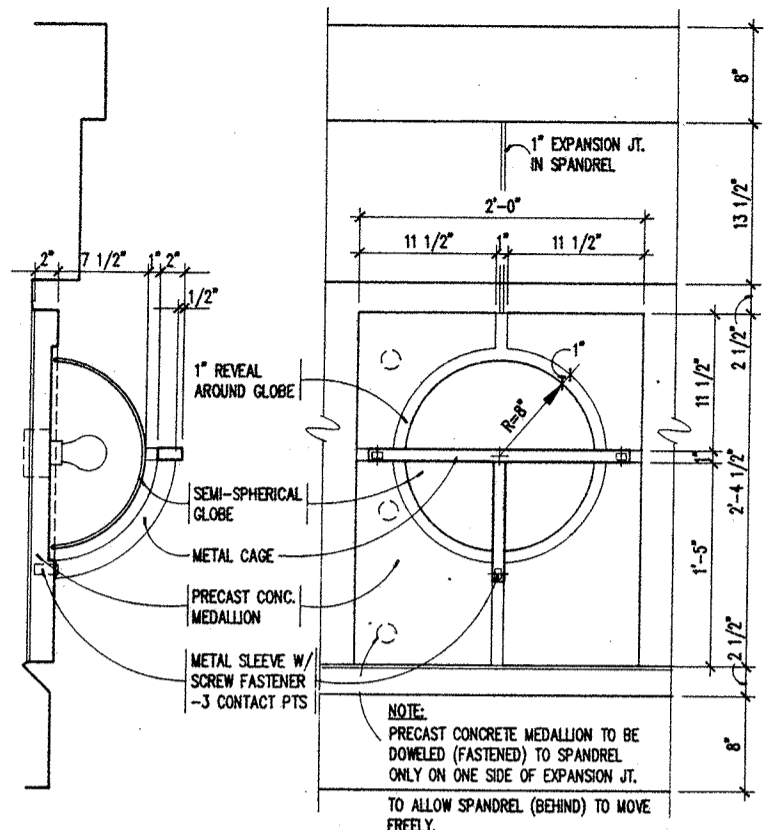


EXTERIOR LIGHT (TYPICAL)
SCALE: 1 1/2" = 1'-0" SEE ELECTRICAL DWGS.
*S.M. - P.C. WITHOUT LIGHT FIXTURE & METAL CAGE

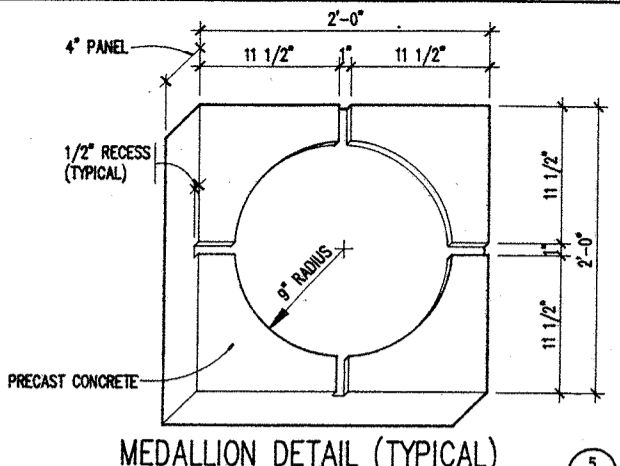

MEDALLION DETAIL (TYPICAL)
SCALE: 1 1/2" = 1'-0"

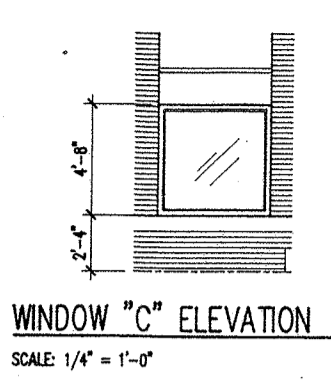


WINDOW "C" ELEVATION
SCALE: 1/4" = 1'-0"

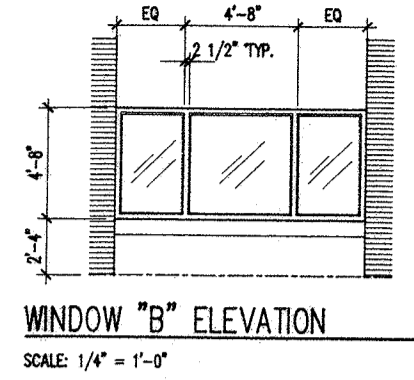


WINDOW "B" ELEVATION
SCALE: 1/4" = 1'-0"


*NOTE: 'B' IS 4" WIDER THAN TYPICAL 'B'

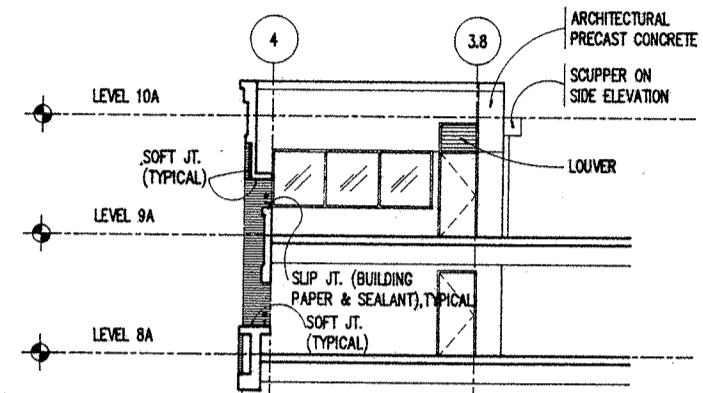


PARTIAL ELEVATION OF WALL @ GRID B.1
SCALE: 1/8" = 1'-0"

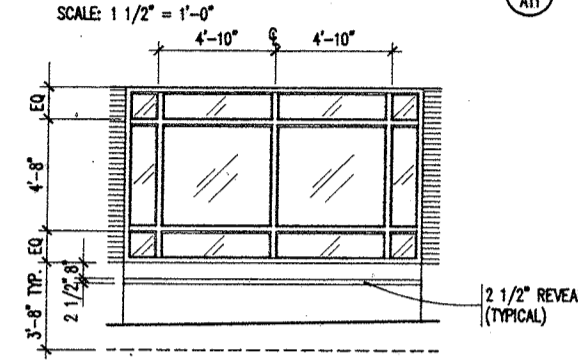

WINDOW "E" ELEVATION
SCALE: 1/4" = 1'-0"

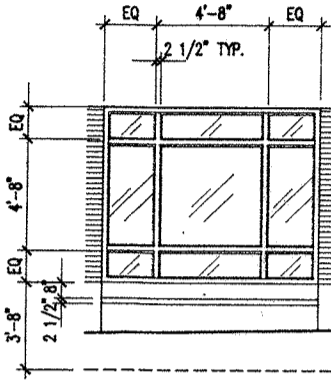


WINDOW "D" ELEVATION
SCALE: 1/4" = 1'-0"

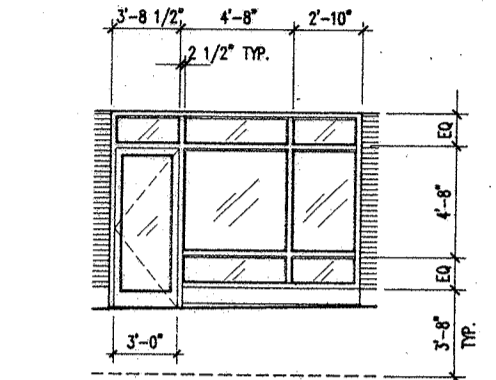

WINDOW "A" ELEVATION
SCALE: 1/4" = 1'-0"

*FOR TYPICAL HEAD, SILL & JAMB DETAILS OF WINDOWS SEE DWG A14

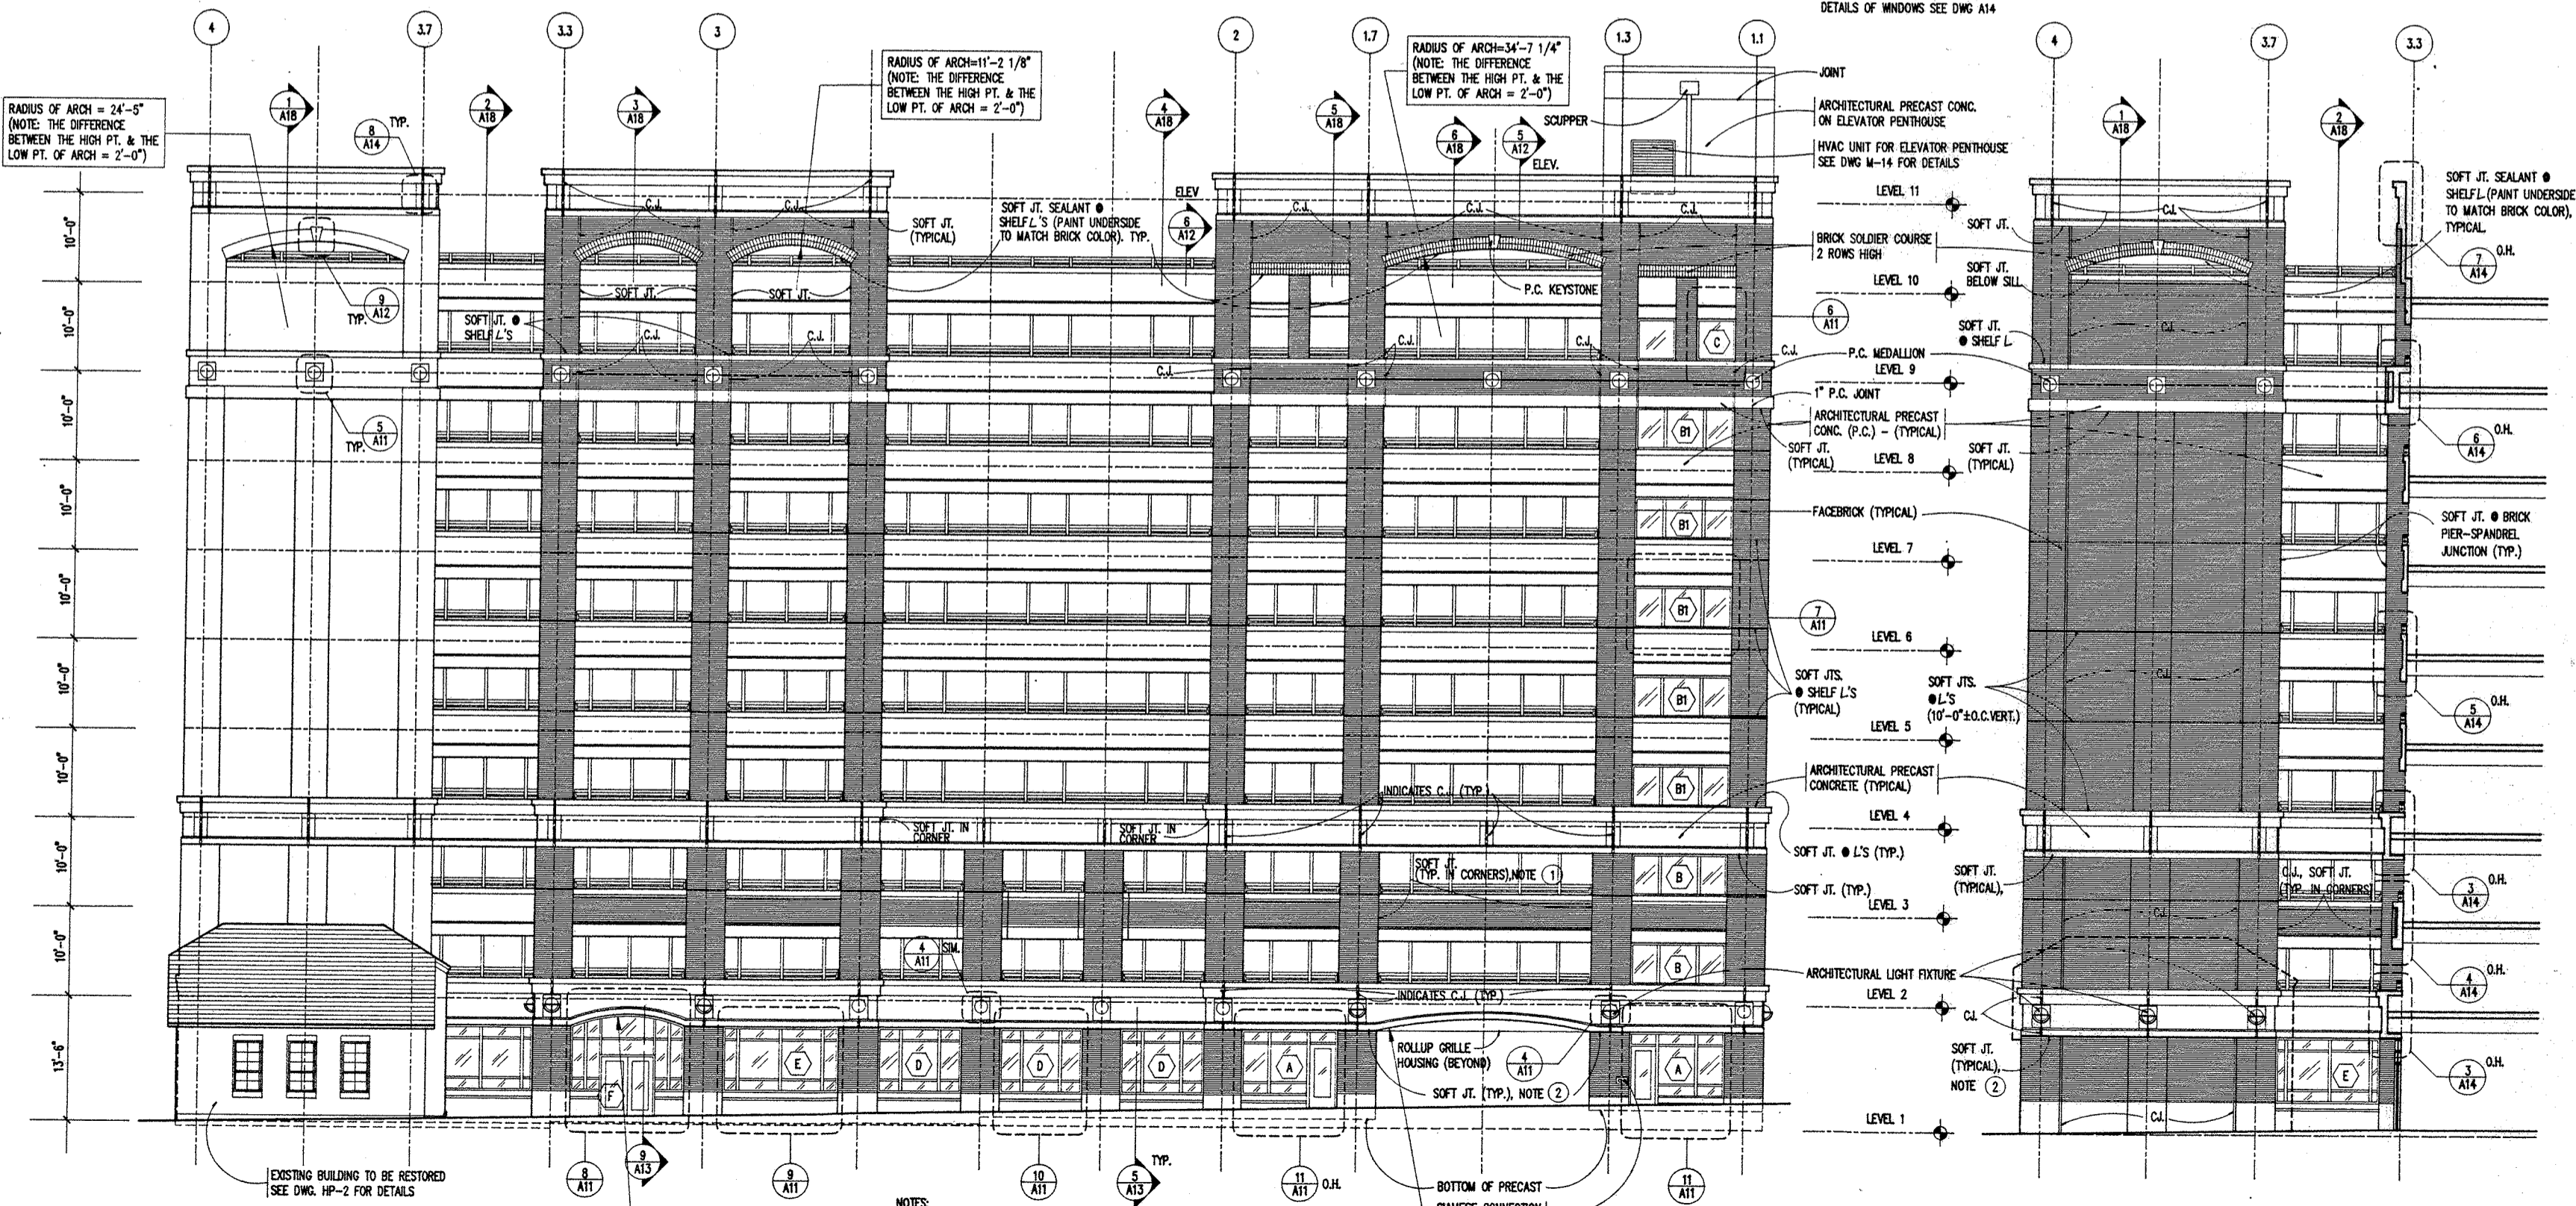

PENN STREET ELEVATION (EAST)
SCALE: 1/8" = 1'-0"

PARTIAL ELEVATION @ GRID G
SCALE: 1/8" = 1'-0"

RADIUS OF ARCH=16'-2 1/8"
(NOTE: THE DIFFERENCE BETWEEN THE HIGH PT. & THE LOW PT. OF ARCH = 1'-4")

- NOTES:
- CONTROL JOINT (SOFT JOINT) REQUIRED BETWEEN COLUMN BRICK VENEER AND SPANDRELS.
 - SOFT JOINTS REQUIRED BETWEEN TOP BRICK VENEERED COLUMN COVERS AND BOTTOM OF SPANDRELS.

RADIUS OF ARCH=53'-10 1/8"
(NOTE: THE DIFFERENCE BETWEEN THE HIGH PT. & THE LOW PT. OF ARCH = 1'-4")


NO.	DATE	BY
1	2/9/94	
2	12/1/93	
3	7/16/93	

REVISIONS


PENN STREET ELEVATION

DRAWING NO. **A11**


SCALE: AS SHOWN
DATE: JULY 1, 1993
PROJECT NO. 93001
DESIGN DRAWN CHKD.

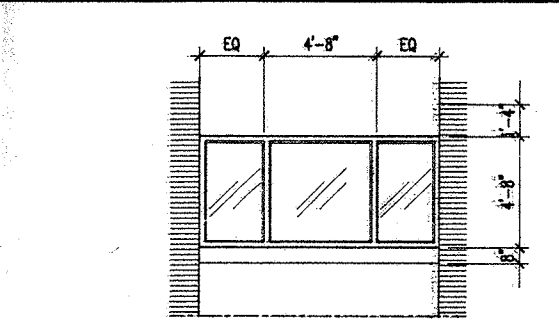


WINDOW "H" ELEVATION
SCALE: 1/4" = 1'-0"

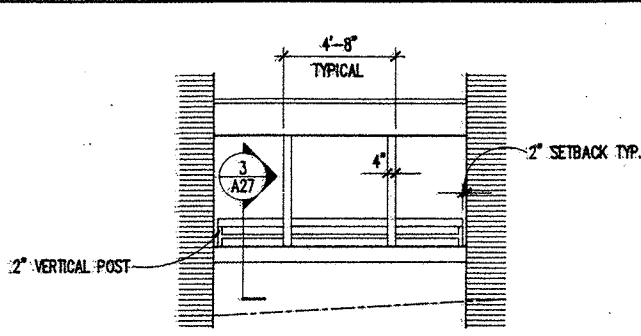


TYPICAL RAILING DETAIL
SCALE: 1/4" = 1'-0"

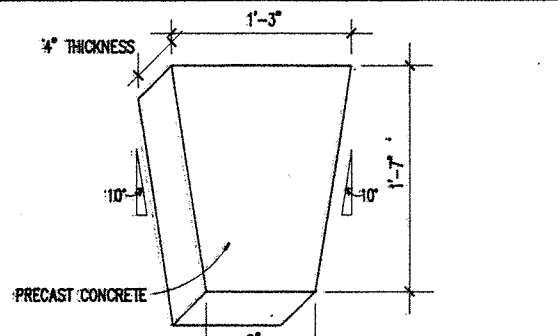


KEYSTONE DETAIL (TYPICAL)
SCALE: 1 1/2" = 1'-0"

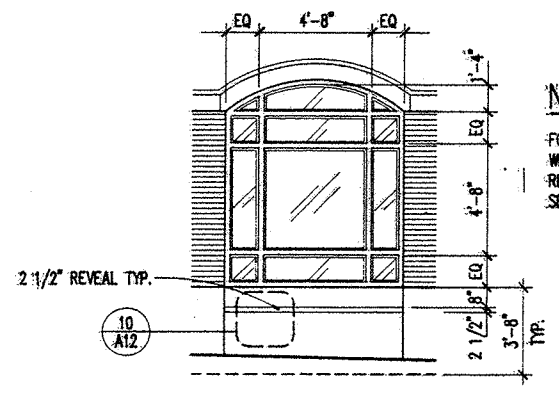


WINDOW "G" ELEVATION
SCALE: 1/4" = 1'-0"

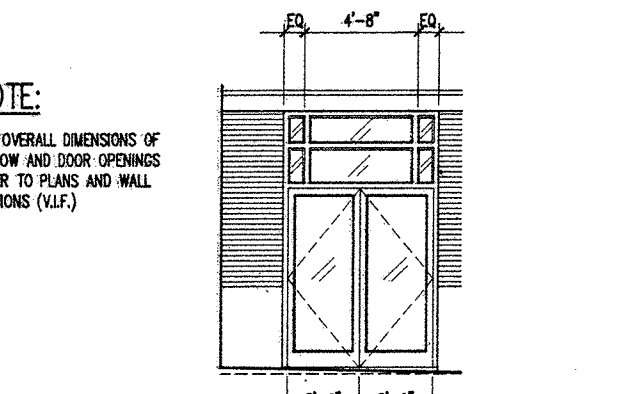


WINDOW "J" ELEVATION
SCALE: 1/4" = 1'-0"

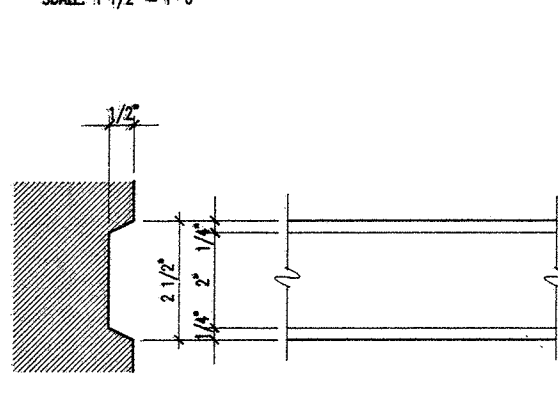


TYPICAL REVEAL DETAIL
SCALE: 6" = 1'-0"

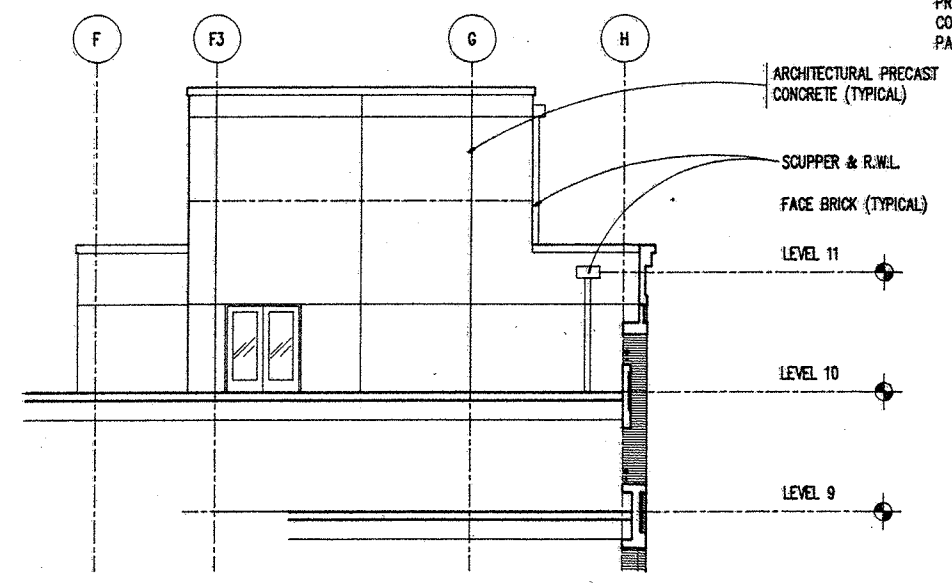


PARTIAL ELEVATION (ON GRID 1.3)
SCALE: 1/8" = 1'-0"

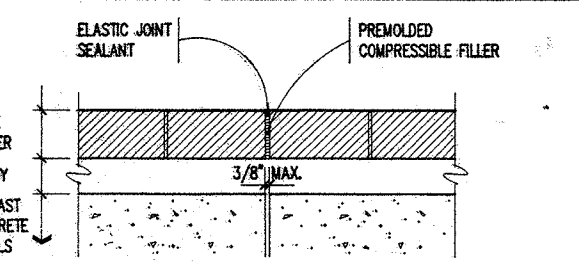

CONTROL JOINT DETAIL
SCALE: 1 1/2" = 1'-0"

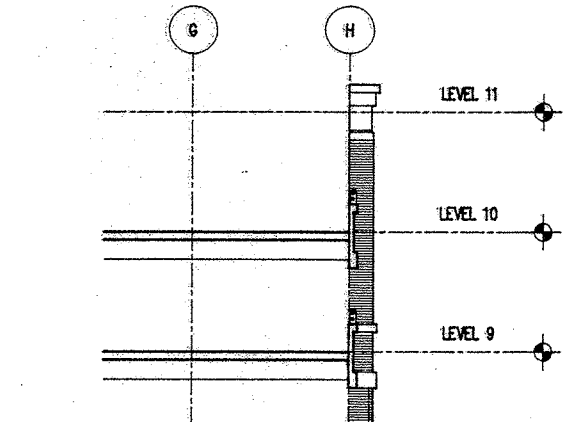


PARTIAL ELEVATION (ON GRID 2)
SCALE: 1/8" = 1'-0"

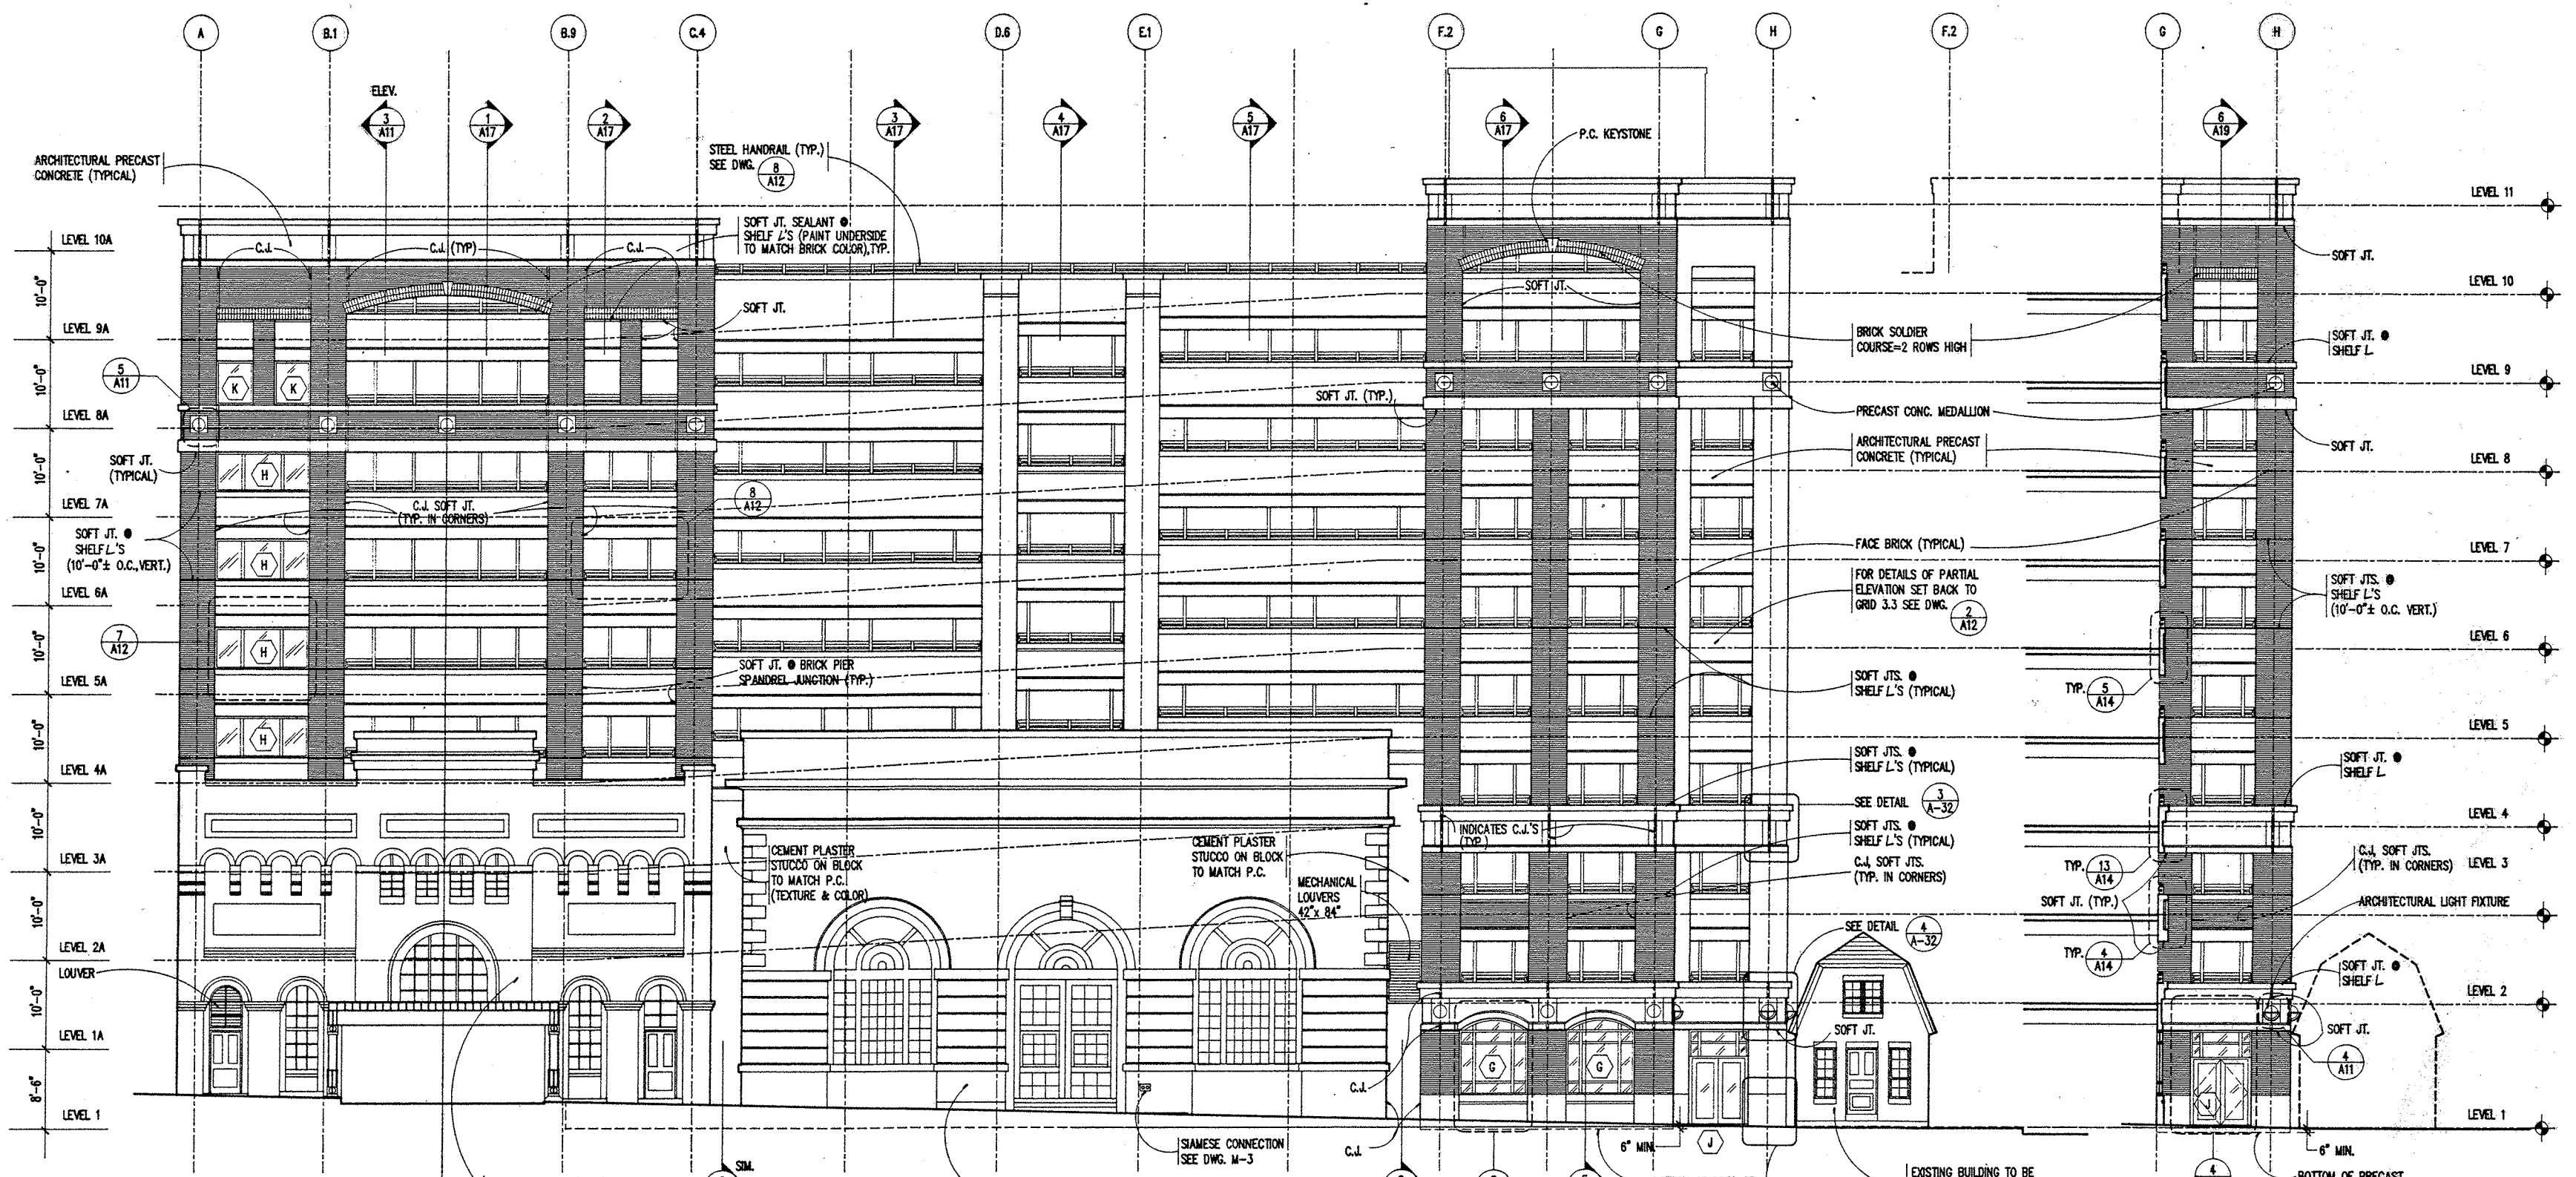

PRATT STREET ELEVATION (SOUTH)
SCALE: 1/8" = 1'-0"


PARTIAL ELEVATION (ON GRID 3.3)
SCALE: 1/8" = 1'-0"

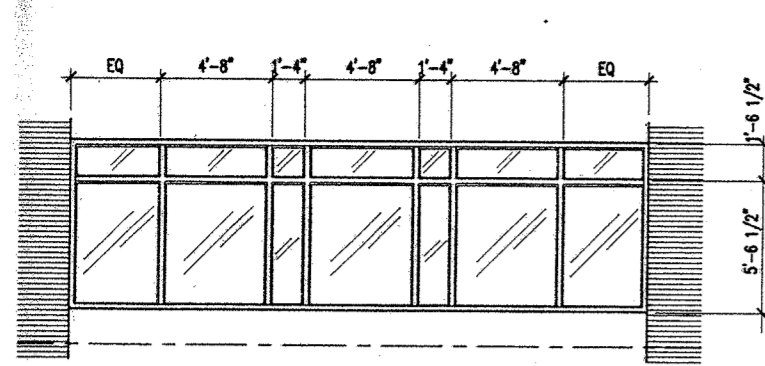

WINDOW "M" ELEVATION

SCALE: 1/4" = 1'-0"


3
A13

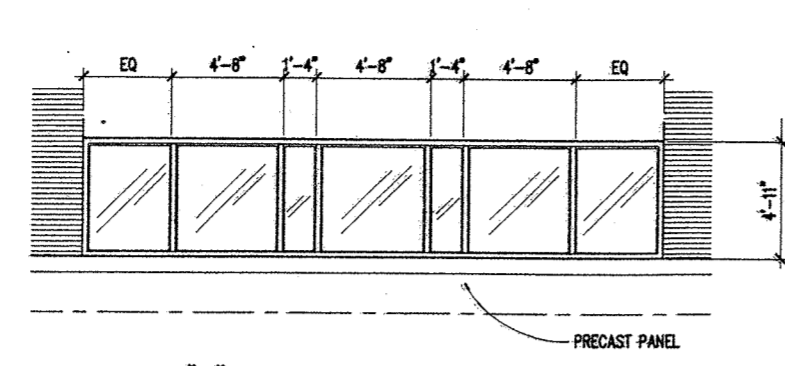

WINDOW "N" ELEVATION

SCALE: 1/4" = 1'-0"


4
A13

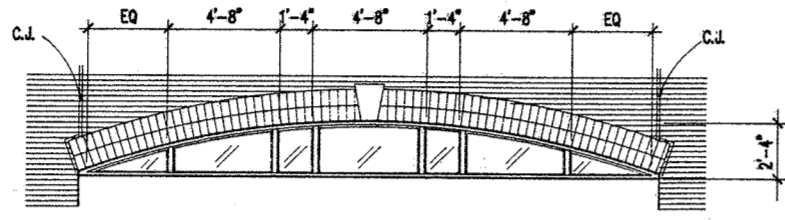

WINDOW "O" ELEVATION

SCALE: 1/4" = 1'-0"


10
A13

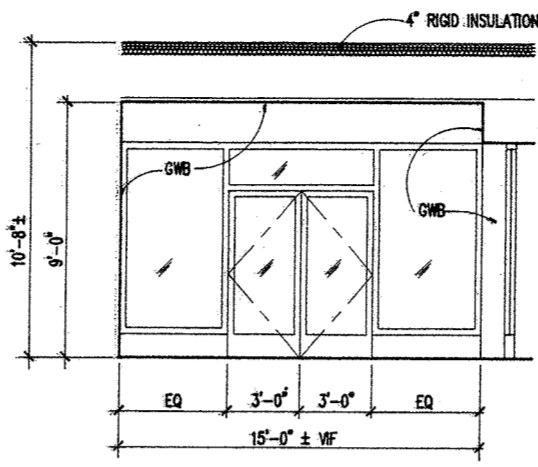

ENTRANCE VESTIBULE

SCALE: 1/4" = 1'-0"


12
A13

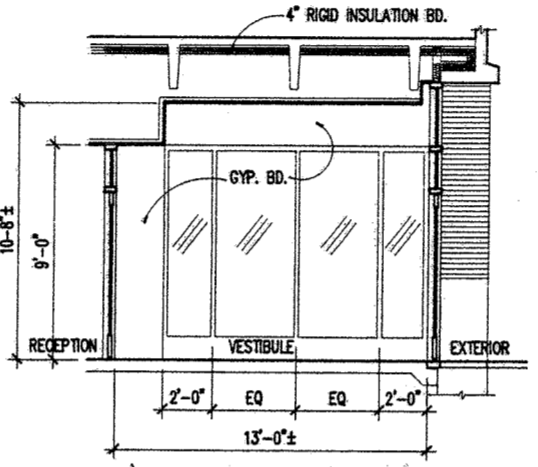

ENTRANCE VESTIBULE

SCALE: 1/4" = 1'-0"


11
A13

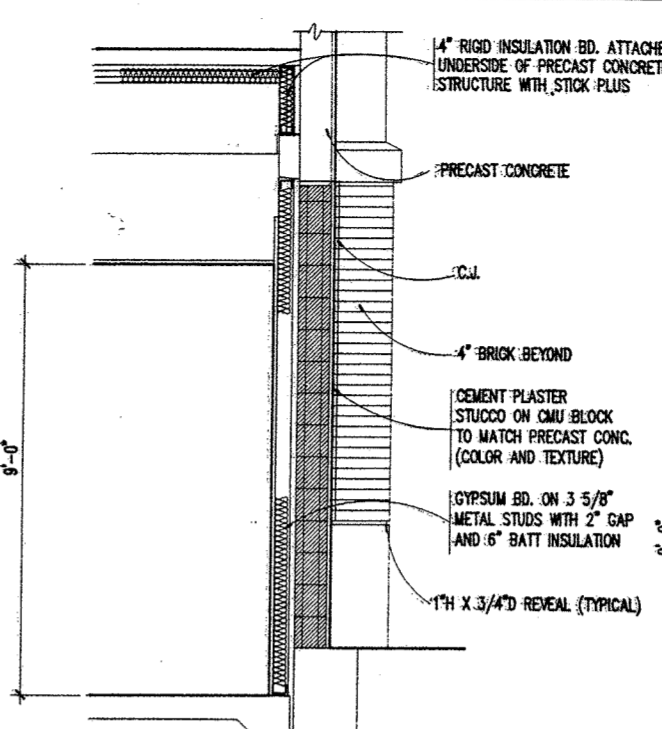

WALL SECTION @ STUCCO INFILL

SCALE: 1/2" = 1'-0"


8
A13

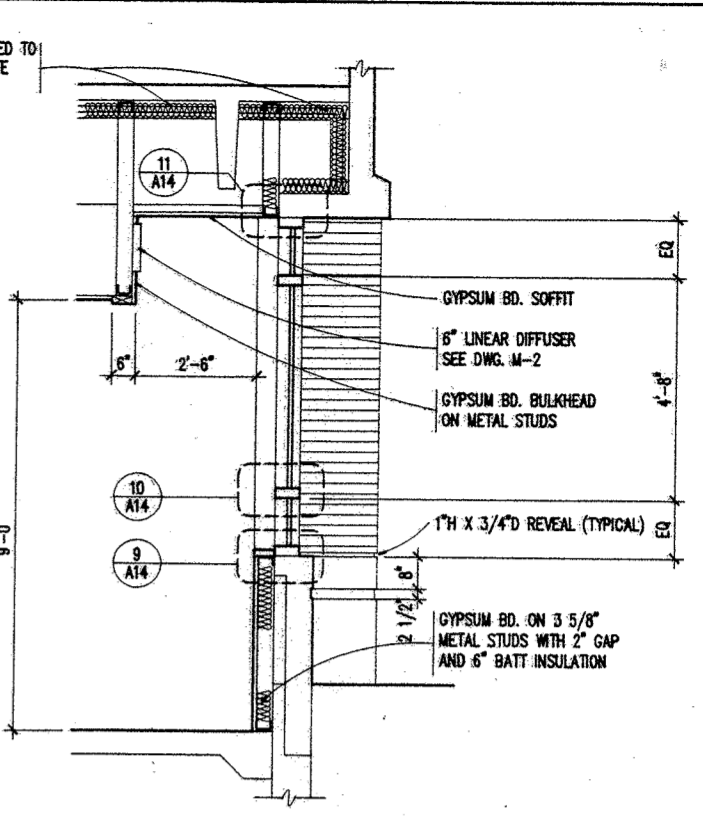

WALL SECTION @ OFFICE WINDOWS

SCALE: 1/2" = 1'-0"


5
A13

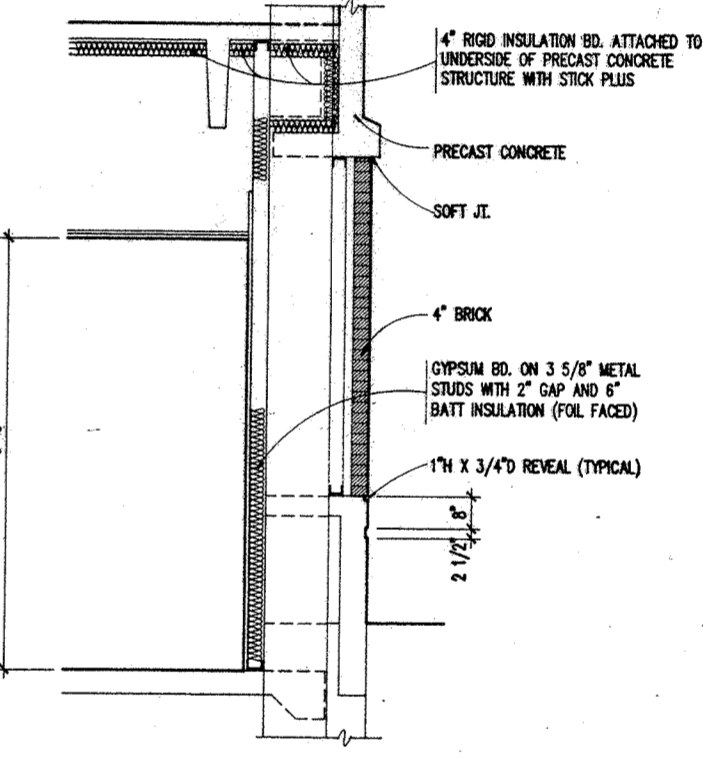

WALL SECTION @ OFFICE PIERS

SCALE: 1/2" = 1'-0"


8
A13

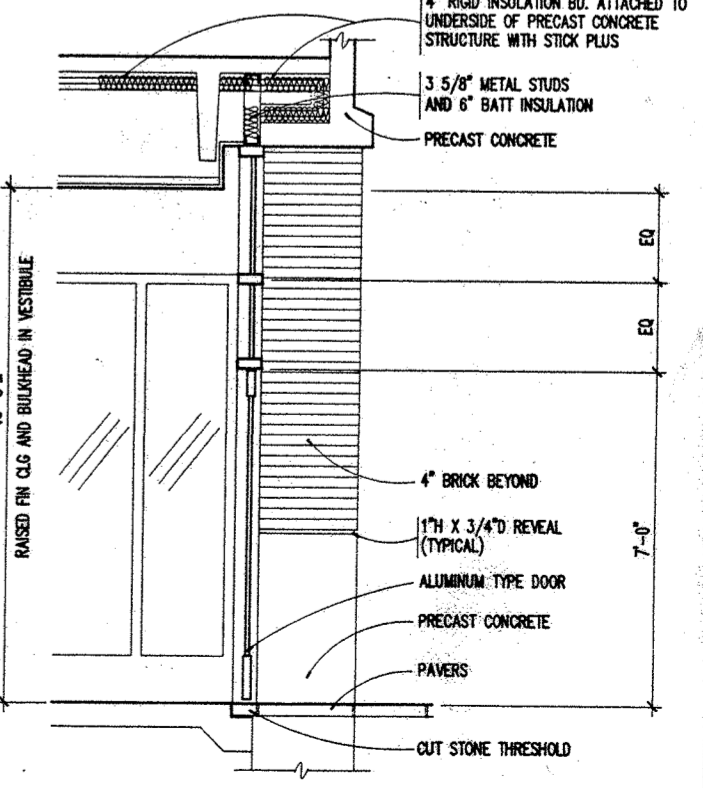

SECTION THRU VESTIBULE

SCALE: 1/2" = 1'-0"


9
A13

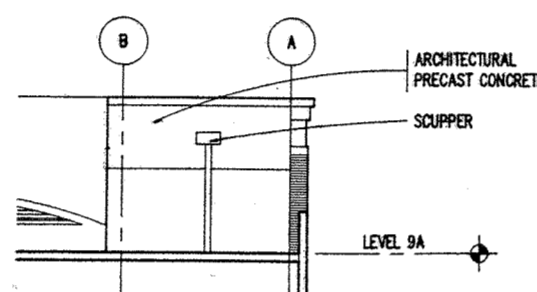

PARTIAL ELEVATION ON GRID 3.8

SCALE: 1/8" = 1'-0"

7
A13

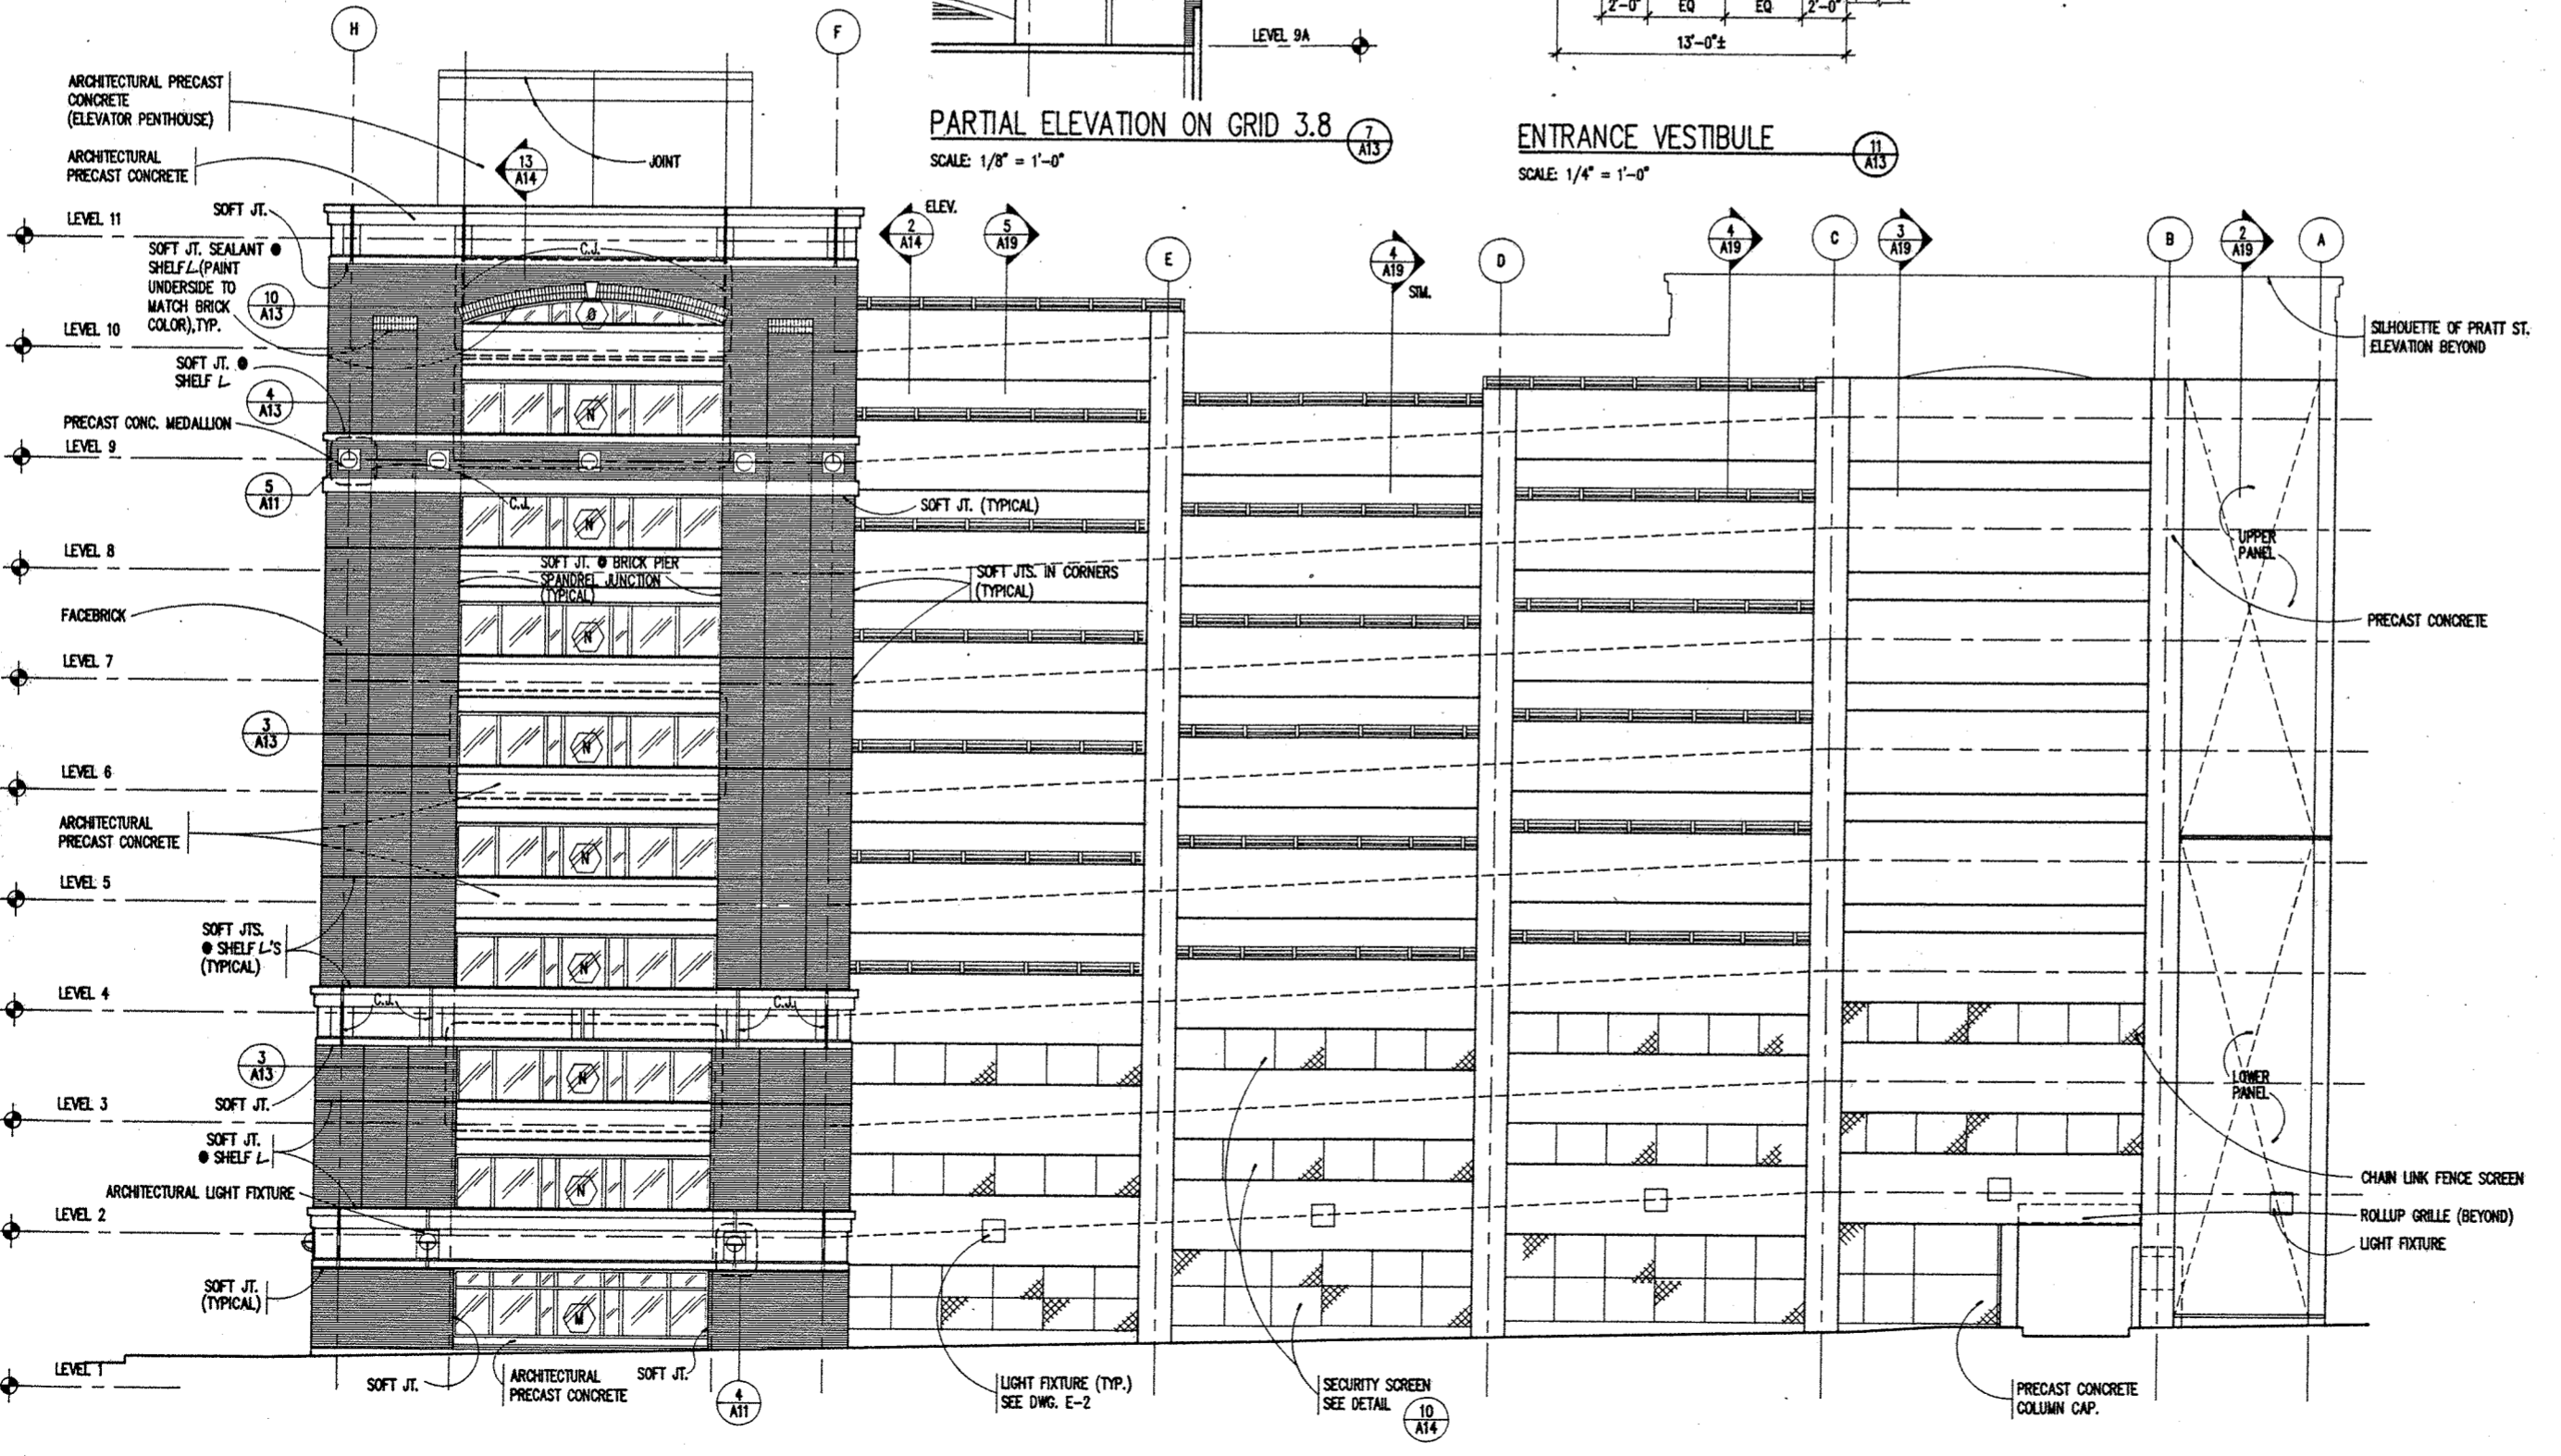

LEMMON STREET ELEVATION (NORTH)

SCALE: 1/8" = 1'-0"

1
A13

WHITING-TURNER
CONTRACTING COMPANY
DESIGNER

BWJ
DESIGNER















PENN STREET PARKING FACILITY
UNIVERSITY OF MARYLAND AT BALTIMORE

LEMMON STREET ELEVATION

A13

SCALE: AS SHOWN
DATE: JULY 1, 1993
PROJECT NO. 93001
DESIGN DRAWN GHPKD


NO.	DATE	BY
1	2/10/94	
2	12/29/93	
3	12/1/93	
4	7/16/93	

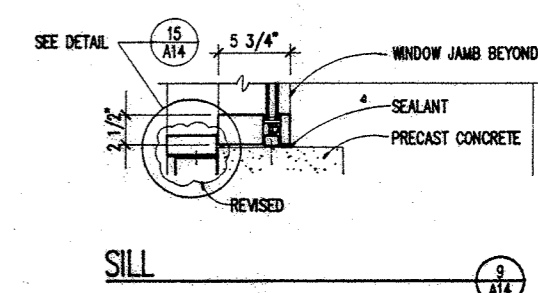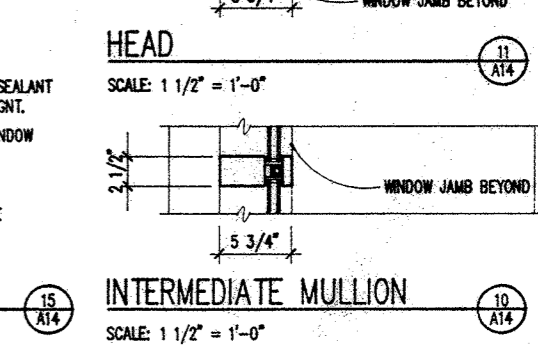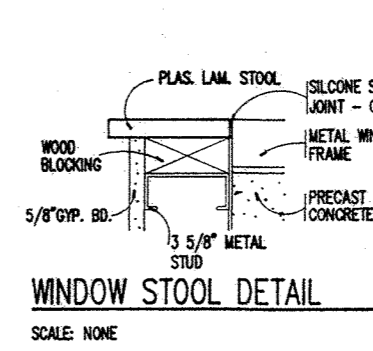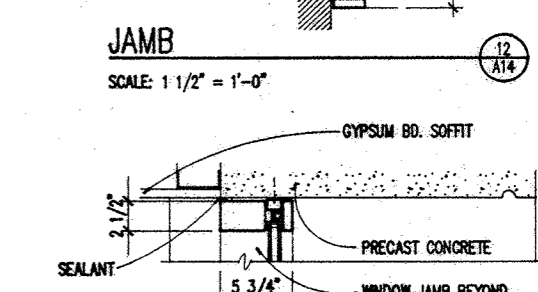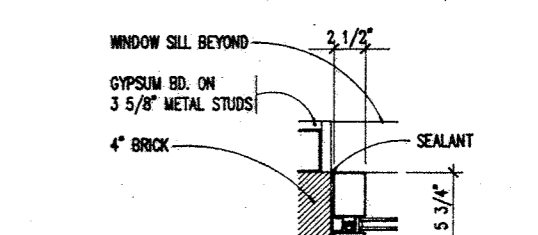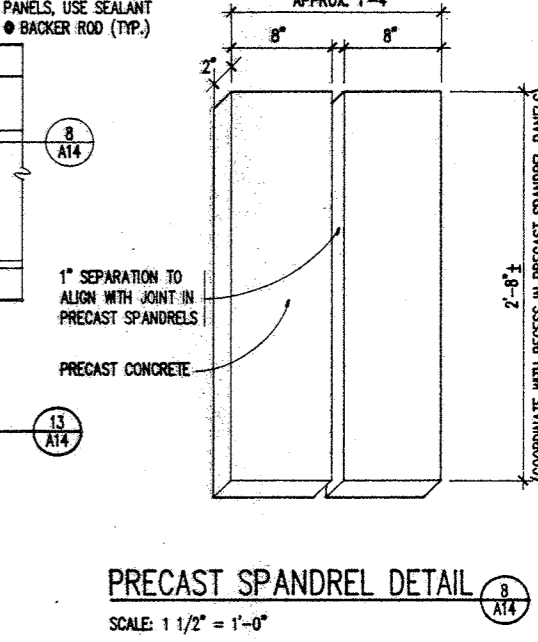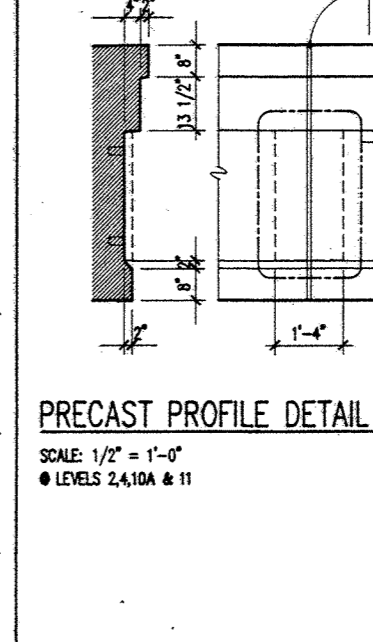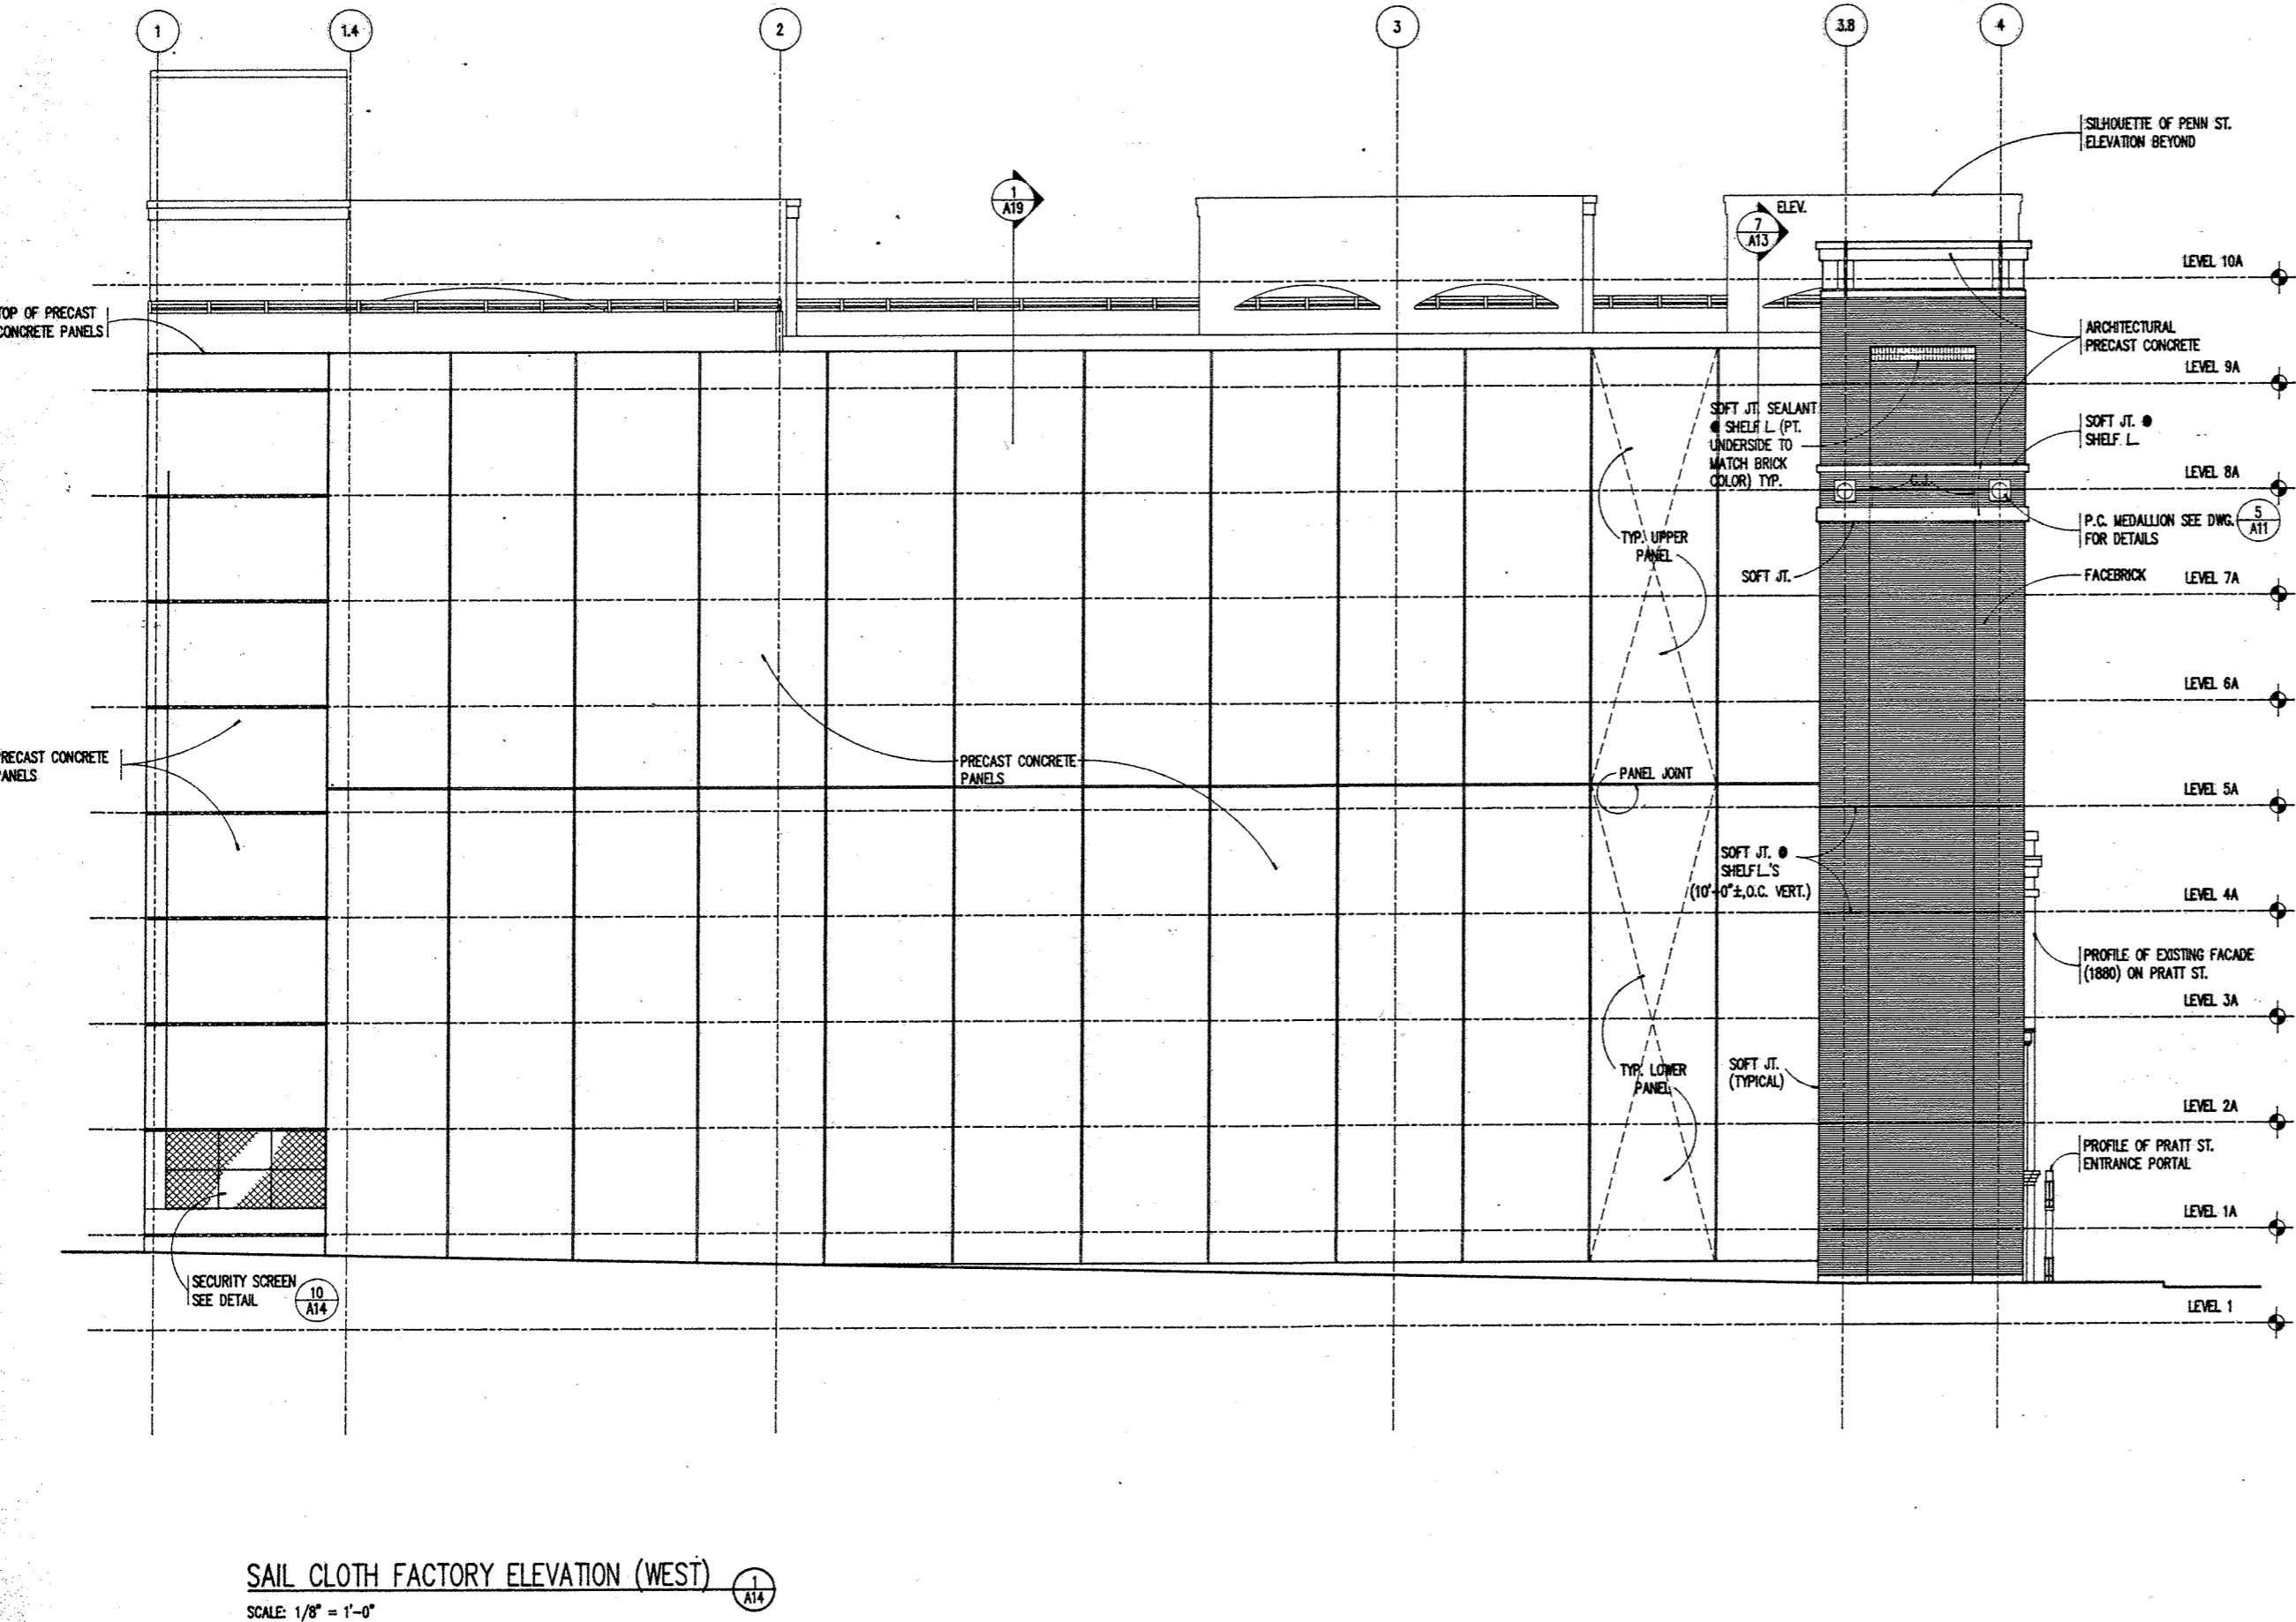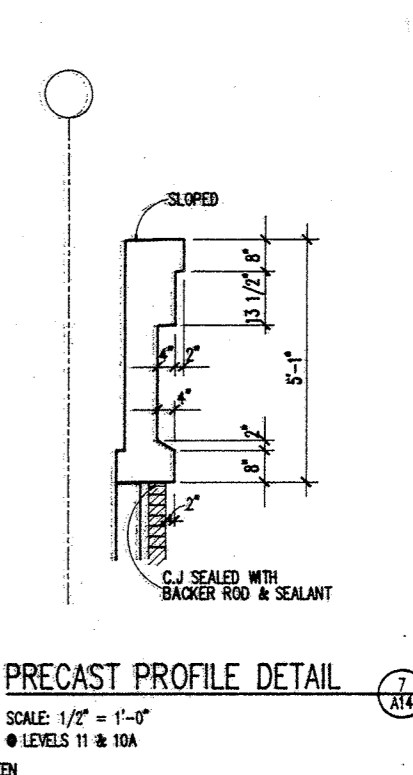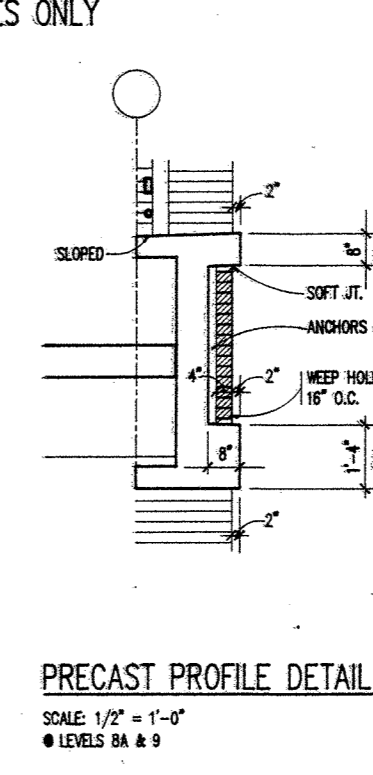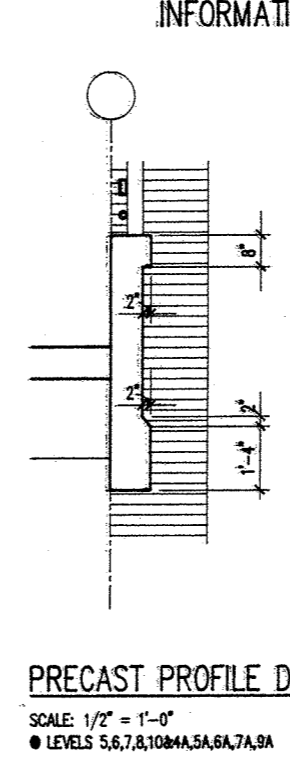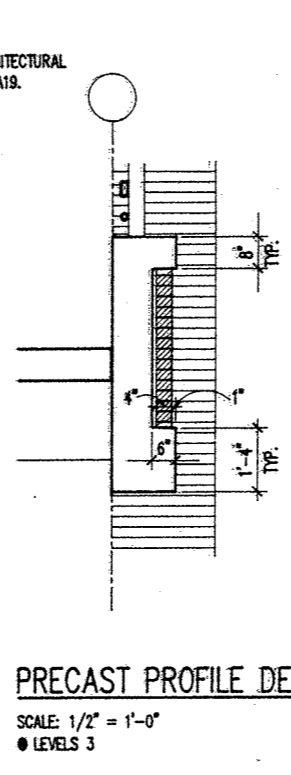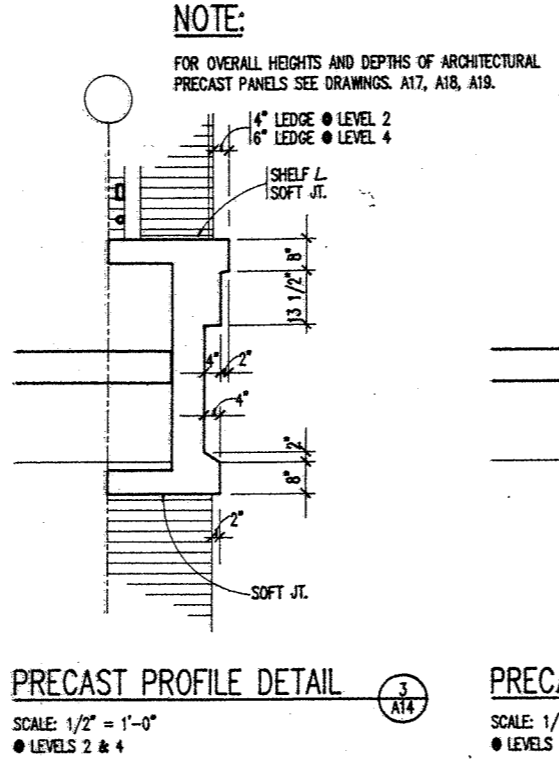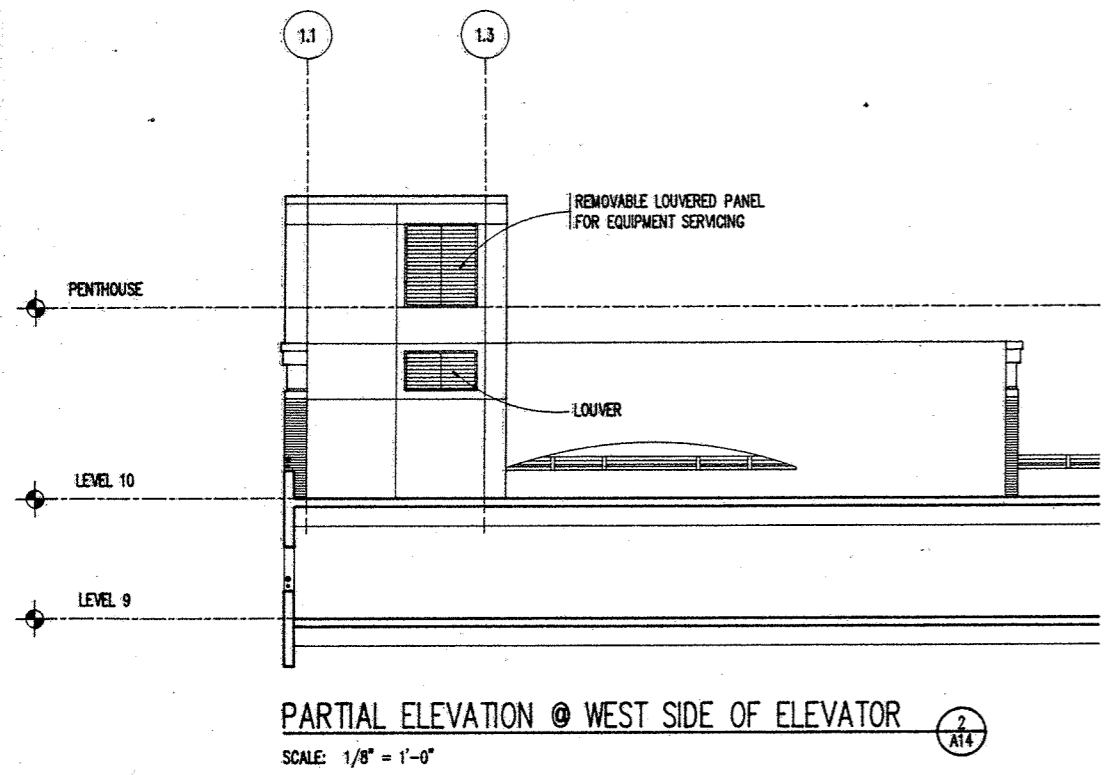


WHITING-TURNER CONTRACTING COMPANY
DESIGNER
DESIGNER
DESIGNER

BWJ
INC. ARCHITECTS
2700 MARKET STREET BALTIMORE, MARYLAND 21201
410-528-7800 FAX 410-528-7801


PENN STREET PARKING FACILITY
UNIVERSITY OF MARYLAND AT BALTIMORE

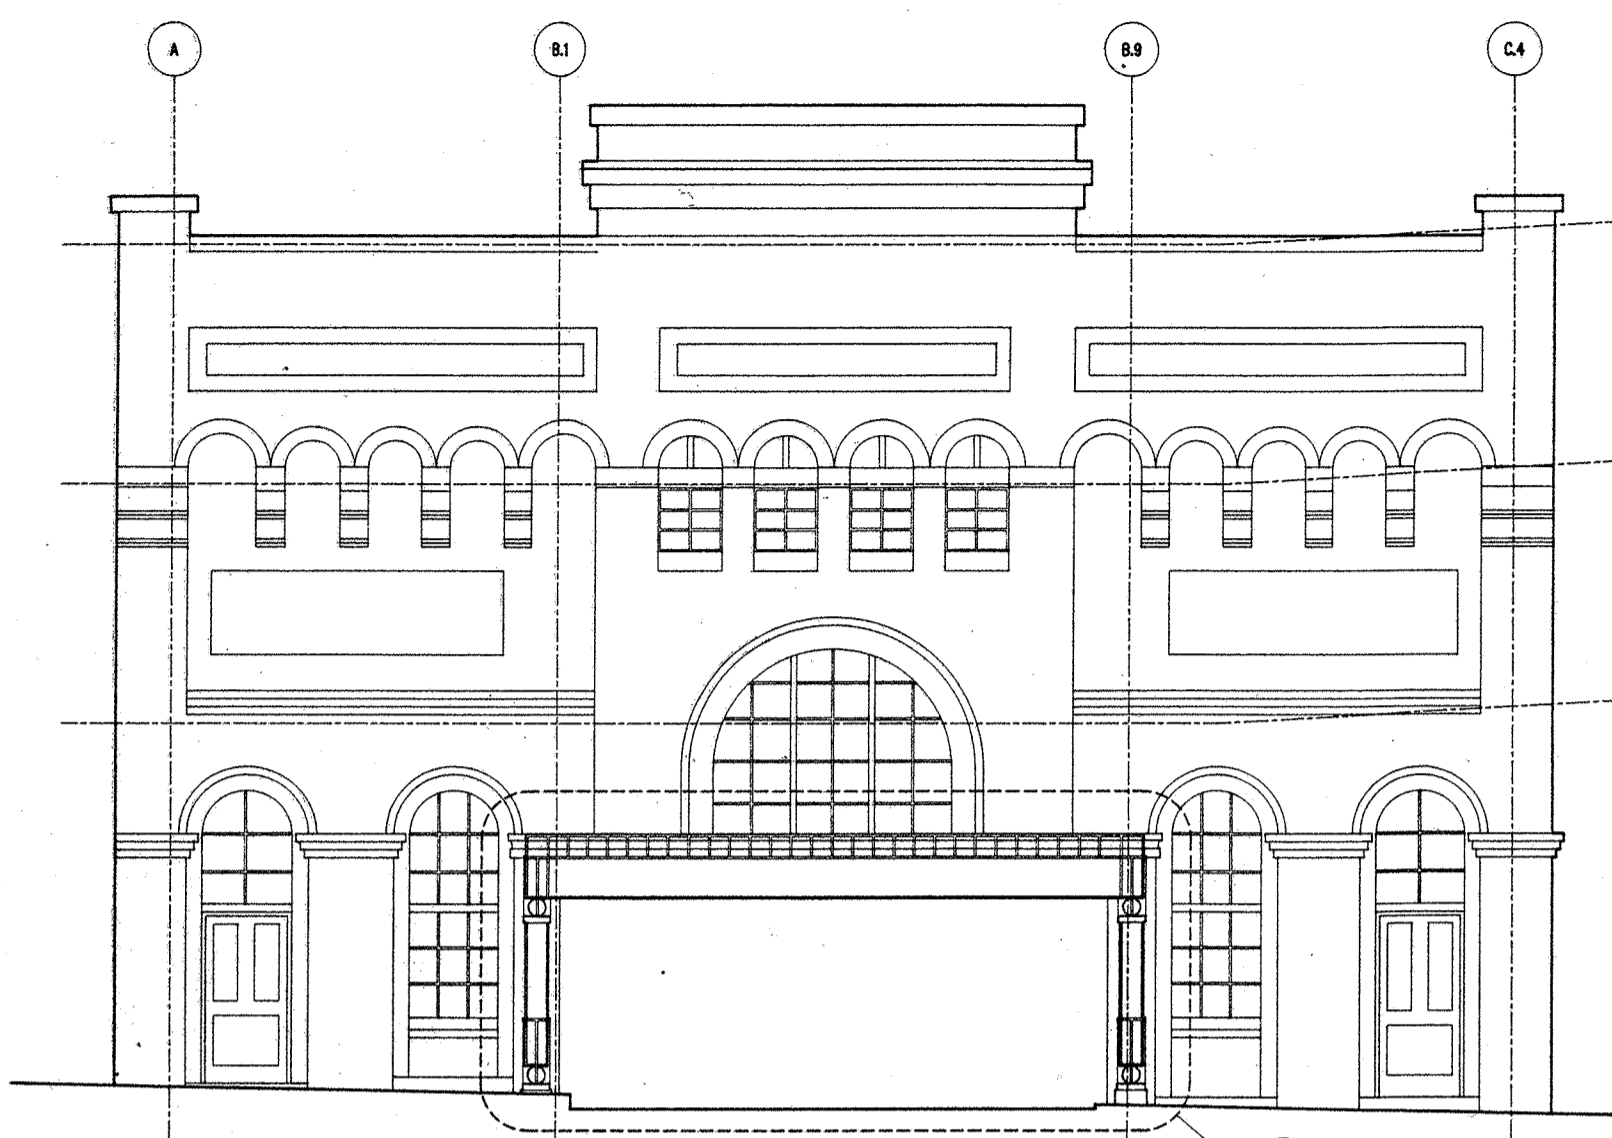


PARTIAL ELEVATION (WITH PORTAL)
1/4" = 1'-0"

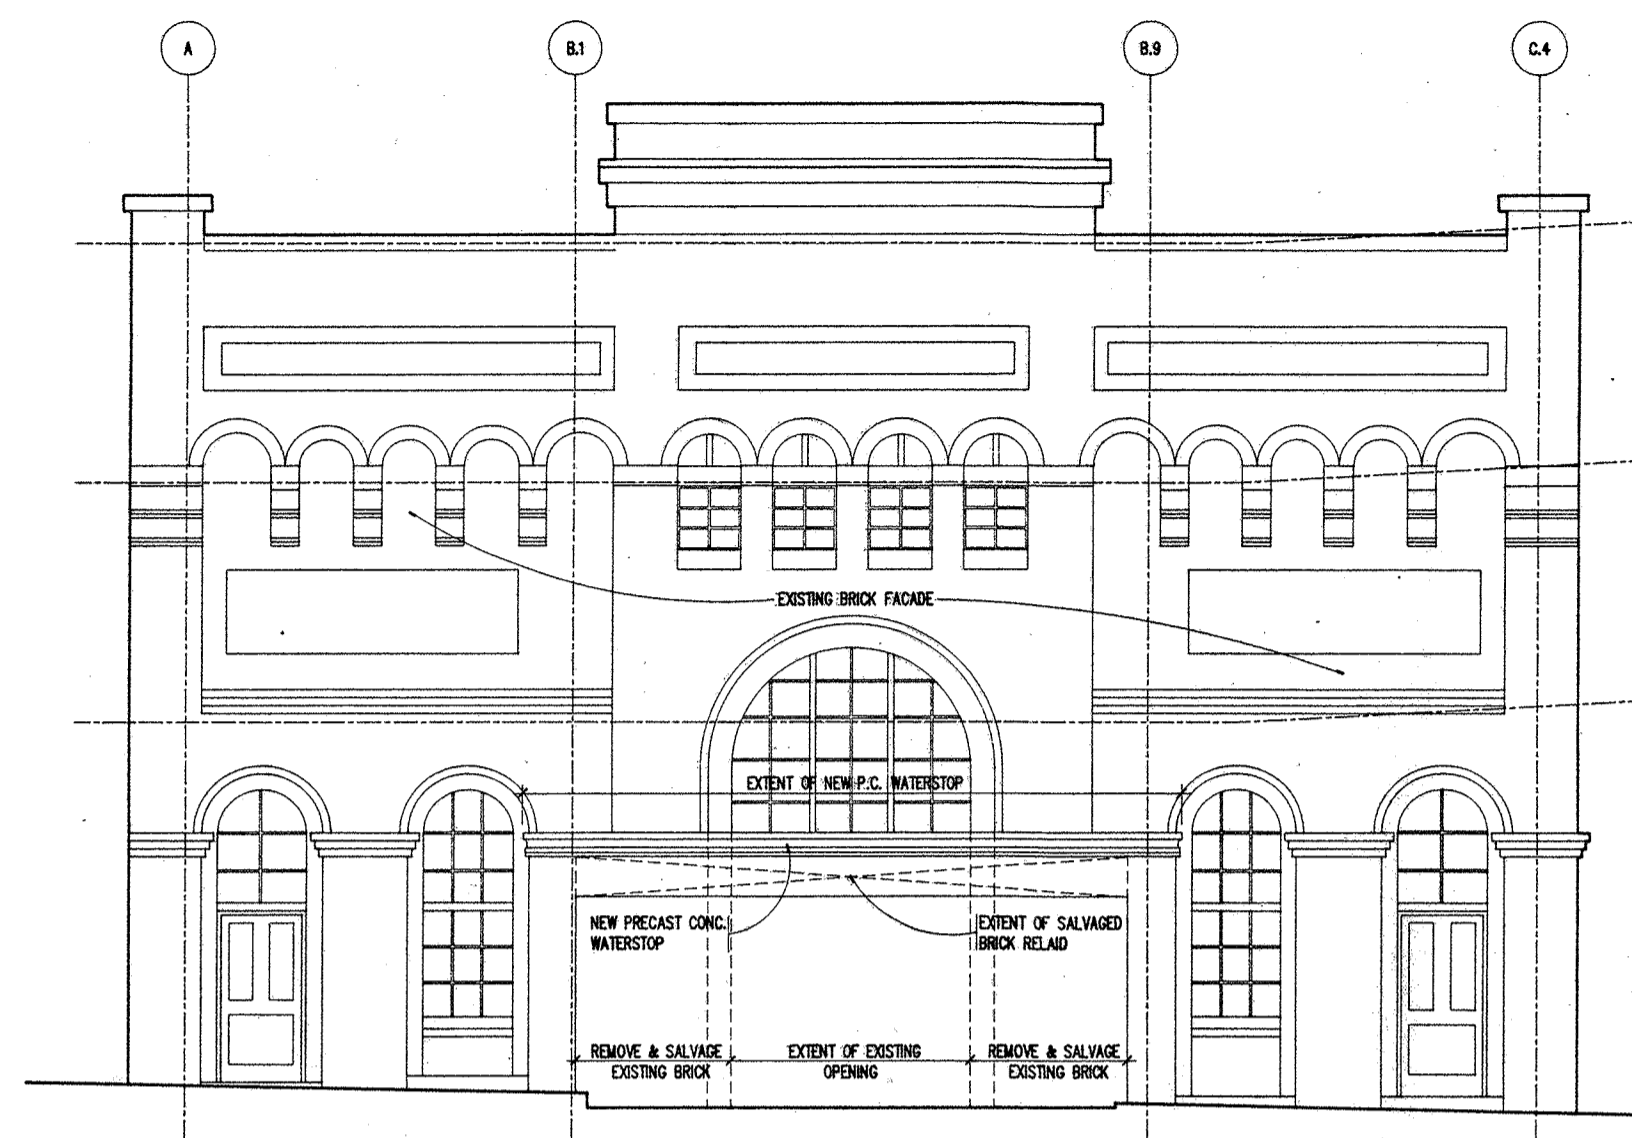


PARTIAL ELEVATION (WITHOUT PORTAL)
1/4" = 1'-0"

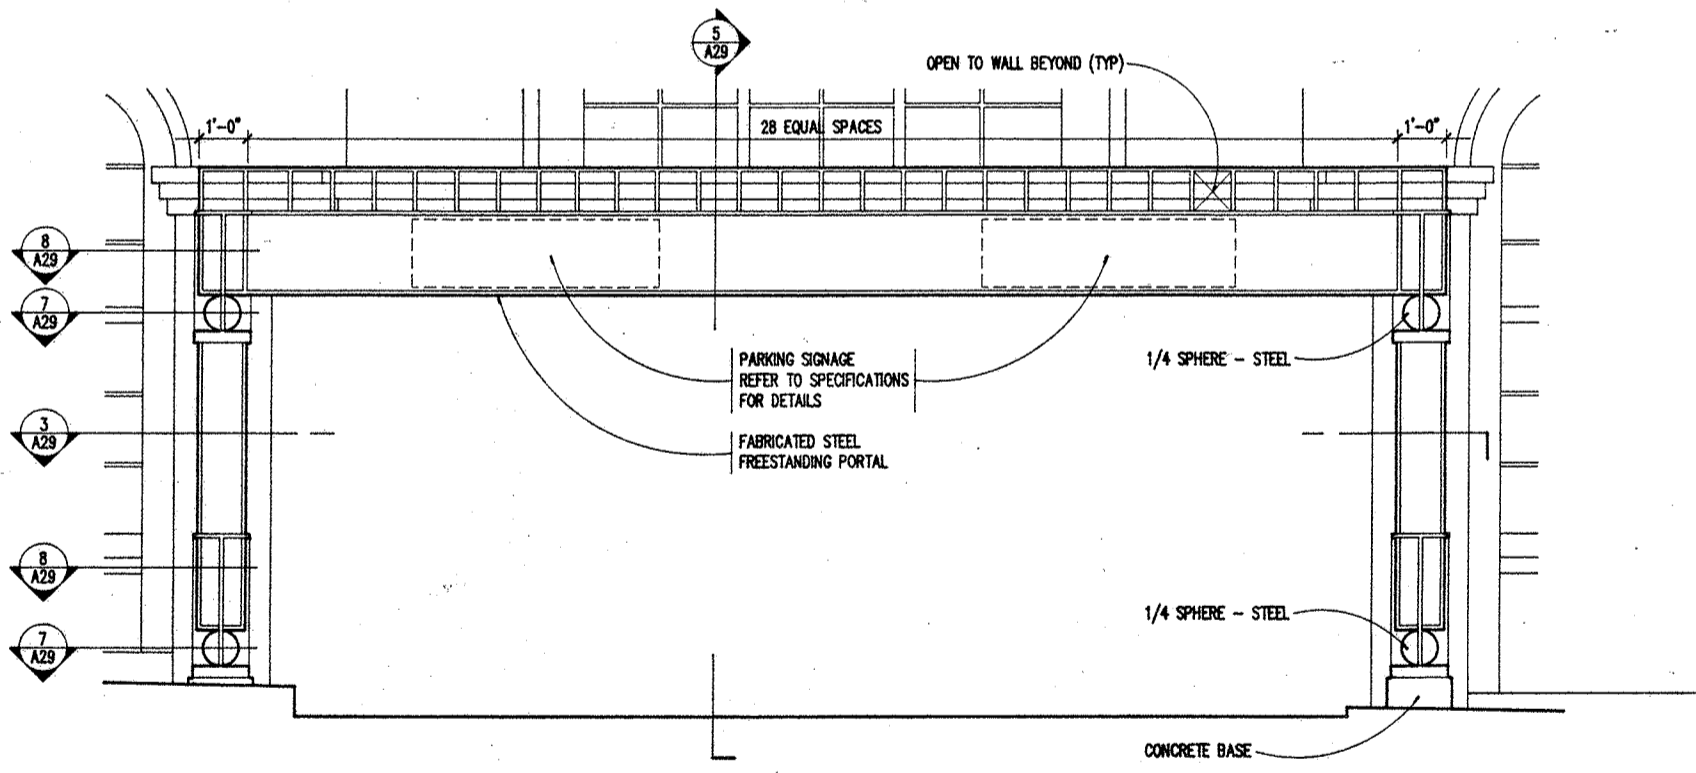


DETAIL ELEVATION OF PORTAL
1/2" = 1'-0"

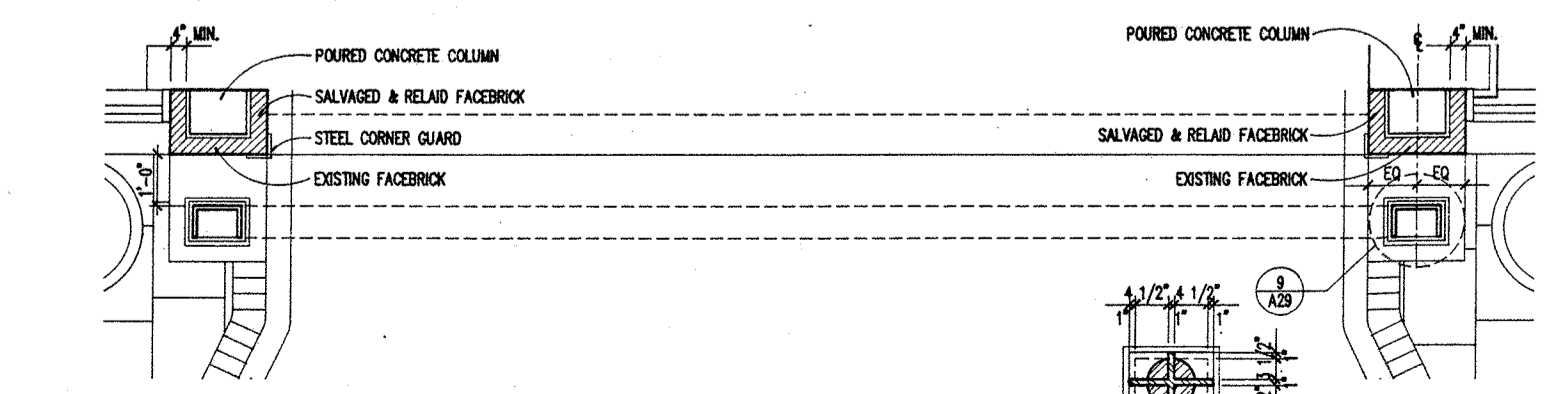

DETAIL PLAN OF PORTAL
1/2" = 1'-0"

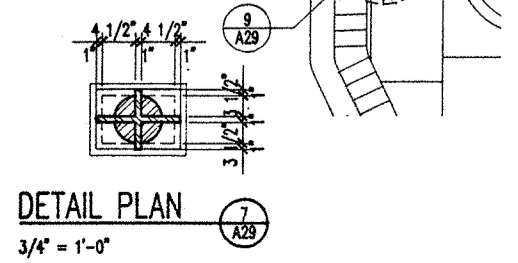

DETAIL PLAN
3/4" = 1'-0"

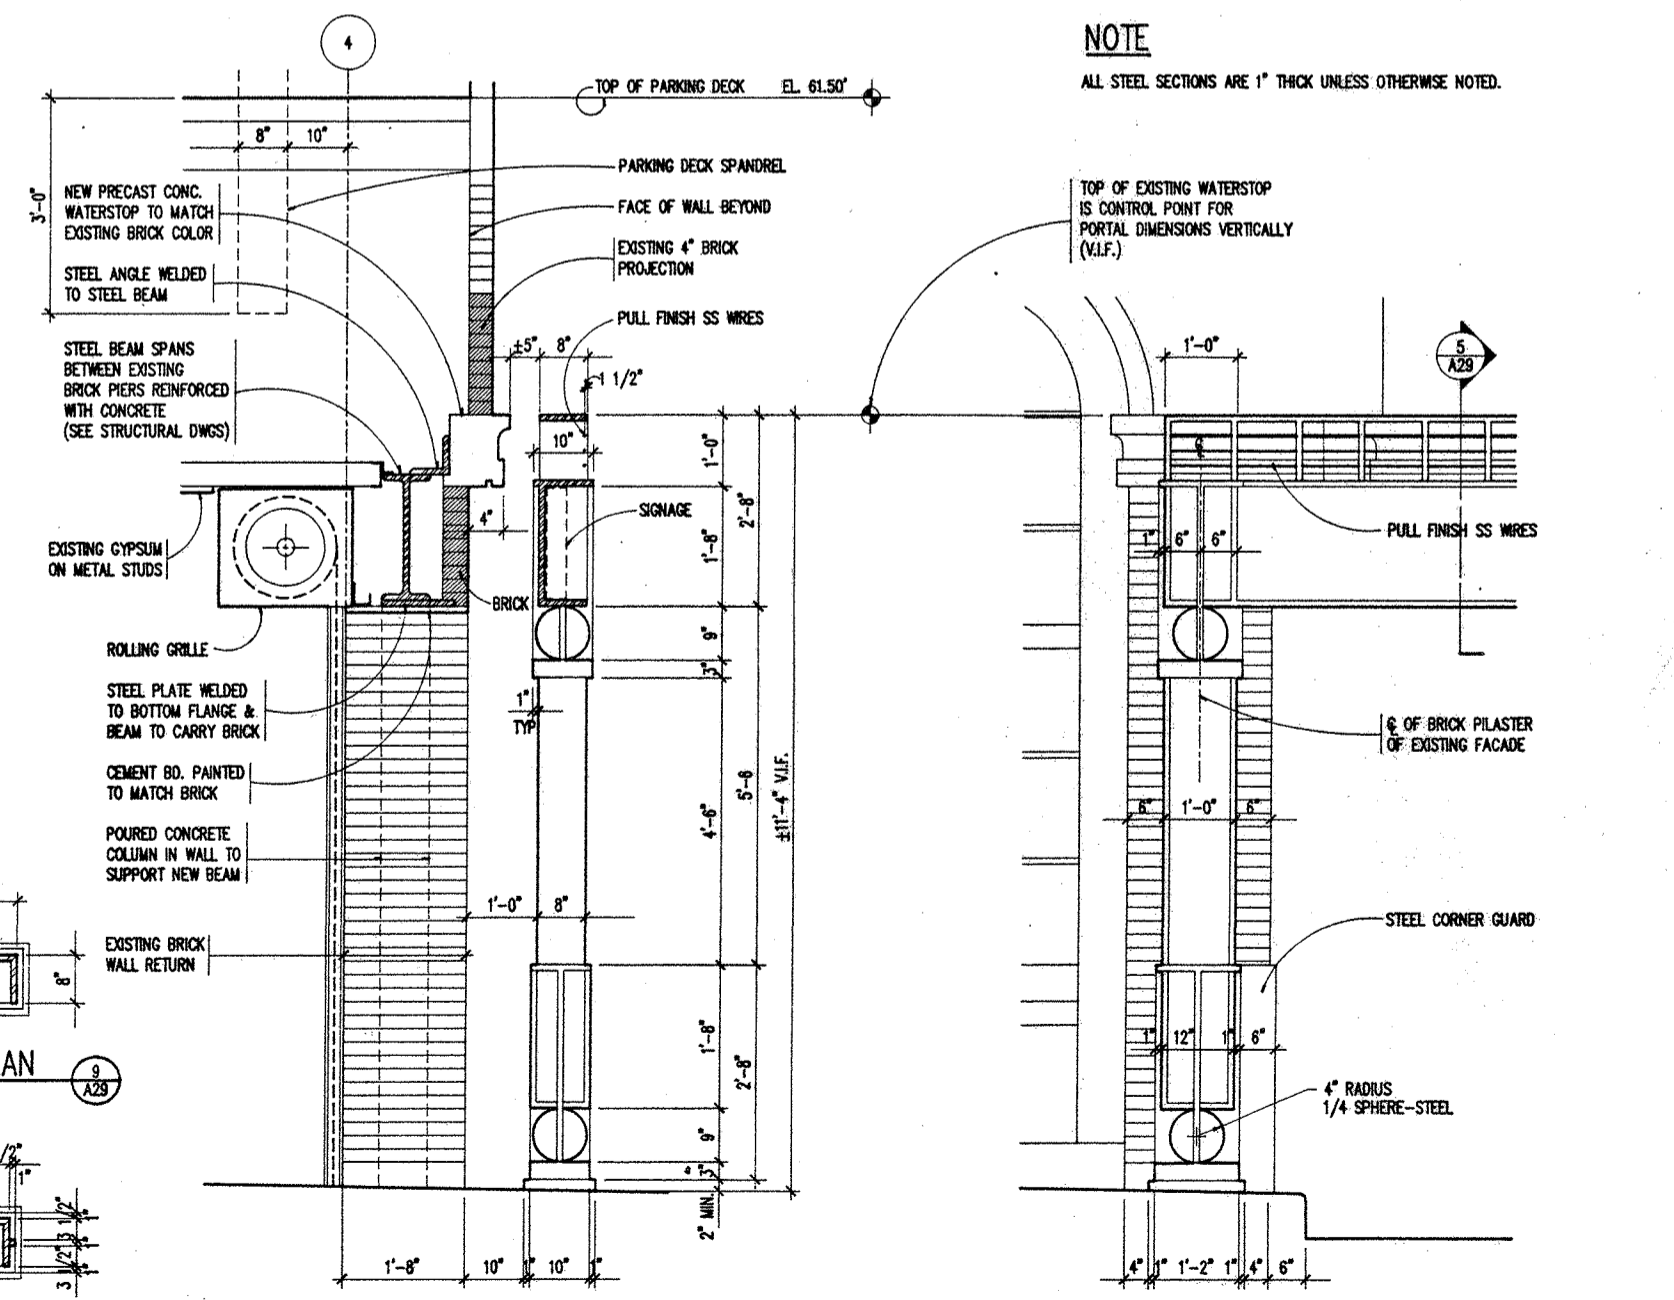

NOTE
ALL STEEL SECTIONS ARE 1" THICK UNLESS OTHERWISE NOTED.


DETAIL PLAN
3/4" = 1'-0"

DETAIL PLAN
3/4" = 1'-0"

PRATT ST. PORTAL (WALL SECTION)
3/4" = 1'-0"

PRATT ST. PORTAL (PARTIAL ELEVATION DETAIL)
3/4" = 1'-0"


NO.	DATE	BY
REVISIONS		
1	JULY 1, 1993	AS SHOWN
PRATT ST. PORTAL ELEVATIONS & DETAILS DRAWING NO. A29		
SCALE: AS SHOWN		
DATE: JULY 1, 1993		
PROJECT NO. 93001		
DESIGN	DRAWN	CHKD.

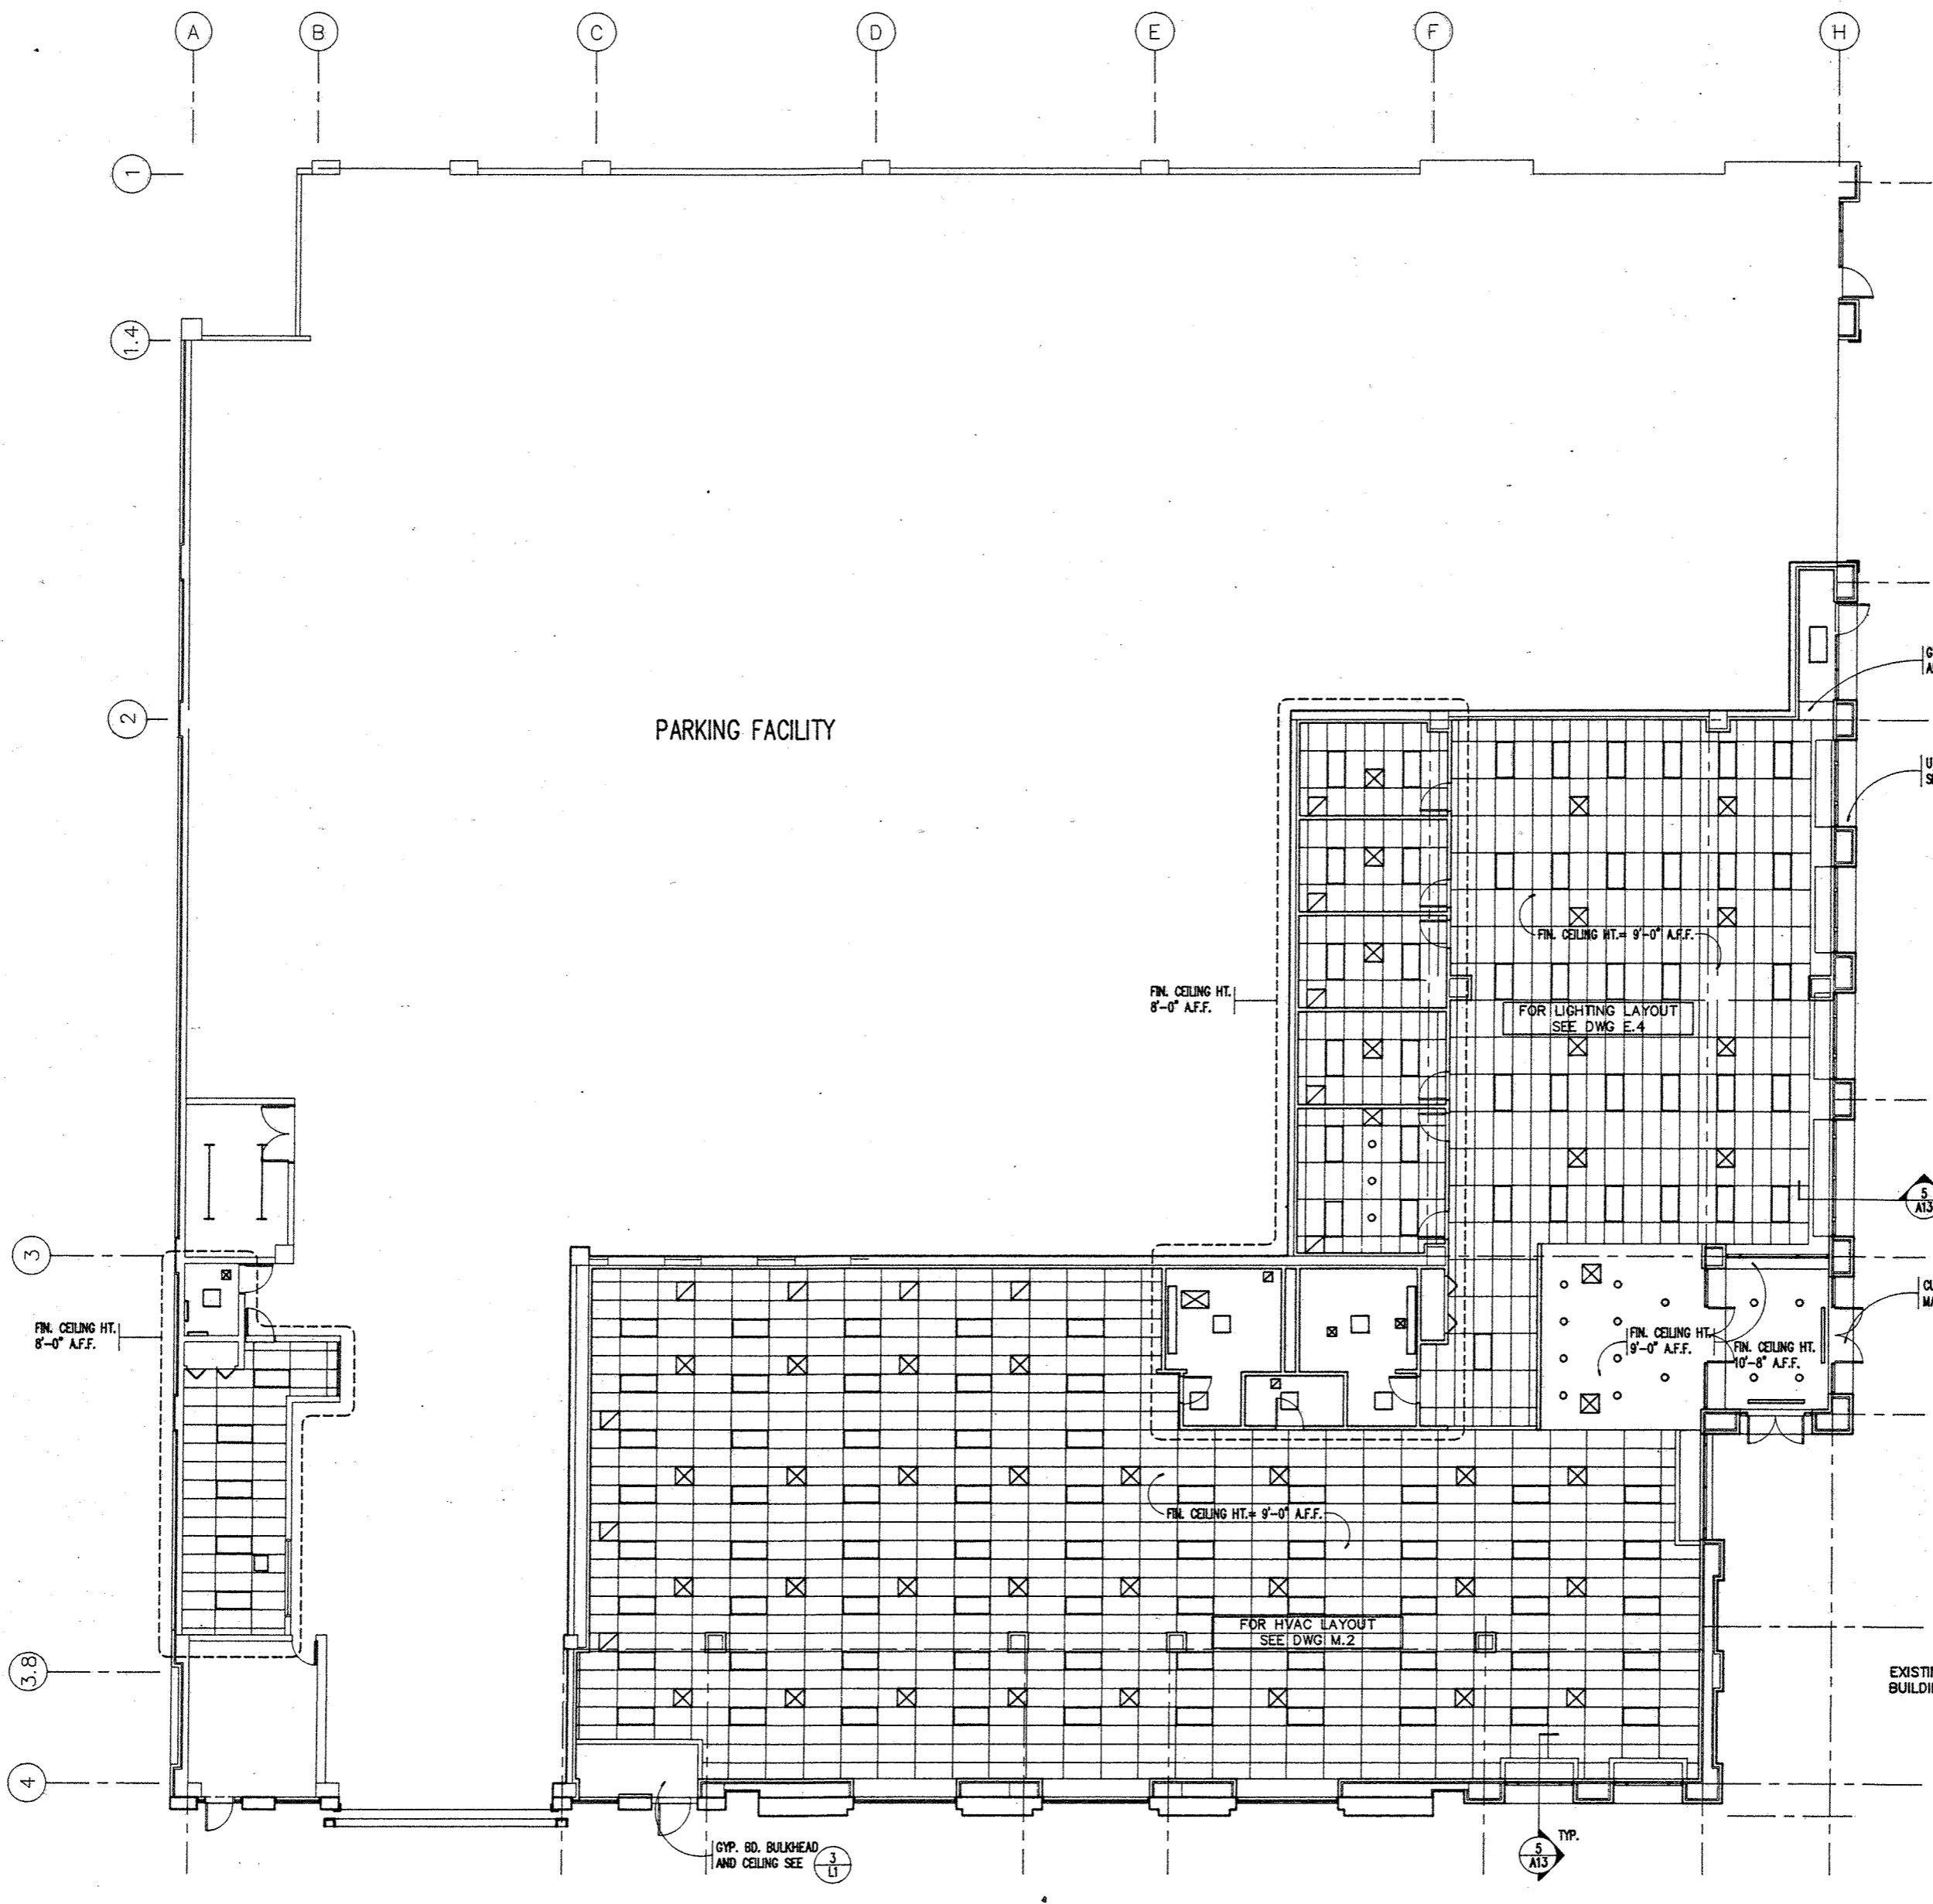


REFLECTED CEILING PLAN - OFFICE FLOOR LEVEL
SCALE: 1/8" = 1'-0"

LEGEND :


- ☒ SUPPLY DIFFUSER
- ☒ RETURN GRILLE

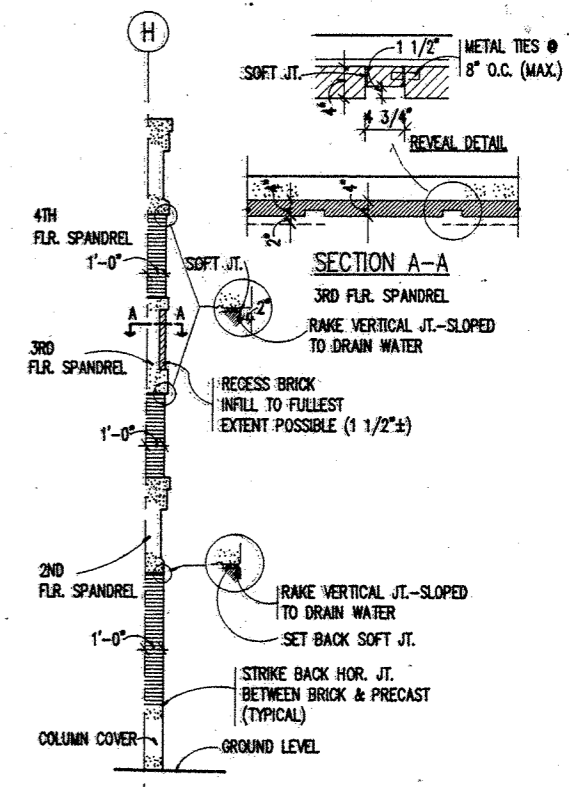


BRICK MASONRY CLAD PERS @ 2.3 & 2.5 C'S

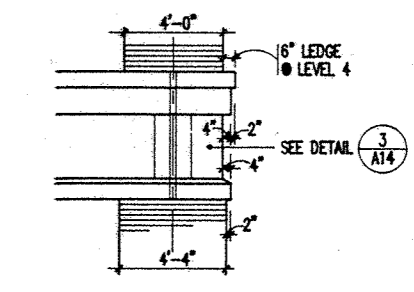

PARTIAL ELEVATION
SCALE: 1/4" = 1'-0"

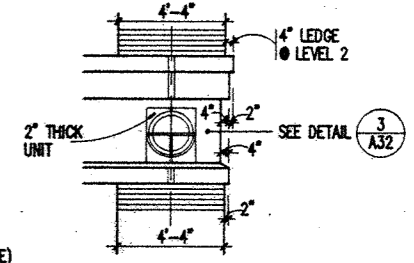

PARTIAL ELEVATION
SCALE: 1/4" = 1'-0"

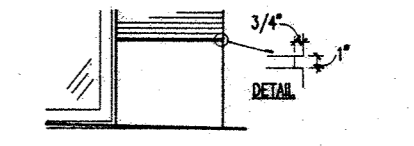


PARTIAL ELEVATION
SCALE: 1/4" = 1'-0"


WHITING-TURNER
CONTRACTING COMPANY
DESIGNER
DESIGNER
DESIGNER

PENN STREET PARKING FACILITY
UNIVERSITY OF MARYLAND AT BALTIMORE

NO.	DATE	BY
2	9/16/93	
1	7/16/93	
REVISIONS		
OFFICE REFLECTED CEILING PLAN		
DRAWING NO. A32		
SCALE: 1/8" = 1'-0"		
DATE: JULY 1, 1993		
PROJECT NO. 93001		
DESIGN	DRAWN	CHECKED


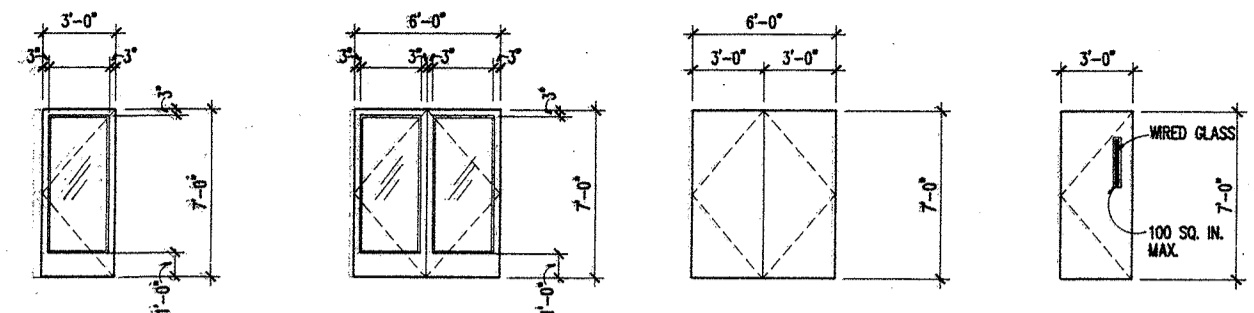


A (ALUM) B (ALUM) C (STEEL) D (STEEL)
B LABEL 1 1/2HR

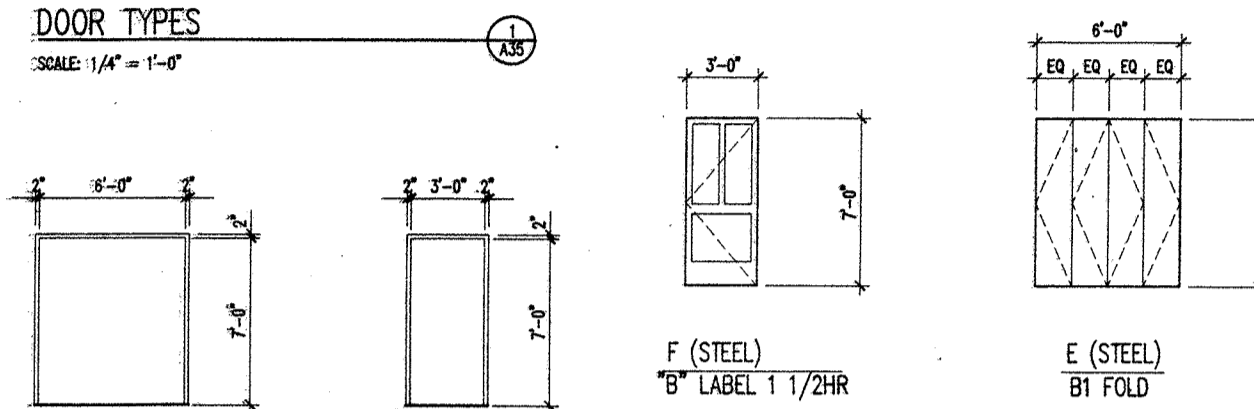


E (STEEL) F (STEEL)
B LABEL 1 1/2HR

DOOR TYPES
SCALE: 1/4" = 1'-0"

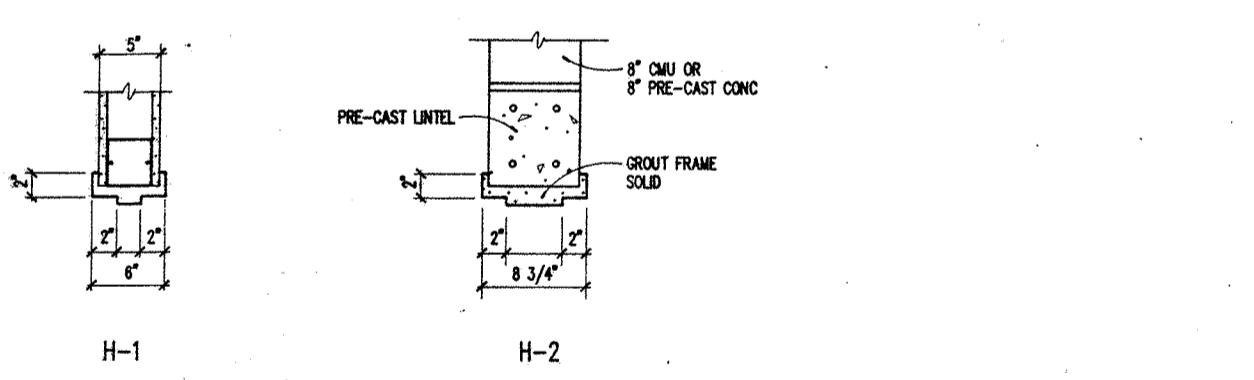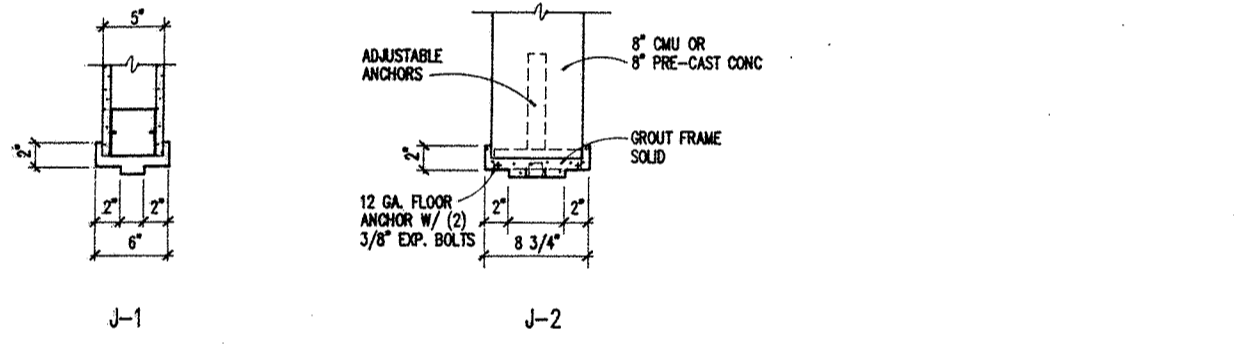

FRAME TYPES
SCALE: 1/4" = 1'-0"

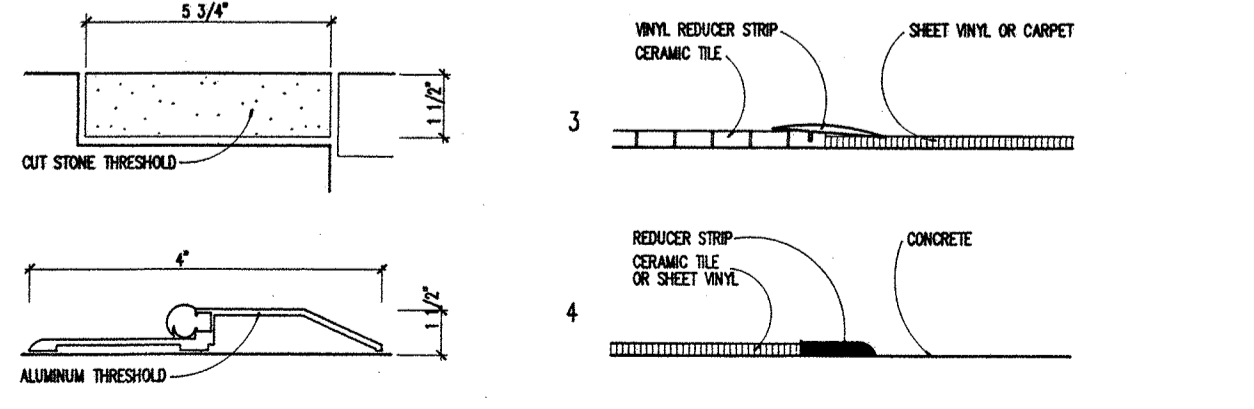

DOOR JAMB AND HEAD DETAILS
SCALE: 1/2" = 1'-0"

THRESHOLDS/ TRANSITION STEPS
NOT TO SCALE

DOOR SCHEDULE

MK	LOCATION	SIZE	DOOR		FRAME				REMARKS	MK				
			TYPE	MATERIAL	WALL WIDTH	JAMB	HEAD	THRESHOLD						
101	ST#1 EXT.	3'-4" 7'-0"	A	AL	-	F-1	*	*	1	AL	-	1	*KAWNEER 1600 SERIES	101
102	OFF. EXT.	3'-4" 7'-0"	A	AL	-	F-1	*	*	2	AL	-	1	*KAWNEER 1600 SERIES	102
103	VEST. EXT.	6'-0" 7'-0"	B	AL	-	F-2	*	*	1	AL	-	1	*KAWNEER 1600 SERIES, CARDKEY OPERATED	103
104	VEST. EXT.	6'-0" 7'-0"	B	AL	-	F-2	*	*	1	AL	-	1	*KAWNEER 1600 SERIES, CARDKEY OPERATED	104
105	OFF. EXT.	3'-4" 7'-6"	F	HM	-	-	*	*	2	HM	-	2	*IN EXIST. 1880 FACADE OPENING-MATCH EXIST.	105
106	EXT. ST#2	3'-4" 7'-6"	F	HM	-	-	*	*	1	HM	-	2	*IN EXIST. 1880 FACADE OPENING-MATCH EXIST.	106
107	P.G. TRANS	6'-0" 7'-0"	C	HM	-	F-4	J-2	H-2	-	HM	1/2HR	3		107
108	P.G. TRANS	3'-0" 7'-0"	D	HM	-	F-5	J-2	H-2	-	HM	1/2HR	4		108
109	P.G. GEN.	6'-0" 7'-0"	C	HM	-	F-4	J-2	H-2	-	HM	1/2HR	3		109
110	P.G. GEN.	3'-0" 7'-0"	D	HM	-	F-5	J-2	H-2	-	HM	1/2HR	4		110
111	MECH. P.G.	3'-0" 7'-0"	D	HM	-	F-5	J-2	H-2	-	HM	1/2HR	4		111
112	EL. MECH. CONC.	3'-0" 7'-0"	D	HM	-	F-5	J-2	H-2	-	HM	-	4		112
113	PH. MECH. CONC.	3'-0" 7'-0"	D	HM	-	F-5	J-2	H-2	-	HM	-	4		113
114	MECH. MECH. CONC.	3'-0" 7'-0"	D	HM	-	F-5	J-2	H-2	-	HM	-	4		114
115	WATER MECH.	3'-0" 7'-0"	D	HM	-	F-5	J-2	H-2	-	HM	-	4		115
116	P.G. ST#2	3'-0" 7'-0"	D	HM	-	F-5	J-2	H-2	2	HM	1/2HR	2		116
117	P.G. ST#2	3'-0" 7'-0"	D	HM	-	F-5	J-2	H-2	4	HM	1/2HR	5		117
118	R.R. P.G.	3'-0" 7'-0"	D	HM	-	F-5	J-2	H-2	4	HM	-	4		118
119	P.G. MAIN	6'-0" 7'-0"	C	HM	-	F-4	J-2	H-2	-	HM	1/2HR	3		119
120	O.O. P.O.	3'-0" 7'-0"	D	WD	-	F-5	J-1	H-1	-	HM	-	5		120
121	O.O. P.O.	3'-0" 7'-0"	D	WD	-	F-5	J-1	H-1	-	HM	-	5		121
122	O.O. P.O.	3'-0" 7'-0"	D	WD	-	F-5	J-1	H-1	-	HM	-	5		122
123	O.O. P.O.	3'-0" 7'-0"	D	WD	-	F-5	J-1	H-1	-	HM	-	5		123
124	O.O. CONF.	3'-0" 7'-0"	D	WD	-	F-5	J-1	H-1	-	HM	-	9		124
125	O.O. CONF.	3'-0" 7'-0"	D	WD	-	F-5	J-1	H-1	-	HM	-	9		125
126	O.O. CL.	6'-0" 7'-0"	E	WD	-	F-4	J-1	H-1	-	HM	-	10		126
127	O.O. R.R.	3'-0" 7'-0"	D	WD	-	F-4	J-1	H-1	3*	HM	-	11	1" UNDERCUT,*TO BE INSTALLED W/ CARPET	127
128	O.O. JAN.	3'-0" 7'-0"	D	WD	-	F-5	J-1	H-1	3*	HM	-	4	1" UNDERCUT,*TO BE INSTALLED W/ CARPET	128
129	O.O. R.R.	3'-0" 7'-0"	D	WD	-	F-5	J-1	H-1	3*	HM	-	11	1" UNDERCUT,*TO BE INSTALLED W/ CARPET	129
130	REC. VEST.	6'-0" 7'-0"	B	AL	-	F-1	*	*	3**	AL	-	2	*KAWNEER 1600 SERIES, **INSTALLED W/ CARPET	130
201	MECH. P.G.	6'-0" 7'-0"	C	HM	-	F-4	J-2	H-2	2	HM	1/2HR	3		201
202	P.G. ST#2	3'-0" 7'-0"	D	HM	-	F-5	J-2	H-2	2	HM	1/2HR	7		202
301	P.G. ST#2	3'-0" 7'-0"	D	HM	-	F-5	J-2	H-2	2	HM	1/2HR	7		301
401	P.G. ST#2	3'-0" 7'-0"	D	HM	-	F-5	J-2	H-2	2	HM	1/2HR	7		401
501	P.G. ST#2	3'-0" 7'-0"	D	HM	-	F-5	J-2	H-2	2	HM	1/2HR	7		501
601	P.G. ST#2	3'-0" 7'-0"	D	HM	-	F-5	J-2	H-2	2	HM	1/2HR	7		601
701	P.G. ST#2	3'-0" 7'-0"	D	HM	-	F-5	J-2	H-2	2	HM	1/2HR	7		701
801	P.G. ST#2	3'-0" 7'-0"	D	HM	-	F-5	J-2	H-2	2	HM	1/2HR	7		801
901	P.G. ST#2	3'-0" 7'-0"	D	HM	-	F-5	J-2	H-2	2	HM	1/2HR	7		901
1001	P.G. ST#1	6'-0" 7'-0"	C	HM	-	F-4	J-2	H-2	2	AL	-	8		1001
1002	ST#3 ST#1	3'-0" 7'-0"	D	HM	-	F-5	J-2	H-2	-	HM	1/2HR	6		1002
1101	M.P. ST#3	3'-0" 7'-0"	D	HM	-	F-5	J-2	H-2	-	HM	1/2HR	6		1101

WHITING-TURNER
CONTRACTING COMPANY
DESIGNER
DESIGNER
DESIGNER

BWJ
INC. ARCHITECTS
2701 MARYLAND DRIVE, BALTIMORE, MD 21206
(410) 528-7000


PENN STREET PARKING FACILITY
UNIVERSITY OF MARYLAND AT BALTIMORE

3/9/94 DOORS
3/8/94 HOWE
7/16/93
NO. DATE BY
REVISIONS


DOOR SCHEDULE

DRAWING NO.
A35



SCALE: AS SHOWN
DATE: JULY 1, 1993
PROJECT NO. 93001
DESIGN DRAWN CHFD.

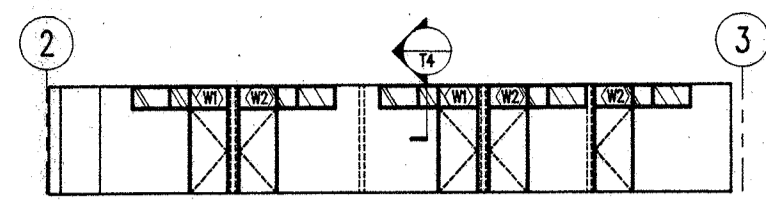



INTERIOR ELEVATION
SCALE: 1/8" = 1'-0"
2
T-2

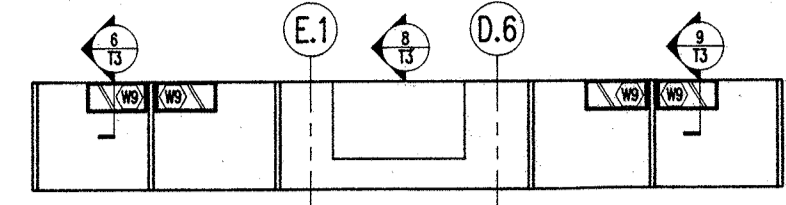


INTERIOR ELEVATION
SCALE: 1/8" = 1'-0"
4
T-2

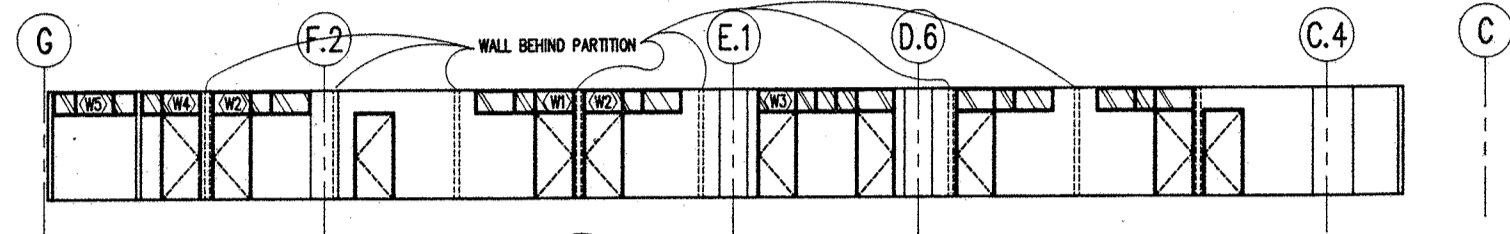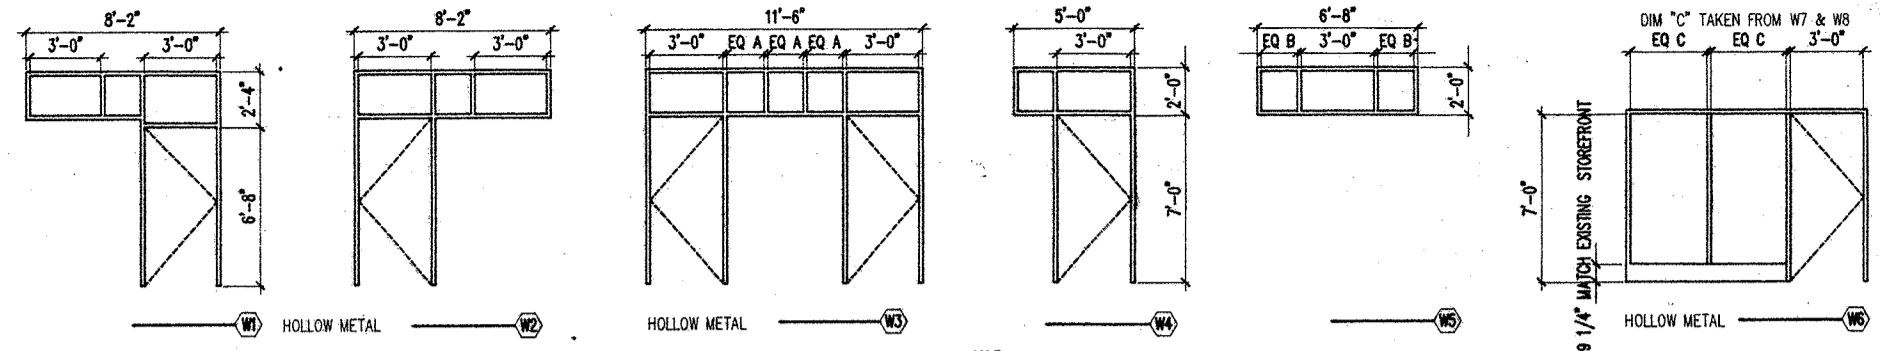


INTERIOR ELEVATION
SCALE: 1/8" = 1'-0"
3
T-2

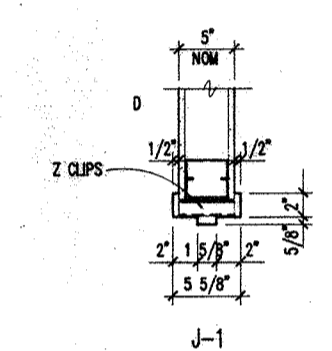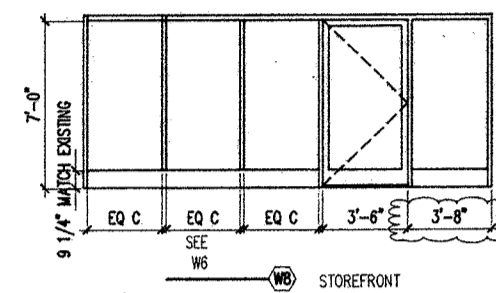


JAMB TYPES
SCALE: 1/2" = 1'-0"

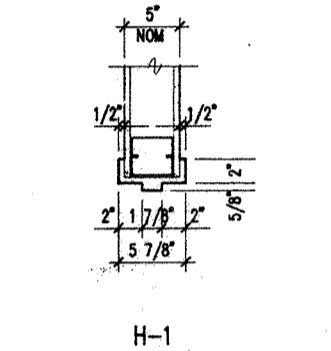




HEAD TYPES
SCALE: 1/2" = 1'-0"

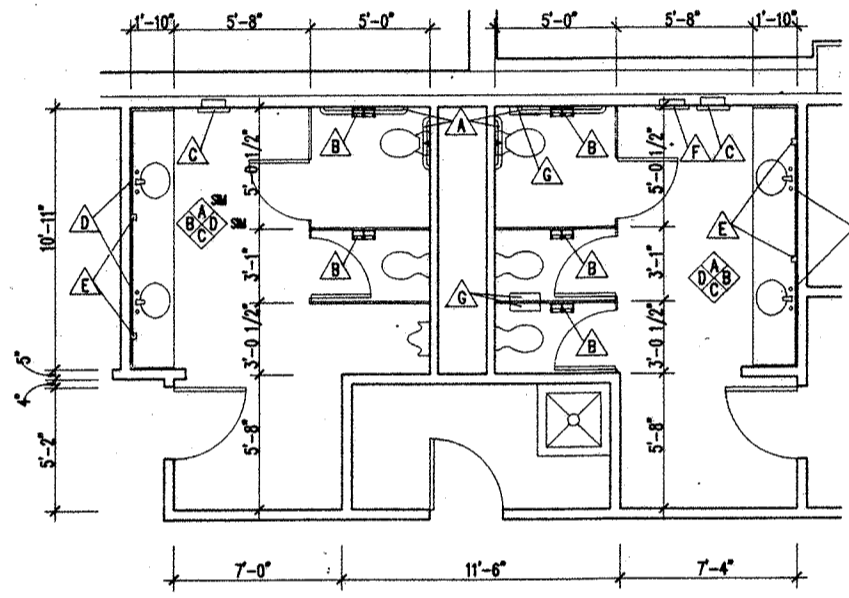


BATH ROOMS
SCALE: 1/4" = 1'-0"
6
T-2

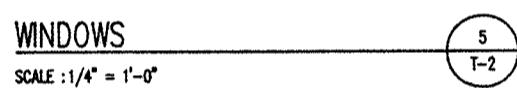




WINDOWS
SCALE: 1/4" = 1'-0"
5
T-2

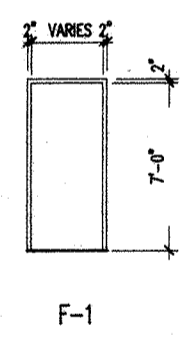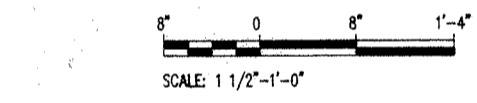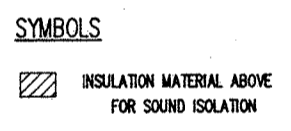


FRAME TYPES
SCALE: 1/4" = 1'-0"

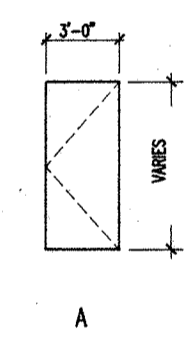


DOOR TYPES
SCALE: 1/4" = 1'-0"

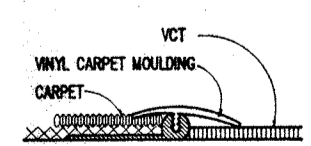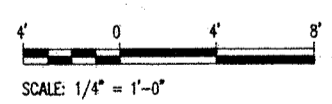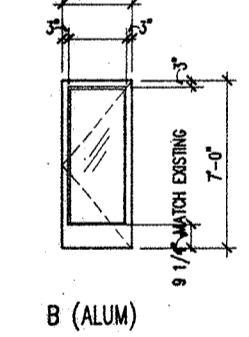

THRESHOLDS/ TRANSITION STEPS
SCALE: 1" = 1'
1
NOTE: USE TRANSITION 'C' AT ALL CARPET/VCT TRANSITIONS

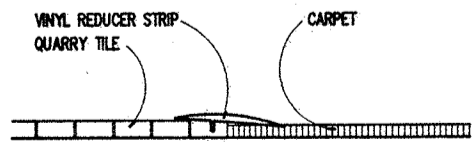


THRESHOLDS/ TRANSITION STEPS
SCALE: FULL SCALE
2

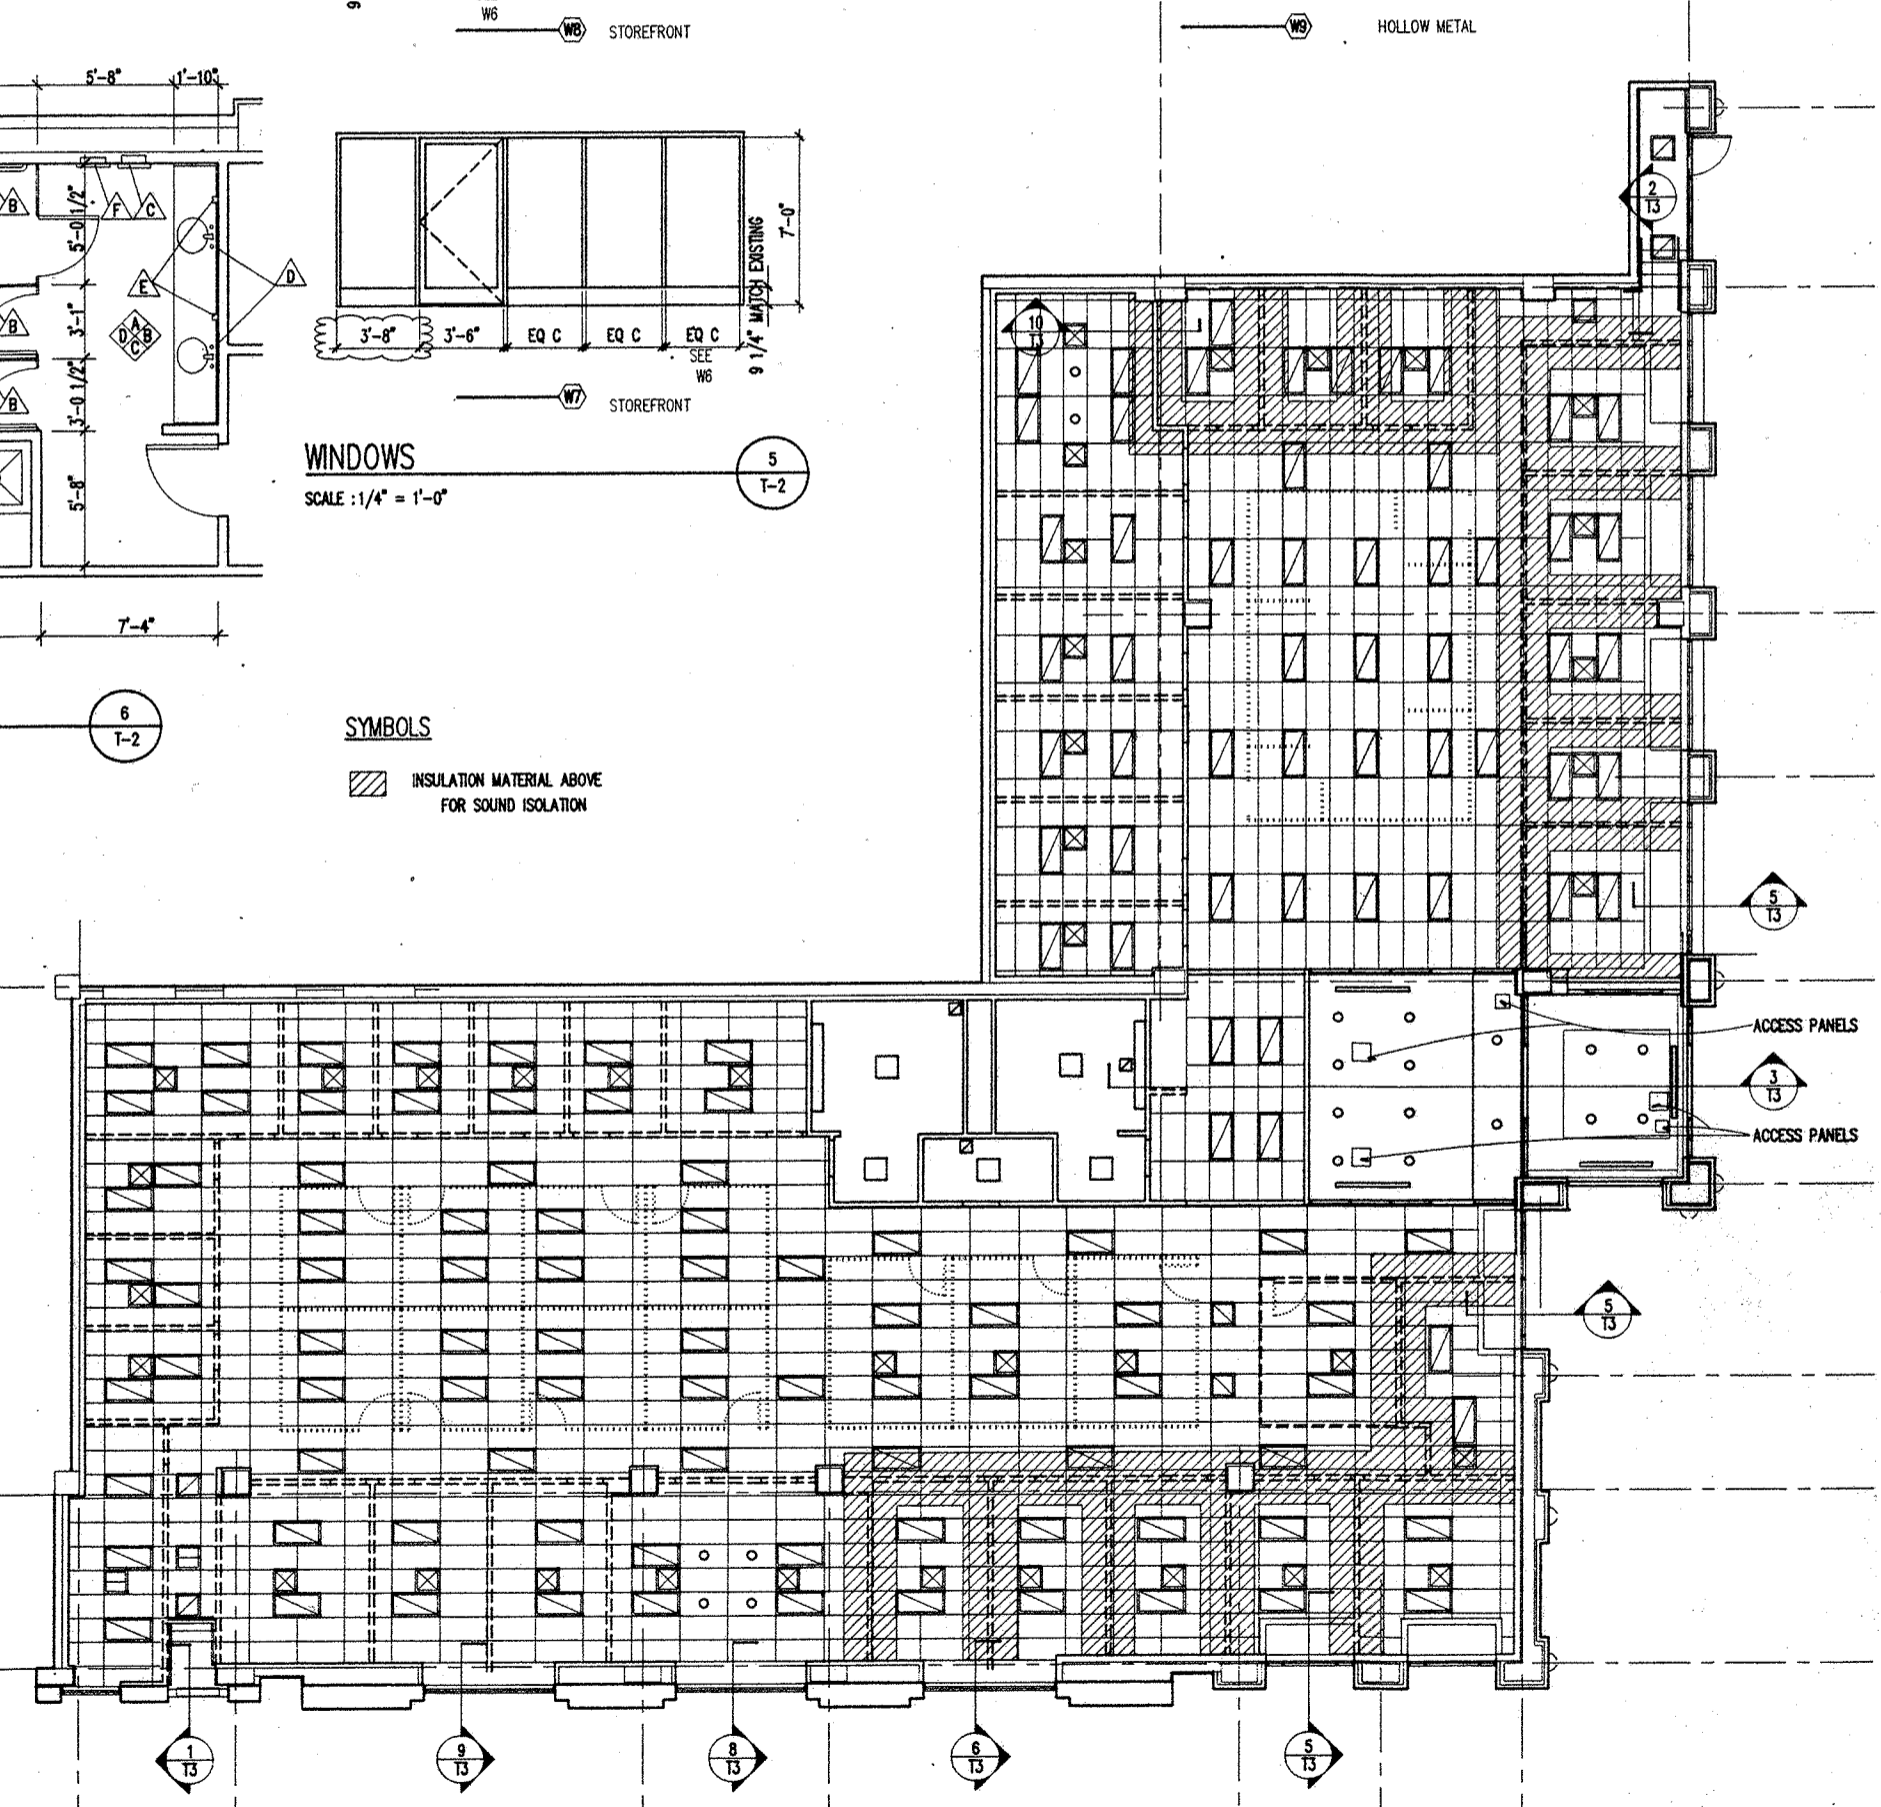

REFLECTED CEILING PLAN
SCALE: 1/8" = 1'-0"
1
T-2

PENN STREET

PRATT STREET

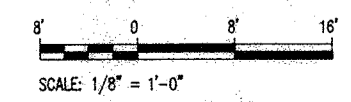

WHITING-TURNER
CONTRACTING COMPANY
DESMAN BWJ INC.
ASSOCIATES ARCHITECTS
BURDETTE KOBILER MURPHY
& ASSOCIATES, INC. M.E.P. ENGINEERS

BWJ
Inc. ARCHITECTS
3701 MARYLAND DRIVE, BALTIMORE, MD 21208
(410) 552-1000 FAX (410) 552-5288

PENN STREET PARKING FACILITY
UNIVERSITY OF MARYLAND AT BALTIMORE







NO. DATE BY
REVISIONS
OFFICE REFLECTED CEILING PLAN

DRAWING NO.
T-2

SCALE: 1/8" = 1'-0"
DATE: 04/21/84
PROJECT NO. 94016
DESIGN DRAWN CHKD.








25-APR-94 1"=8'
94024T-2

NO.	DATE	BY
REVISIONS		
TENANT SECTIONS & DETAILS		
DRAWING NO. T-3		
SCALE: 1/2" = 1'-0"		
DATE: 04/21/94		
PROJECT NO. 940241		
DESIGN	DRAWN	CHECKED

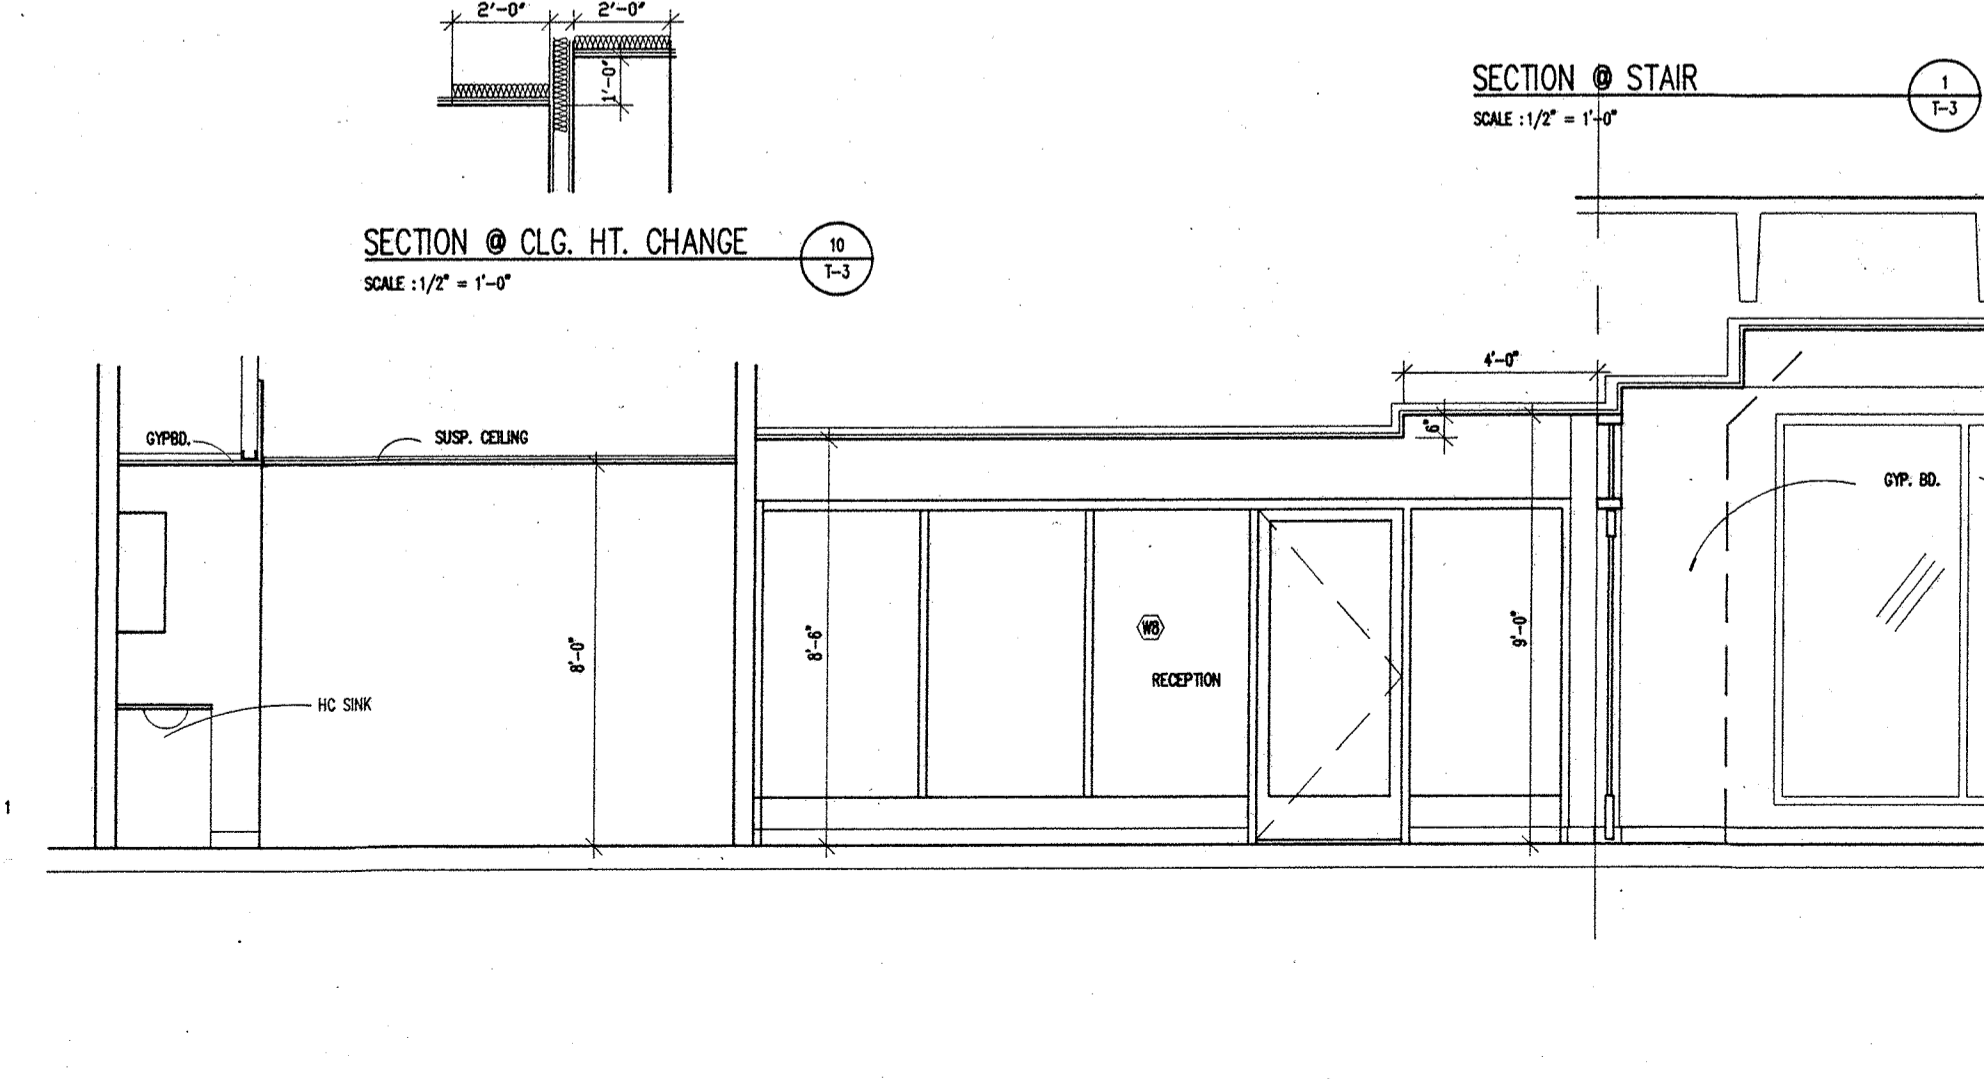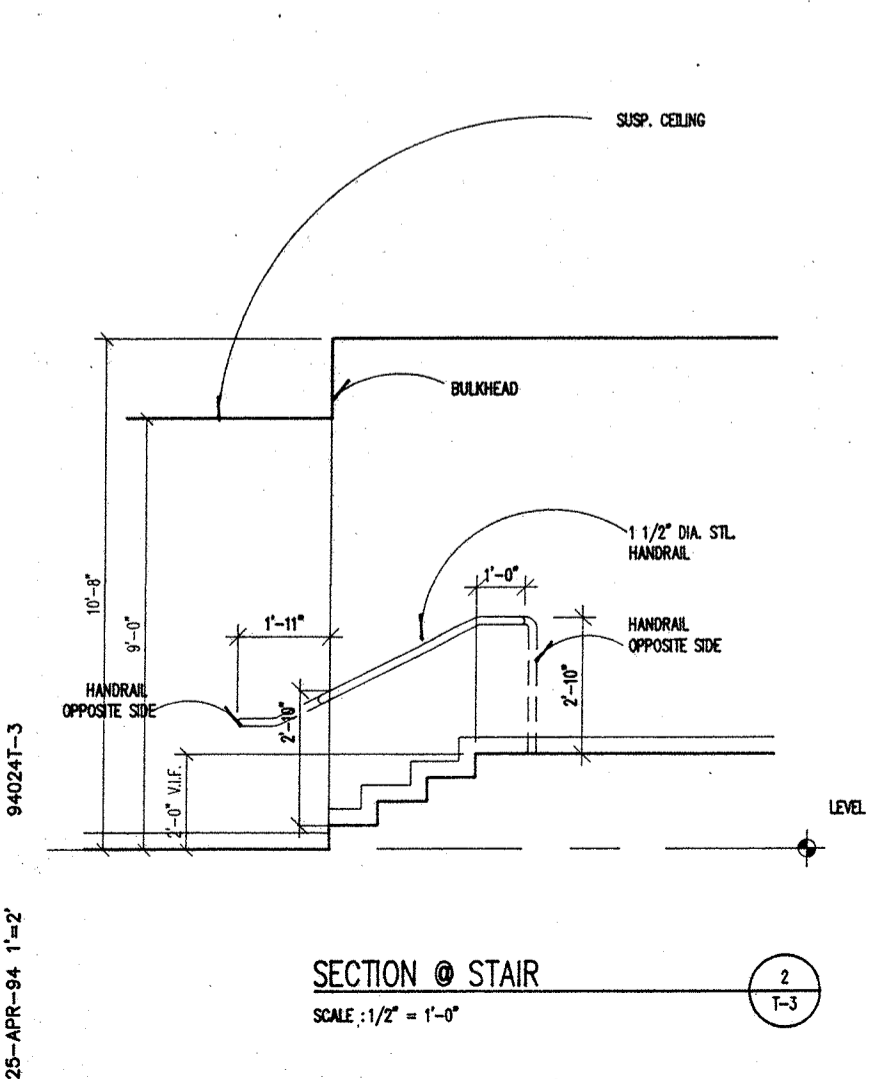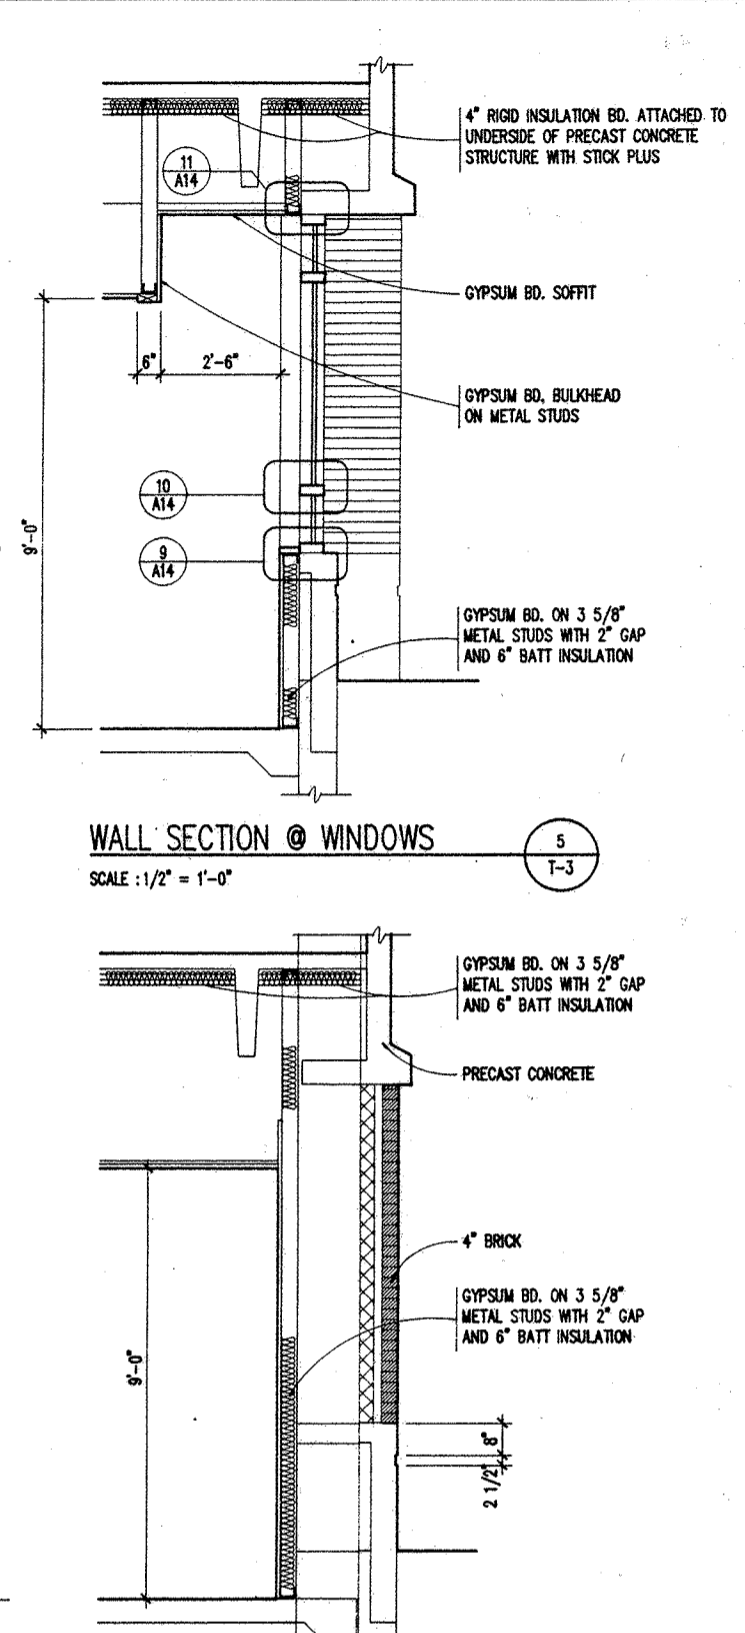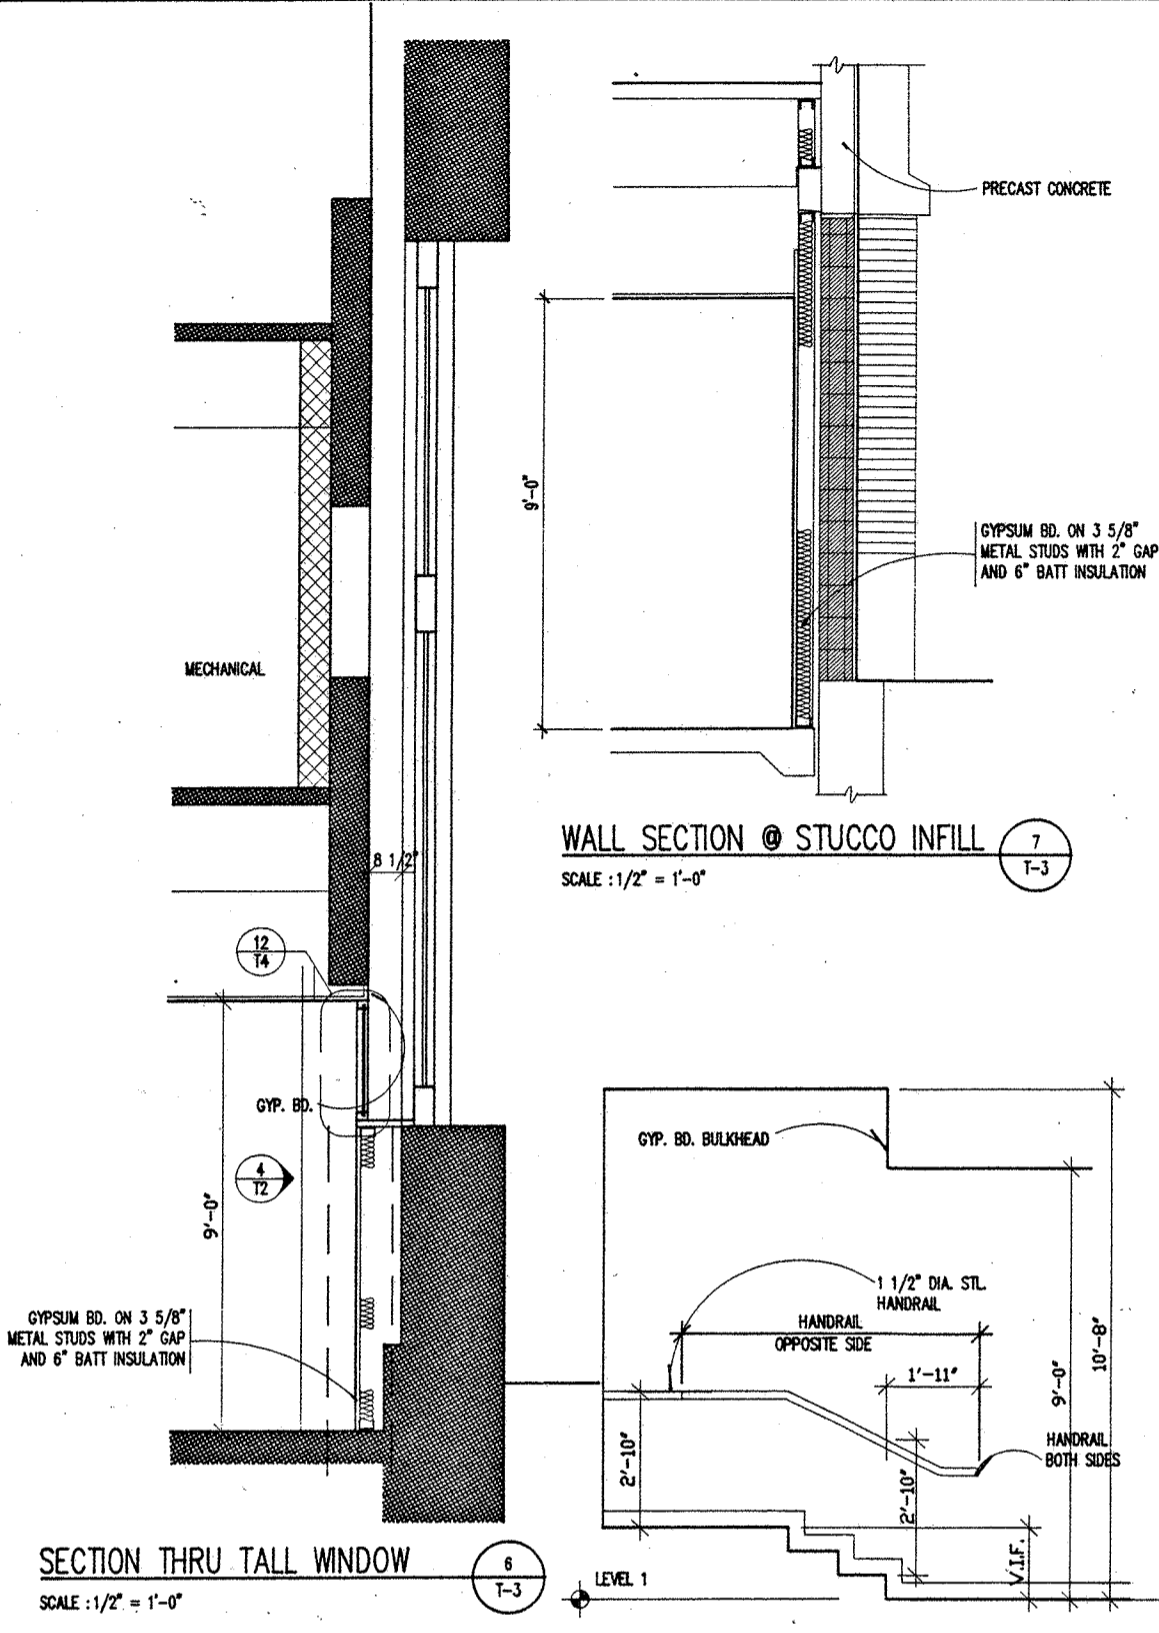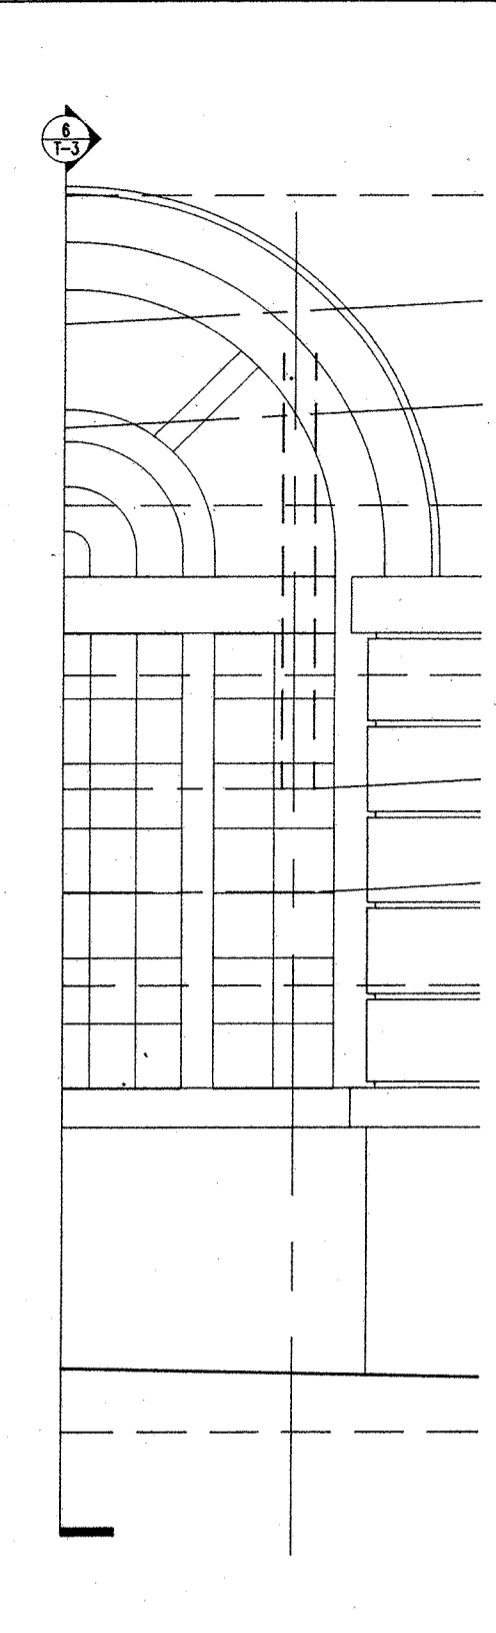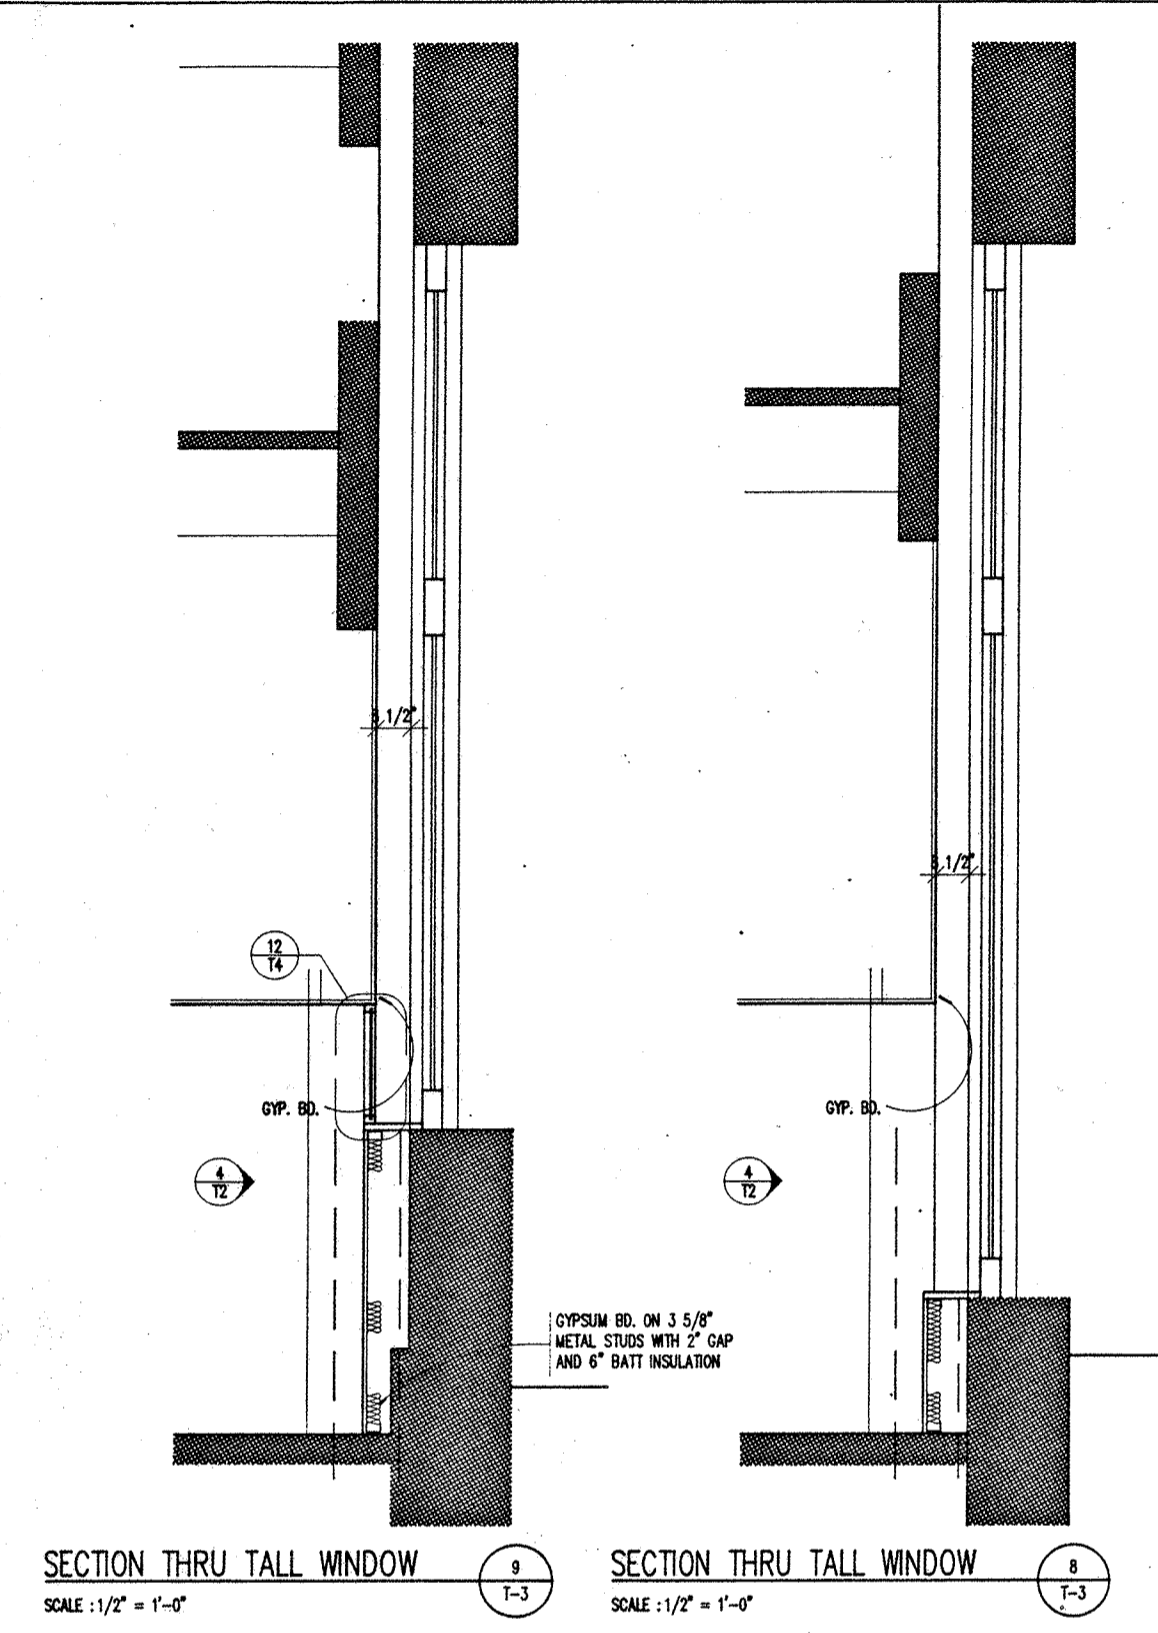

25-APR-94 1'-2"




940241-3

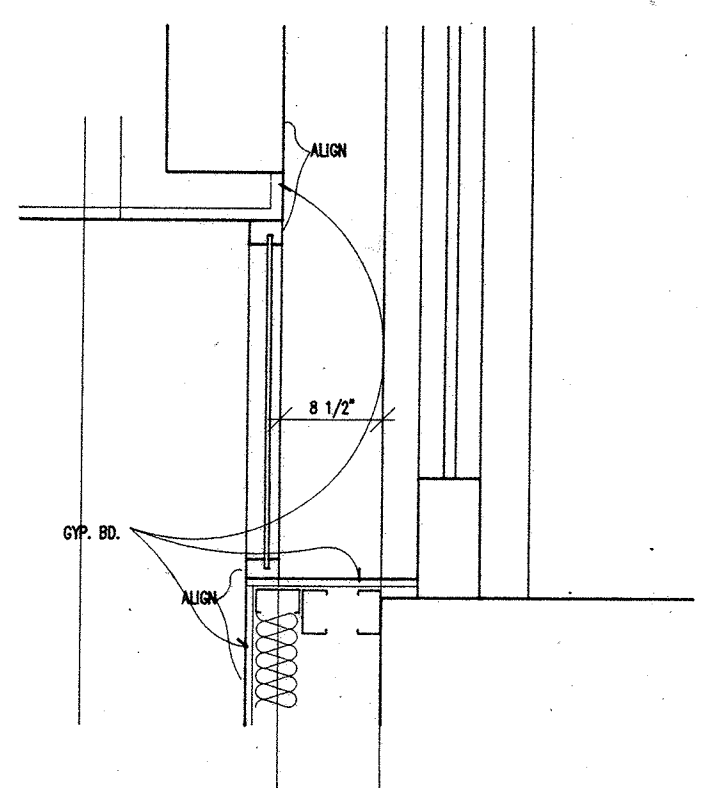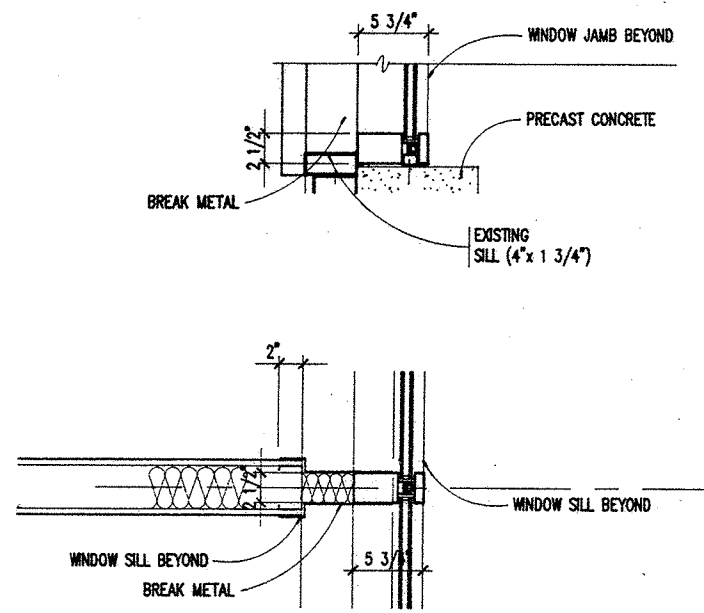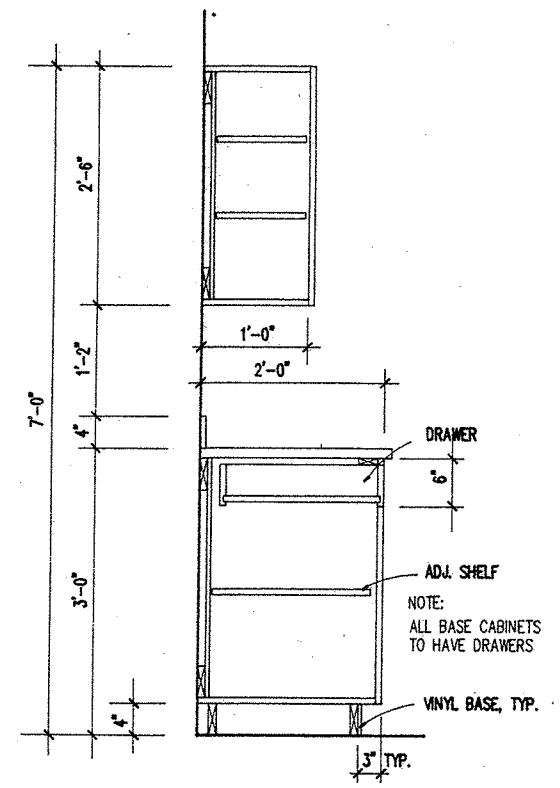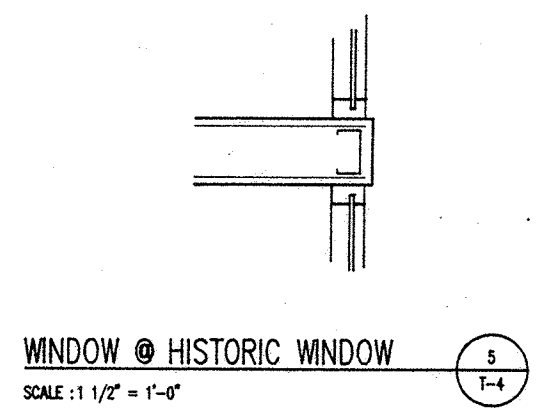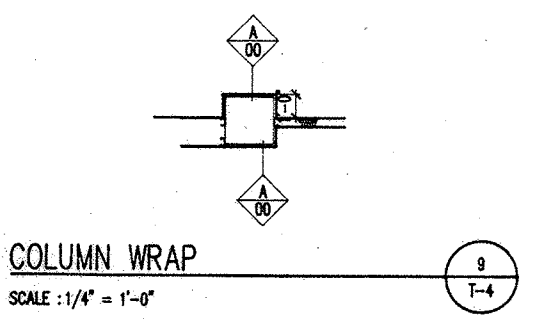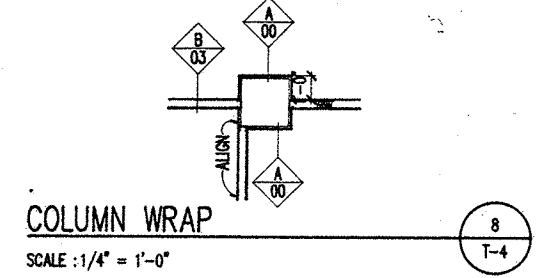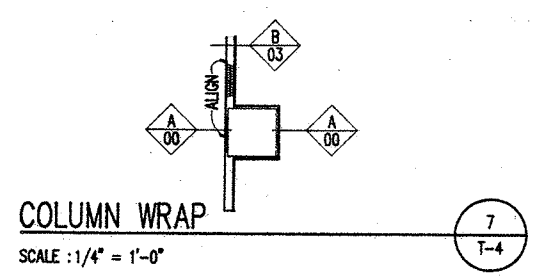

CABINET SECTION
SCALE: 1" = 1'-0"

WALL @ MULLION
SCALE: 1 1/2" = 1'-0"






WINDOW @ HISTORIC WINDOW
SCALE: 1 1/2" = 1'-0"

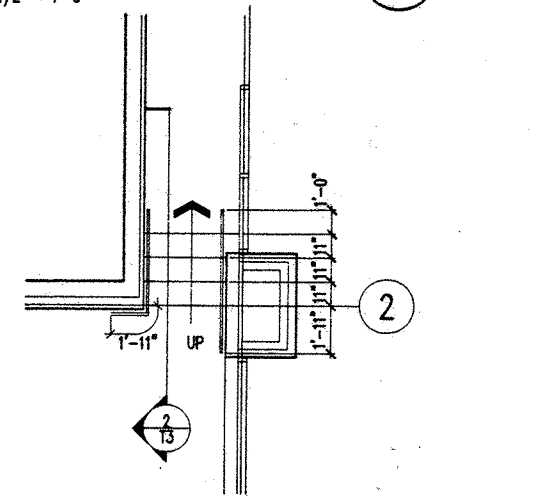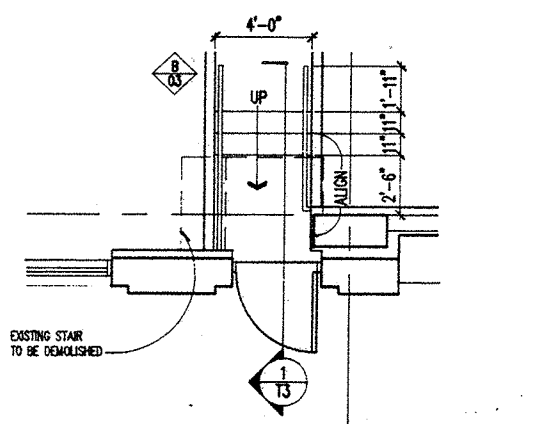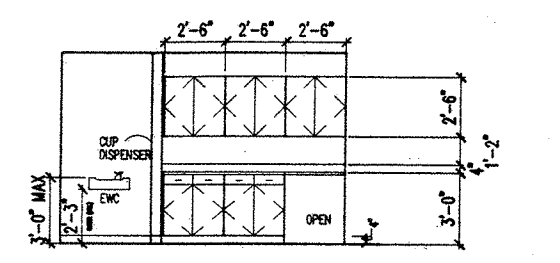

KITCHEN ELEVATION
SCALE: 1/4" = 1'-0"

STAIR
SCALE: 1/4" = 1'-0"

STAIR
SCALE: 1/4" = 1'-0"

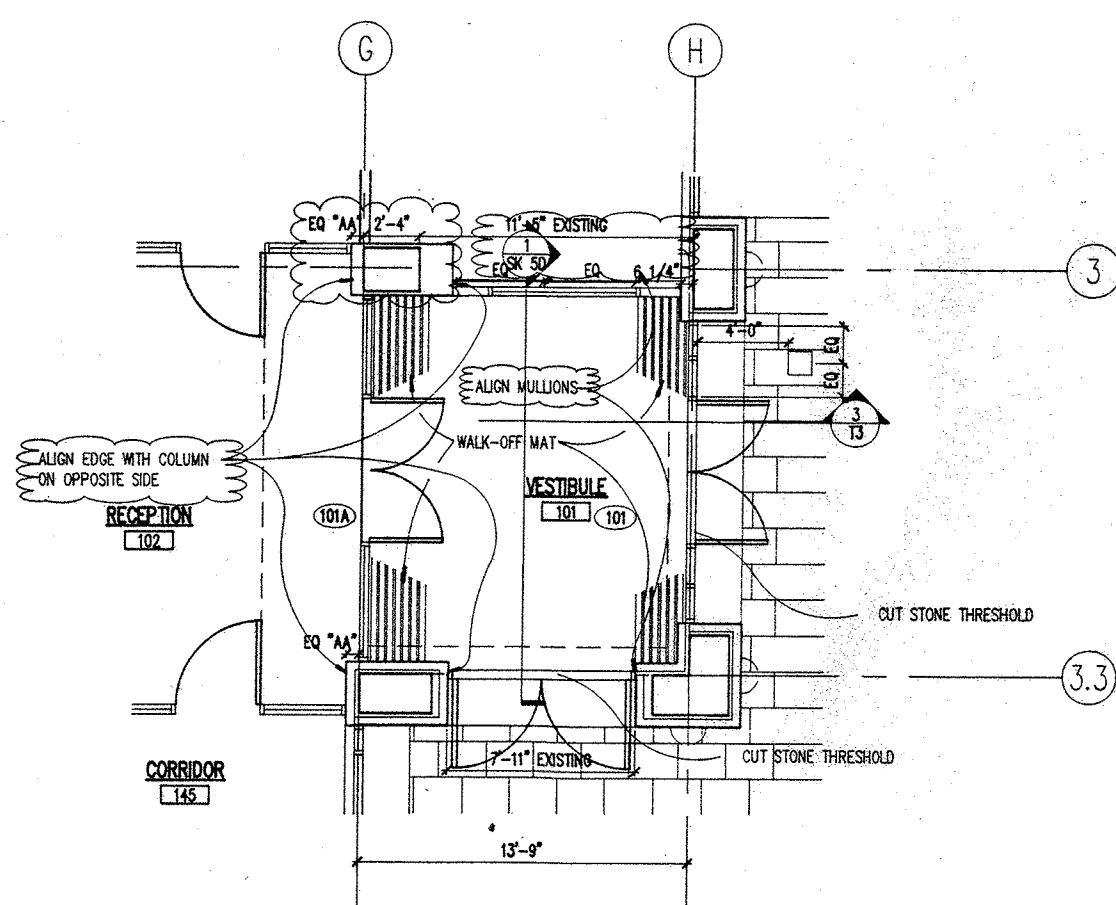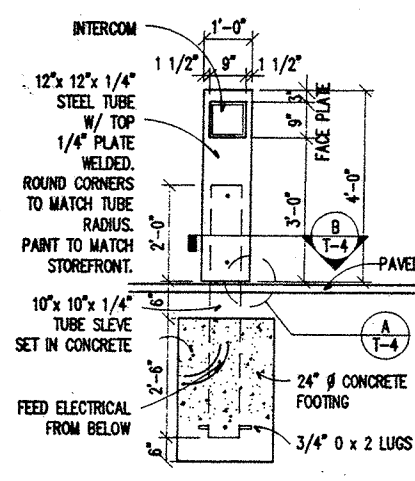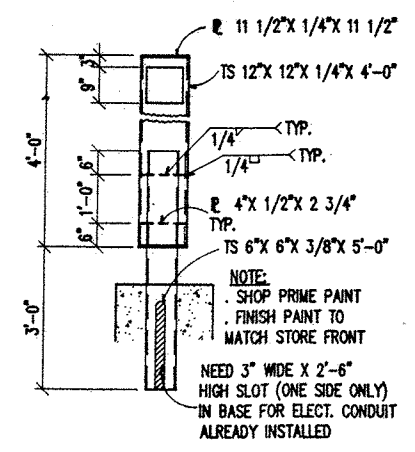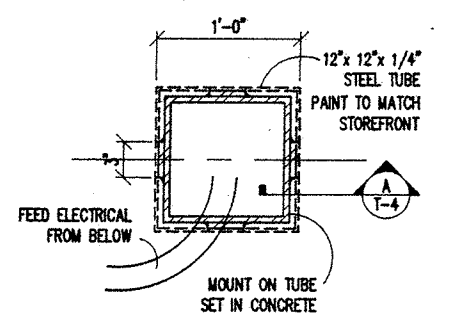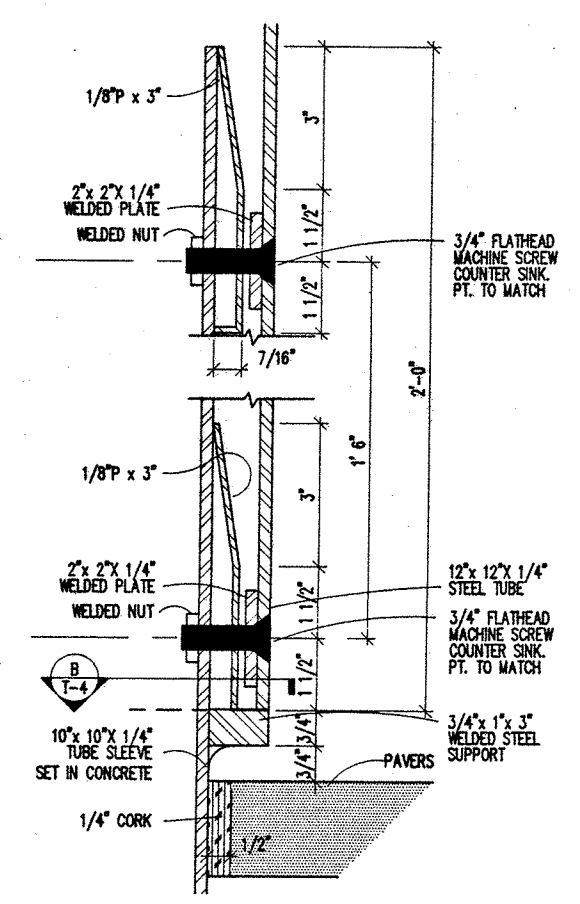

INTERCOM PEDISTAL BASE SEC.
SCALE: 6" = 1'-0"

INTERCOM PEDISTAL BASE PLAN
SCALE: 1 1/2" = 1'-0"

INTERCOM PEDISTAL
SCALE: 1/2" = 1'-0"

VESTIBULE
SCALE: 1/4" = 1'-0"




















NO.	DATE	BY
REVISIONS		
TENANT PLAN & MISC. DETAILS		
DRAWING NO. T-4		
SCALE: 1/4" = 1'-0"		
DATE: 04/21/94		
PROJECT NO. 94016		
DESIGN DRAWN CHK'D.		

25-APR-94 1'-4" 94024T-4

GENERAL STRUCTURAL NOTES

WHITING-TURNER
CONTRACTING COMPANY
DESIGN ASSOCIATES
ARCHITECTS ENGINEERS

PENN STREET PARKING FACILITY
UNIVERSITY OF MARYLAND AT BALTIMORE

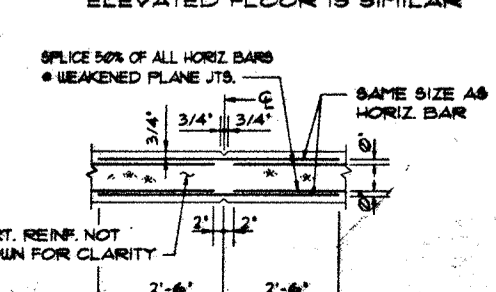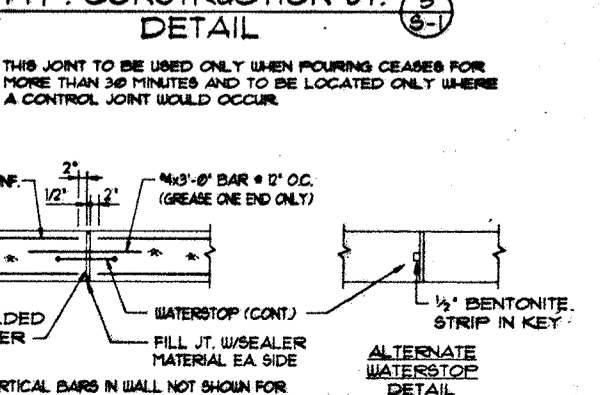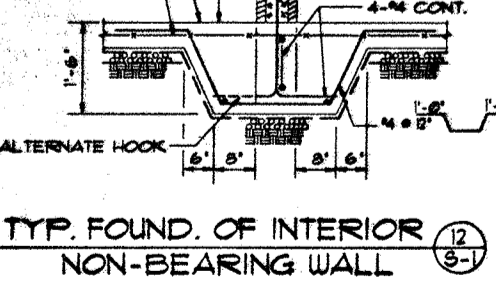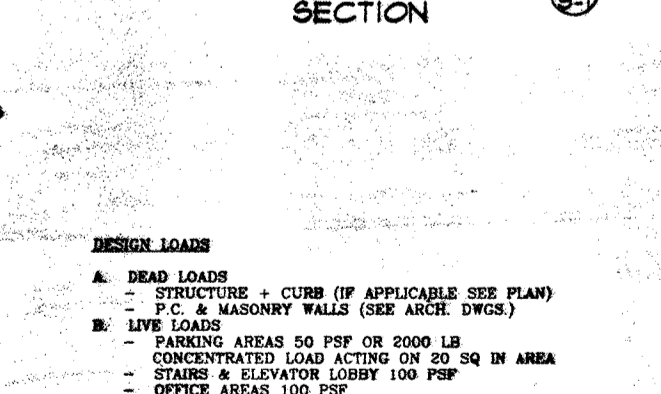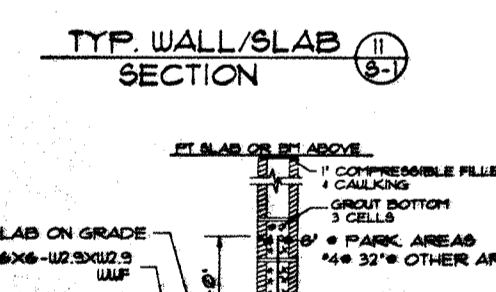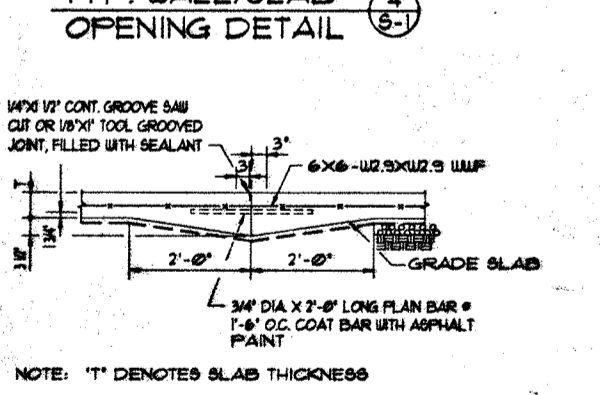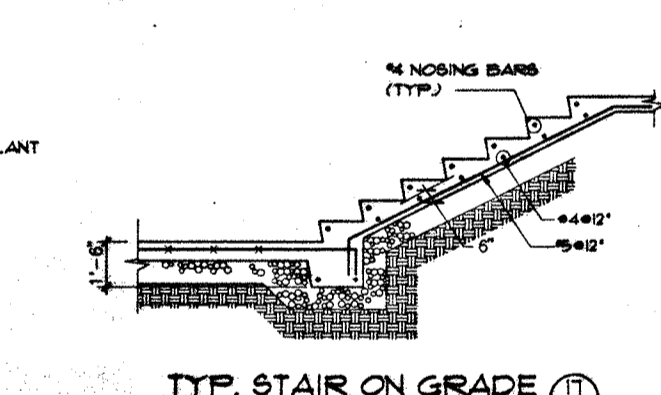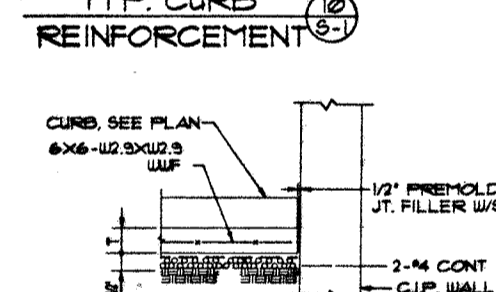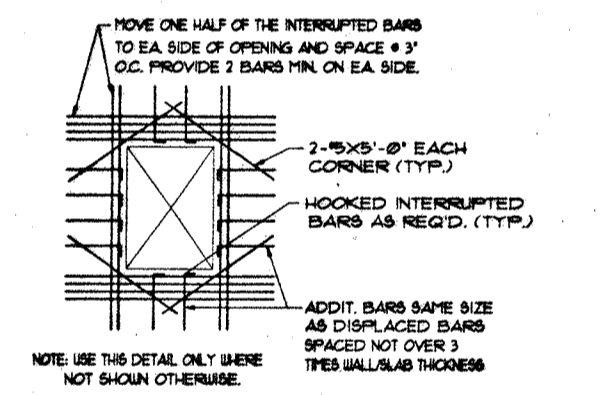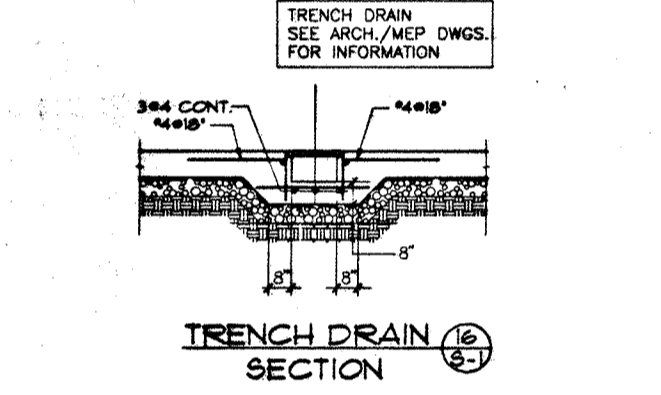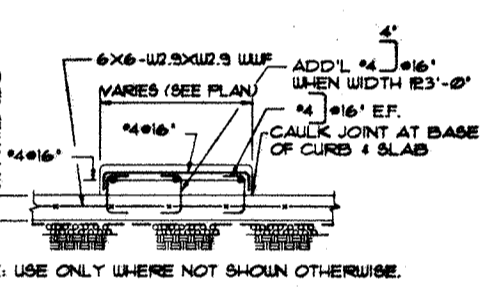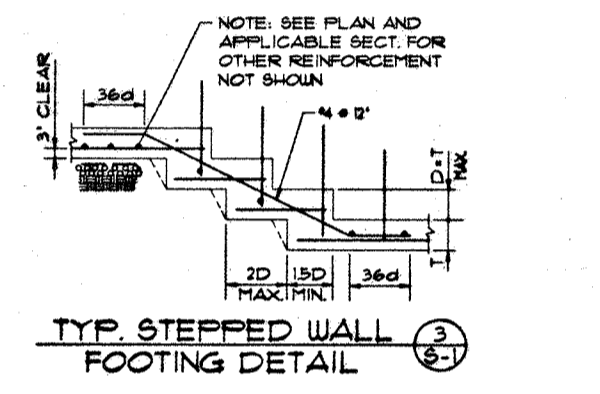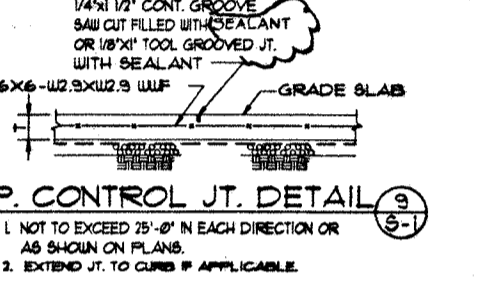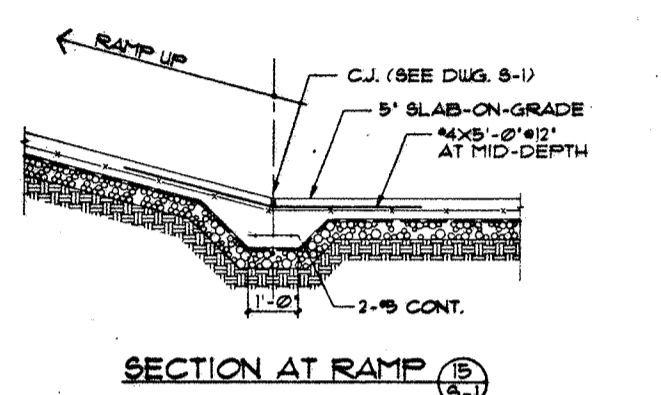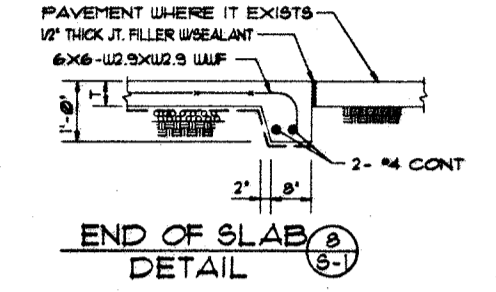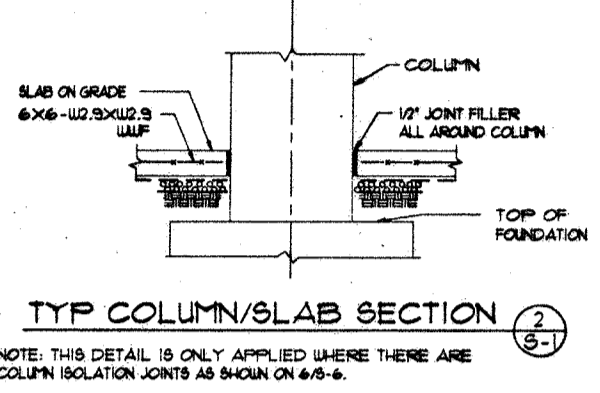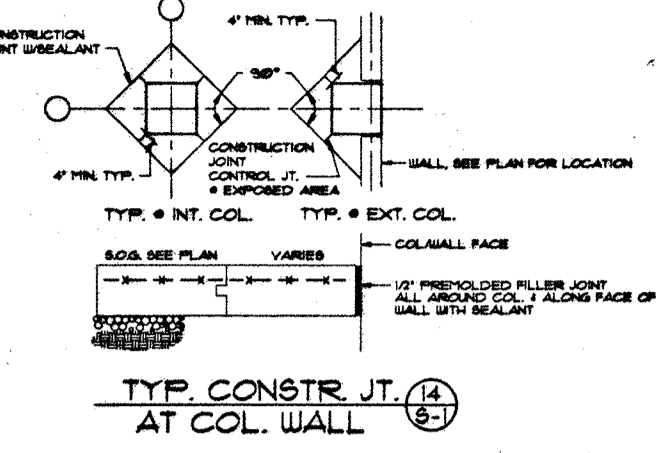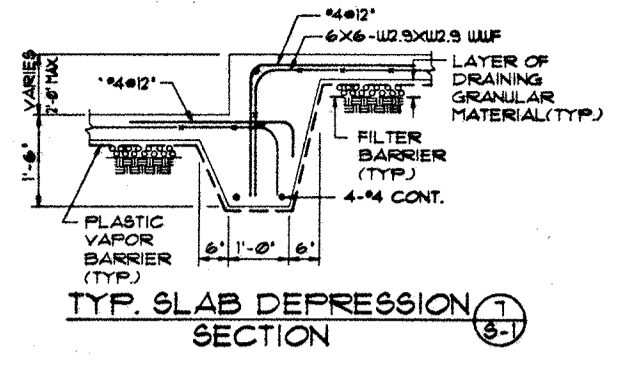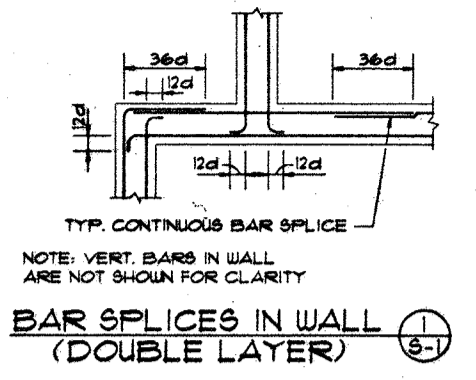

A. GENERAL NOTES

- The following notes shall apply unless otherwise shown or noted on the plans.
- All design and construction shall be in accordance with:
 - ACI-318-89 Code
 - BOCA-1990 as amended
 - AISC (9th Edition)
 - The Contractor shall verify all dimensions in the field prior to commencing work. The Architect shall be notified of any discrepancies which may exist.
 - All inspection shall be made as specified below:
 - All concrete having a strength in excess of 3000 psi.
 - All prestressing.
 - All welding.
 - All masonry.
 - All material tests shall be made as specified. Concrete test cylinders shall be made for all concrete. Test results shall be submitted to the Owner and Architect. Tests shall be made by an approved laboratory.
 - See Drawings for elevations (Minimum head clearance between girders and finished floor shall be 7'-6").
 - Shop drawings for plumbing shall be provided before construction of concrete frame so that location of sleeves can be determined.
 - Forms for slab soffits shall be tight and leakproof. Contractor shall take special precautions at construction joints where camber due to prestressing may take place.
 - All details, sections and notes shown on drawings are intended to be typical and shall apply to similar situations elsewhere, unless otherwise shown.
 - Contractor to supply all chairs, support bars and accessories to insure proper placement of all reinforcing bars, mesh and/or cable.
 - The contractor shall notify A/E of any conflicts between contract drawing and specifications and request for direction in writing prior to fabrication and construction.

B. MATERIALS

- Concrete strengths shall be as follows:
 - Footings and Caissons: Stone aggregate $f'_c = 4000$ psi @ 28 days.
 - Foundation walls, sidewalks and concrete not specified: $f'_c = 4000$ psi @ 28 days.
 - Traffic bearing slab-on-grade: Stone aggregate microsilica $f'_c = 5000$ psi @ 28 days w/fiber mesh and epoxy coated W.W.F.
 - Curb: Stone aggregate microsilica $f'_c = 4000$ psi @ 28 days w/fiber mesh and epoxy coated reinforcement.
 - Precast walls, pavement stairs, precast and beams: Stone aggregate $f'_c = 5000$ psi @ 28 days. Add microsilica as specified.
 - Precast prestressed double tees: $f'_c = 5000$ psi @ 28 days.
 - Cast-in-place topping and pour strips: Stone aggregate with microsilica $f'_c = 5000$ psi @ 28 days.
 - Precast Columns: Stone aggregate with microsilica $f'_c = 5000$ psi @ 28 days.
- Concrete mix designs shall be made by an approved laboratory for all concrete and shall be submitted to the Architect and Engineer for approval before use. Maximum water/cement ratio = 0.37 for 5000 psi concrete and 0.45 for 4000 psi concrete.
- Fine and coarse aggregates shall be stone aggregates conforming to ASTM C33-86.
- Cement shall be Portland Type 1 conforming to ASTM C150-89.
- All exposed concrete shall be air entrained. (6% ± 1%)
- All reinforcing steel shall conform to ASTM A615-89 (60,000 psi yield) and shall be used throughout the job with the exception of steel used in welded connections which shall be ASTM-A706-84. Welded wire shall conform to ASTM A185-88. All reinforcing and W.W.F. epoxy coated.
- 7-wire strand for prestressing shall conform to ASTM A418. Minimum ultimate tensile strength shall be 270,000 psi. Wire shall be stress relieved, clean and free from corrosion.
- 1/4" diameter wires for prestressing shall conform to ASTM A421. Minimum ultimate tensile strength shall be 240,000 psi. Wire shall be stress relieved clean and free from corrosion.
- Fiber mesh shall be 100% virgin polypropylene fibrillated fibers.

C. STEEL

- Structural steel shall conform to ASTM-A36. Pipe to conform to ASTM-A53, Grade A or B. Light gauge structural steel shall conform to either ASTM-A245 or ASTM-A303.
- Welding of structural steel (ASTM-A36) shall be with E70XX electrode.
- All welding of reinforcing shall be done with E90XX electrodes in accordance with A.W.S. Specifications D1.4-78.

D. REINFORCED CONCRETE NOTES

- Concrete shall not be dropped through reinforcing steel, (as in walls) so as to cause segregation of aggregates. In such cases, hopper or vertical chutes or trunks shall be used. Chutes or trunks shall be of variable lengths so that the free unconfined fall of concrete shall not exceed six (6) feet and a sufficient number shall be used to insure the concrete being kept level at all times.
- All dimensions shown for location of reinforcing are to the face of forms clear and denote clear coverage. For beams and tied columns, dimensions are to main bars. Unless specifically noted, concrete coverages to reinforcing steel (not prestressing steel) shall be as follows:
 - 3 inches where concrete is deposited directly against earth
 - 2 inches for main bars of tied columns.
 - 1-1/2 inches for wall bars unless otherwise shown; #6 or smaller.
 - 2 inches for wall bars #6 or larger.
 - 1-1/2 inches for bars in beams (1-1/2" bott. & 2-1/2" top)
 - 2 inches top steel for slabs.
- Splice in continuous reinforcement as in walls, wall footings, etc. shall meet the embedment and lap lengths required by ACI-318-89 Code and the splices in adjacent bars shall not be less than five (5) feet apart. Vertical wall bars shall be spliced at or near floor lines. Bars may be wired together at splices or laps except for top reinforcing of beams and slabs or where definitely detailed to be separated. See beam details or schedules for separation of beam or girder bars over supports. Continuous bars in spandrels, wall beams, etc. shall lap as follows: Top bars at center line span, bottom bars at center line supports.
- All walls shall be dowelled to footings, walls, beams or slabs with bars of the same size and spacing as the wall bars, except where specifically indicated otherwise, with 3# diameter embedment minimum.
- See Architectural and Mechanical drawings for size and location of wall and floor openings, wall offsets, provisions for future equipment, stair details, pipe, vent, duct and other openings and details not shown on Structural drawings. See Electrical drawings for attachment or mounting of light fixtures, light standards, and other supports and openings for electrical equipment.
- All reinforcing steel details shall be in accordance with the Manual of Standard Practice for Detailing Reinforcing Concrete Structures, ACI 315-80(88) and 315R-80(88).
- The precast concrete wall suppliers shall submit all design & fabrication details with calculations signed and sealed by a licensed professional engineer in the State of Maryland to the Architect for review.
- All exposed steel plates and angles for exterior wall connections shall be galvanized.
- Minimum lap splices for epoxy coated shall be 50 bar dia.

DESIGN LOADS


- DEAD LOADS
 - STRUCTURE + CURB (IF APPLICABLE SEE PLAN)
 - P.C. & MASONRY WALLS (SEE ARCH. DWGS.)
- LIVE LOADS
 - PARKING AREAS 50 PSF OR 2000 LB CONCENTRATED LOAD ACTING ON 20 SQ IN AREA
 - STAIRS & ELEVATOR LOBBY 100 PSF
 - OFFICE AREAS 100 PSF
 - STORAGE AREAS 120 PSF
 - MECHANICAL ROOMS 150 PSF
 - SNOW 20 PSF+DRIFTS
 - ROOF LEVEL FULL LIVE LOAD PLUS FULL SNOW LOAD
- LATERAL LOADS
 - WIND LOADS PER ASCE 7-88.90 MPH, EXPOSURE B
 - SEISMIC LOADS
 - EFFECTIVE PEAK VELOCITY-RELATED ACCELERATION < 0.05

NOTES:

- Precast spandrel walls shall be designed for a minimum horizontal impact load of 10,000 pounds applied at a height of 1'-6" above the floor at any point along the structure.
- Double-Tee flanges shall be designed for a minimum concentrated vertical load of 2,000 pounds acting on an area of 20 square inches.
- All calculations and drawings shall be stamped and signed by Professional Engineer registered in the state of Maryland.

NO.	DATE	BY
REVISIONS		
GENERAL NOTES & TYPICAL DETAILS		
DRAWING NO. S-1		
SCALE:	NOTE:	
DATE:		
PROJECT NO. 4-543		
DESIGN DRAWN	CHKD.	
A.P.		



SAIL CLOTH FACTORY

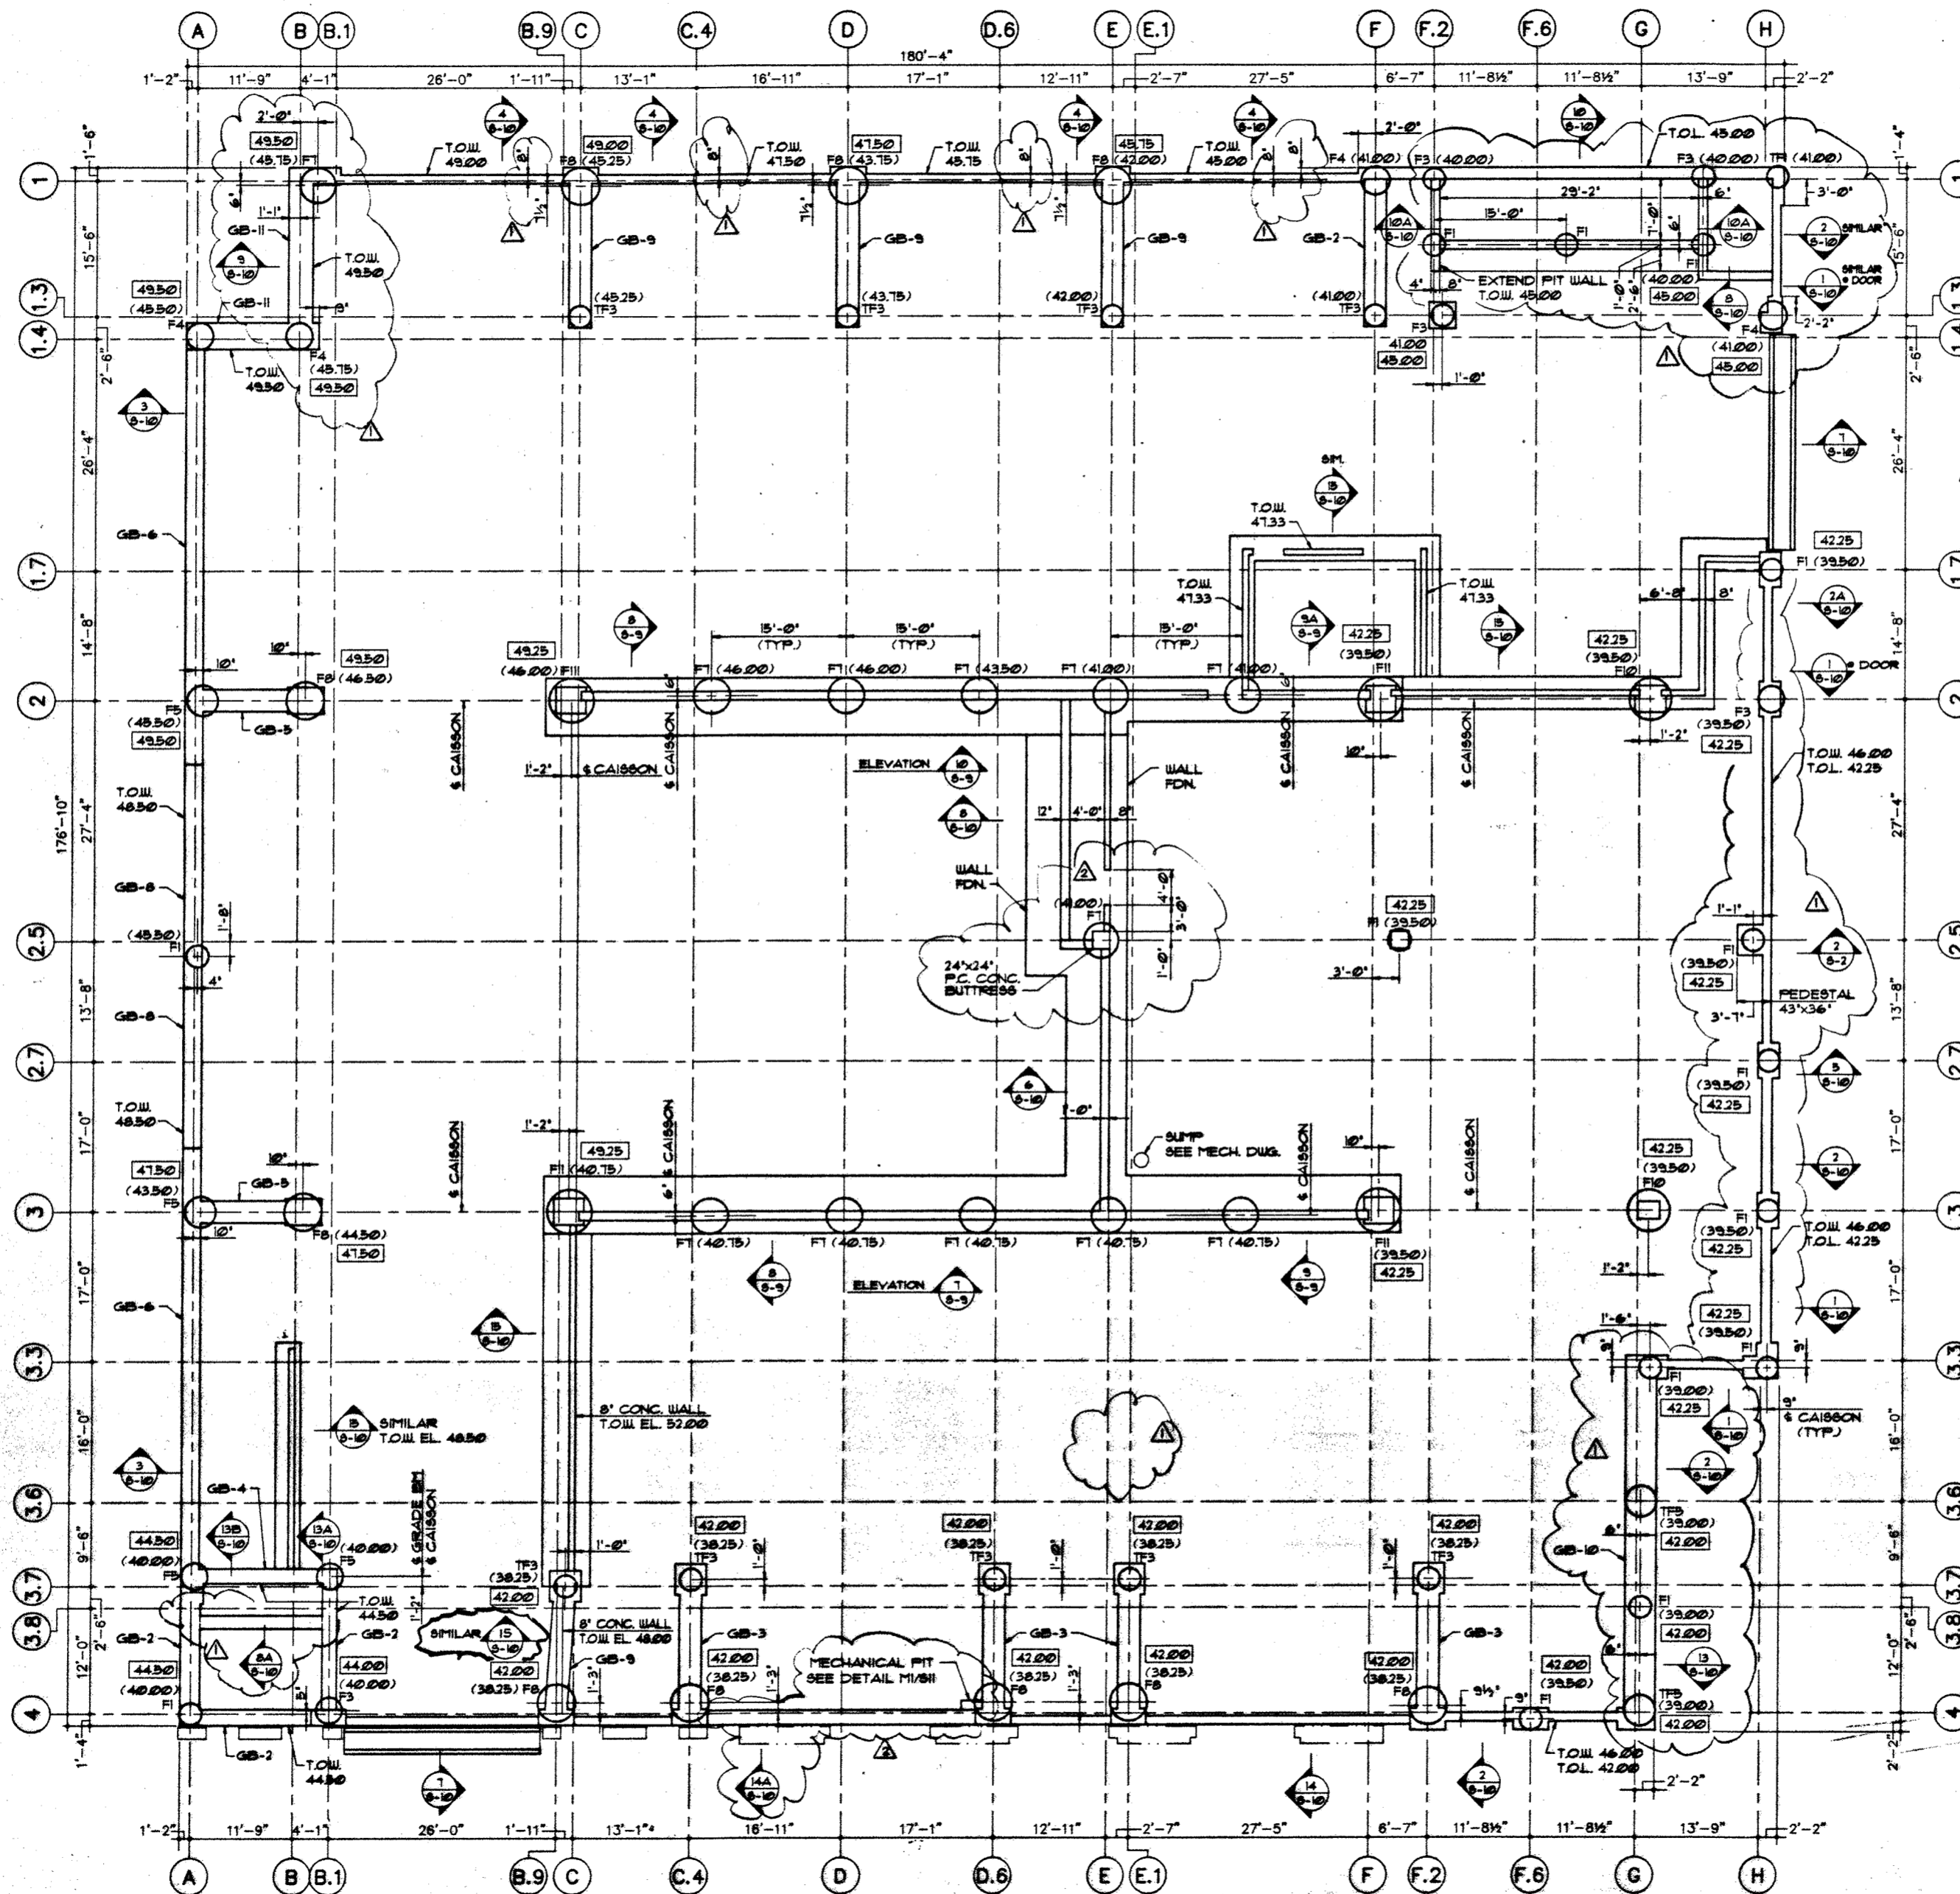

CAISSON SCHEDULE				
TYPE	DIAMETER	VERTICAL BARS SPACE UNIFORMLY	TIES	REMARKS
F1	30"	6#7	#3@14"	
F2	33"	7#8	#3@14"	
F3	36"	7#8	#3@16"	
F4	39"	7#9	#3@16"	
F5	42"	7#9	#3@18"	
F6	45"	7#10	#4@18"	
F7	48"	7#10	#4@18"	
F8	51"	9#10	#4@18"	
F9	54"	9#10	#4@18"	
F10	57"	9#11	#4@18"	
F11	60"	9#11	#4@18"	

GRADE BEAM SCHEDULE				
TYPE	W x D	TOP REINFORCEMENT	BOTTOM REINFORCEMENT	TIES
GB1	30 x 36	3-#8	3-#8	#4@12"
GB2	30 x 36	6-#10	6-#9	2-#4@12"
GB3	30 x 45	10-#11 (2 LAYERS)	6-#8	#4@18"
GB4	24 x 54	7-#9	11-#11 (2 LAYERS)	2-#5@8"
GB5	30 x 36	9-#10	5-#8	2-#4@12"
GB6	24 x 48	8-#9	8-#9	2-#4@18"
GB7	30 x 36	8-#11	8-#11	2-#4@12"
GB8	30 x 36	5-#8	5-#8	2-#4@12"
GB9	30 x 45	9-#10	6-#8	2-#4@18"
GB10	42 x 36	8-#10	8-#10	2-#5@12"
GB11	30 x 45	6-#9	6-#9	2-#4@18"

- NOTES:
- VERTICAL REINFORCEMENT IN CAISSONS WILL BE PROVIDED UP TO 3'-0" DEPTH OR 1/2" WHICH EVER IS MAXIMUM. 'D' = DIAMETER OF CAISSON.
 - CAISSON MARKED WITH 'T' - AS TENSION CAISSON. PROVIDE FULL DEPTH VERTICAL REINFORCEMENT IN THESE CAISSONS.
 - PROVIDE 4-#8 BAR DOUELS FROM CAISSON INTO GRADE BEAM OR RETAINING WALL AS THE CASE MAY BE.
 - TOP OF CAISSON SHOWN THUS (----) ON PLAN.
 - TOP OF CONCRETE PEDESTAL SHOWN THUS (---) ON PLAN.

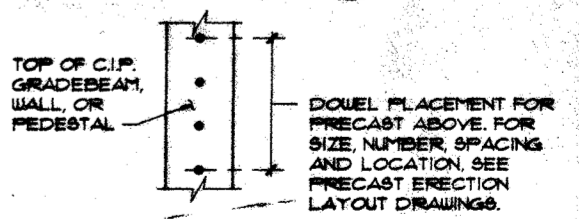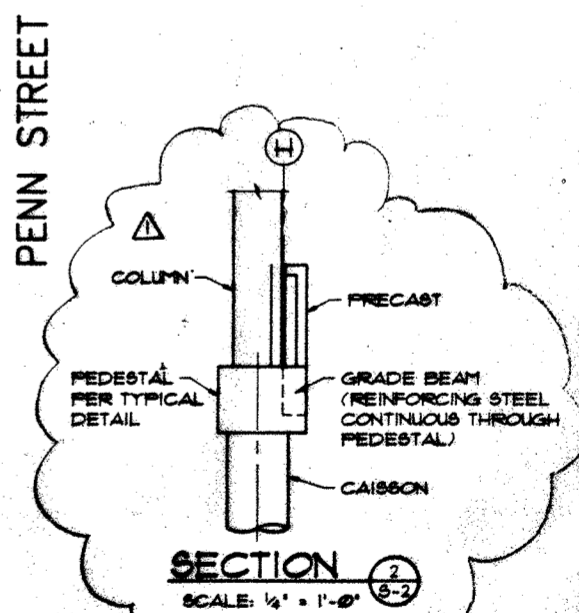

NOTE: TEMPLATE PLACEMENT REQUIRED. COORDINATE LOCATION WITH PRECASTER. MAXIMUM TOLERANCE SPECIFIED EQUALS (1/4")

TOP OF CAST-IN-PLACE CONCRETE PRECAST ANCHOR DETAIL (TYP.)

WHITING-TURNER
CONTRACTING COMPANY
DESIGN ASSOCIATES
ARCHITECTS ENGINEERS

PENN STREET PARKING FACILITY
UNIVERSITY OF MARYLAND AT BALTIMORE

NO.	DATE	BY

FOUNDATION PLAN



DRAWING NO. S-2

SCALE: 1/8" = 1'-0"
DATE: JUNE 1993
PROJECT NO. J-343
DESIGN DRAWN CHKD.

1 FOUNDATION PLAN
S-2

PRATT STREET

1
S-2

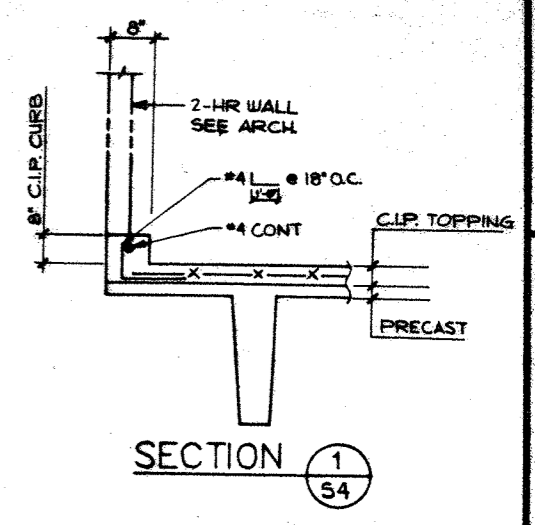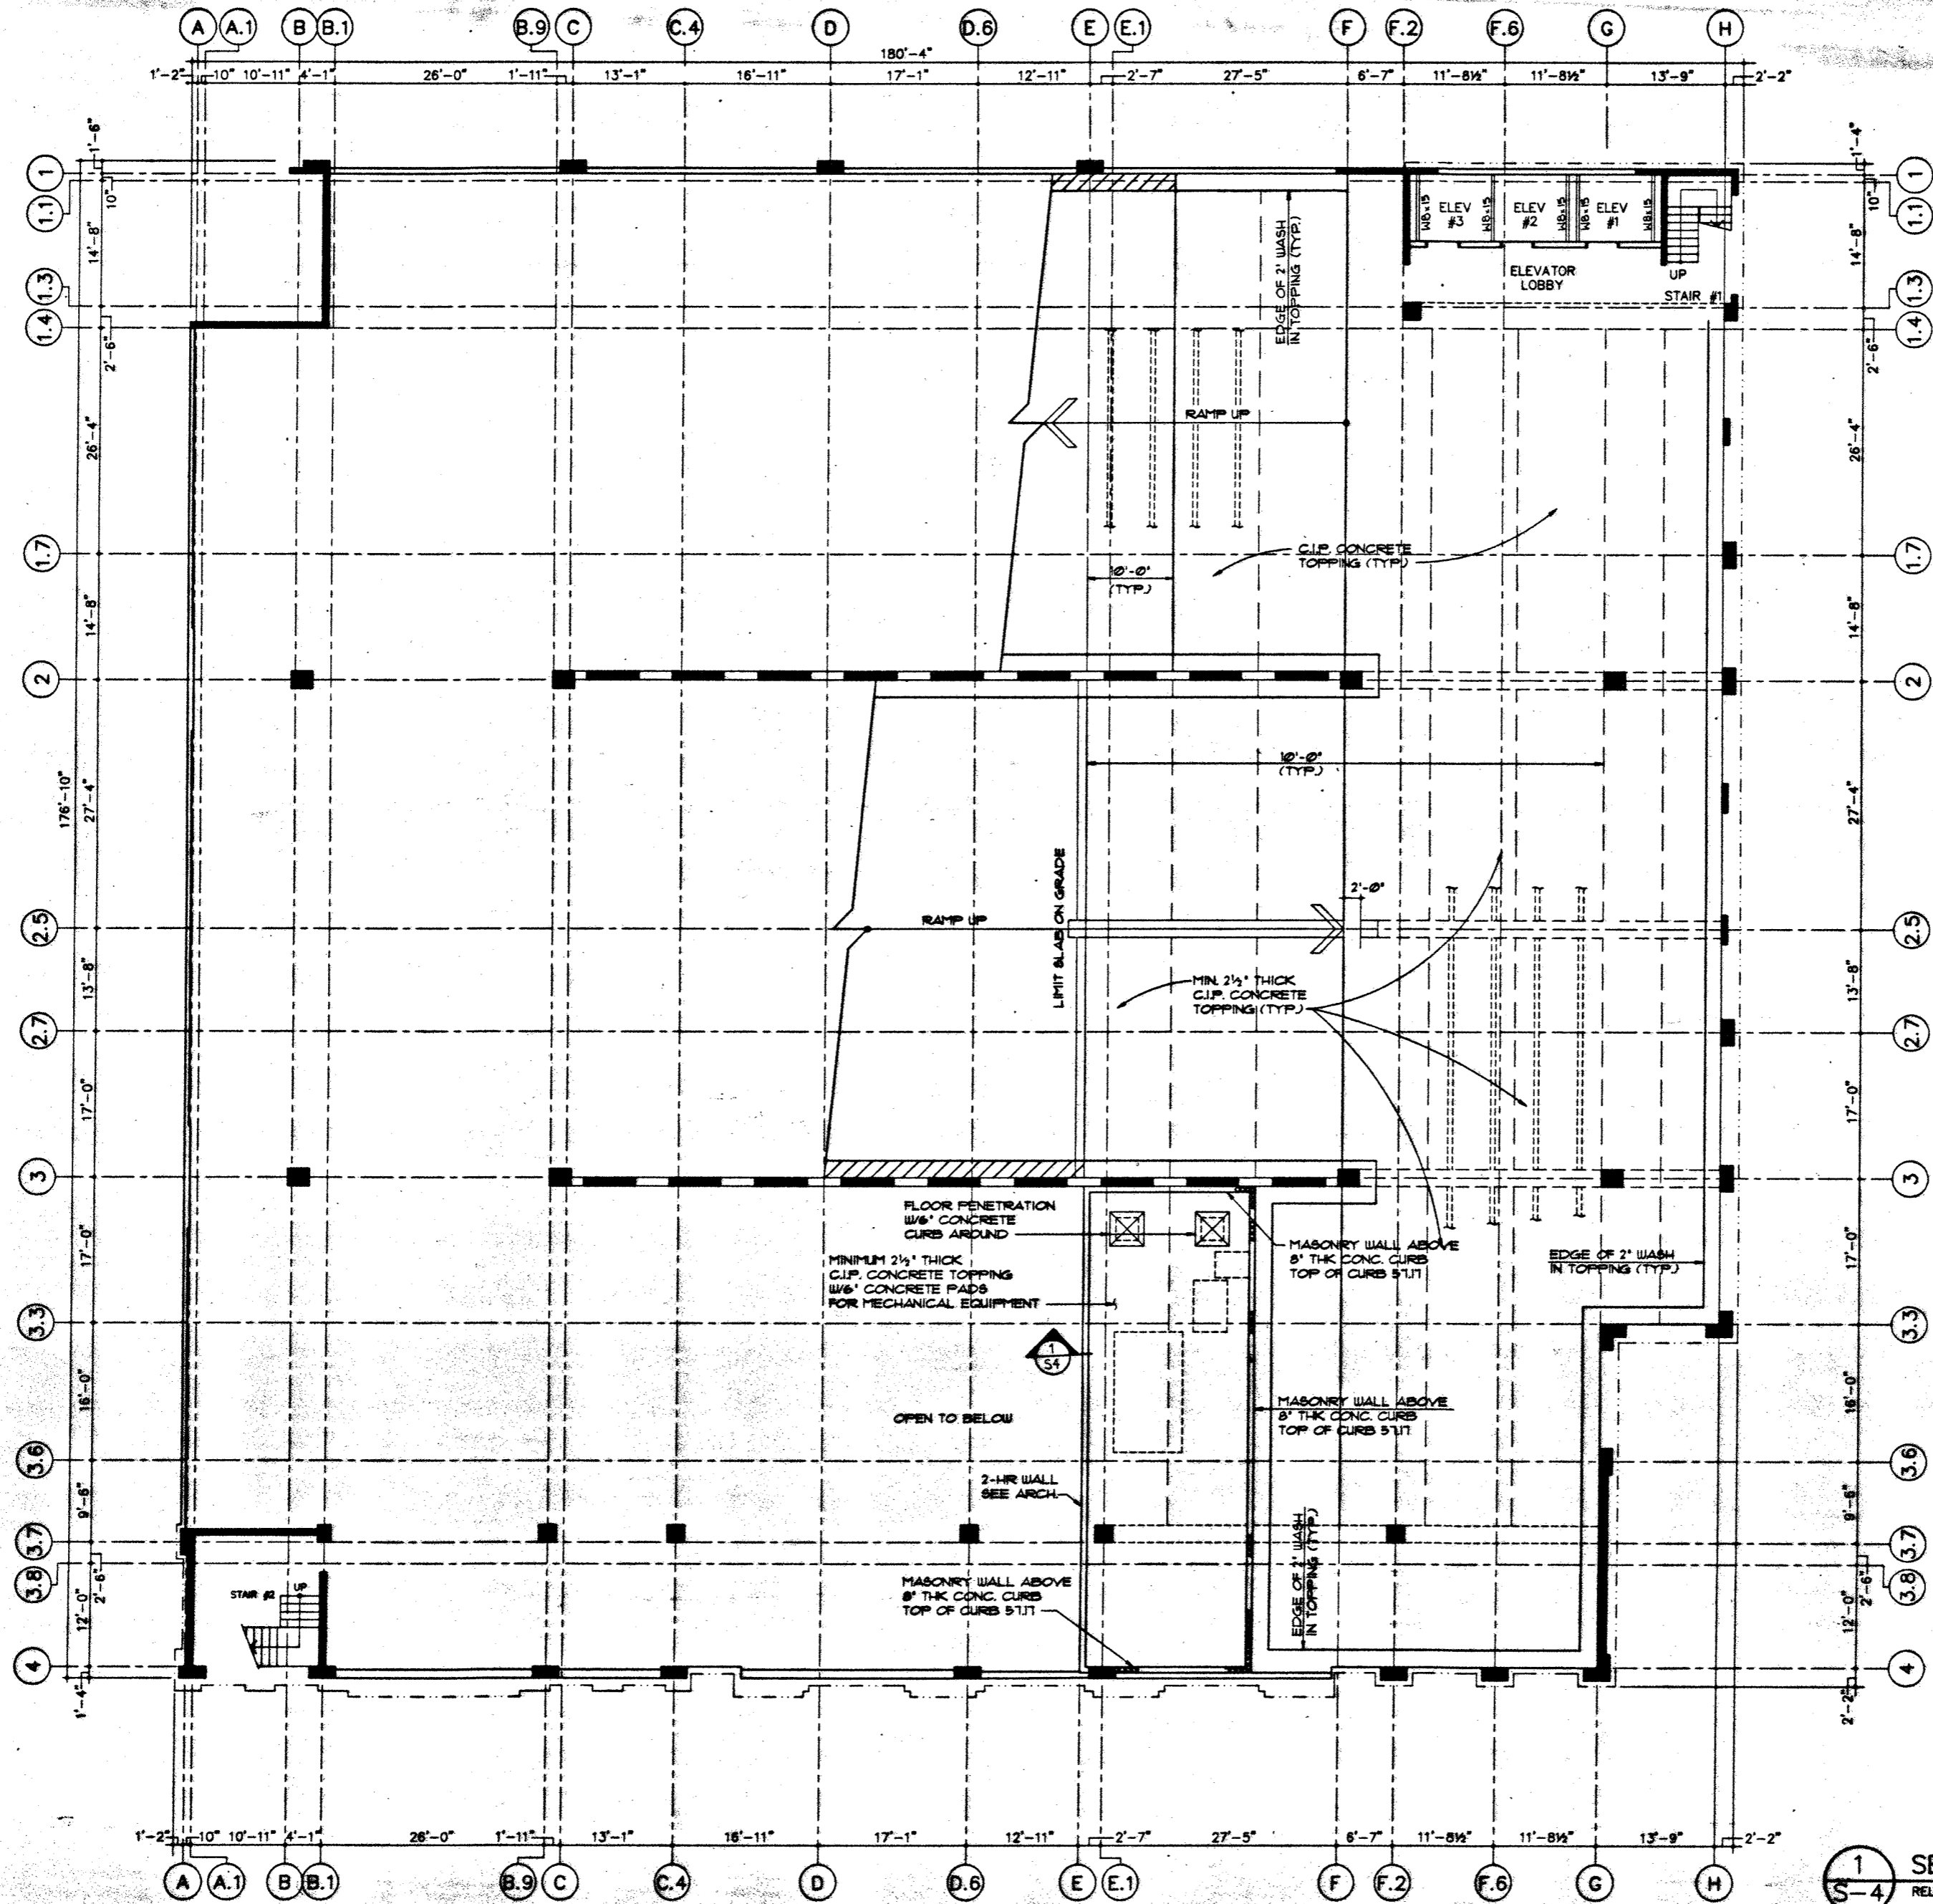


WHITING-TURNER
CONTRACTING COMPANY
DISMAN ASSOCIATES
ARCHITECTS ENGINEERS

PENN STREET PARKING FACILITY
UNIVERSITY OF MARYLAND AT BALTIMORE

1 SECOND FLOOR PLAN
S-4 RELATIVE ELEVATION = 57.00

NO.	DATE	BY
REVISIONS		
SECOND FLOOR PLAN		
DRAWING NO. S-4		
SCALE:	1/8" = 1'-0"	
DATE:	JUNE, 1993	
PROJECT NO.:	J-348	
DESIGN:	DRWN:	CHKD:
RB:	SP:	AP:

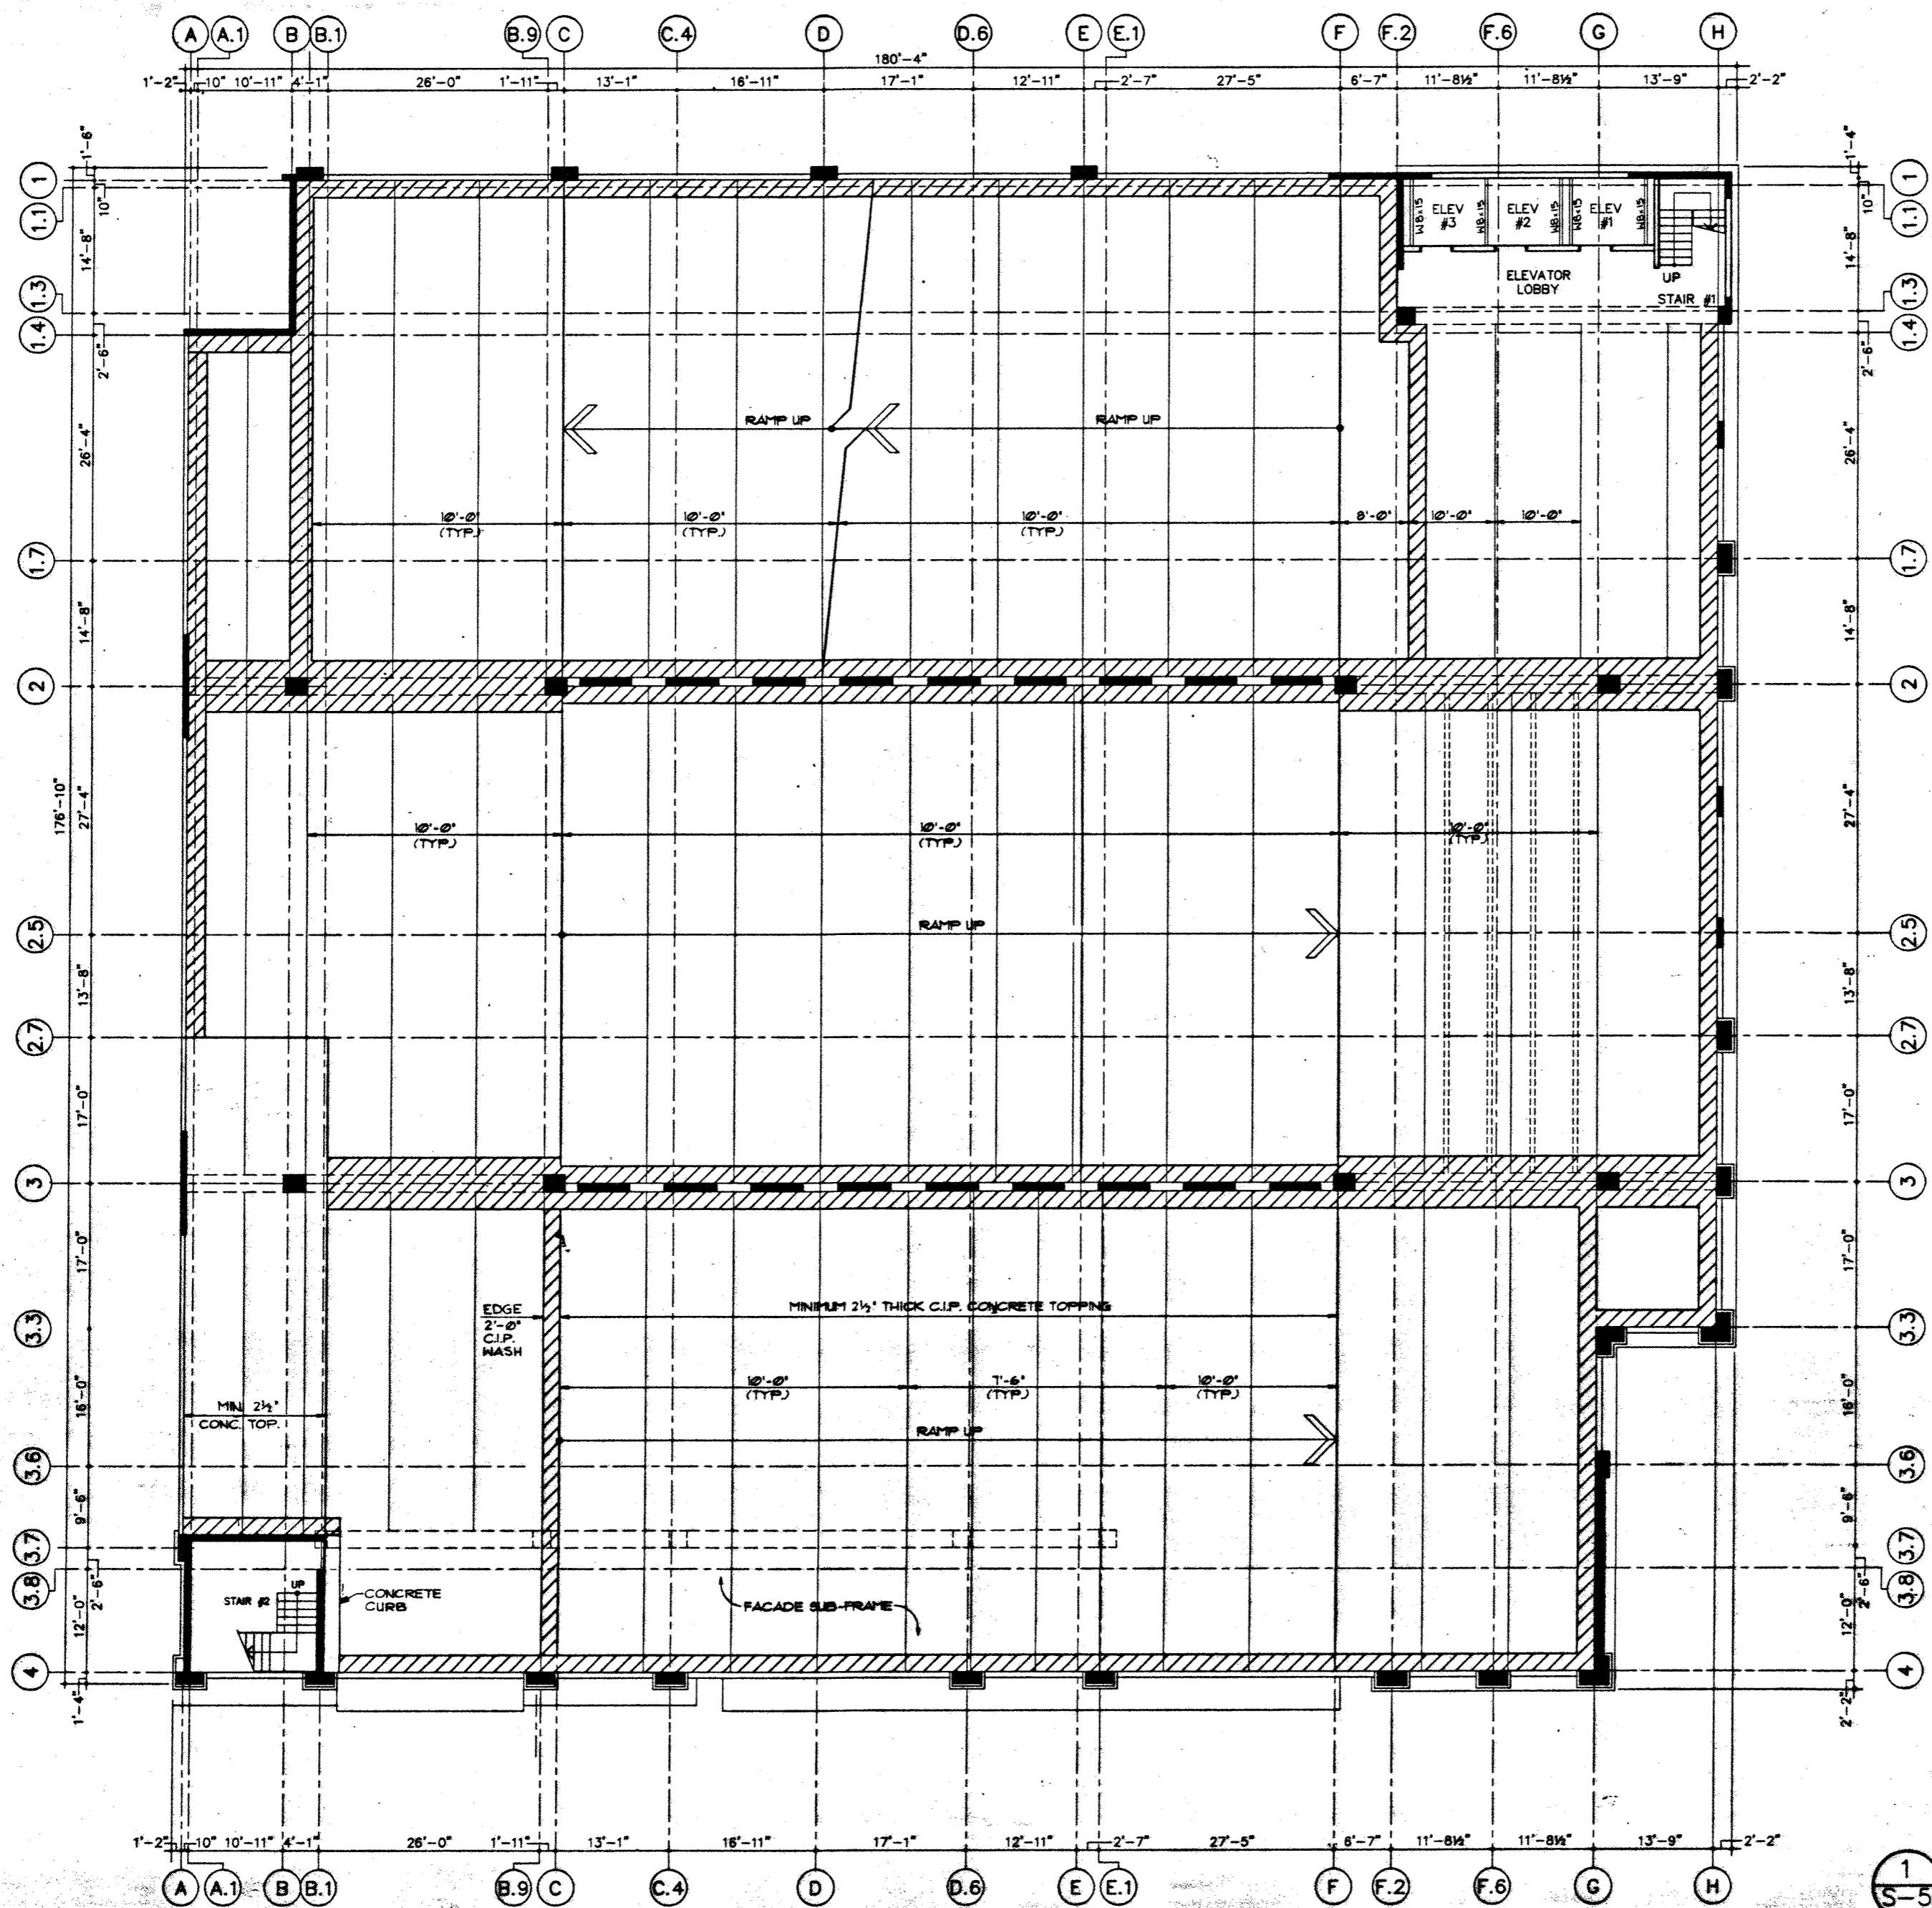


1 THIRD LEVEL PLAN
 S-5 RELATIVE ELEVATION = 66.50

WHITING-TURNER
 CONTRACTING COMPANY
 DESMAN ASSOCIATES
 ARCHITECTS ENGINEERS

PENN STREET PARKING FACILITY
 UNIVERSITY OF MARYLAND AT BALTIMORE

AS BUILT	S-1-16
NO.	DATE
REVISIONS	
THIRD FLOOR PLAN	
DRAWING NO.	
S-5	
SCALE:	1/8" = 1'-0"
DATE:	
PROJECT NO.:	J-248
DESIGN:	DRWEN
CHECK:	CHYLN

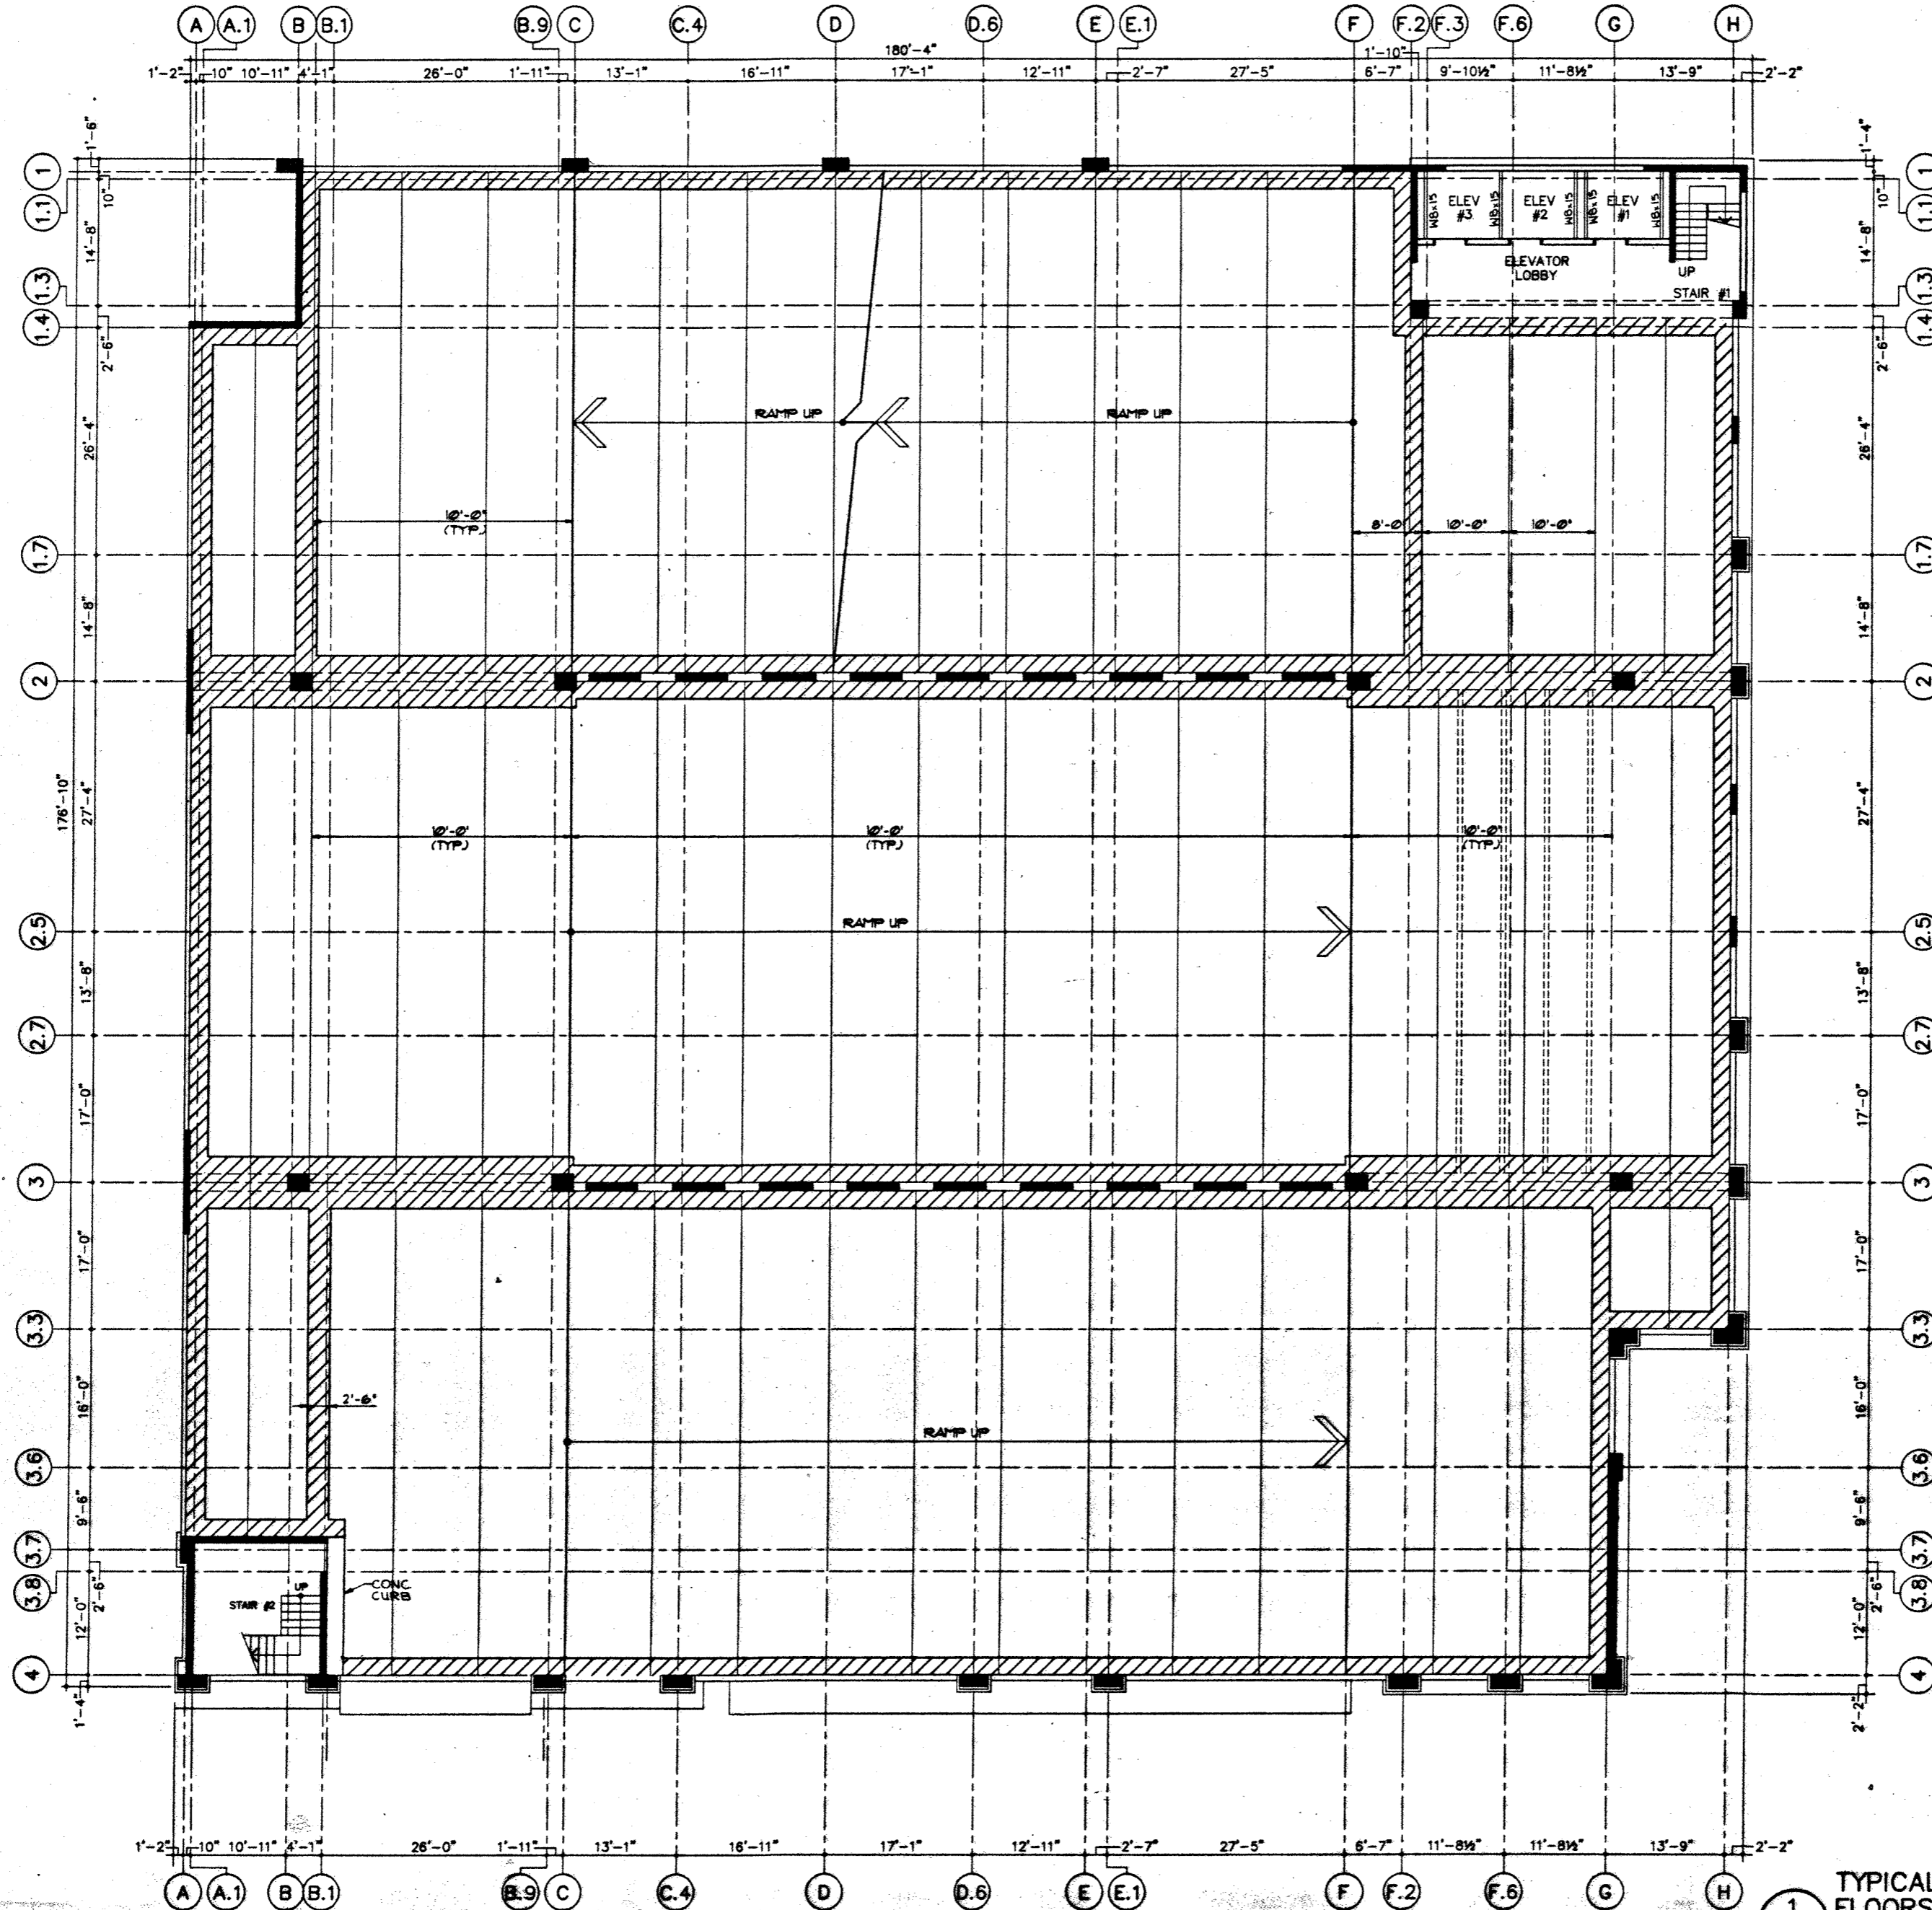


1
S-6 TYPICAL FLOOR PLAN
 FLOORS 4 THRU 9
 RELATIVE ELEVATIONS = 76.50, 86.50, 96.50, 106.50, 116.50, & 126.50

WHITING-TURNER
 CONTRACTING COMPANY
 DASMAN ASSOCIATES
 ARCHITECTS ENGINEERS

PENN STREET PARKING FACILITY
 UNIVERSITY OF MARYLAND AT BALTIMORE

AS BUILT	5-1-95		
NO.	DATE	BY	
REVISIONS			
TYPICAL FLOOR PLAN FLOORS 4-9			
DRAWING NO. S-6			
SCALE: 1/8"=1'-0"			
DATE: JUNE, 1983			
PROJECT NO. J-343			
DESIGN	DRAWN	CHECKED	
R.B.	B.P.	A.P.	

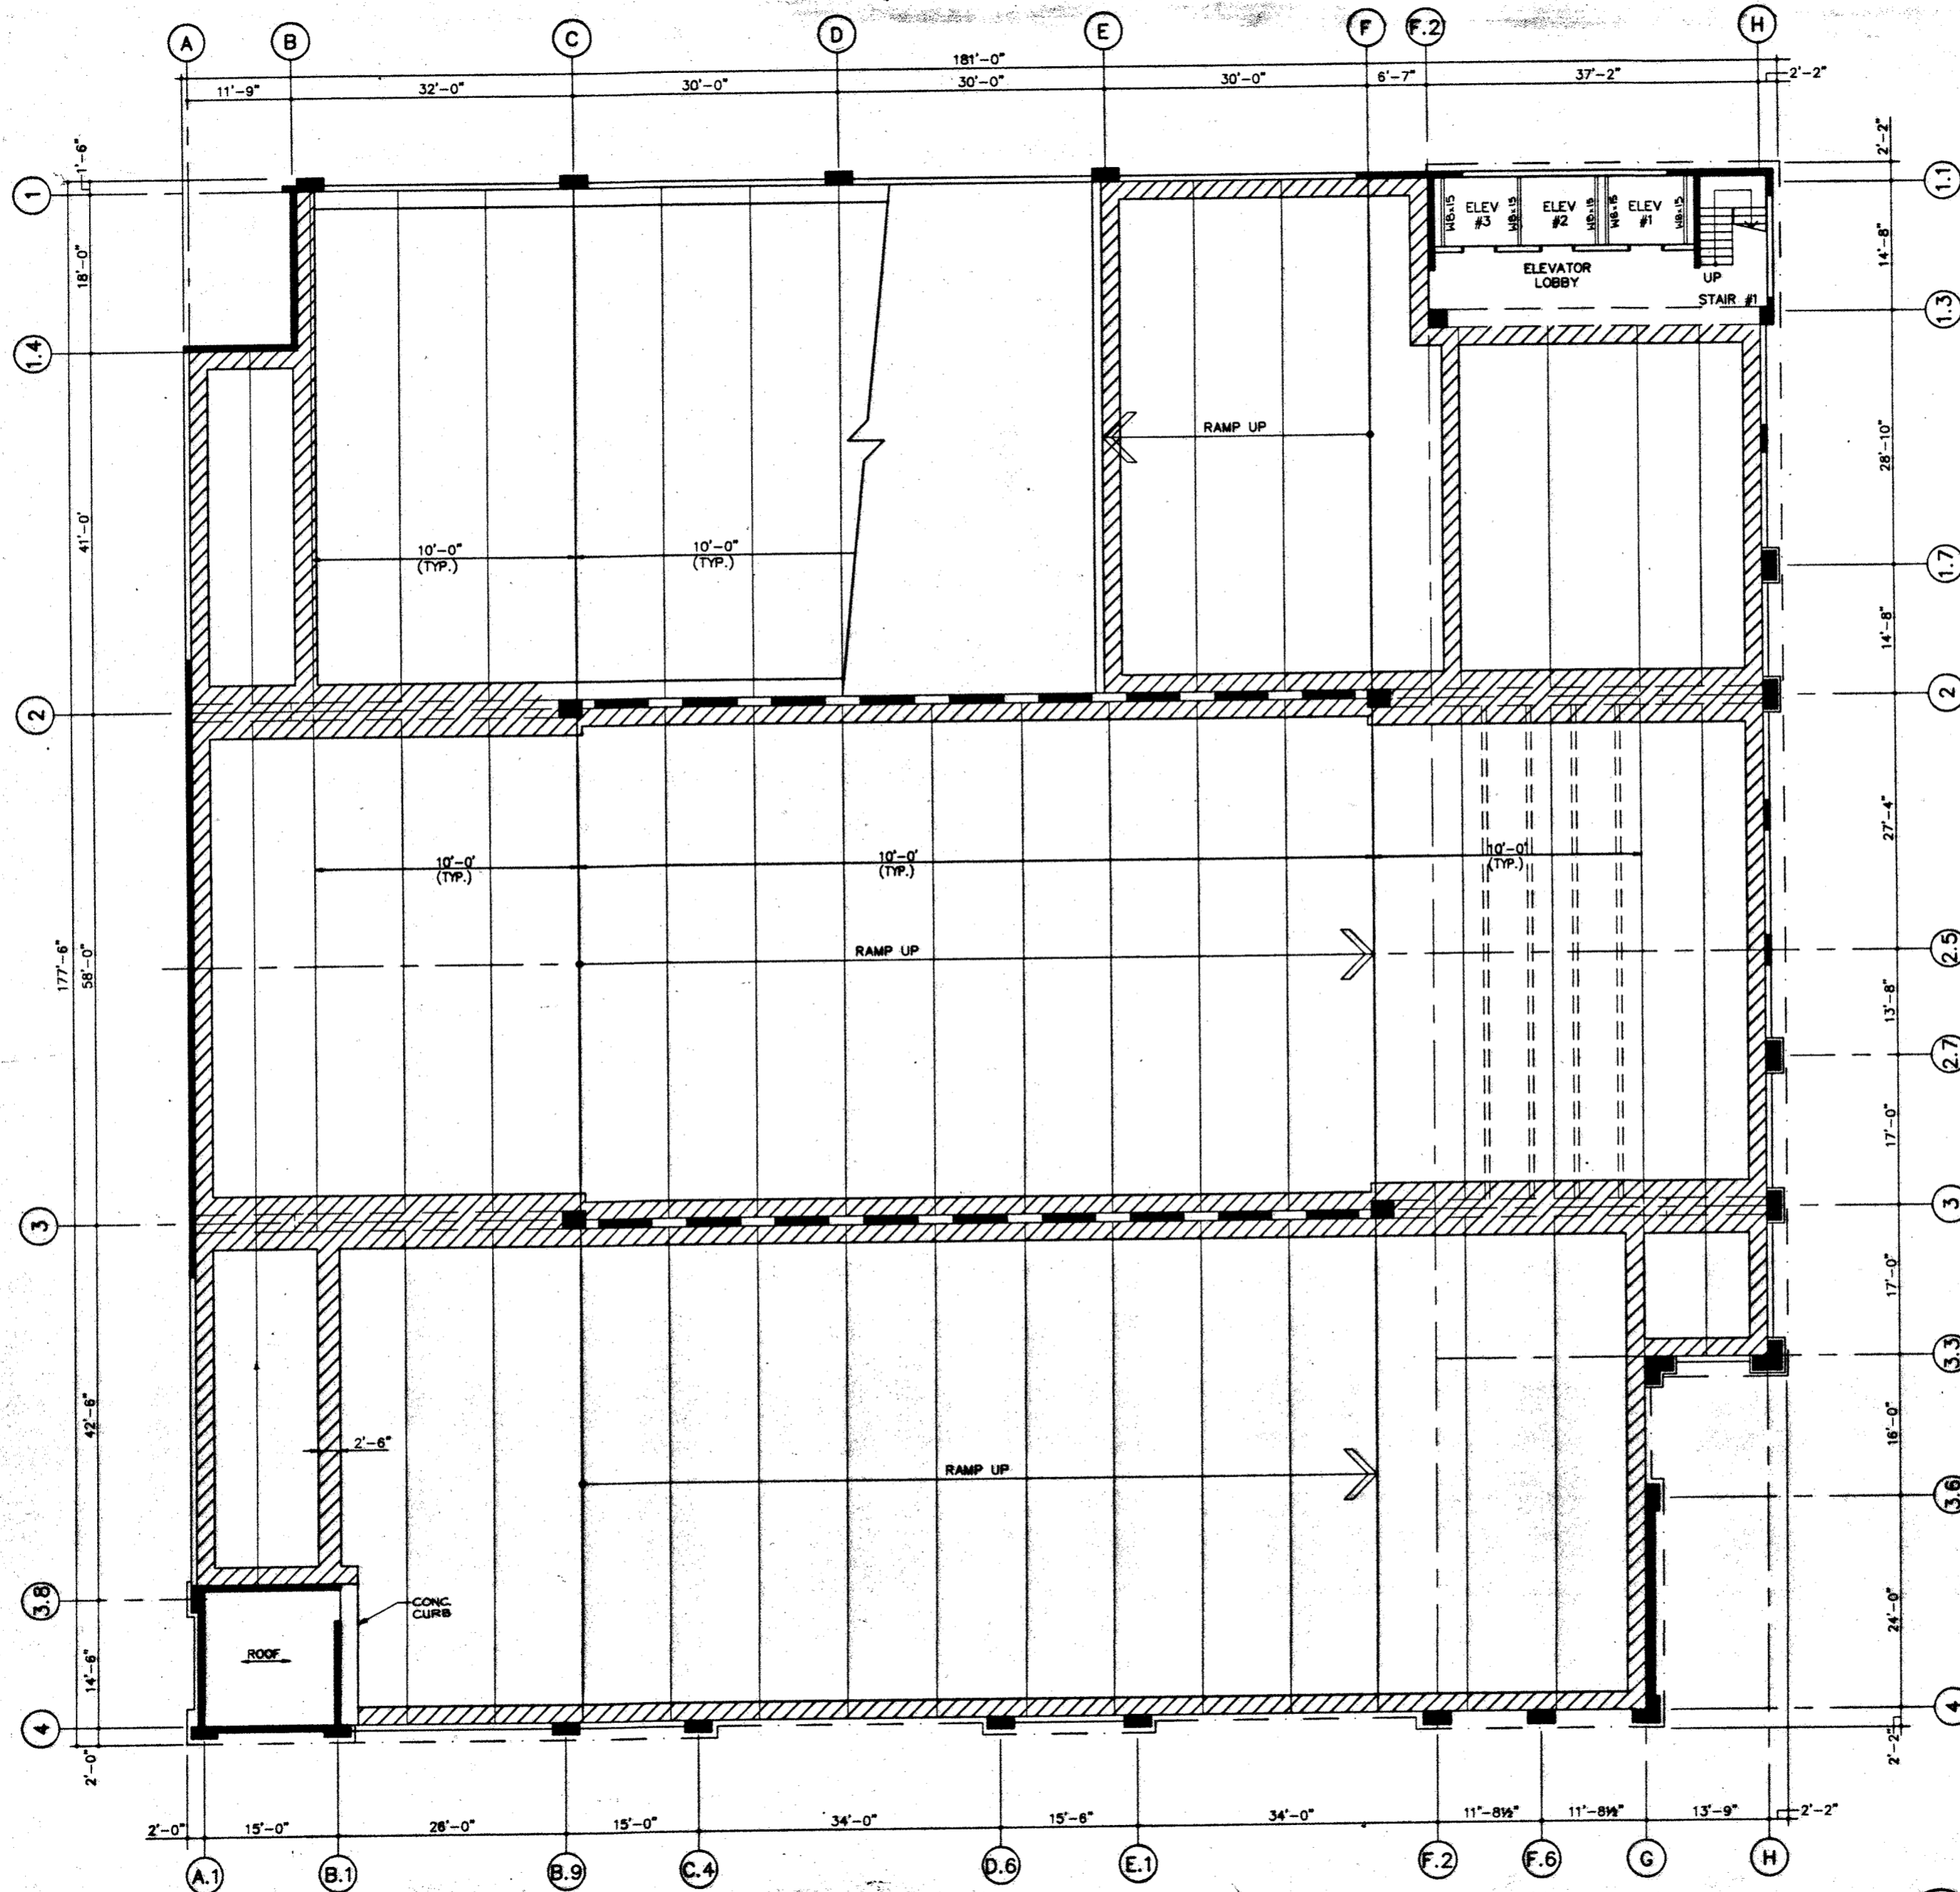


1 ROOF LEVEL FLOOR PLAN
 S-7 RELATIVE ELEVATION = 136.50

WHITING-TURNER
 CONTRACTING COMPANY
 DESMAN ASSOCIATES
 ARCHITECTS ENGINEERS


PENN STREET PARKING FACILITY
 UNIVERSITY OF MARYLAND AT BALTIMORE

AS BUILT	5-1-95	
NO.	DATE	BY
REVISIONS		
ROOF LEVEL FLOOR PLAN		
DRAWING NO.		
S-7		
SCALE: 1/8"=1'-0"		
DATE: JUNE, 1993		
PROJECT NO. J-343		
DESIGN	DRAWN	CHKD.
R.B.	B.P.	A.P.

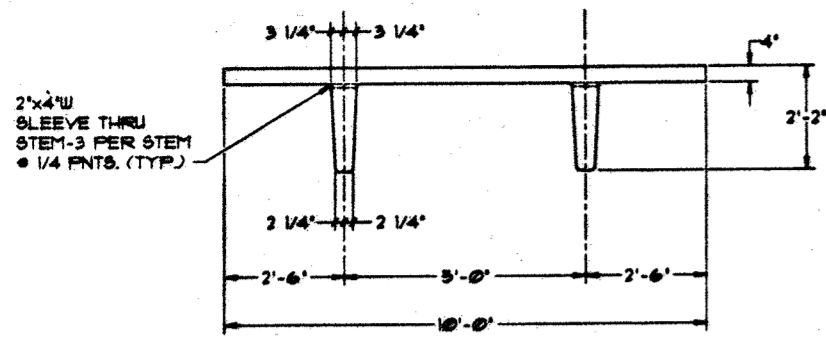


2"x4" W SLEEVE THRU STEM-3 PER STEM @ 1/4 PNTS. (TYP.)


TYPICAL DOUBLE TEE

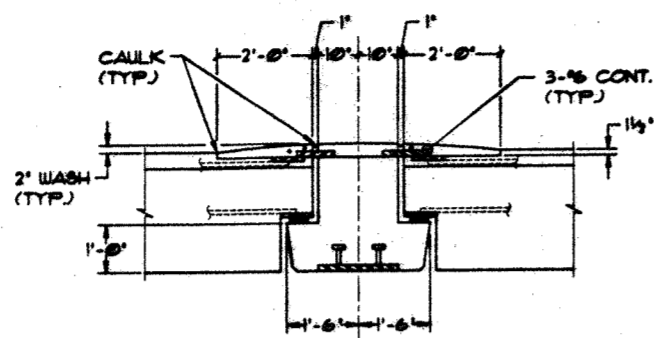

TYPICAL INVERTED TEE

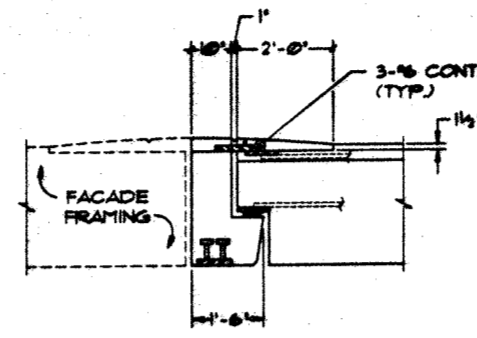

TYPICAL 'L' BEAM

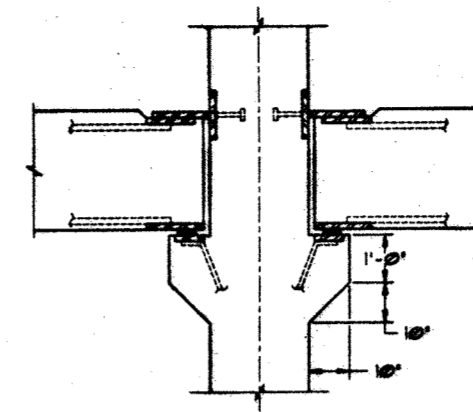


TYPICAL SECTION • INVERTED 'T' BEAM • COLUMN


GENERAL NOTES:

1. SHAPE OF THE PRECAST SECTION SHOWN IS FOR GENERAL CONFIGURATION ONLY. THE ACTUAL SHAPE WILL BE PER ARCHITECTURAL DETAILS.
2. FINISH OF PRECAST UNIT SHALL BE AS SHOWN ON ARCHITECTURAL DRAWINGS OR SELECTED BY SAMPLE PANELS.
3. ANY EMBED OR ANCHORS REQUIRED BY HVAC SPRINKLER PIPES, PLUMBING, BRICK SHELF ANGLES, MASONRY ANCHORS, ETC. SHALL BE PROVIDED BY PRECAST MANUFACTURER.
4. ALL STRUCTURAL CONNECTIONS PRECAST TO PRECAST SHALL BE GALVANIZED STEEL EXCEPT SHEAR CONNECTORS SHALL BE STAINLESS STEEL.
5. ALL FOUNDATION ANCHOR BOLTS SHALL BE GALVANIZED STEEL. COLUMN BASE PLATES SHALL BE PAINTED STEEL.


WHITING-TURNER
CONTRACTING COMPANY
DASMAN ASSOCIATES
ARCHITECTS ENGINEERS

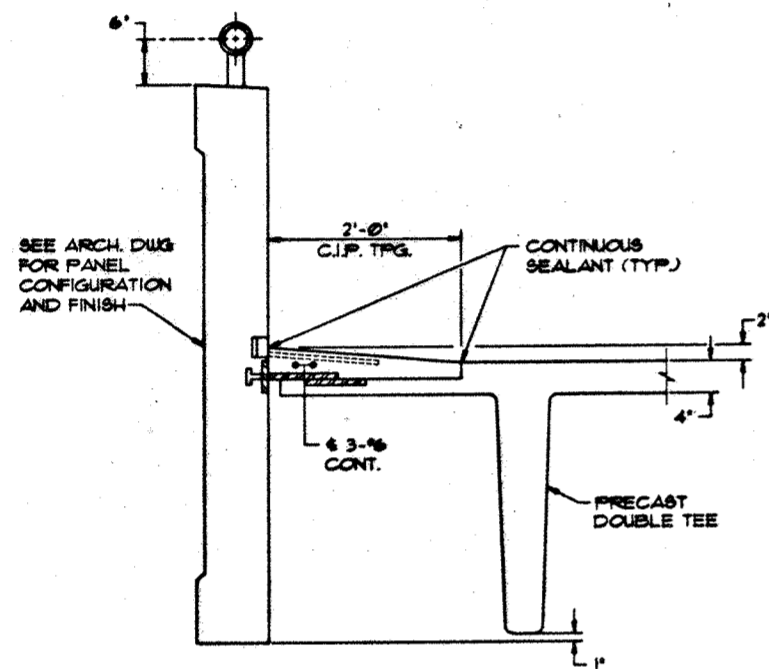


TYPICAL LOAD BEARING SPANDREL DETAIL

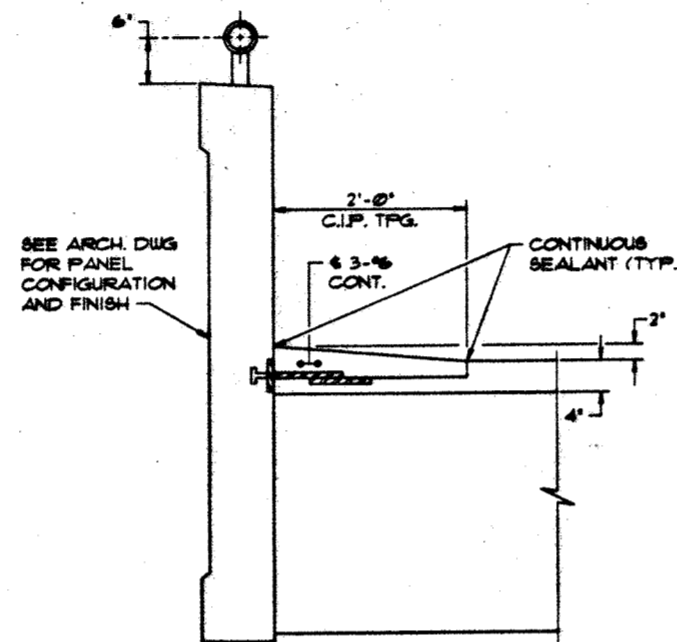


TYPICAL NON-LOAD BEARING SPANDREL DETAIL

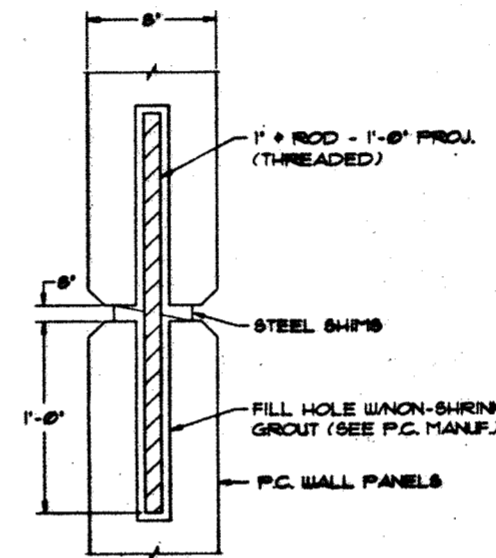


TYPICAL WALL PANEL DETAIL

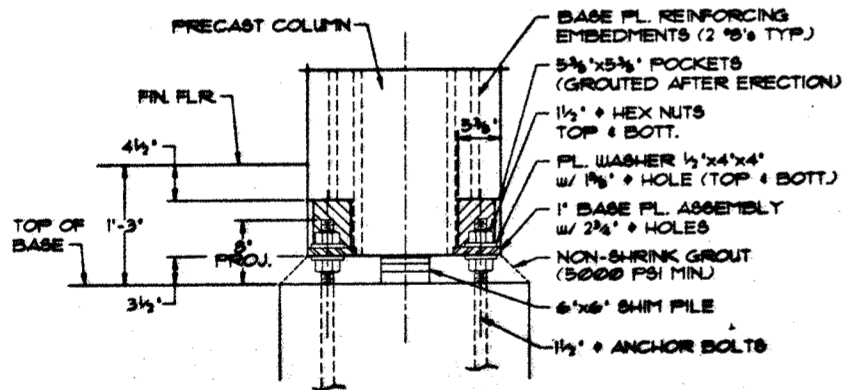


COLUMN TO BASE/FOUNDATION DETAIL

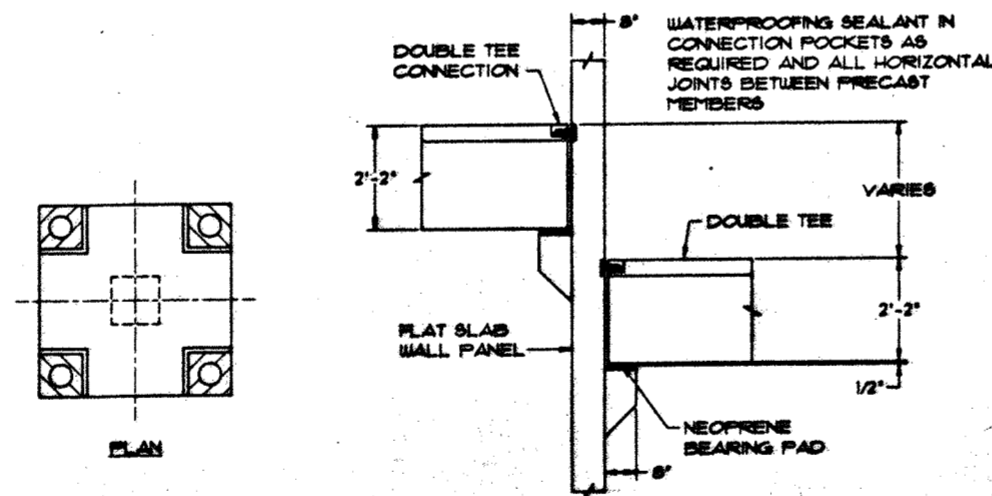


TYPICAL WALL/DOUBLE TEE DETAIL

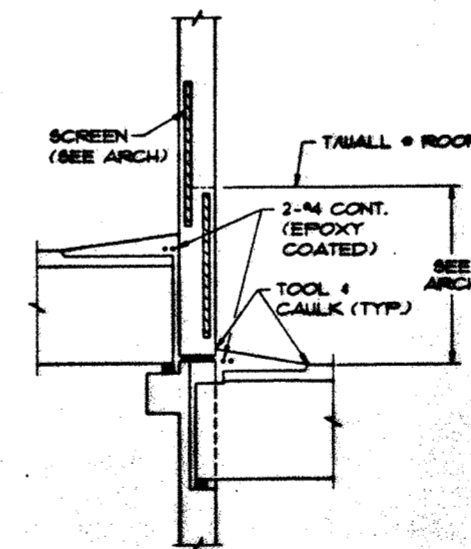


TYPICAL SECTION

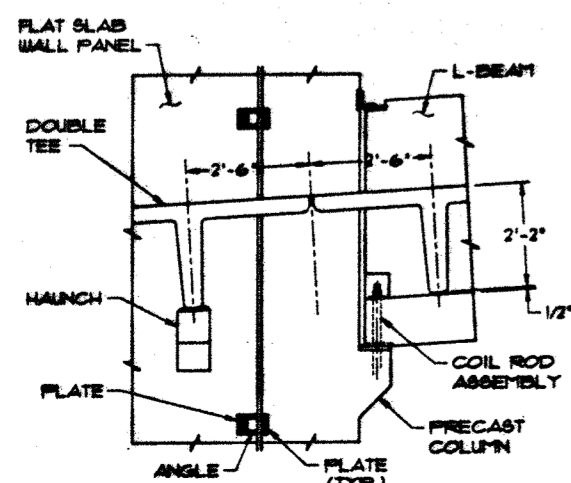


TYPICAL WALL/GIRDER DETAIL

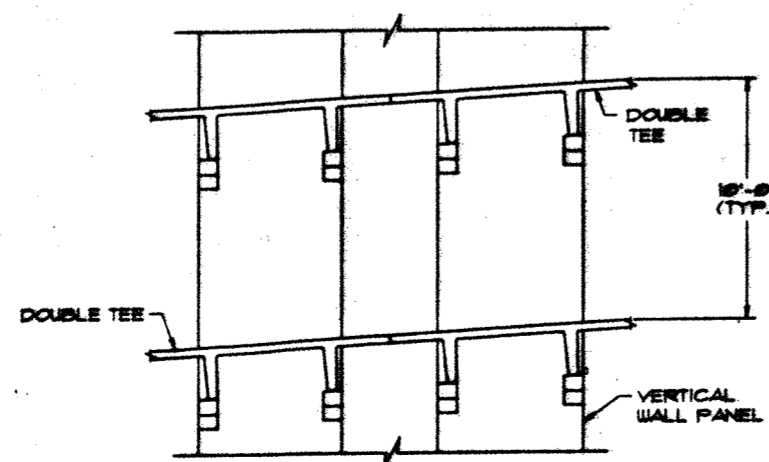

TYPICAL WALL DETAIL

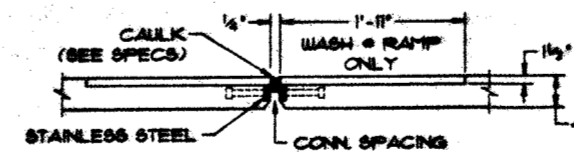

TYPICAL DOUBLE TEE CONNECTION DETAIL

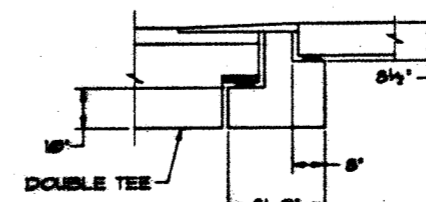

TYPICAL SECTION • STAIRS


PENN STREET PARKING FACILITY
UNIVERSITY OF MARYLAND AT BALTIMORE

AS BUILT 5-1-95
NO. DATE BY
REVISIONS


TYPICAL PRECAST DETAILS

DRAWING NO.
S-8


SCALE: N.T.S.
DATE: JUNE, 1988
PROJECT NO. J-343
DESIGN DRAWN CHKD.
R.B. B.P. A.P.

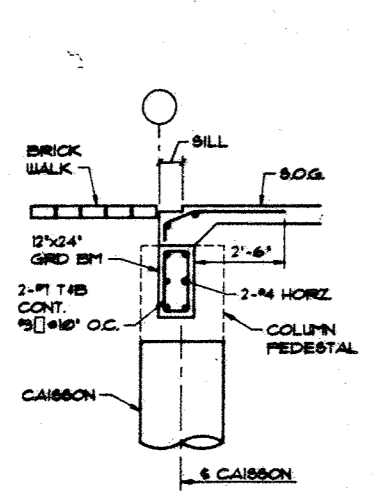


SECTION 1
SCALE: 1/4" = 1'-0"

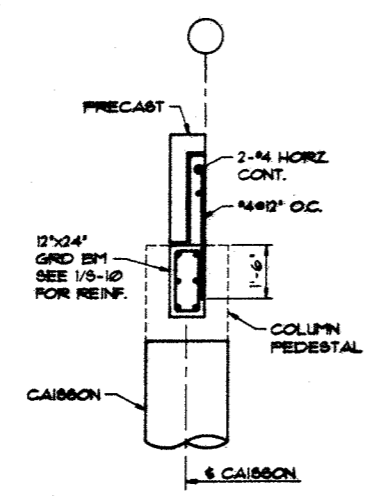


SECTION 2
SCALE: 1/4" = 1'-0"

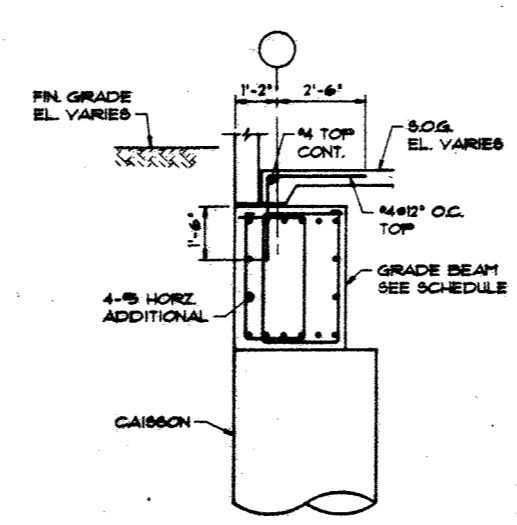


SECTION 3
SCALE: 1/4" = 1'-0"

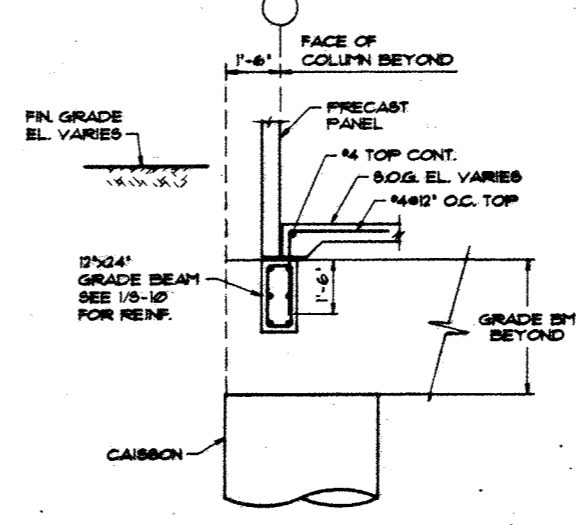


SECTION 4
SCALE: 1/4" = 1'-0"

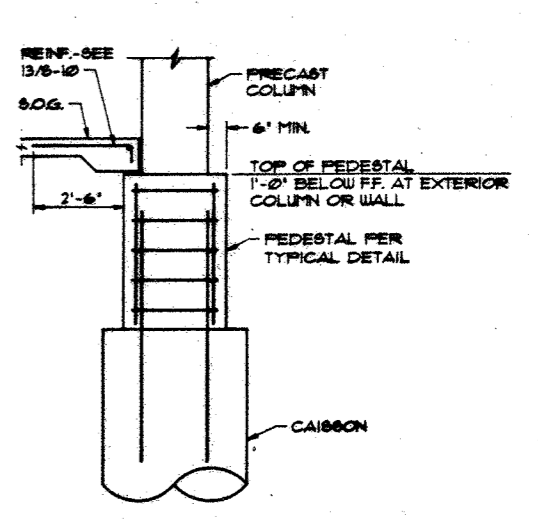


SECTION 5
SCALE: 1/4" = 1'-0"

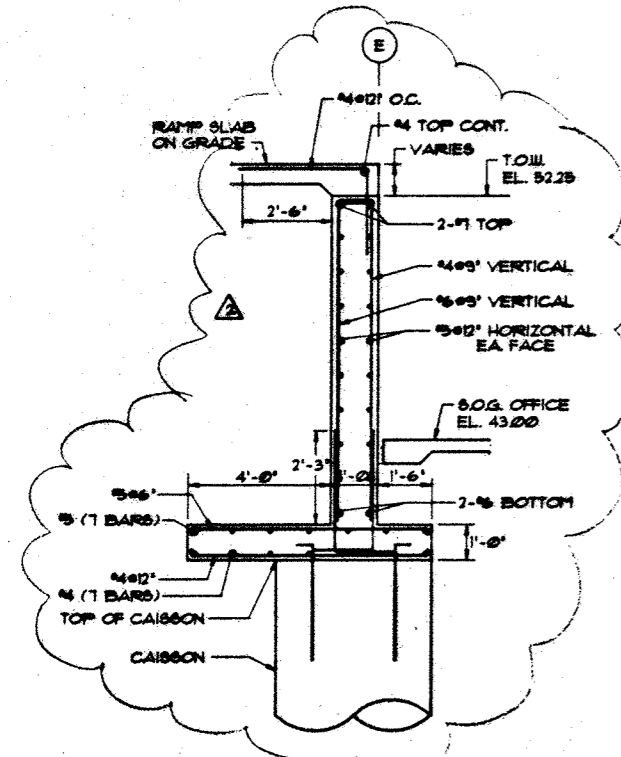


SECTION 6
N.T.S.

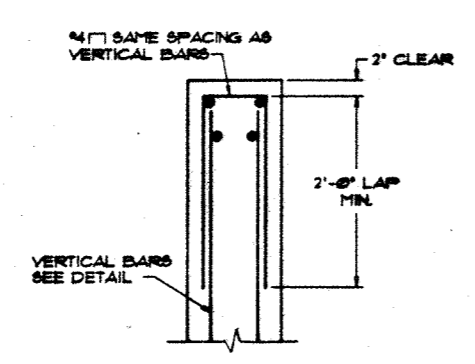


TYPICAL TOP OF WALL
SCALE: 1" = 1'-0"

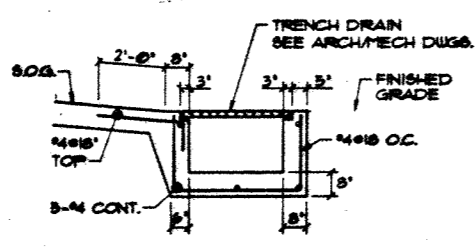


SECTION 7
SCALE: 1/4" = 1'-0"

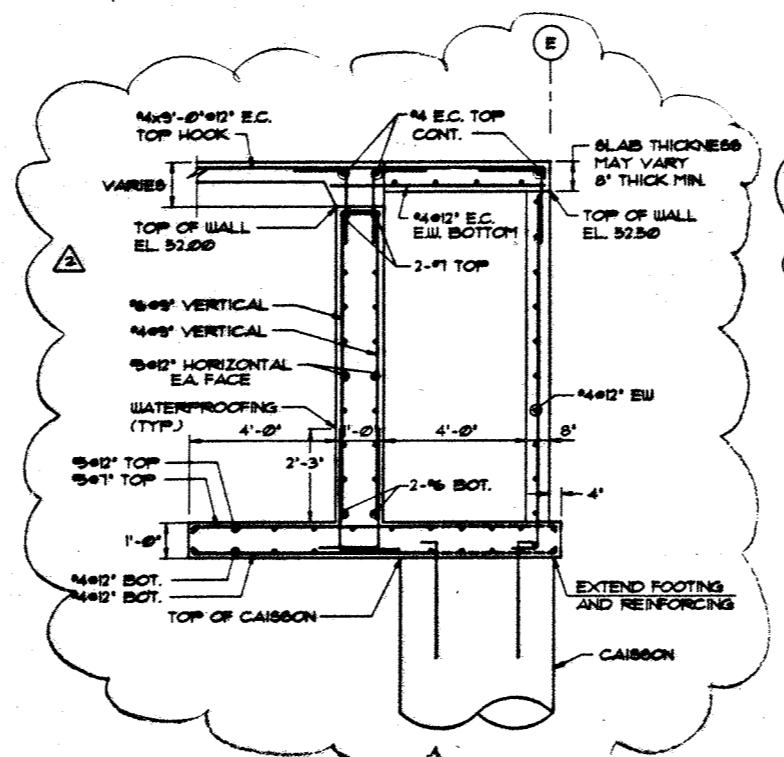


SECTION 8
N.T.S.

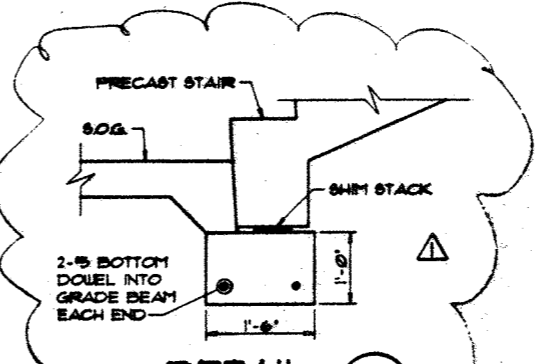


DETAIL 8A
SCALE: 1/4" = 1'-0"

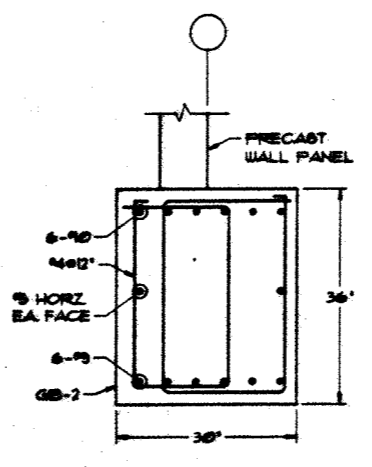


SECTION 9
SCALE: 1/4" = 1'-0"

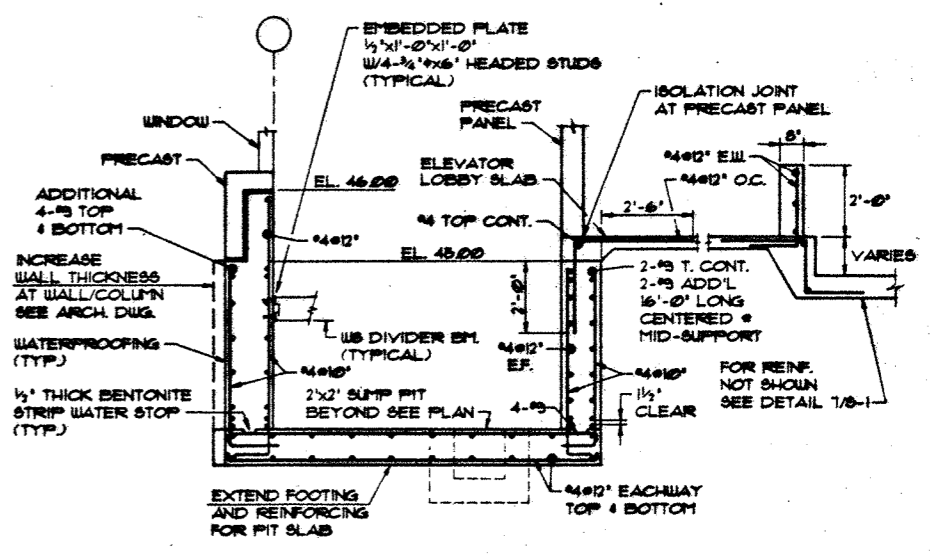


SECTION 10
SCALE: 1/4" = 1'-0"

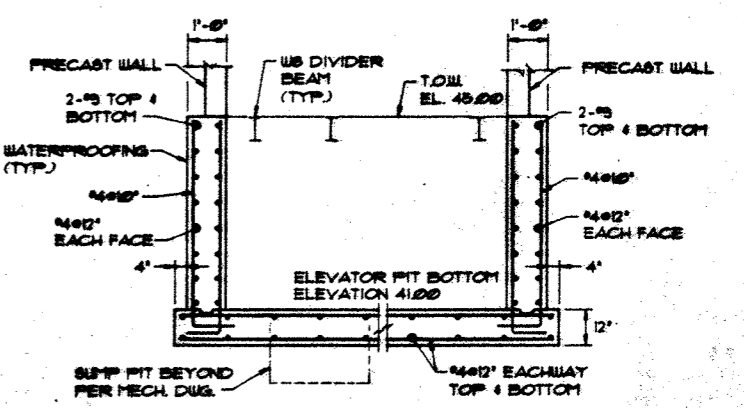


SECTION 10A
SCALE: 1/4" = 1'-0"

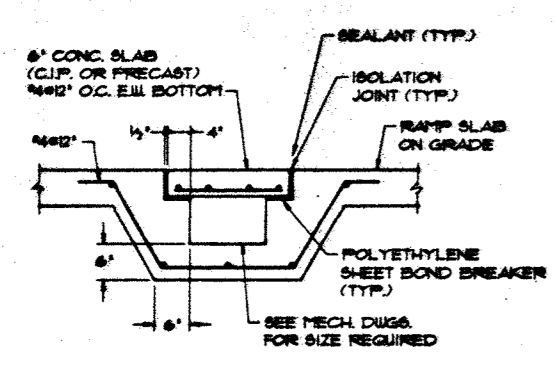


SECTION 11
SCALE: 1/4" = 1'-0"

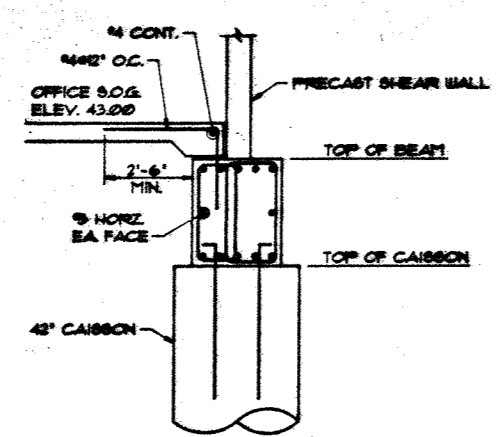


SECTION 13
SCALE: 1/4" = 1'-0"

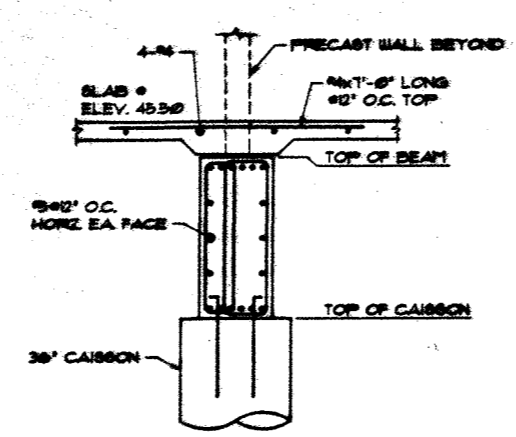


SECTION 13A
SCALE: 1/4" = 1'-0"

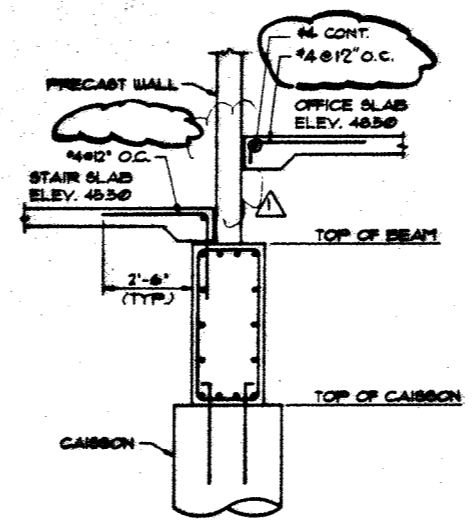

SECTION 13B
SCALE: 1/4" = 1'-0"

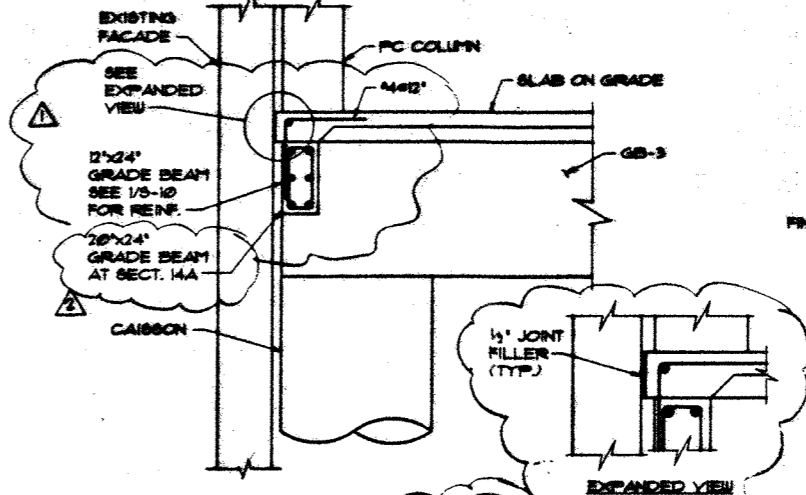

SECTION 14
SCALE: 1/4" = 1'-0"

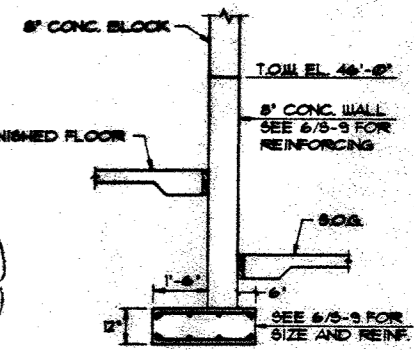

SECTION 15
SCALE: 1/4" = 1'-0"

NO.	DATE	BY

REVISIONS

FOUNDATION SECTIONS


DRAWING NO. S-10

SCALE: AS NOTED


DATE: 4/30/93

PROJECT NO. J-343


DESIGN DRAWN BY: R.B. SP. A.P.

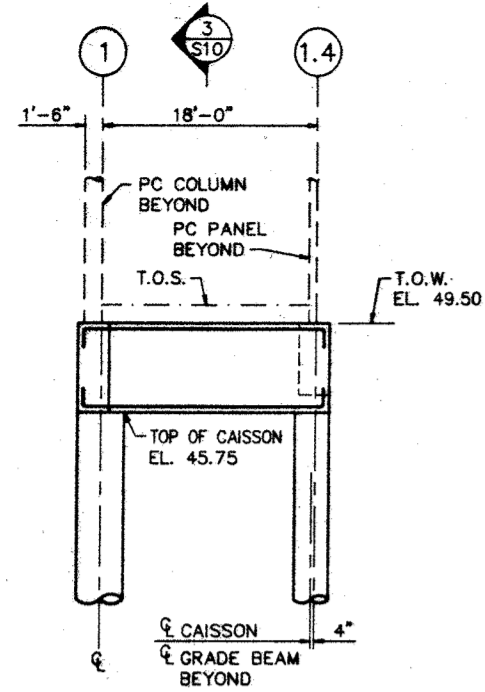


WEST ELEVATION
GRID LINE B (E3)
H.S.: 1/8"=1'-0"
V.S.: 1/4"=1'-0"
S11

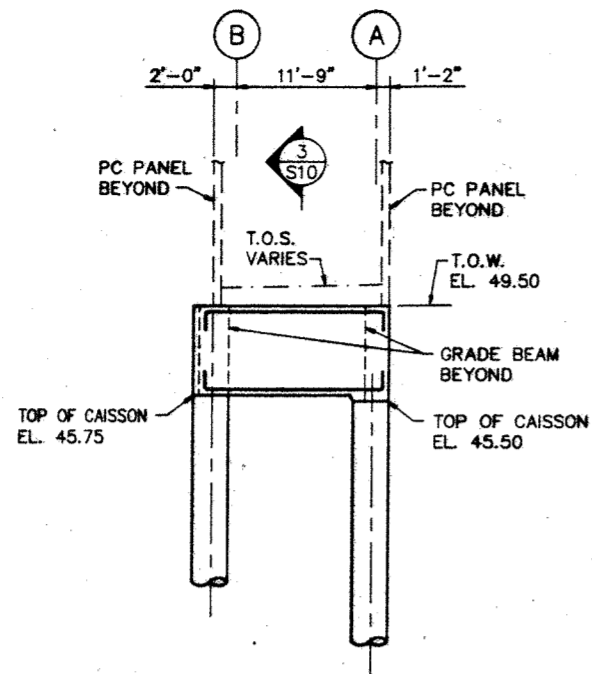


NORTH ELEVATION
GRID LINE 1.4 (E2)
H.S.: 1/8"=1'-0"
V.S.: 1/4"=1'-0"
S11

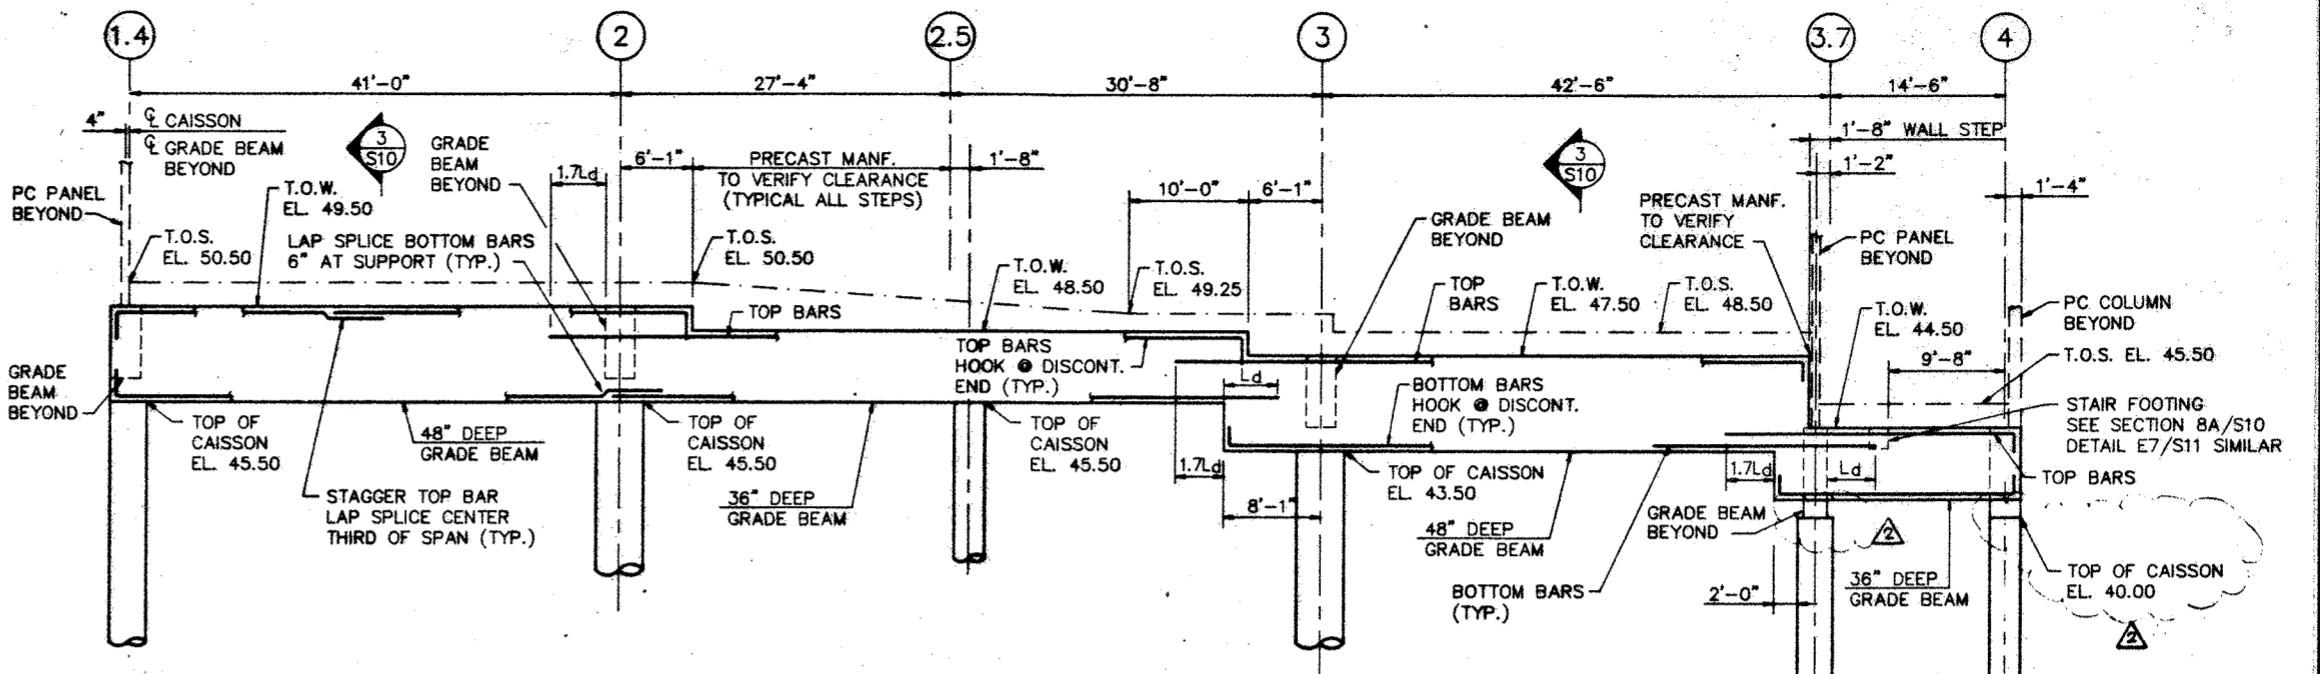


WEST ELEVATION
GRID LINE A (E1)
H.S.: 1/8"=1'-0"
V.S.: 1/4"=1'-0"
S11

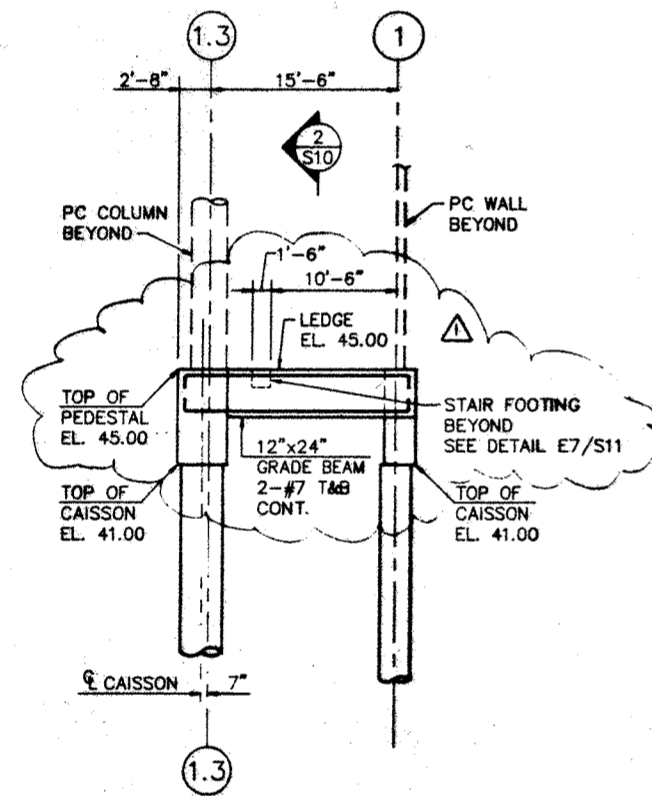


EAST ELEVATION
GRID LINE H (E5)
H.S.: 1/8"=1'-0"
V.S.: 1/4"=1'-0"
S11

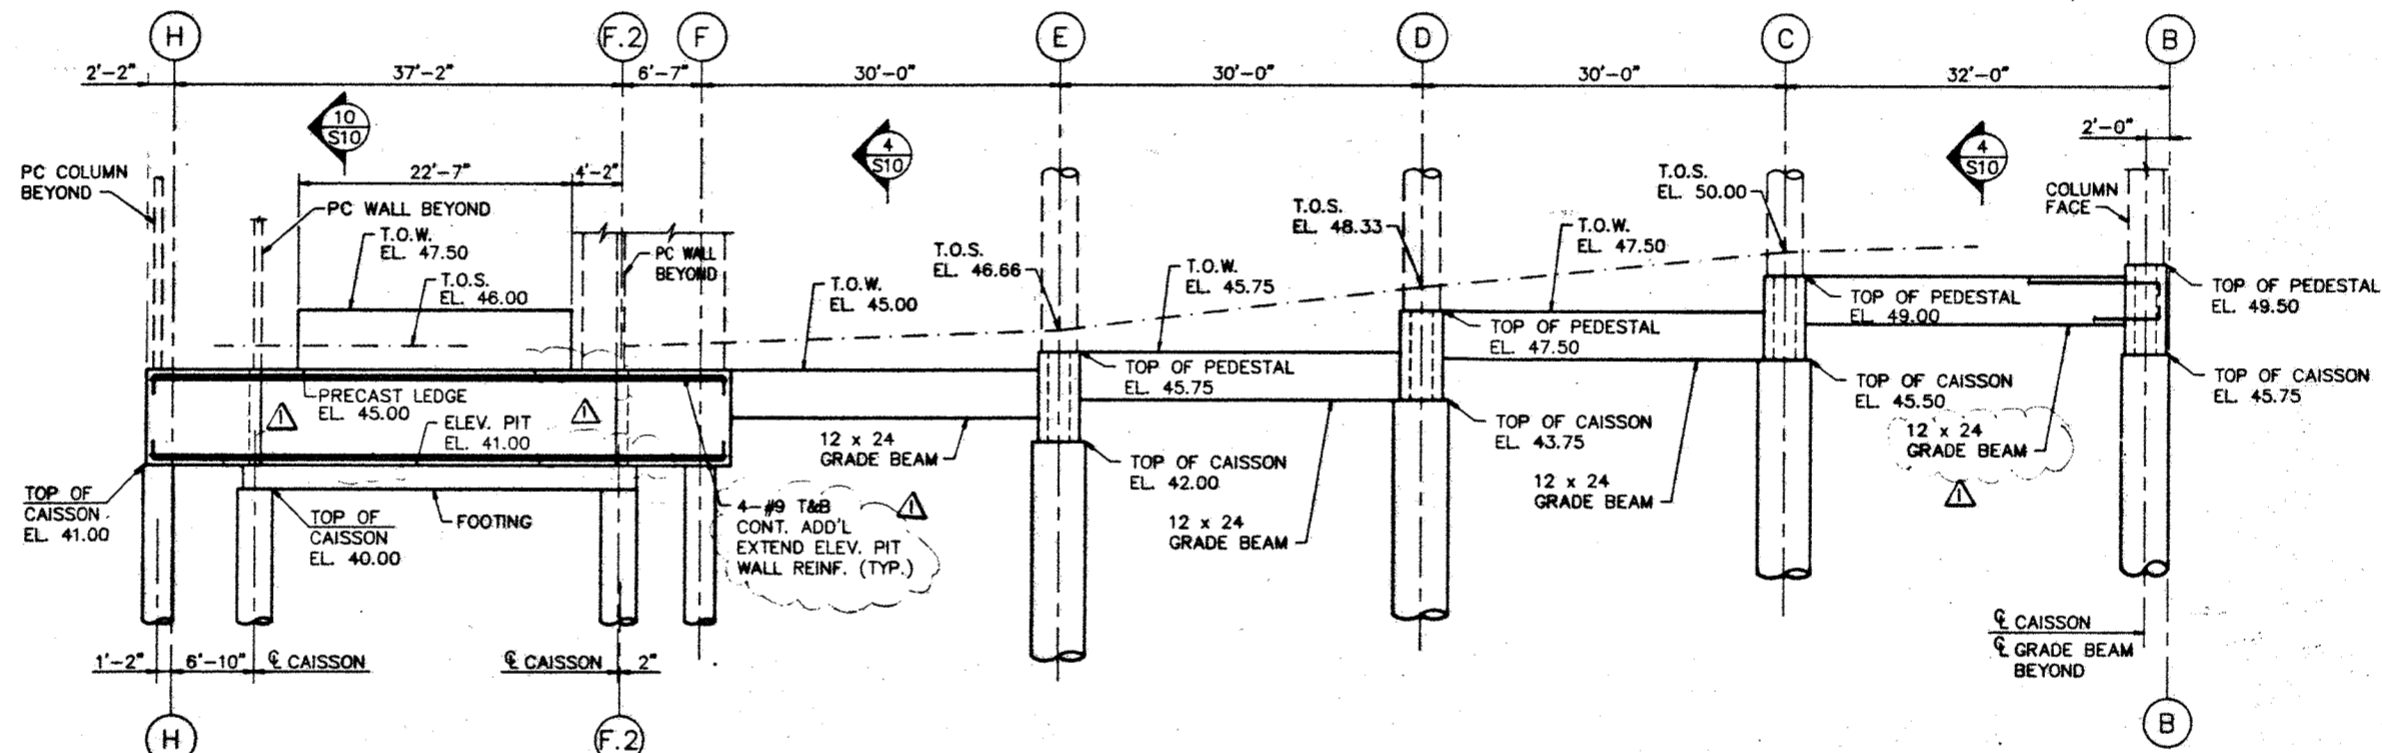


NORTH ELEVATION
GRID LINE 1 (E4)
H.S.: 1/8"=1'-0"
V.S.: 1/4"=1'-0"
S11

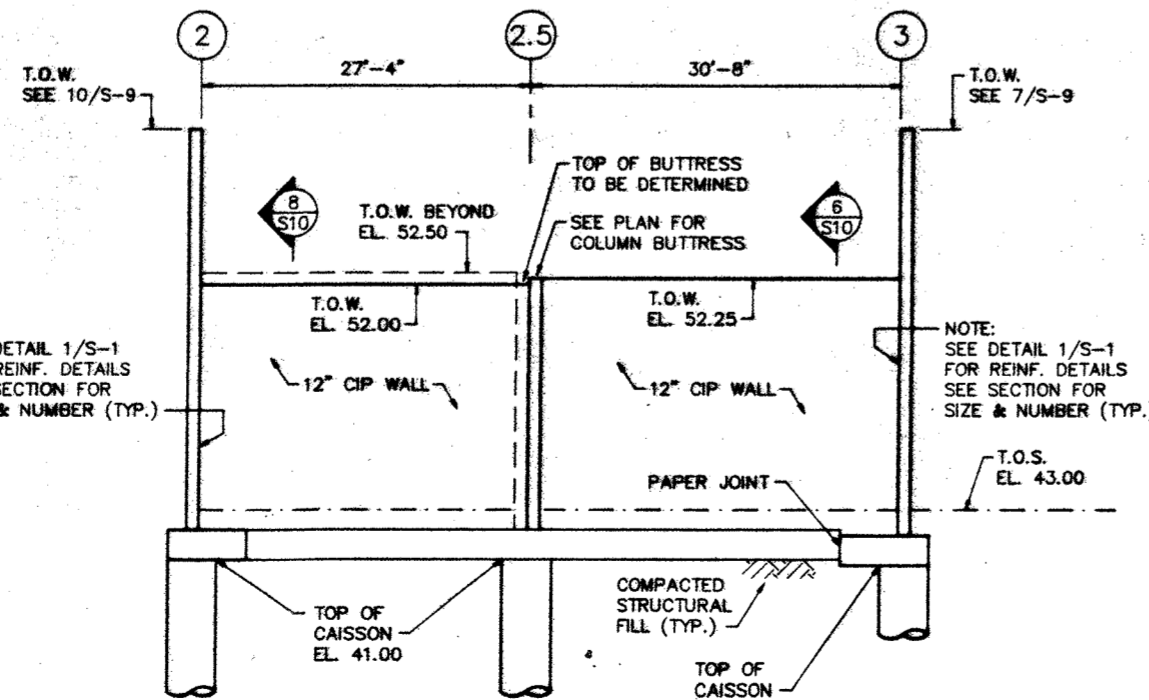

WEST ELEVATION
GRID LINE E (E6)
H.S.: 1/8"=1'-0"
V.S.: 1/4"=1'-0"
S11

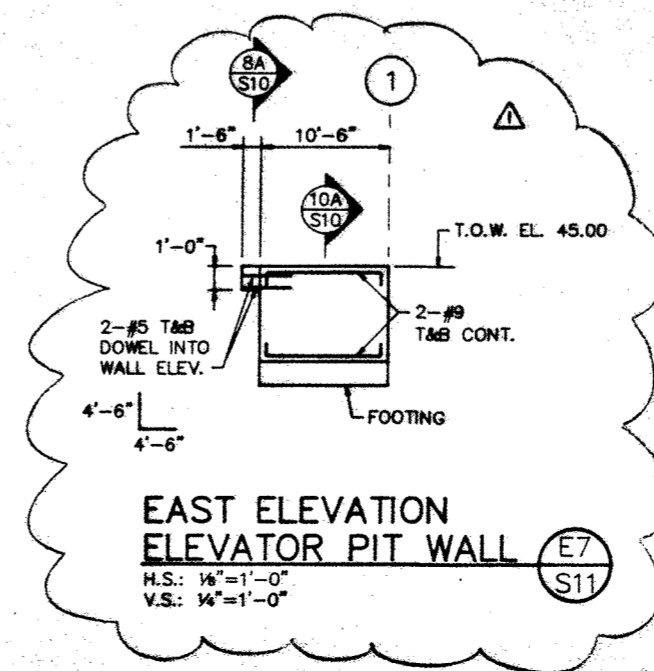

EAST ELEVATION
ELEVATOR PIT WALL (E7)
H.S.: 1/8"=1'-0"
V.S.: 1/4"=1'-0"
S11

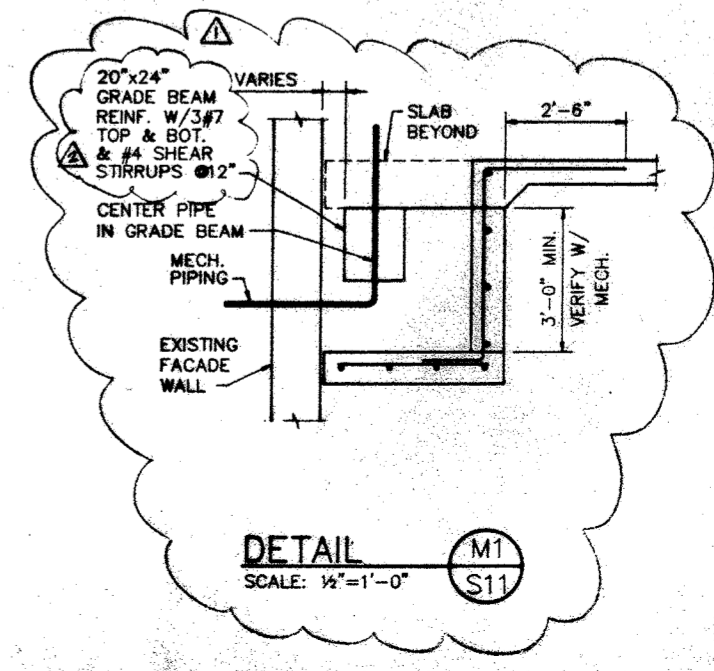

DETAIL (M1)
SCALE: 1/8"=1'-0"
S11

NOTE:
SEE DETAIL 1/S-1
FOR REINF. DETAILS
SEE SECTION FOR
SIZE & NUMBER (TYP.)

NOTE:
SEE DETAIL 1/S-1
FOR REINF. DETAILS
SEE SECTION FOR
SIZE & NUMBER (TYP.)

NO.	DATE	BY
AS BUILT	5-1-95	
	1-26-93	
	8-16-93	

ELEVATION
DETAILS

DRAWING NO.

S-11

SCALE: AS NOTED
DATE: JUNE 1993
PROJECT NO. J-348
DESIGN | DRAWN | CHKD.
JBA | JBA | JBA


NO.	DATE	BY
8-28-93		
7-13-93		

FOUNDATION FLOOR PLAN

DRAWING NO.
M-1

SCALE: 1/8" = 1'-0"
DATE: 6-24-93
PROJECT NO. J-343
DESIGNER: DAT
DRAWN: MKA

APRIL 3, 1995 AS-BUILTS

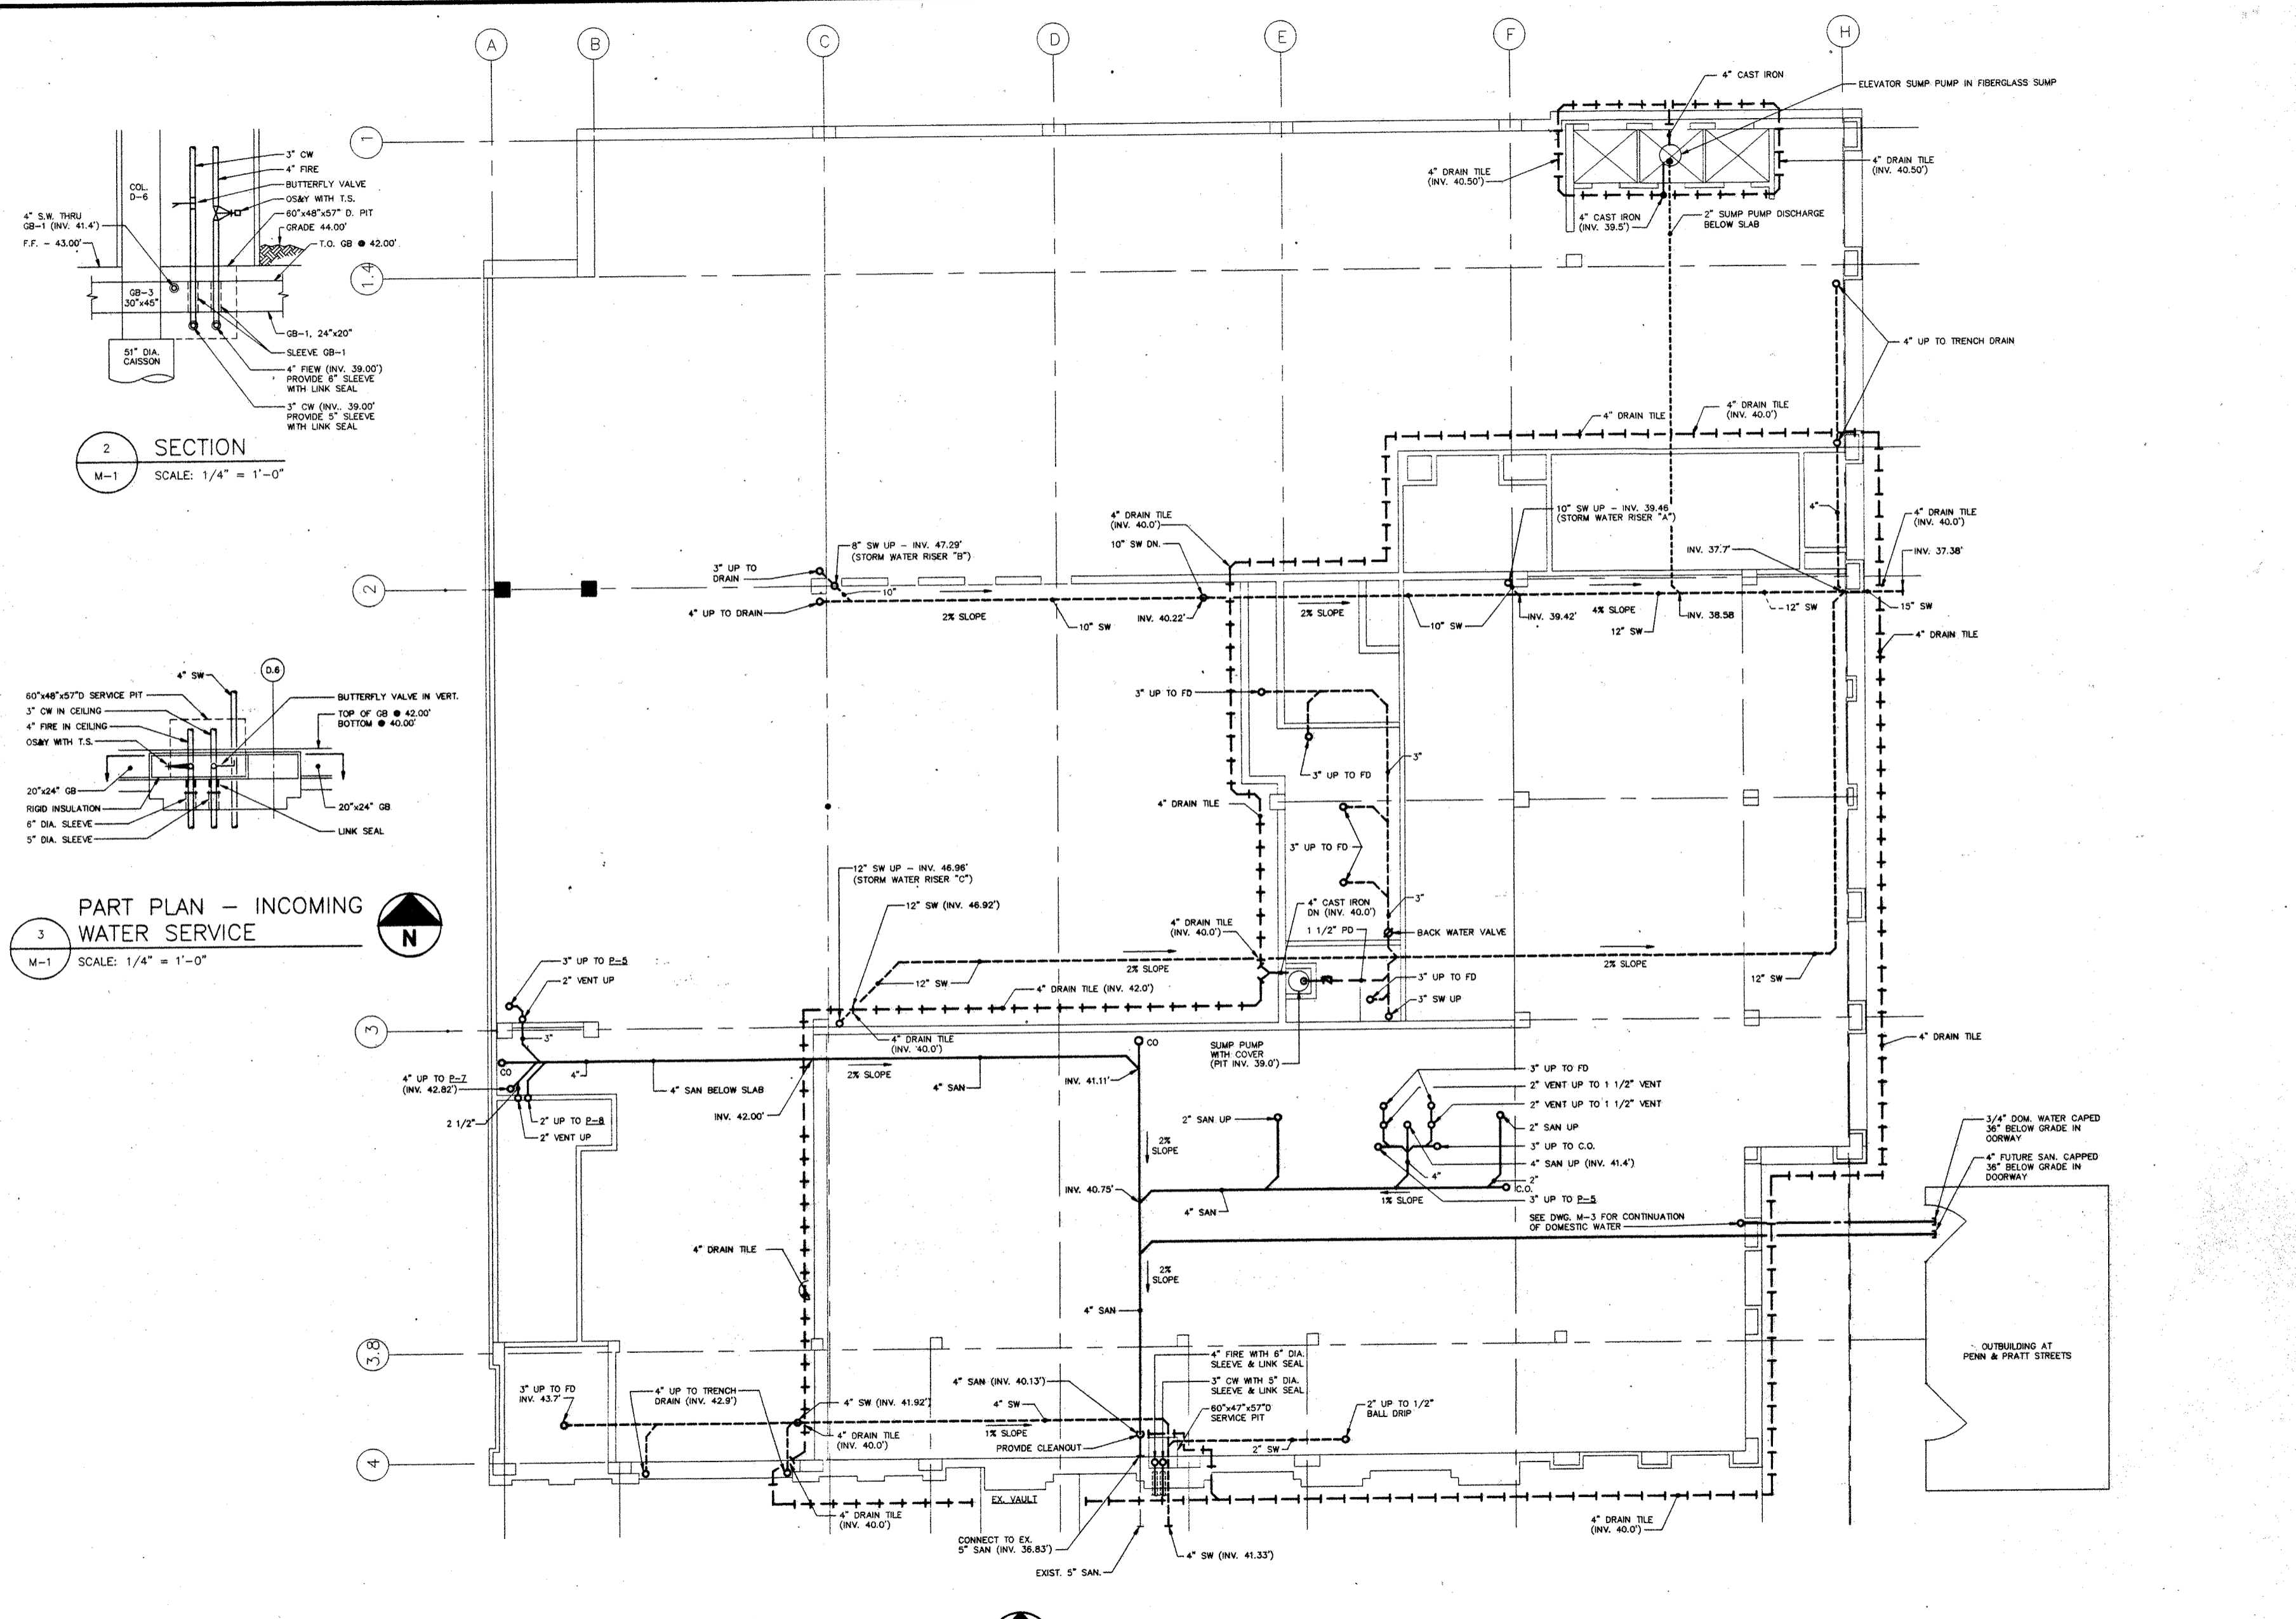


2 SECTION
M-1 SCALE: 1/4" = 1'-0"

3 PART PLAN - INCOMING WATER SERVICE
M-1 SCALE: 1/4" = 1'-0"


1 FOUNDATION FLOOR PLAN
M-1



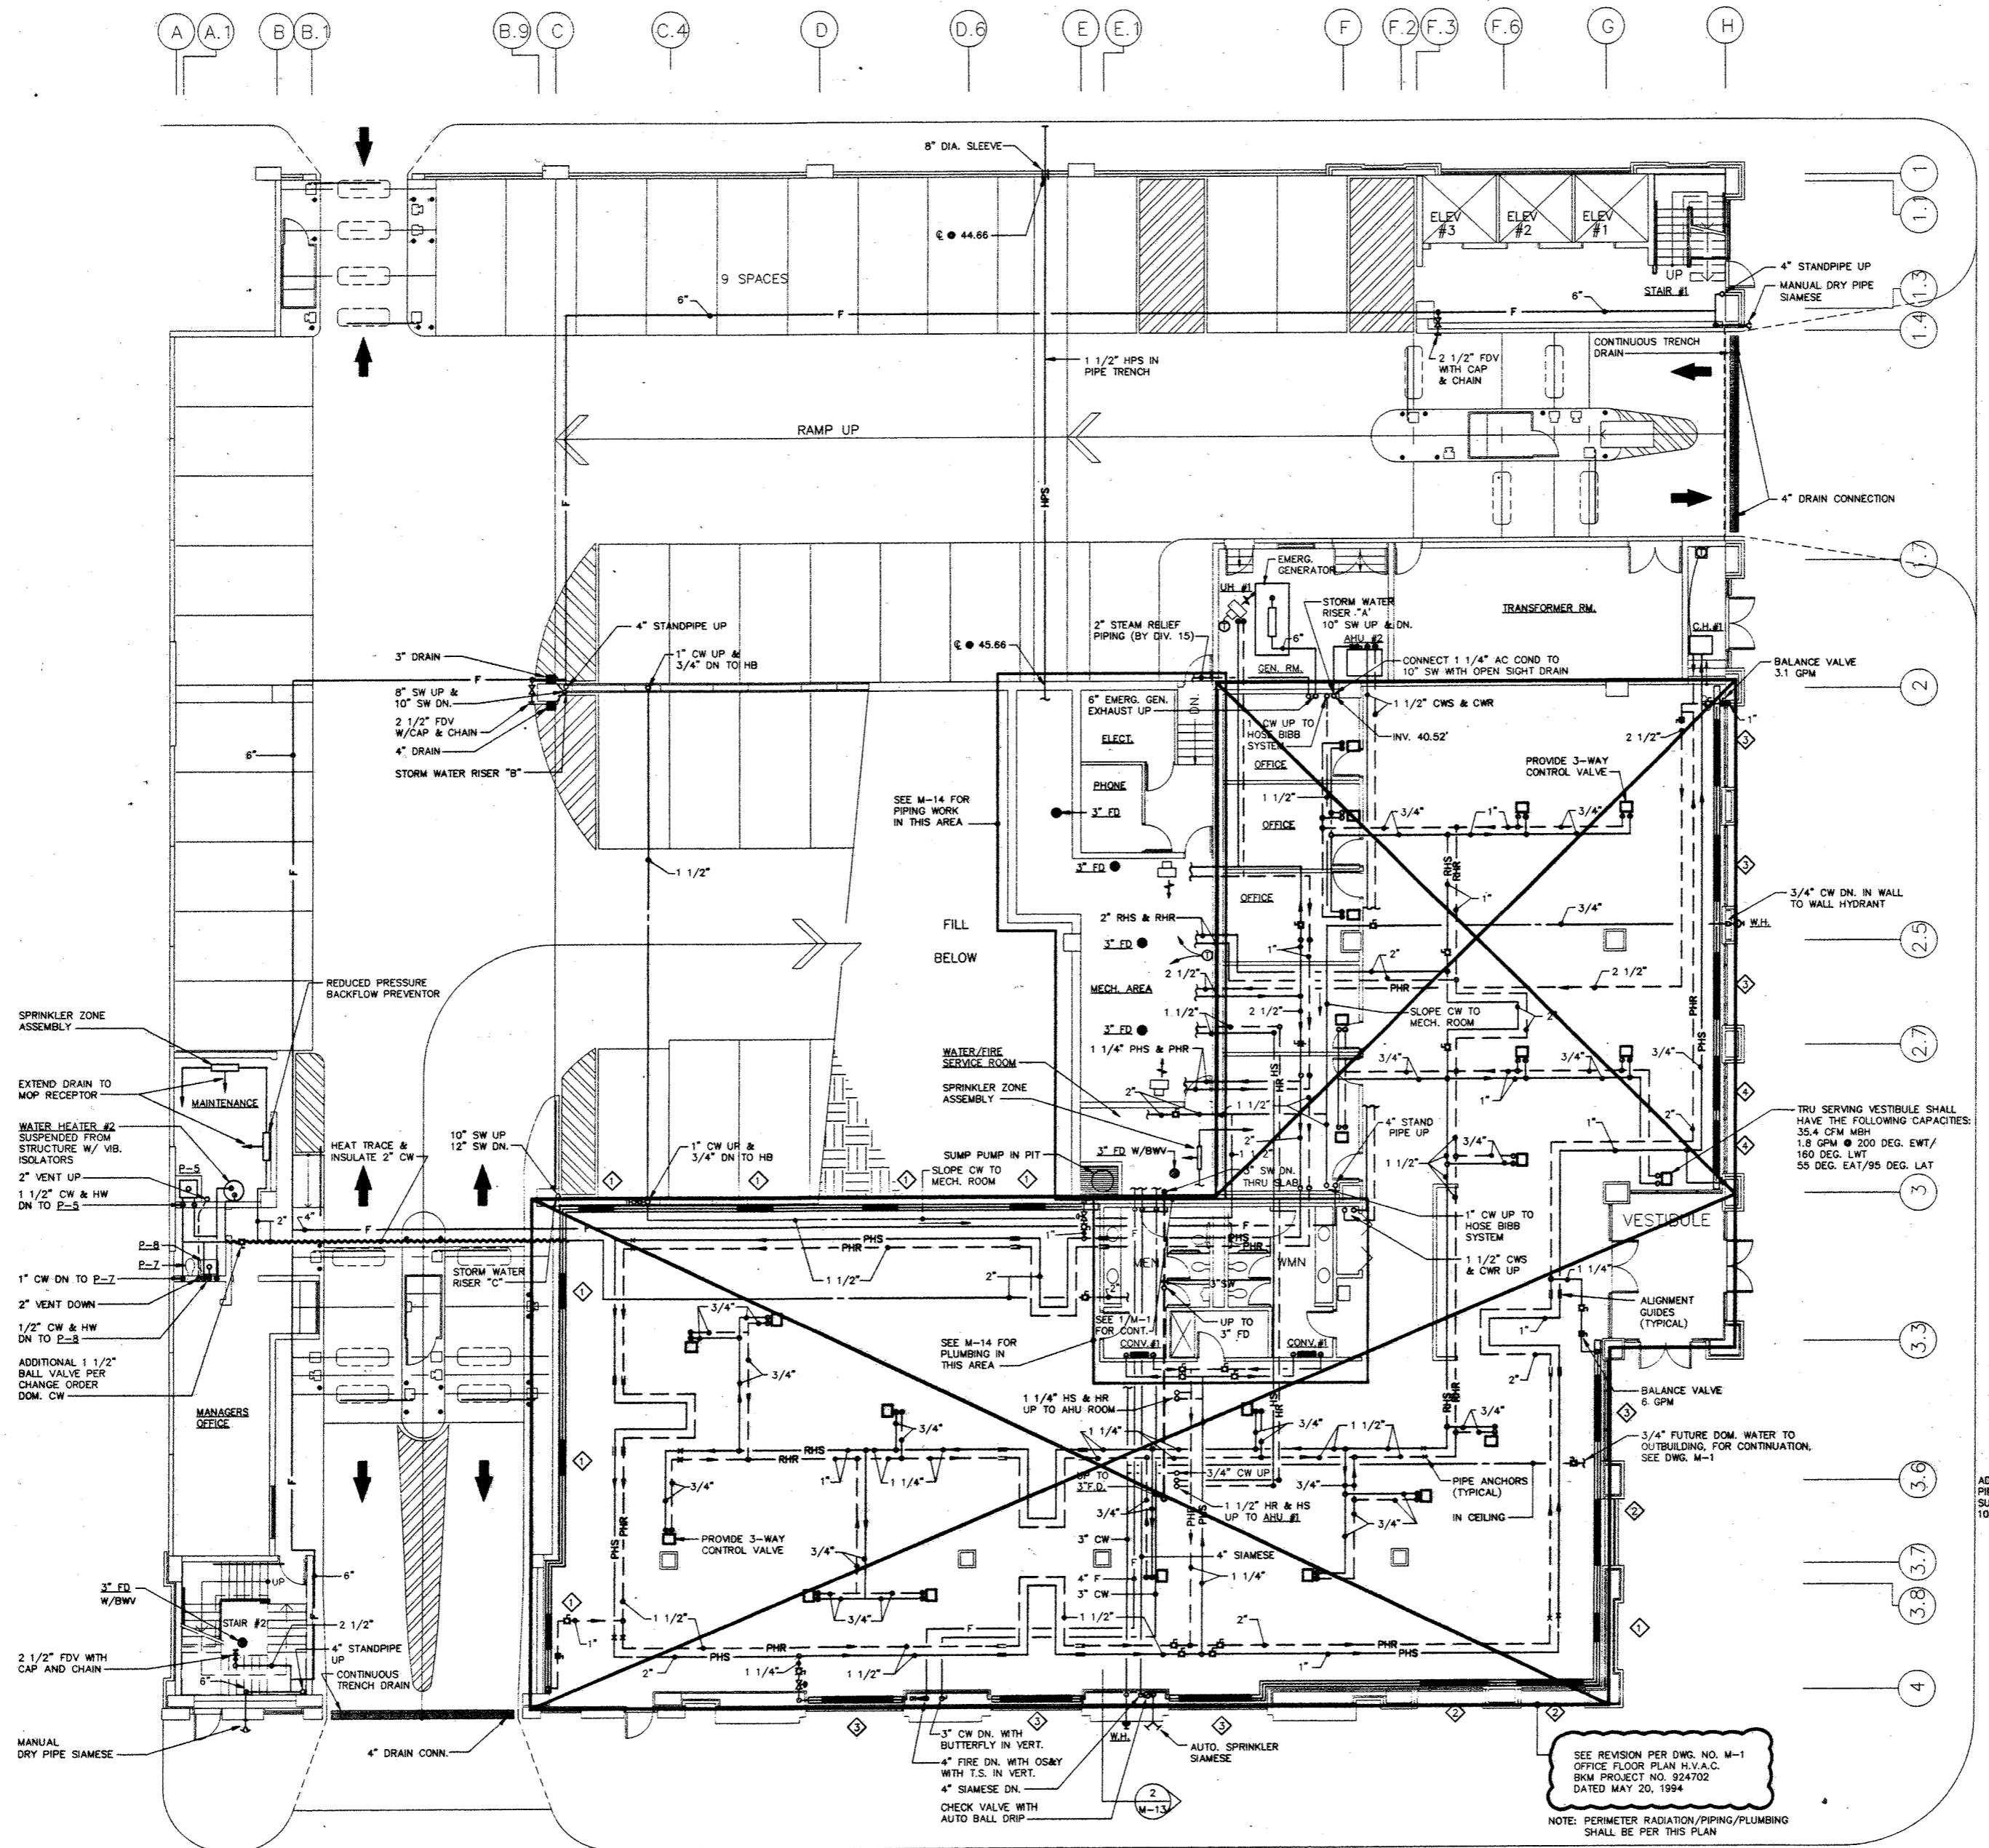

- SPRINKLER ZONE ASSEMBLY
- EXTEND DRAIN TO MOP RECEPTOR
- WATER HEATER #2 SUSPENDED FROM STRUCTURE W/ VIB. ISOLATORS
- 2" VENT UP
- 1 1/2" CW & HW DN TO P-5
- 1" CW DN TO P-7
- 2" VENT DOWN
- 1/2" CW & HW DN TO P-3
- ADDITIONAL 1 1/2" BALL VALVE PER CHANGE ORDER DOM. CW
- MANAGERS OFFICE
- STAIR #2
- 2 1/2" FDV WITH CAP AND CHAIN
- MANUAL DRY PIPE SIAMASE

PIPING, CONDUIT, INSULATION, PIPE SUPPORTS, & SLEEVE (WITH LINK SEAL) ARE PROVIDED BY BALTIMORE THERMAL

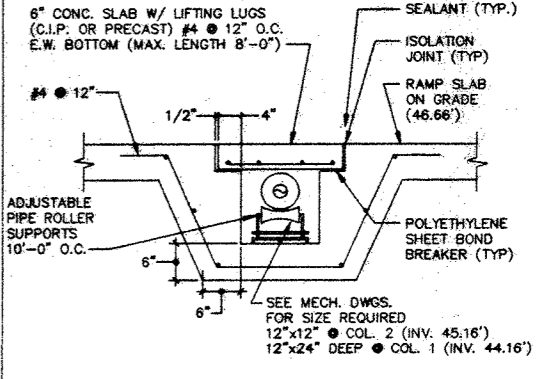

SECTION 11
SCALE: 3/4" = 1'-0"
S-10

PROVIDE 8" DIA. SLEEVE THRU WALL AT COLUMN 1 (INV. 44.49)

SEE REVISION PER DWG. NO. M-1 OFFICE FLOOR PLAN H.V.A.C. BKM PROJECT NO. 924702 DATED MAY 20, 1994
NOTE: PERIMETER RADIATION/PIPING/PLUMBING SHALL BE PER THIS PLAN

1 GRADE FLOOR PLAN - PIPING
M-3 SCALE: 1/8" = 1'-0"



WHITING-TURNER
CONTRACTING COMPANY
DESMAN ASSOCIATES
ARCHITECTS ENGINEERS


PENN STREET PARKING FACILITY
UNIVERSITY OF MARYLAND AT BALTIMORE


NO.	DATE	BY
8-28-93		
7-13-93		

GRADE FLOOR PLAN PIPING
DRAWING NO. M-3

SCALE: 1/8" = 1'-0"
DATE: 8-24-1993
PROJECT NO. J-343
DESIGN DRAWN CHKD.

APRIL 3, 1995 AS-BUILTS

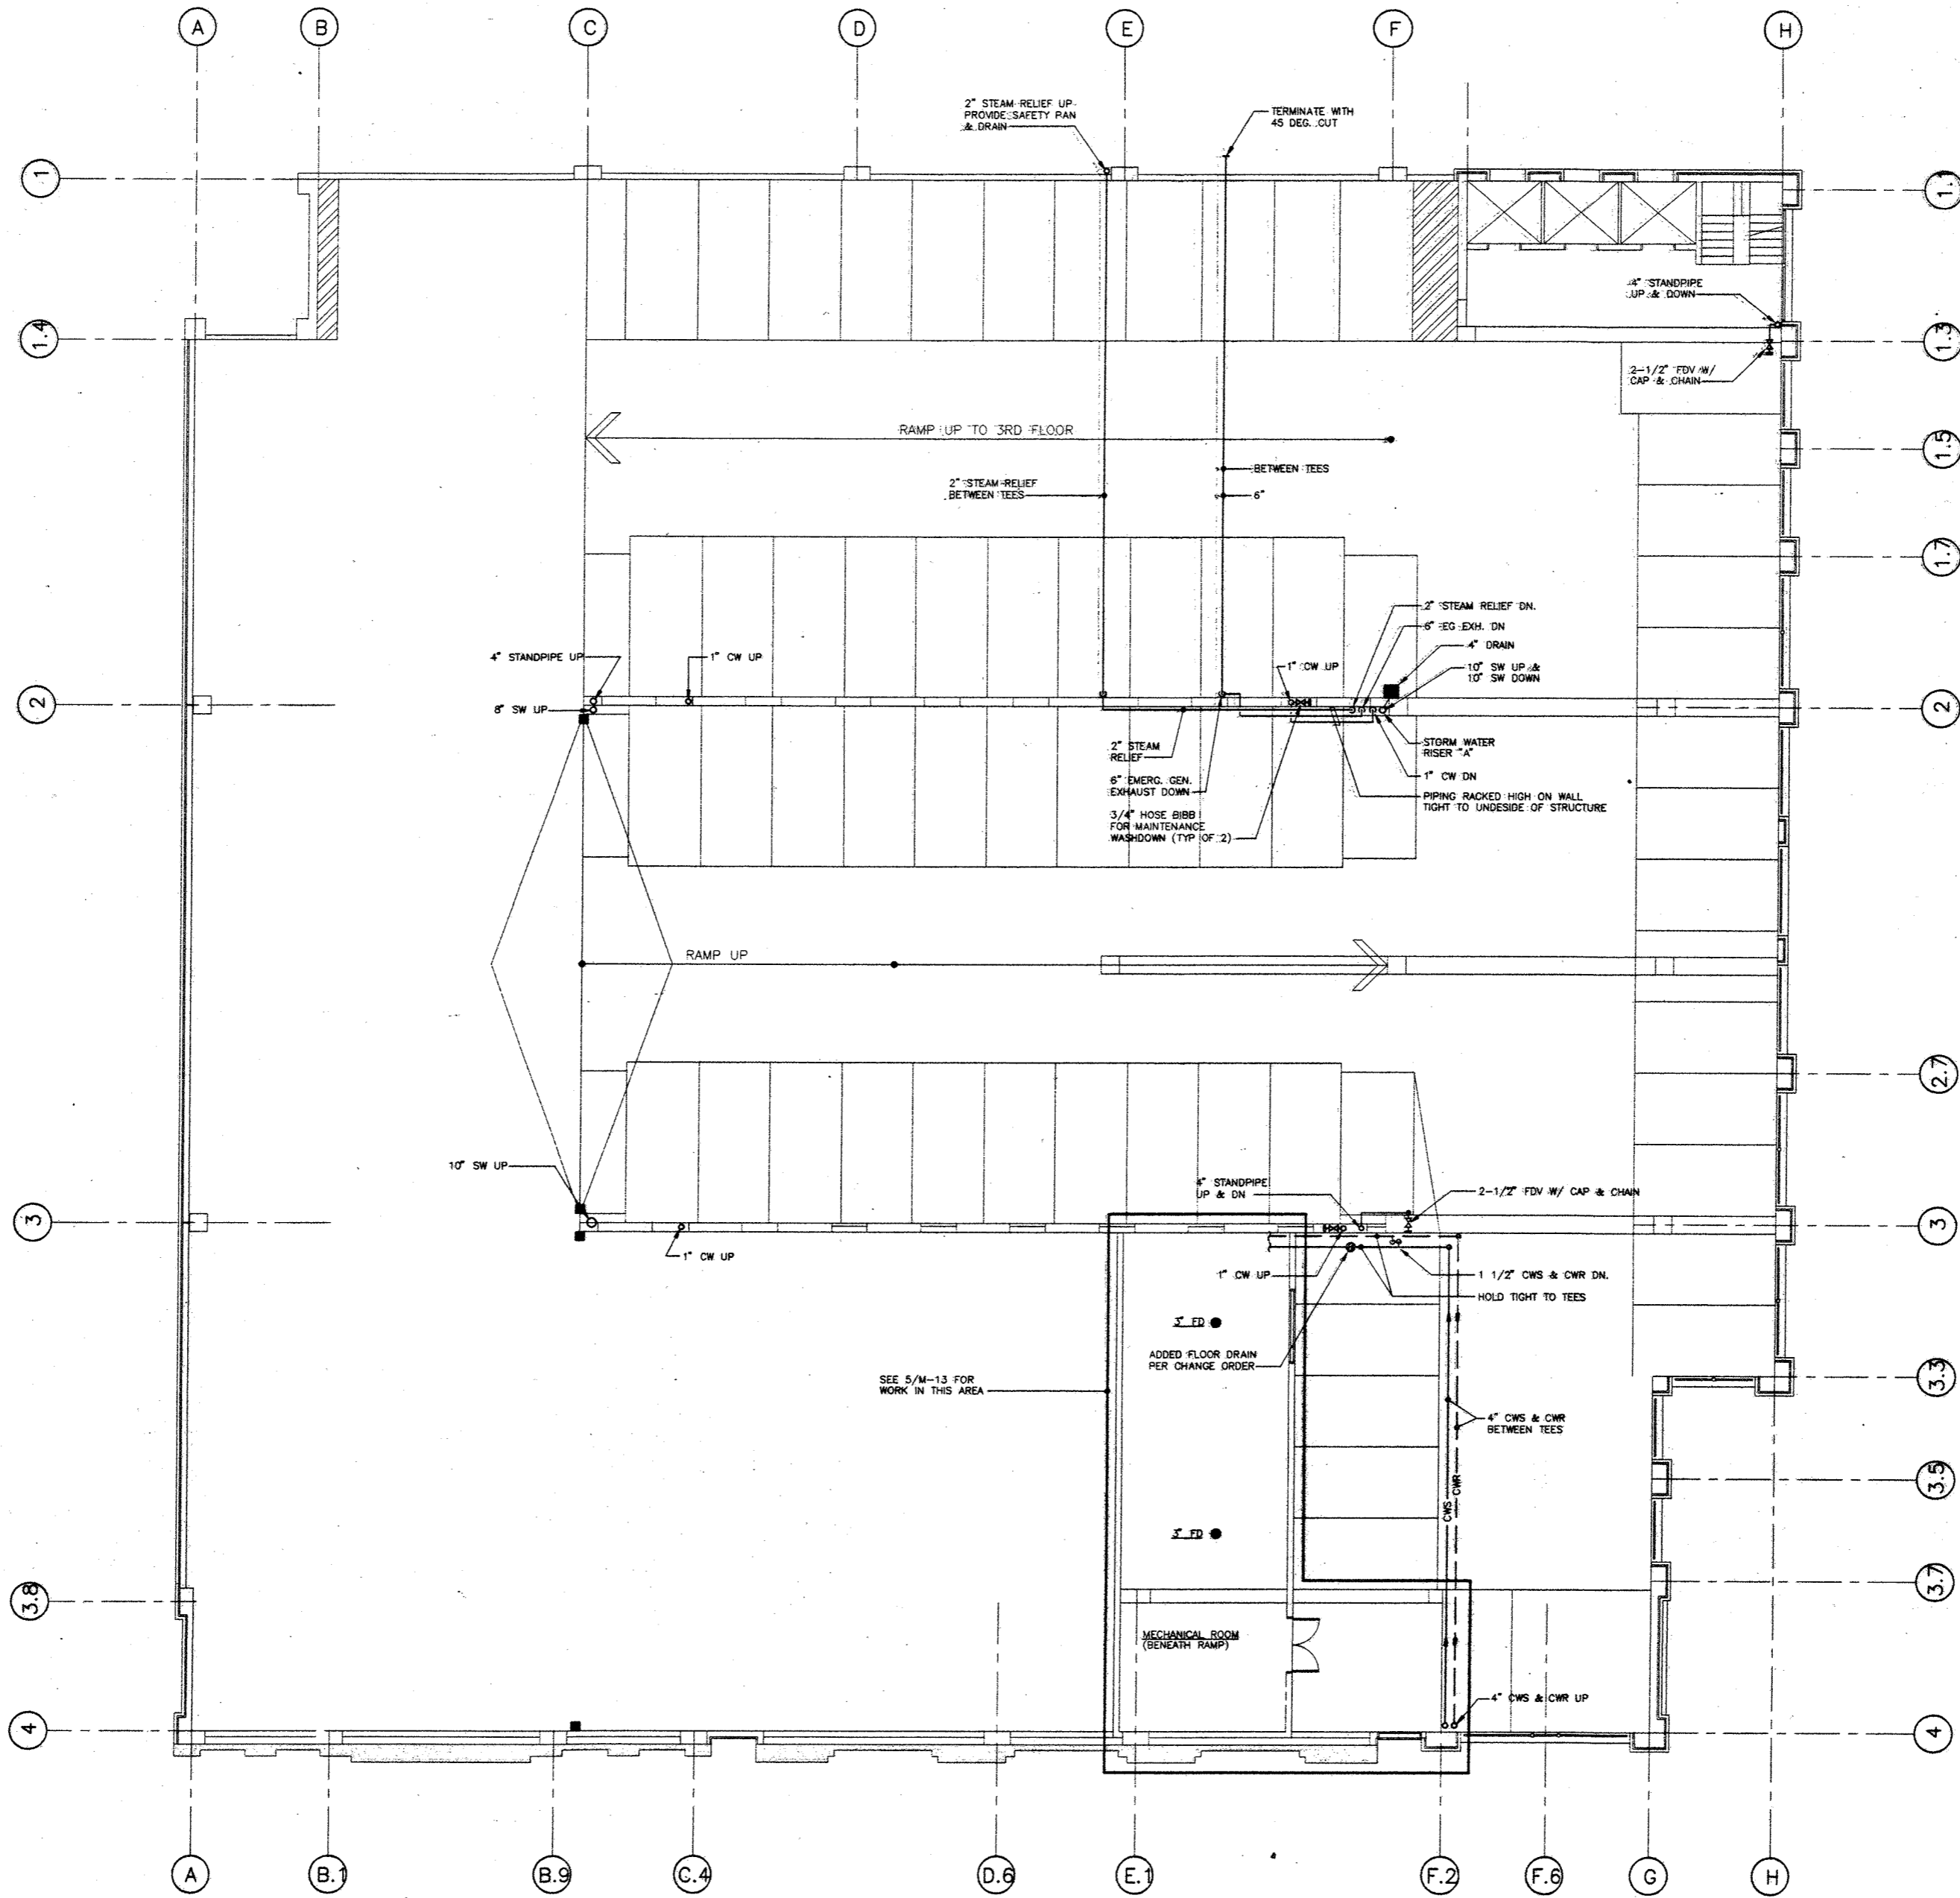

1 SECOND FLOOR PLAN - PIPING
 M-4 SCALE: 1/8" = 1'-0" 


WHITING-TURNER
 CONTRACTING COMPANY
 DESMAN ASSOCIATES
 ARCHITECTS ENGINEERS

BURDETTE KOEHLER MURPHY &
 ASSOCIATES, INC.
 CONSULTING ENGINEERS
 1000 PENNSYLVANIA AVENUE, N.W.
 WASHINGTON, D.C. 20004

PENN STREET PARKING FACILITY
 UNIVERSITY OF MARYLAND AT BALTIMORE

NO.	DATE	BY
REVISIONS		
SECOND FLOOR PLAN PIPING		
DRAWING NO. M-4		
SCALE: 1/8" = 1'-0"		
DATE: 5-13-93		
PROJECT NO. J-343		
DESIGN	DRAWN	CHKD.

APRIL 3, 1995 AS-BUILTS

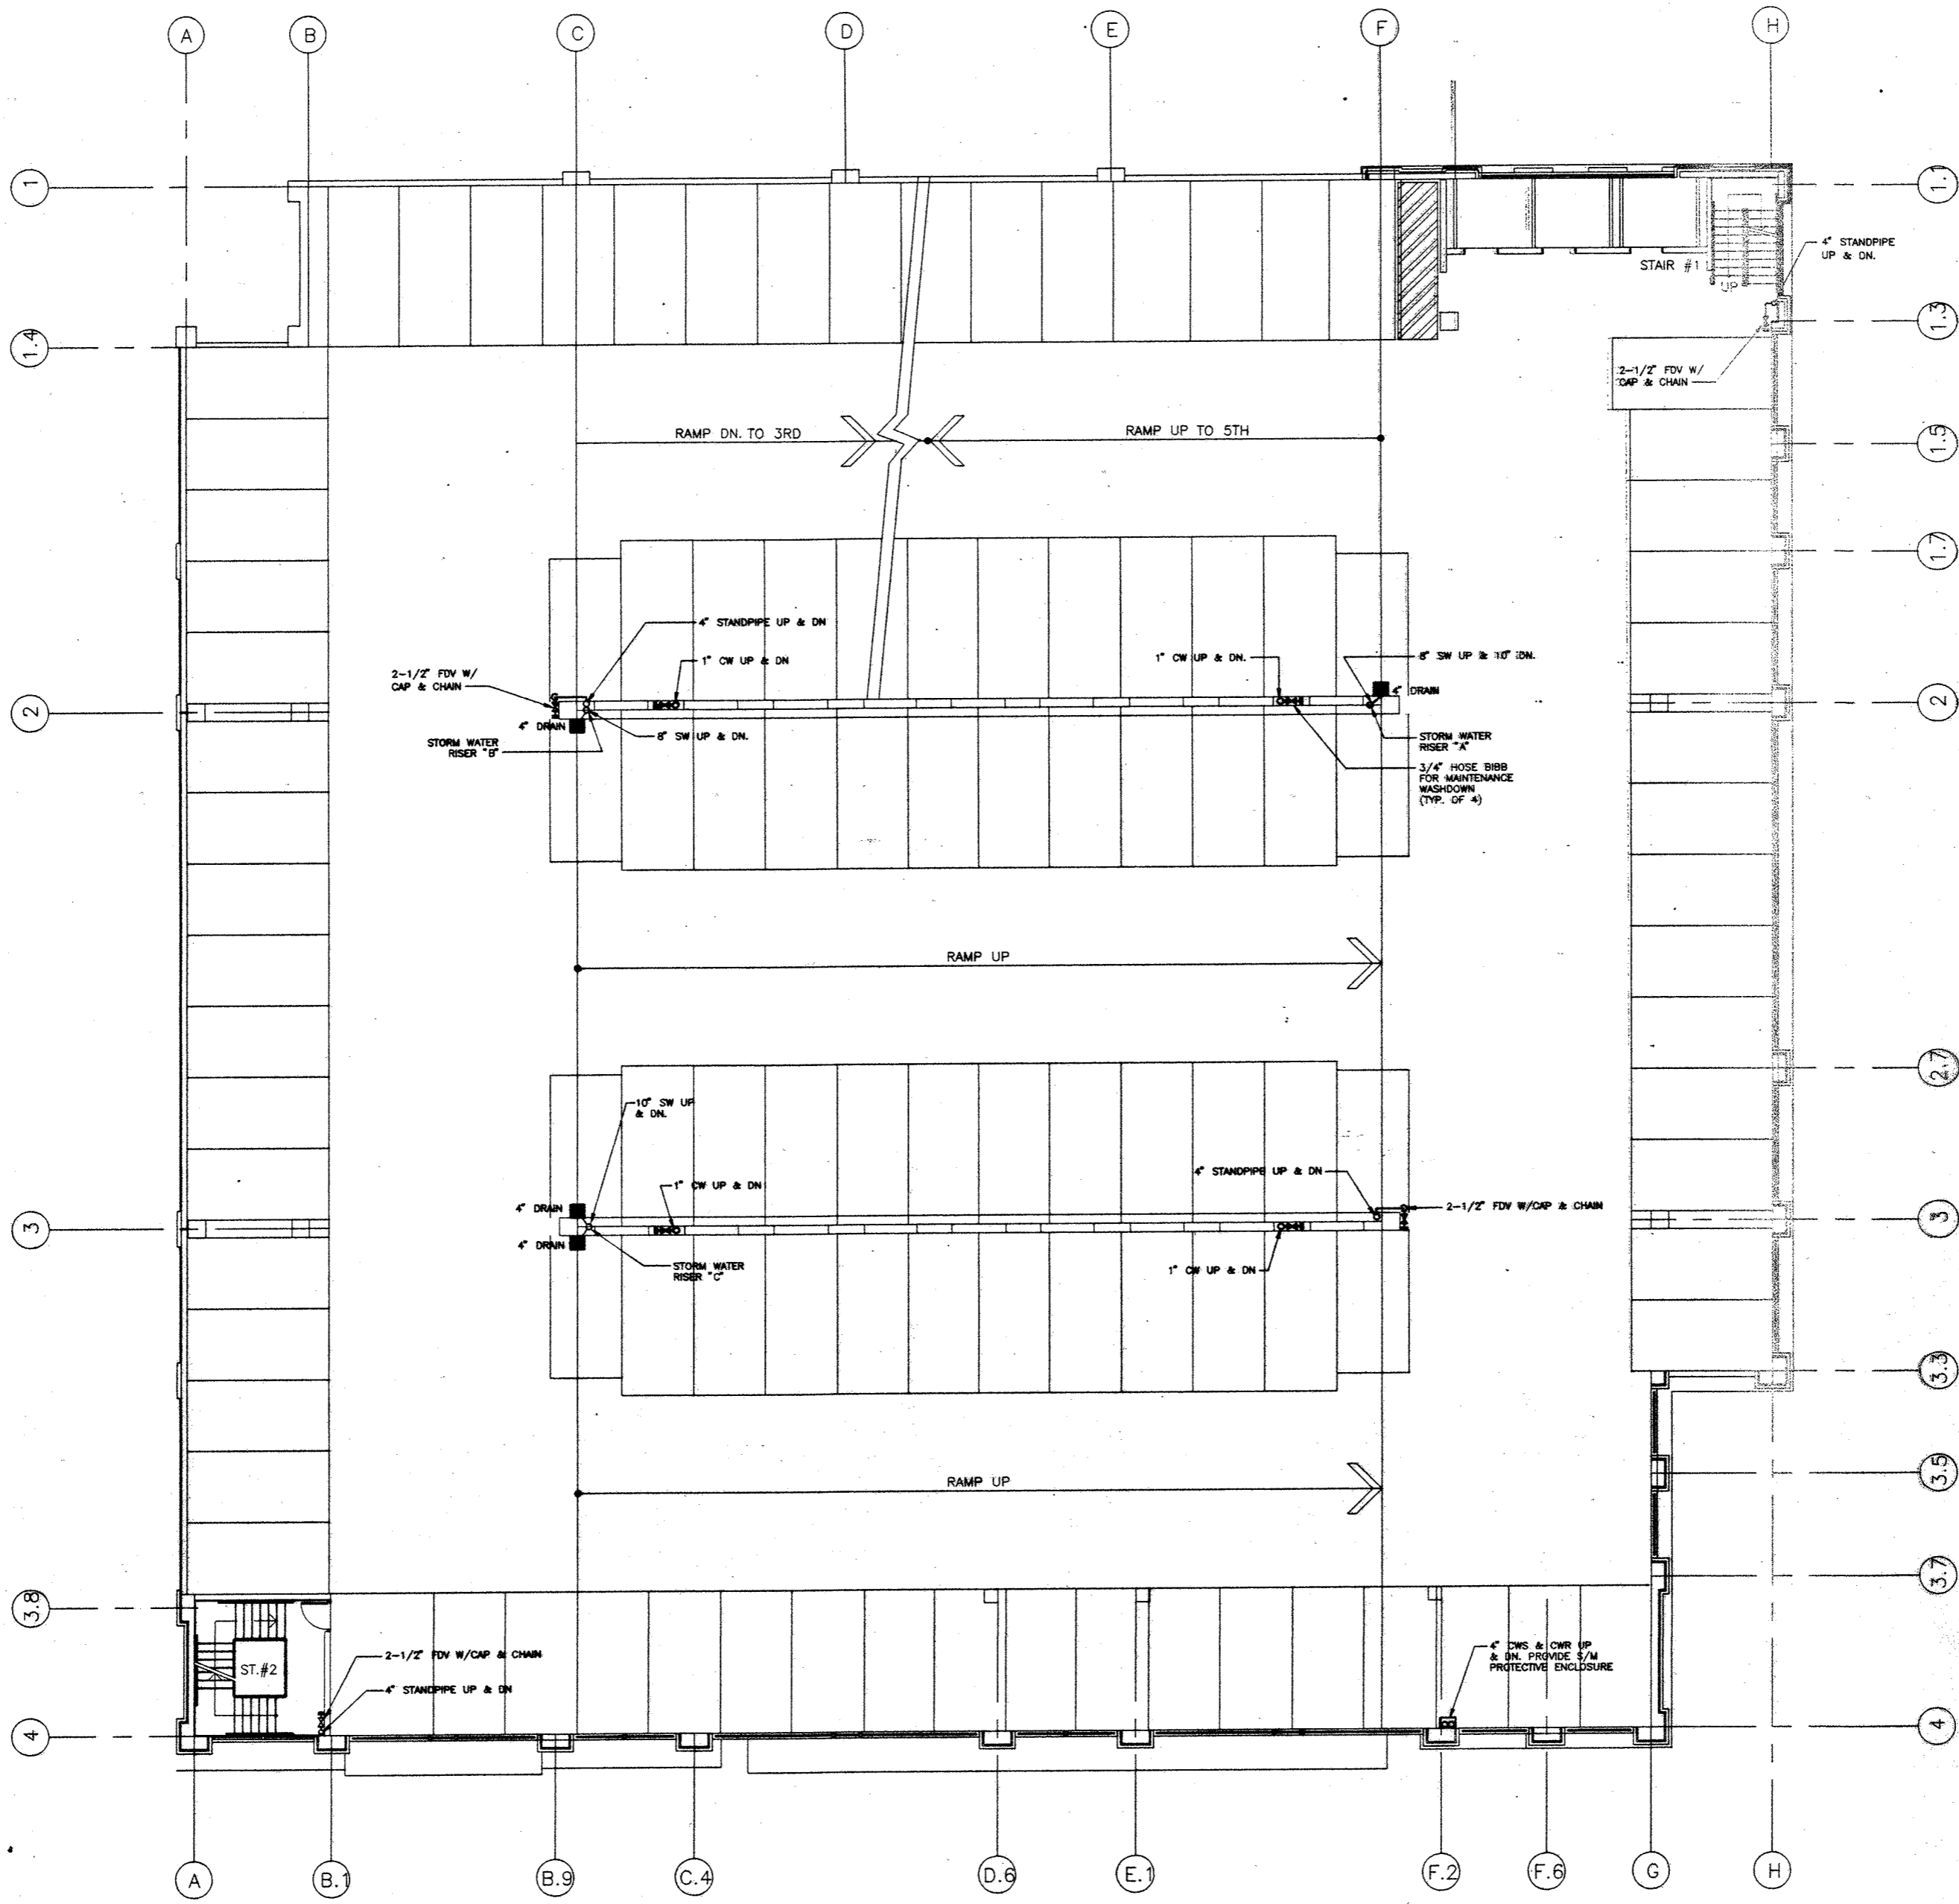

1 FOURTH FLOOR PLAN - PIPING
M-6




WHITING-TURNER
CONTRACTING COMPANY
DESIGN ASSOCIATES
ARCHITECTS ENGINEERS

BURDETTE, KOEHLER, MURPHY &
ASSOCIATES, INC.
CONTRACTING ENGINEERS
100 N. WASHINGTON ST. BALTIMORE, MD 21201-2000

PENN STREET PARKING FACILITY
UNIVERSITY OF MARYLAND AT BALTIMORE

NO.	DATE	BY
REVISIONS		
FOURTH FLOOR PLAN PIPING		
DRAWING NO. M-6		
SCALE: 1/8"=1'-0"		
DATE: 6-24-93		
PROJECT NO. J-343		
DESIGN	DRAWN	CHECKED
GEJ	DAT	MKA

APRIL 3, 1995 AS-BUILTS

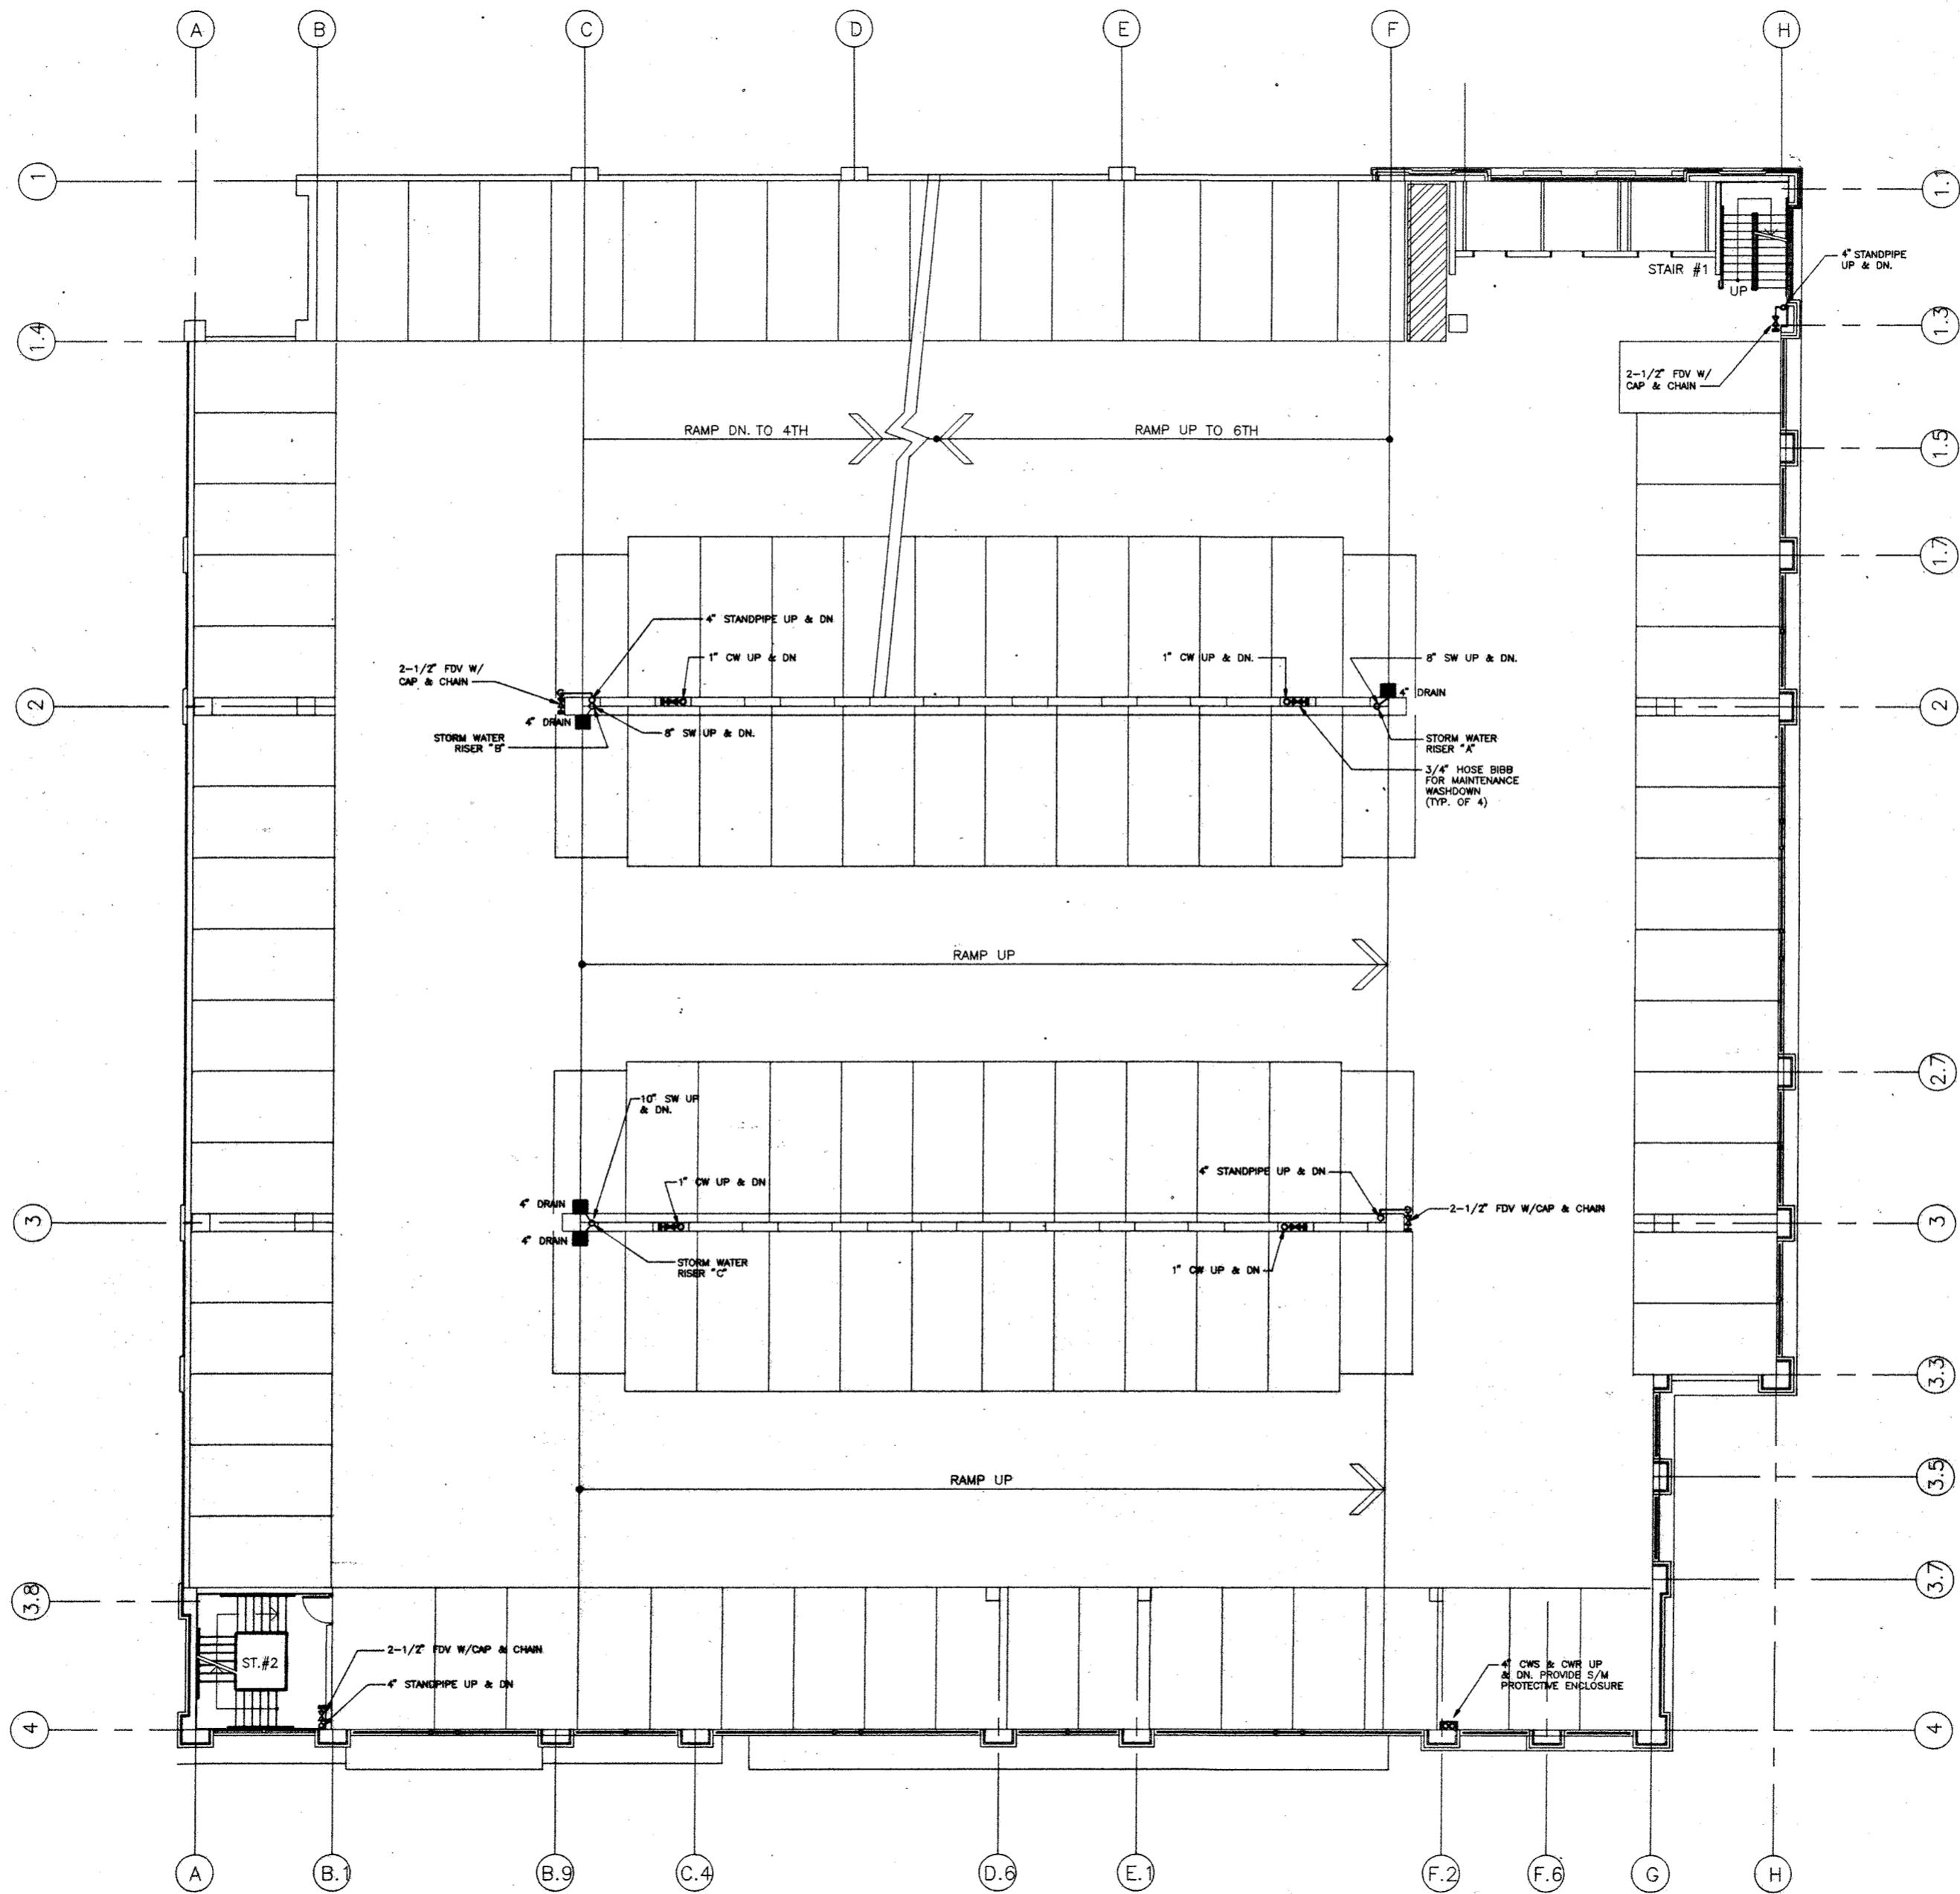

1 FIFTH FLOOR PLAN - PIPING
M-7




WHITING-TURNER
CONTRACTING COMPANY
DESIGN ASSOCIATES
ARCHITECTS ENGINEERS

BURDETTE KOEHLER MURPHY &
ASSOCIATES, INC.
CONSULTING ENGINEERS
2200 WASHINGTON BLVD., SUITE 200
WASHINGTON, D.C. 20037

PENN STREET PARKING FACILITY
UNIVERSITY OF MARYLAND AT BALTIMORE

NO.	DATE	BY
REVISIONS		
FIFTH FLOOR PLAN PIPING		
DRAWING NO. M-7		
SCALE:	1/8" = 1'-0"	
DATE:	6-24-93	
PROJECT NO.:	J-343	
DESIGN:	DRAWN:	CHECKED:
GEJ	DAT	MKA

APRIL 3, 1995 AS-BUILTS

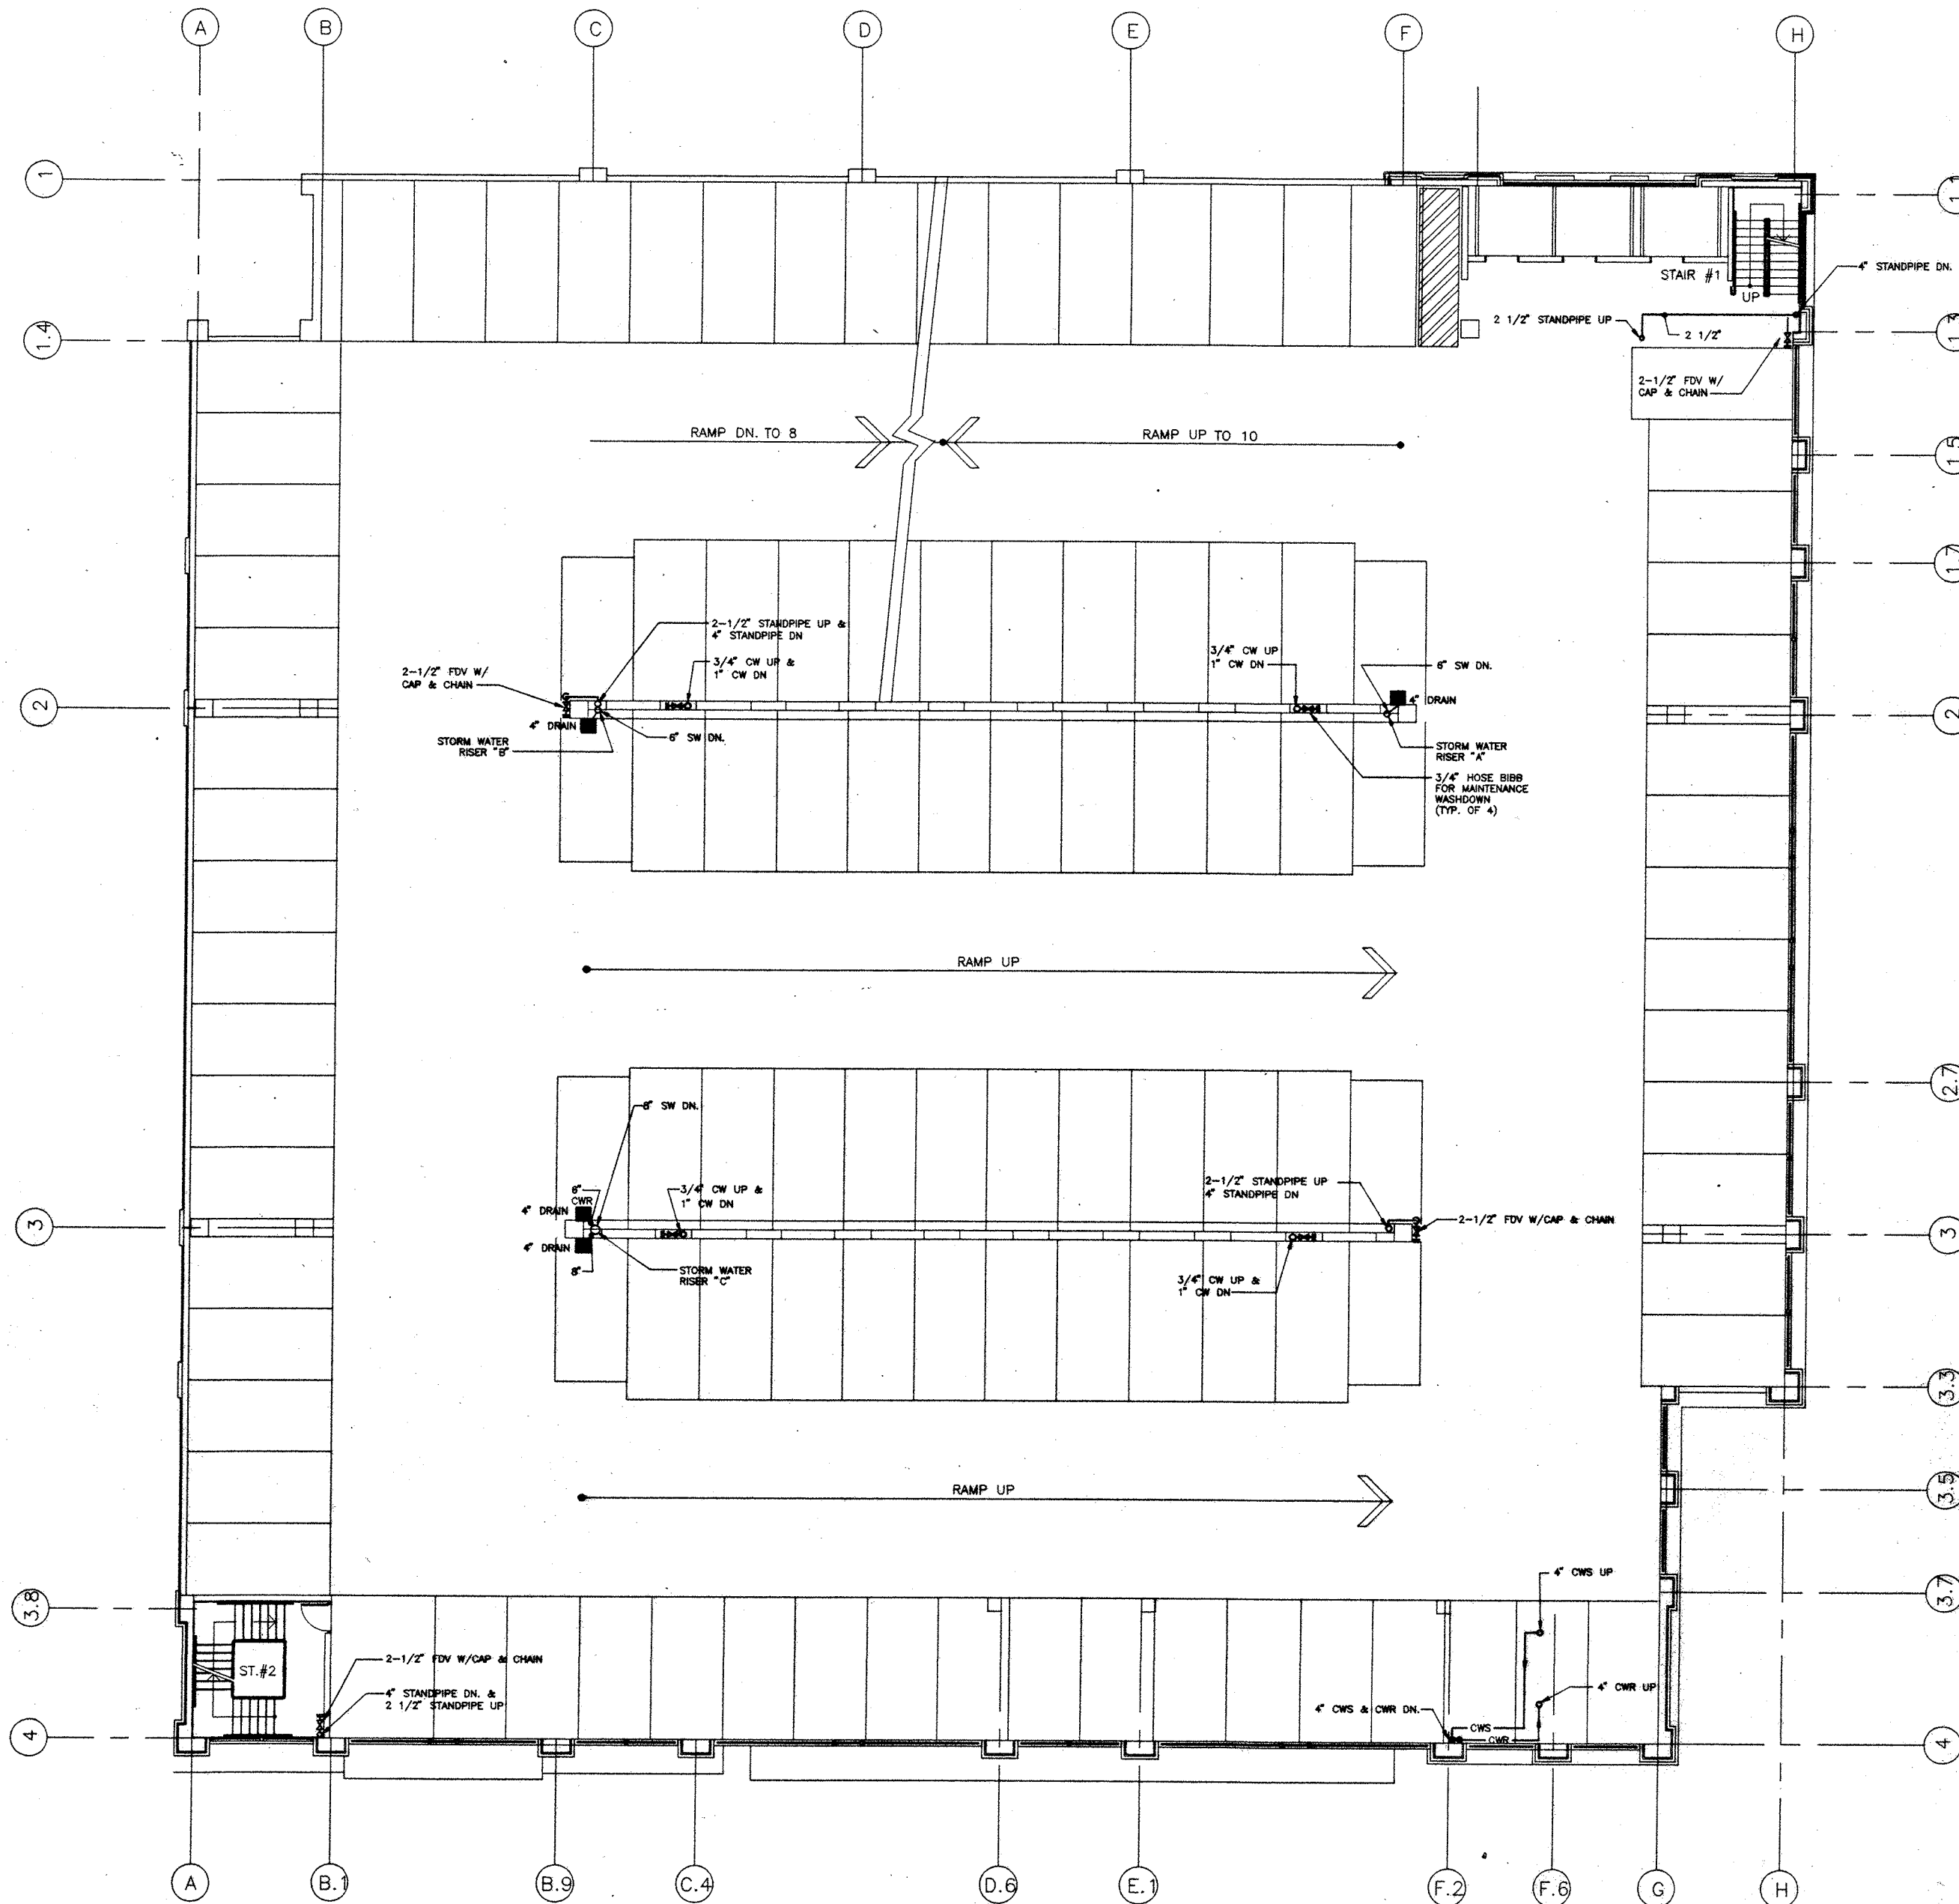

1 NINTH FLOOR PLAN - PIPING
M-11



WHITING-TURNER
CONTRACTING COMPANY
DESIGN ASSOCIATES
ARCHITECTS ENGINEERS




BURDETTE KOEHLER MURPHY &
ASSOCIATES, INC.
CONSULTING ENGINEERS
1000 PENNSYLVANIA AVENUE, N.W.
WASHINGTON, D.C. 20004


PENN STREET PARKING FACILITY
UNIVERSITY OF MARYLAND AT BALTIMORE

NO.	DATE	BY
REVISIONS		
NINTH FLOOR PLAN PIPING		
DRAWING NO. M-11		
SCALE: 1/8"=1'-0"		
DATE: 6-24-93		
PROJECT NO. J-343		
DESIGN	DRAWN	CHKD.
GEJ	DAT	MKA


APRIL 3, 1995 AS-BUILTS

3543-1

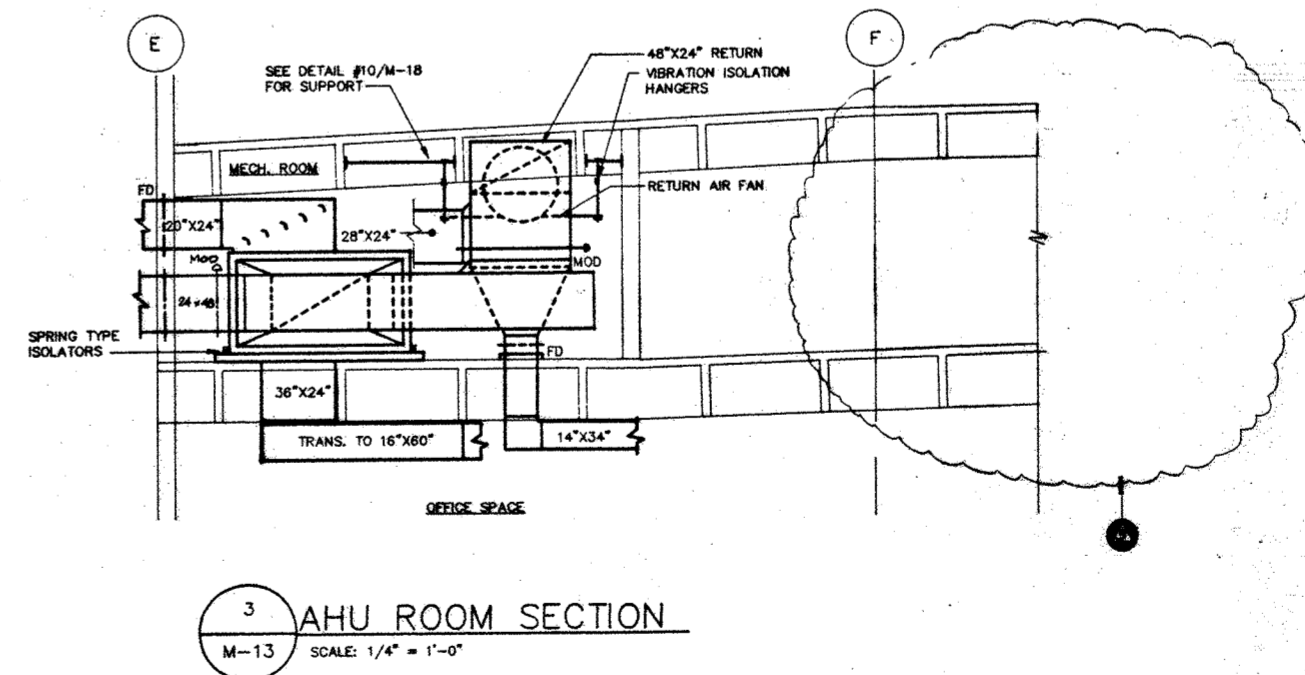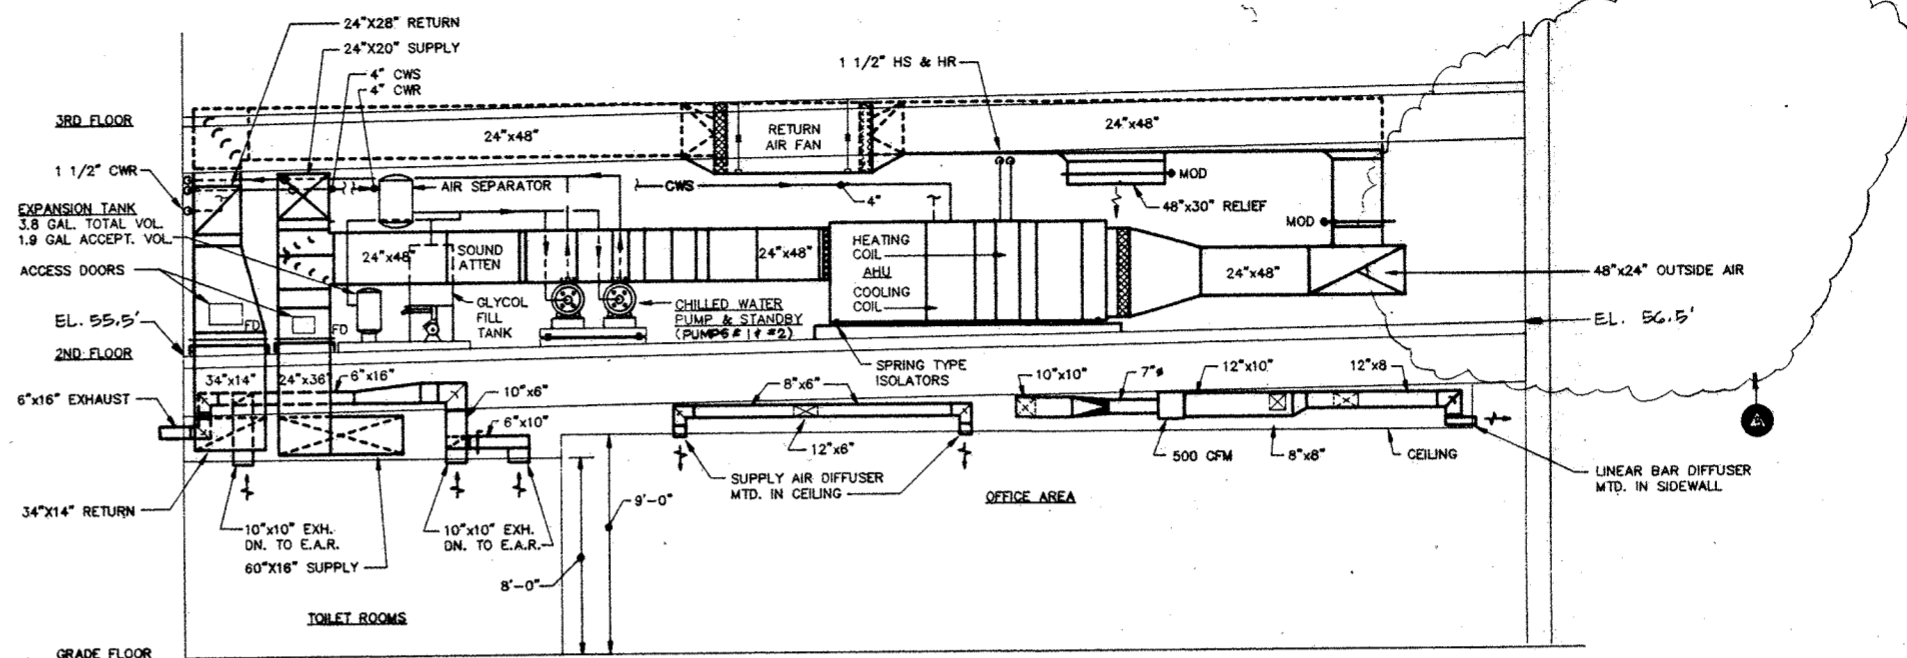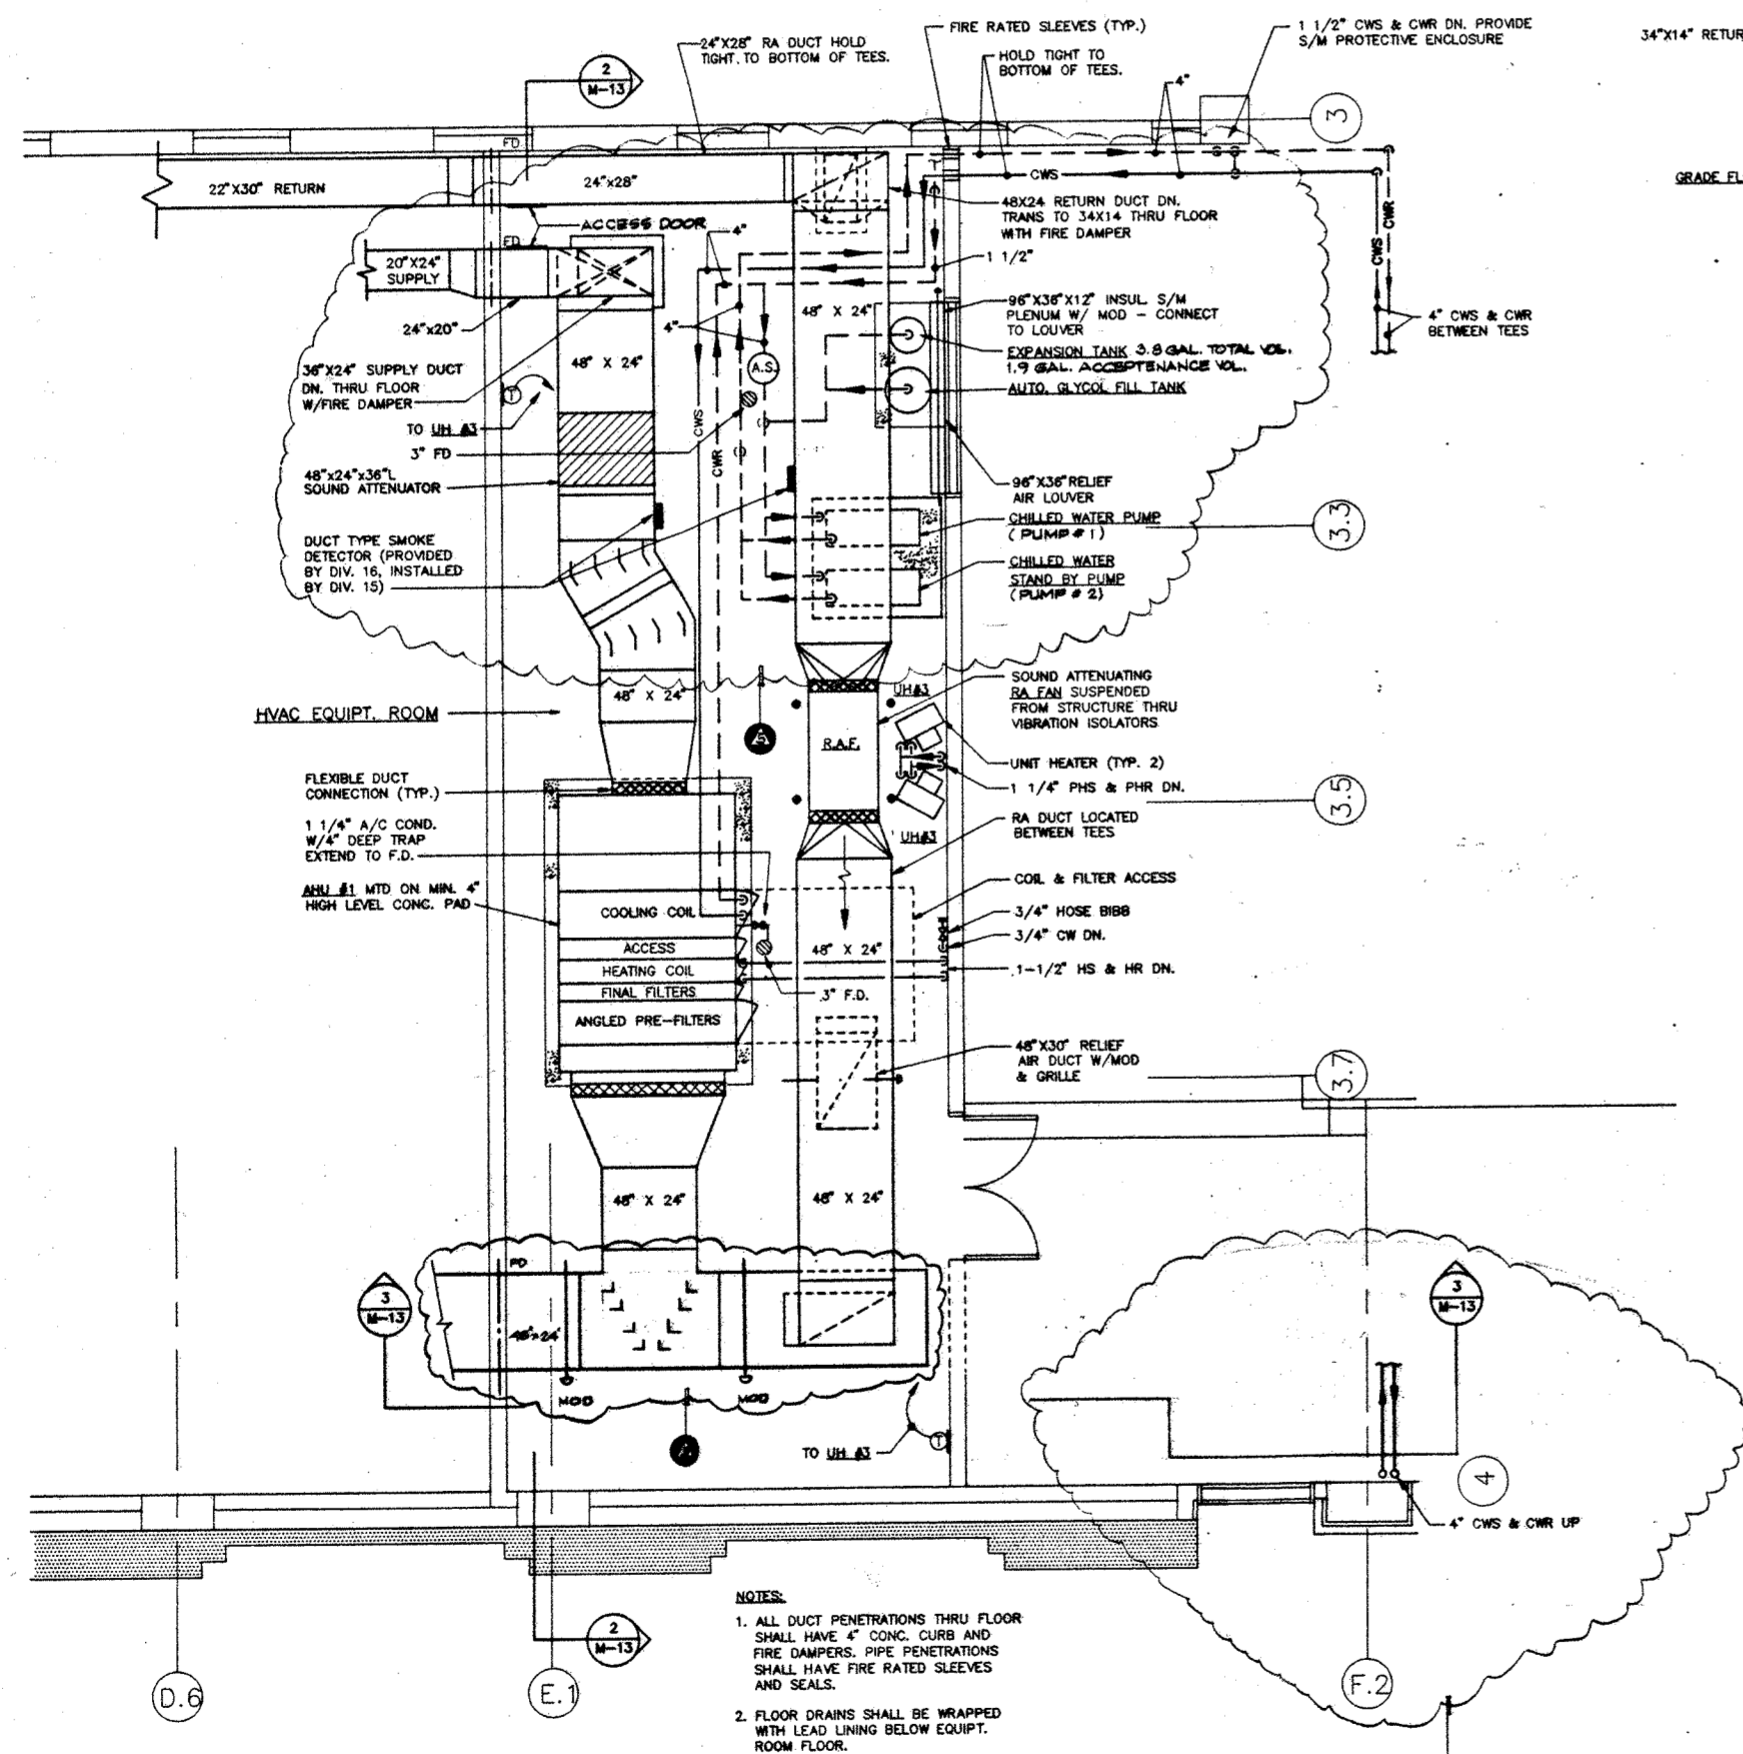


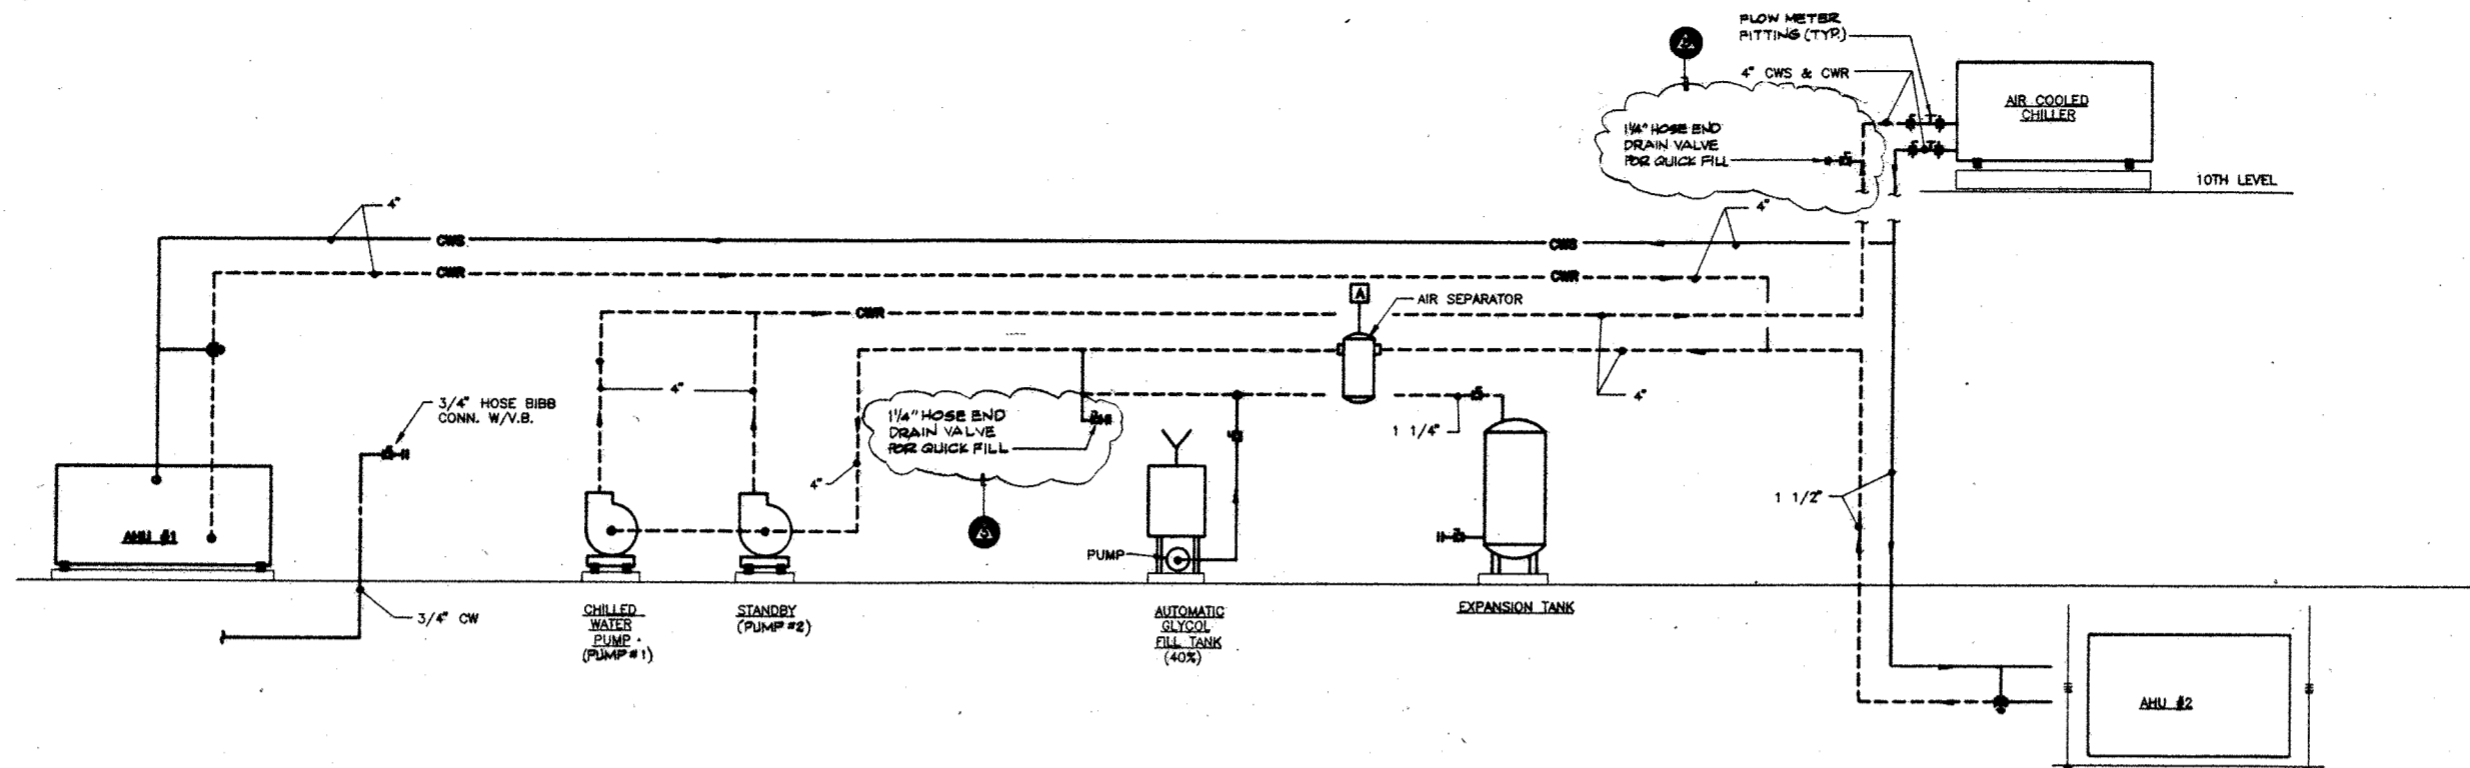

1 CHILLED WATER SYSTEM PIPING SCHEMATIC
M-16 NO SCALE

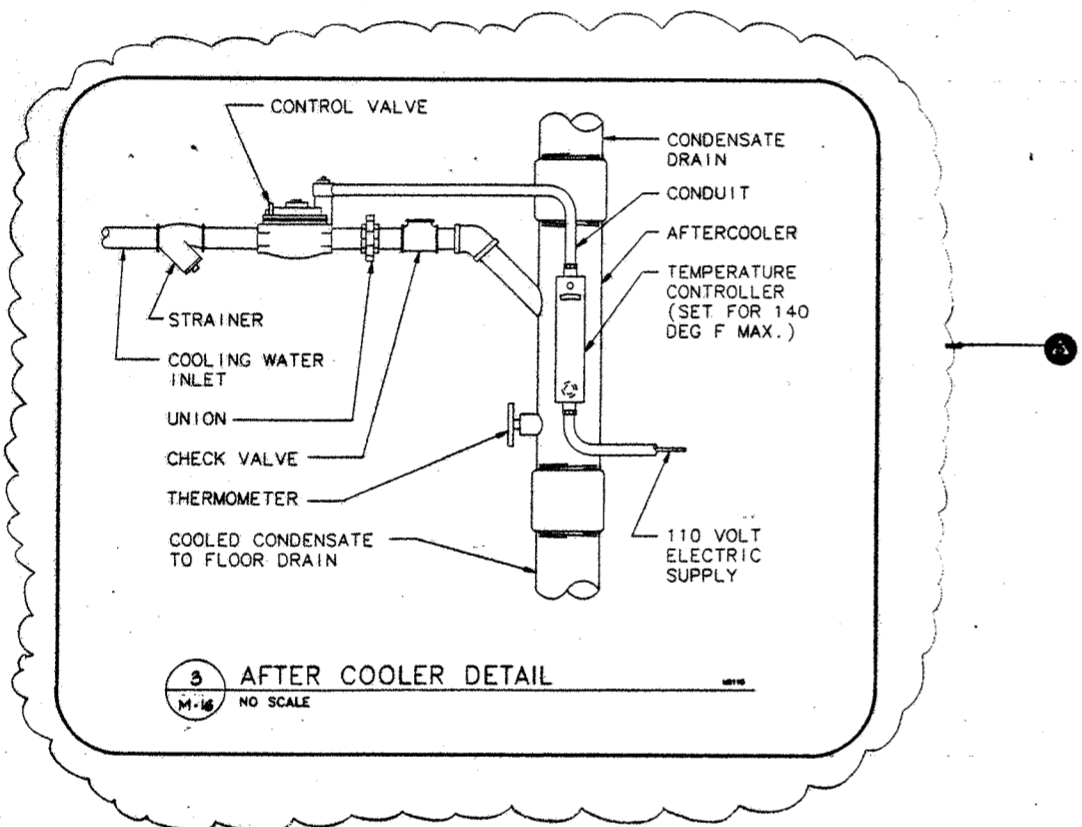

3 AFTER COOLER DETAIL
M-16 NO SCALE

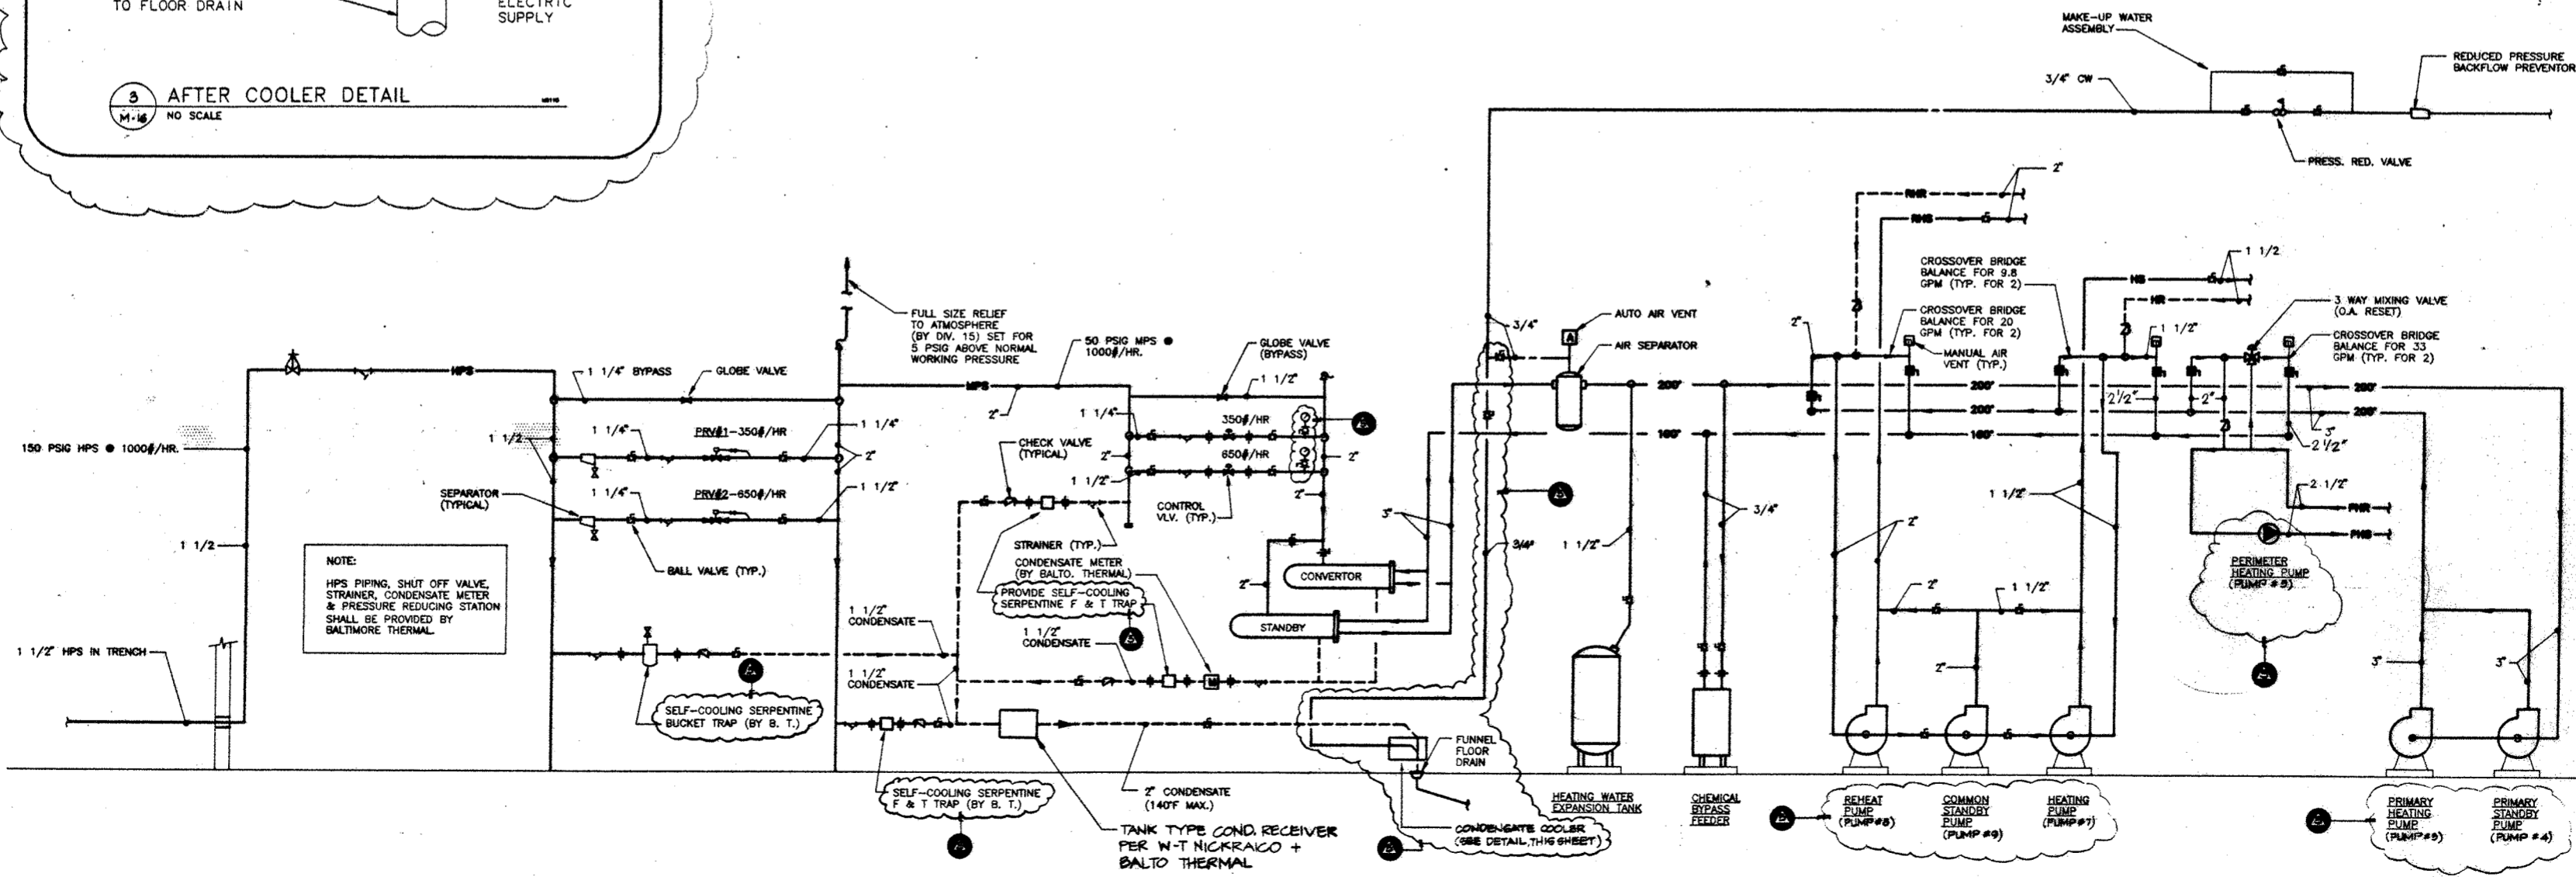

2 HEATING SYSTEM PIPING SCHEMATIC
M-16 NO SCALE

WHITING-TURNER
CONTRACTING COMPANY
DESIGN ASSOCIATES
ARCHITECTS ENGINEERS

BURDETTE KOEHLER MURPHY &
ASSOCIATES, INC.
CONSTRUCTION MANAGER
1000 W. BALTIMORE ST. BALTIMORE, MD 21201
TEL: 527-1100

PENN STREET PARKING FACILITY
UNIVERSITY OF MARYLAND AT BALTIMORE













NO.	DATE	BY

PIPING SCHEMATICS

DRAWING NO.
M-16

SCALE: NONE
DATE: 6-24-93
PROJECT NO. J-343
DESIGN DRAWN CHKD.

APRIL 3, 1995 AS-BUILTS

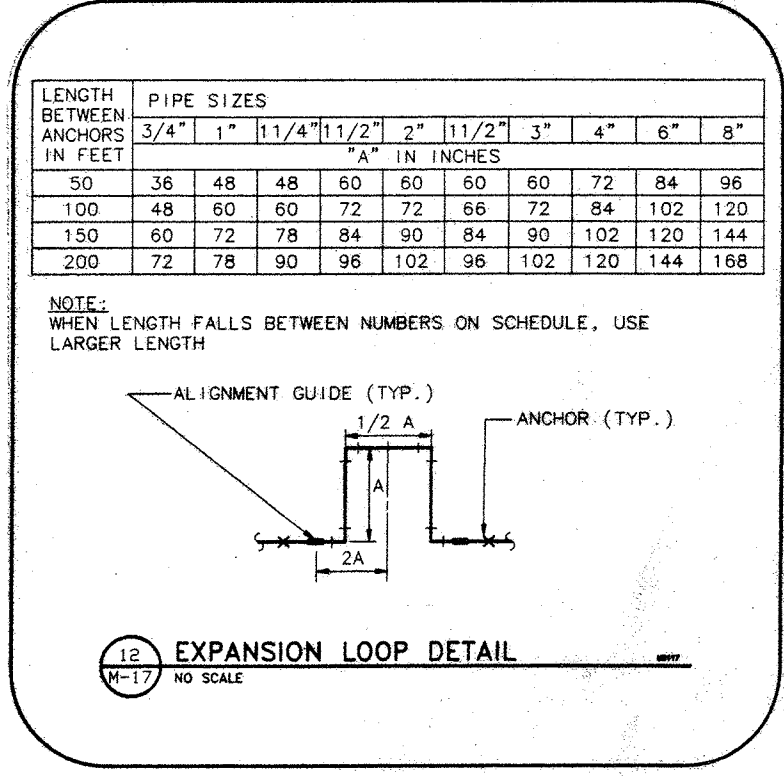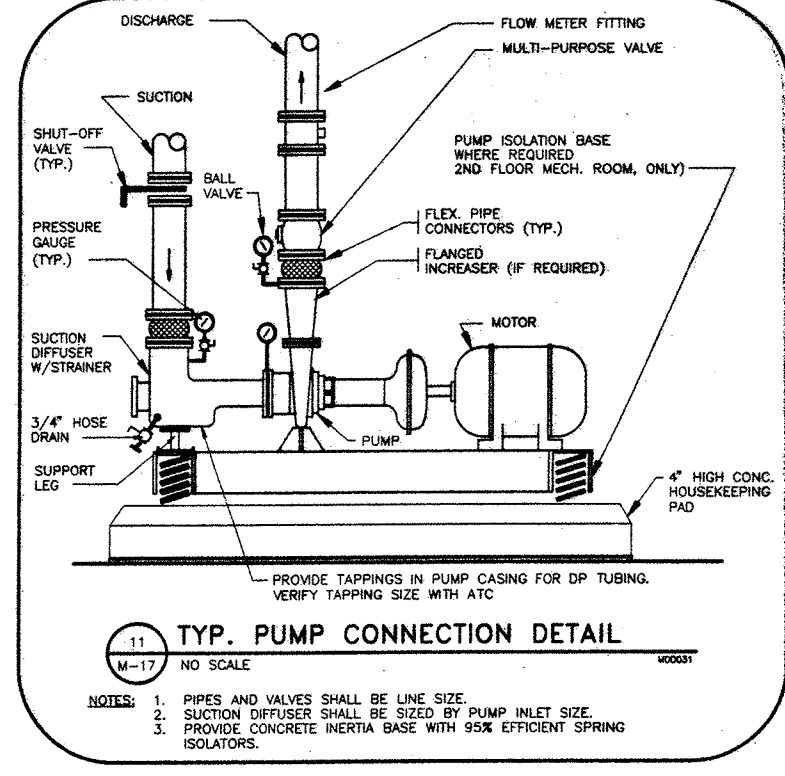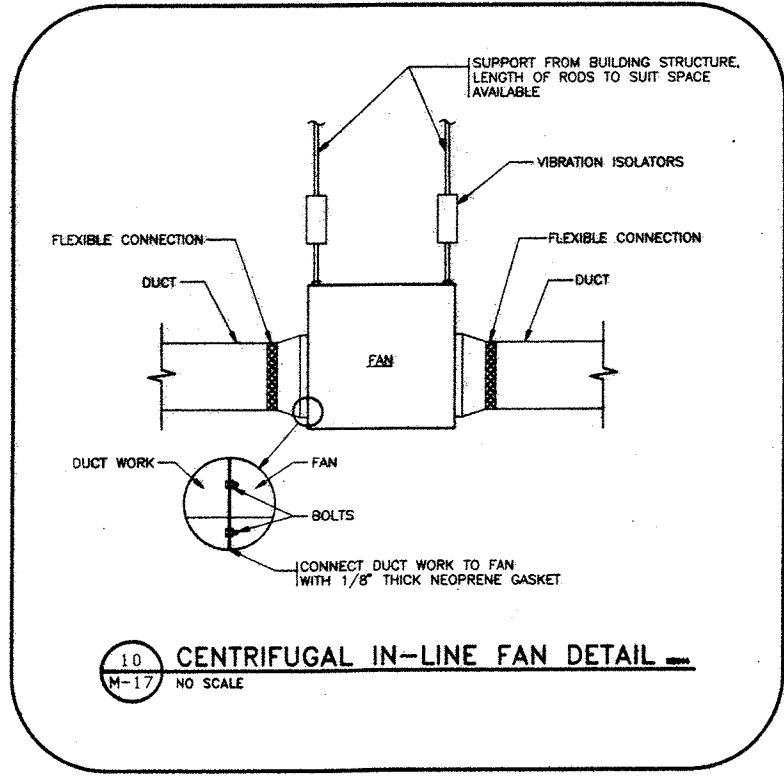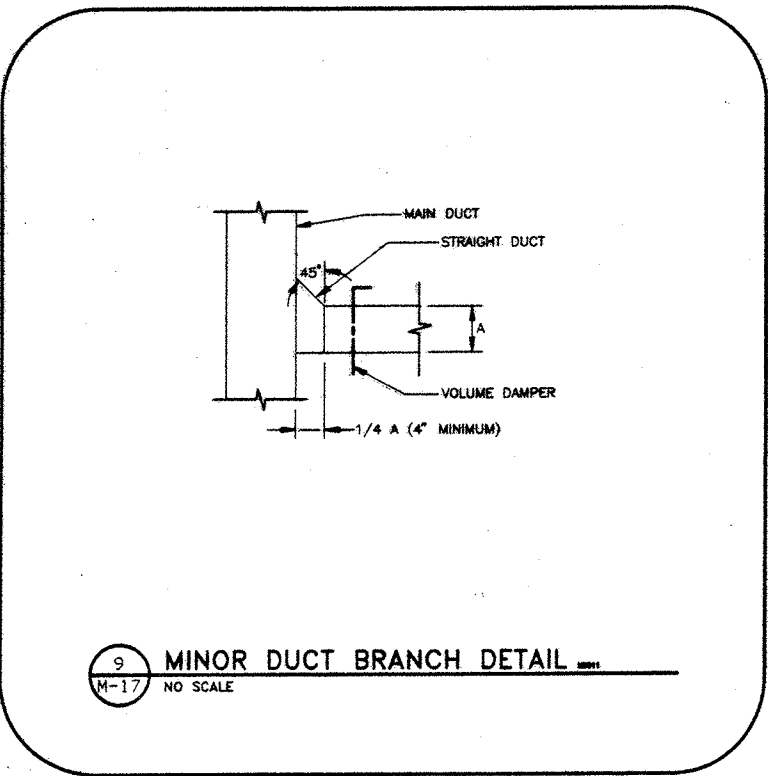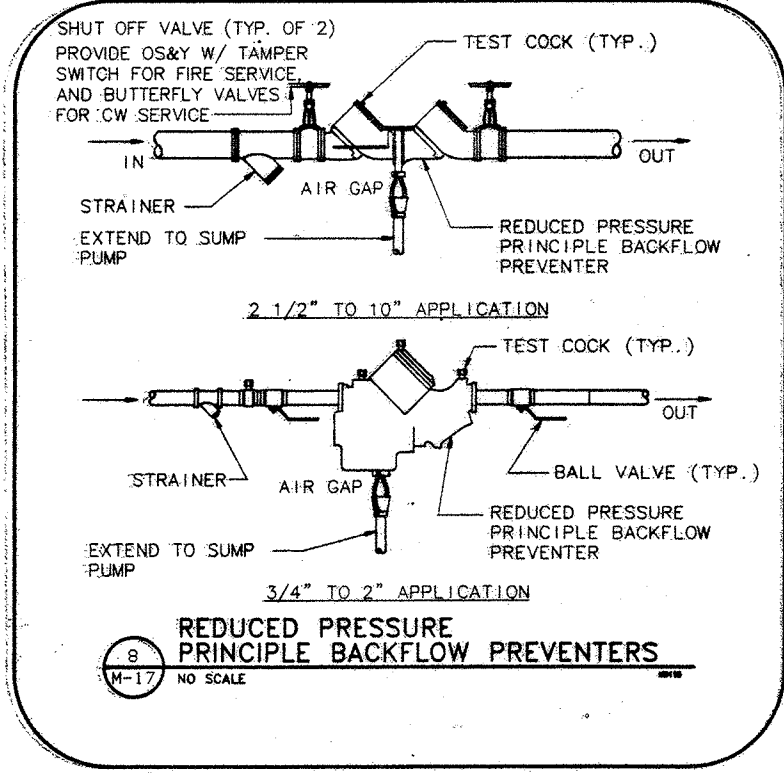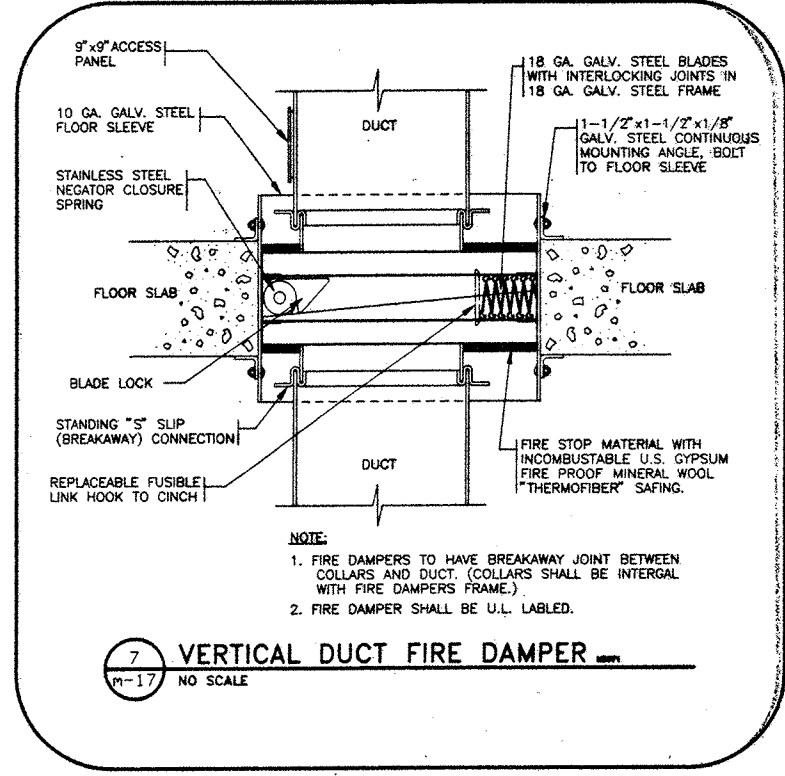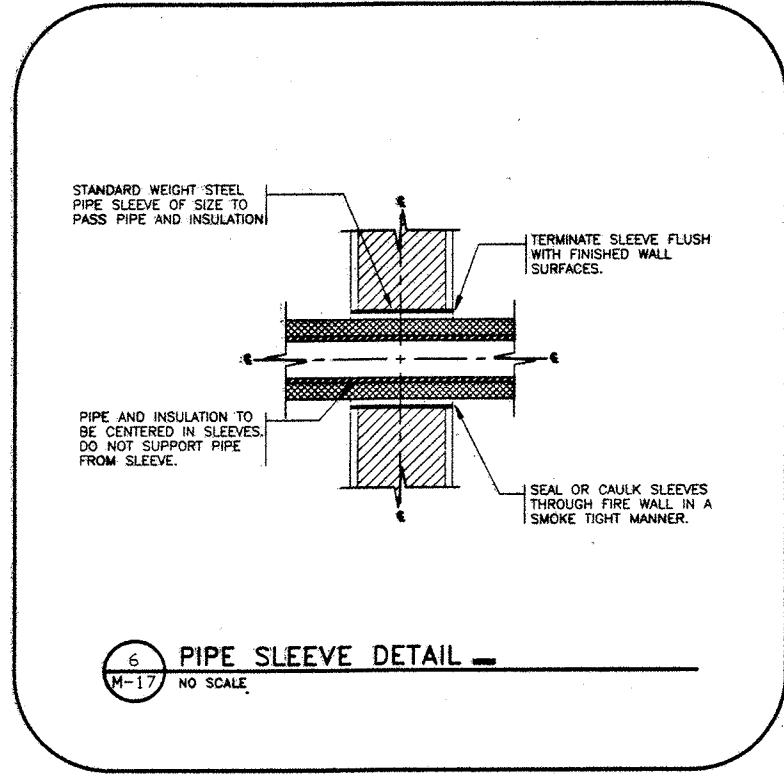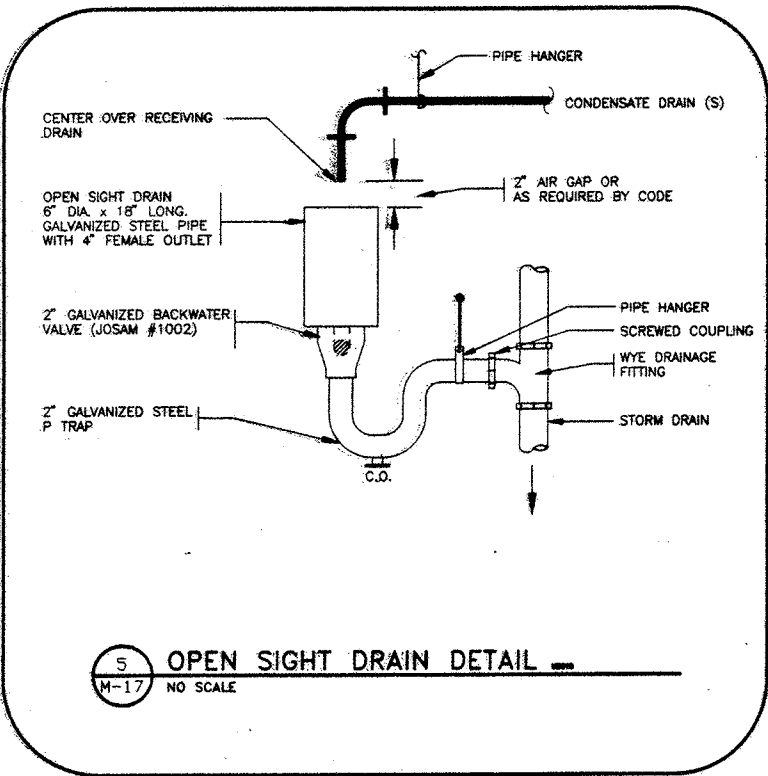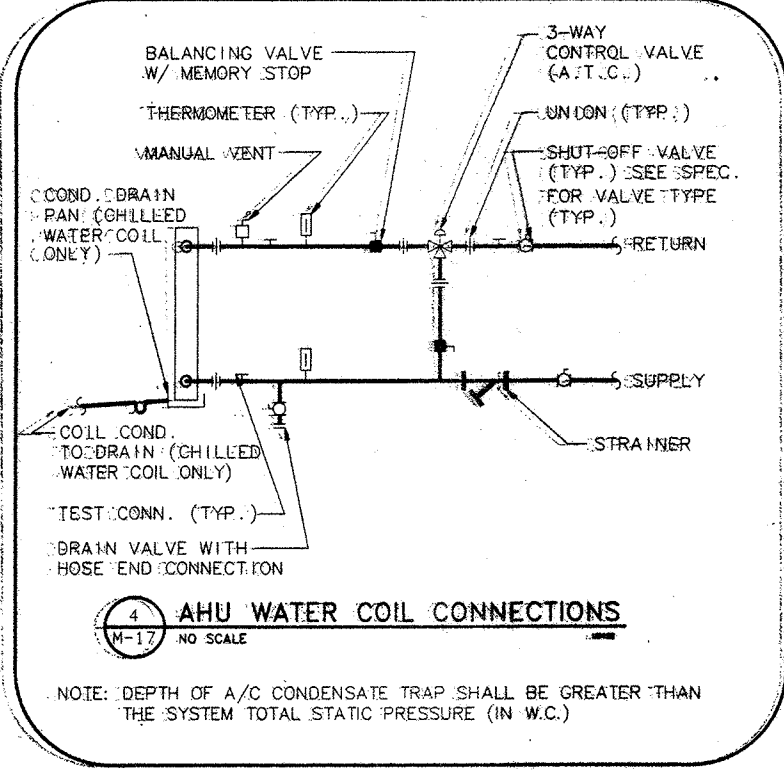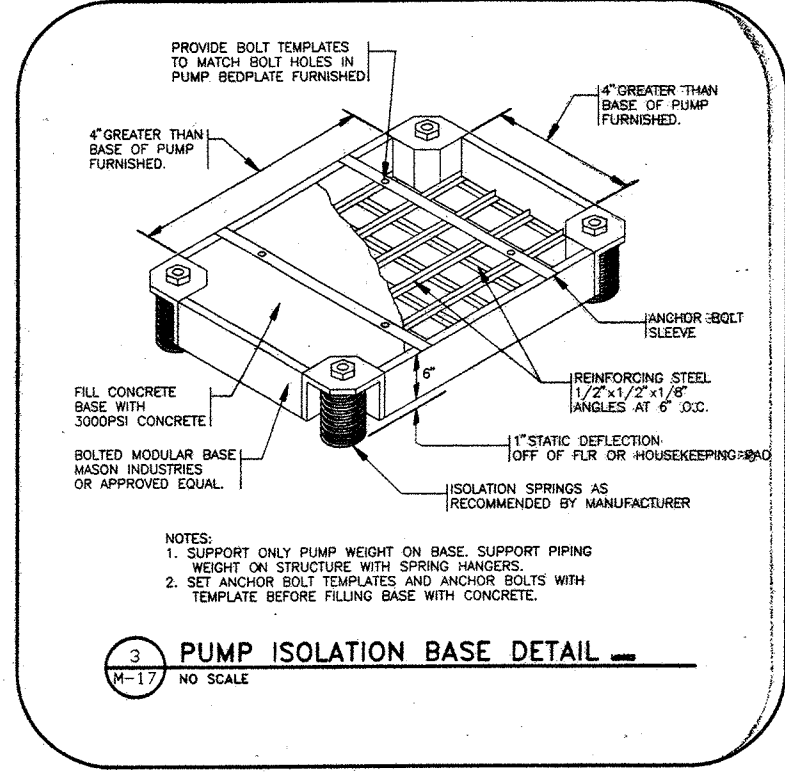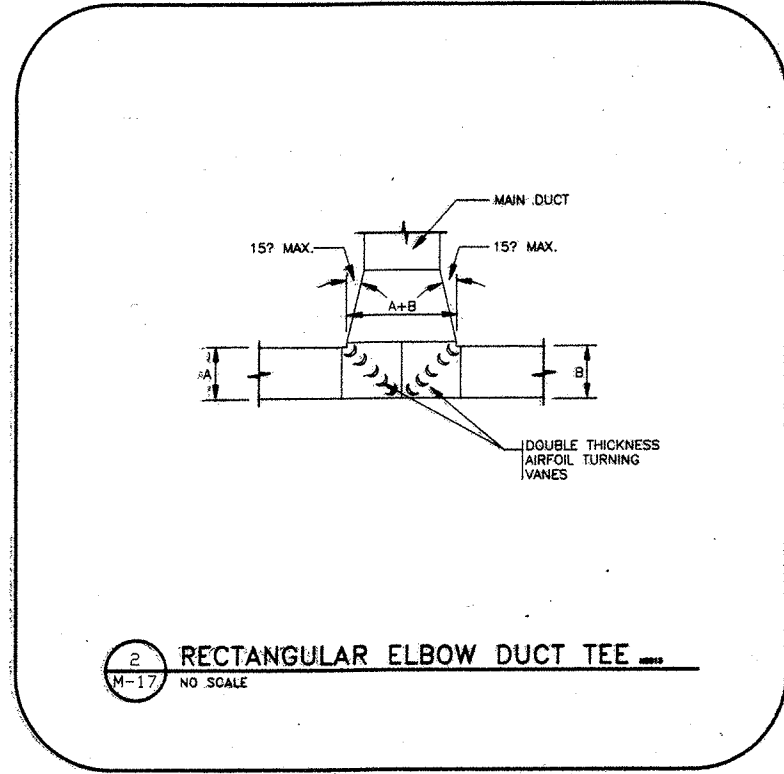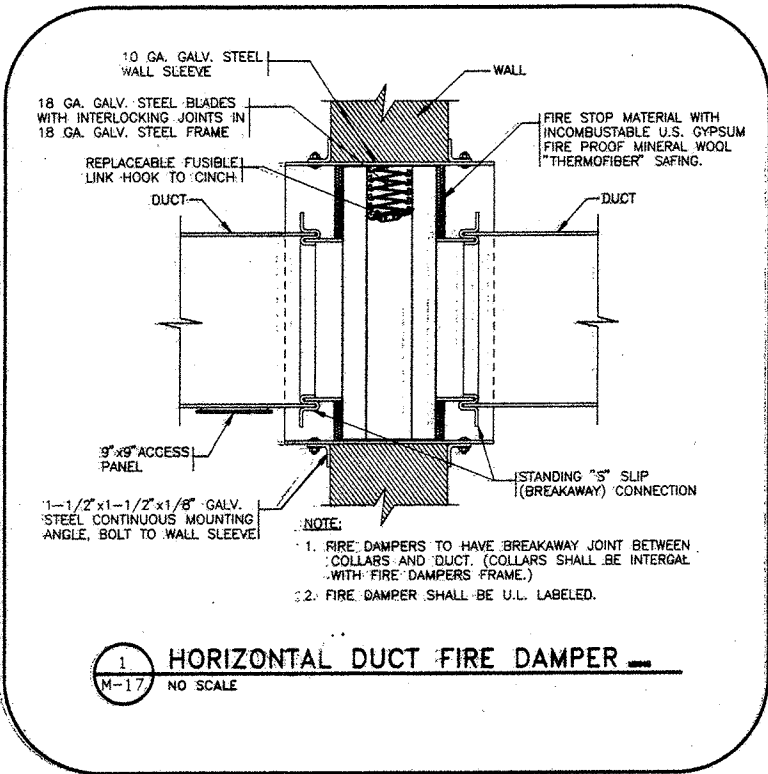

WHITING-TURNER
CONTRACTING COMPANY
DERSMAN ASSOCIATES
ARCHITECTS-ENGINEERS

PENN STREET PARKING FACILITY
UNIVERSITY OF MARYLAND AT BALTIMORE

NO. DATE BY
REVISIONS

MECHANICAL
DETAILS

DRAWING NO.

M-17

SCALE: NONE

DATE: 6-24-93

PROJECT NO. J-343

DESIGN DRAWN CHKD.
GEJ DAT MKA

APRIL 3, 1995 AS-BUILTS

AIR HANDLING UNIT SCHEDULE																															
AHU NO.	AREA SERVED	TOTAL S.P.	CFM	EXT. SP. IN. WG	MIN. O.A. CFM	FAN					HEATING COIL CAPACITY					COOLING COIL CAPACITY					REMARKS										
						HP	VOLTS	PHASE	RPM	FAN DIA. IN.	MBH	AIR ENT. DEG. F.	AIR LV. DEG. F.	WATER ENTERS DEG. F.	WATER LEAVES DEG. F.	GPM @ 40°F ΔT	WATER PD. FT. WG	AIR PD. IN.	MAX. FV	TYPE		MBH TOTAL	MBH SENS.	AIR ENT. DEG. F.	AIR LEAVES DEG. F.	WATER ENTERS DEG. F.	WATER LEAVES DEG. F.	GPM	WATER PD. FT. HD	AIR PD. IN. WG	MAX. FV
AHU#1	GRADE LEVEL OFFICES	4.25"	12,100	2.0"	1725	15	480	3	2000	22"	198	55	70	200	160	10	.4	.07	550	HYDRONIC	467.7	318.8	77.8/64.67	51.7/51.68	44	54	93.5	17.7	1.06	550	YORK CS-SH-217AF22CD
AHU#2	TRANSFORMER ROOM	1.50"	1450	0.75"	-	3/4	288	3	1120	-	-	-	-	-	-	-	-	-	HYDRONIC	54.4	48.7	85/65.5	55/53.2	44	54	10.9	9.4	.58	550	YORK DBA168YSD4R8	

* BASED ON 40% GLYCOL

PUMP SCHEDULE										
PUMP DES.	PUMP NAME	GPM	HEAD PRESS. IN FEET	HP	VOLTS	PHASE	RPM	CONTROL	MFR/MODEL	REMARKS
#1	CHILLED WATER	105	86'	7 1/2	480	3	1780	A.T.C.	TACO FM2010	END SUCTION FRAME MOUNTED
#2	CHILLED WATER STANDBY	105	86'	7 1/2	480	3	1780	A.T.C.	TACO FM2010	END SUCTION FRAME MOUNTED
#3	PRIMARY HEATING	63	24'	3/4	208	3	1780	A.T.C.	TACO FM1506	END SUCTION FRAME MOUNTED
#4	PRIMARY HEATING STANDBY	63	24'	3/4	208	3	1780	A.T.C.	TACO FM1506	END SUCTION FRAME MOUNTED
#5	PERIMETER SYSTEM	33	42'	1	208	3	1750	A.T.C.	TACO 1600 SERIES MODEL #1619	INLINE PUMP
#6	NOT USED									
#7	HEATING SYSTEM	10	32'	1/2	480	3	1780	A.T.C.	TACO FM1207	END SUCTION FRAME MOUNTED
#8	REHEAT SYSTEM	20	42'	3/4	480	3	1780	A.T.C.	TACO FM1207	END SUCTION FRAME MOUNTED
#9	COMMON STANDBY	20	42'	3/4	480	3	1780	A.T.C.	TACO FM1207	END SUCTION FRAME MOUNTED
#10	NOT USED									
#11	ELEVATOR SUMP PUMP	20	20'	1/3	120	1	1750	FLOAT	PROSSER/ENPO MODEL #1850	SUBMERSIBLE SUMP PUMP
#12	WATER SERVICE ROOM SUMP PUMP	20	20'	1/3	120	1	1750	FLOAT	PROSSER/ENPO MODEL #1850	SUBMERSIBLE SUMP PUMP

SELF CONTAINED AIR TO AIR HEAT PUMP SCHEDULE																
UNIT	SERVES	MODEL #	TOTAL COOLING MBH	CFM	COMPRESS. HP	EVAPORATOR HP	COND. E.A.T.	AMPS FLA	WATTS LRA	VOLTS/PHASE	REVERSE CYCLE MBH 52°F	REVERSE CYCLE MBH 32°F	ELECTRIC HEAT			
1	MANAGERS OFFICE	TRANE PTHB1501GC	13.9	325	1/8	.7	1/15	.5	95F	7.9	42	1800	208/1#	15.3	11.4	3.5 KW

PACKAGED AIR-COOLED LIQUID CHILLER SCHEDULE													
UNIT NO.	NOMINAL TONS	CHILLER DATA					ELECTRICAL DATA			SIZE LxWxH	WEIGHT LBS (OPER.)	MAKE/MODEL	REMARKS
		MBH	GPM	EWI DEG F.	LWT DEG F.	PD FT	OUTDOOR AMBIENT	VOLT	PHASE				
LC-1	45	525	105	54	44	14.7	95	480	3	127"x87"x55"	3820	YORK WILC530-46	40% GLYCOL

FAN SCHEDULE													
FAN NO.	LOCATION	SERVE	CFM	E.S.P.	HP	VOLTS	PHASE	RPM	DIRECT-DRIVE OR V-BELT	FAN DIA.	ROOF OPG. (IN.)	METHOD OF CONTROL	MFR/MODEL
EF #1	MAINTENANCE	MAINTENANCE	520	.5"	1/4	120	1#	1350	V-BELT	12 1/4"	-	R.A. STAT	PENN CENTREX INLINER MODEL SX958
EF #2	STEAM ROOM	MAIN TOILET ROOMS	550	1.0"	1/2	120	1#	1800	V-BELT	12 1/4"	-	TIMECLOCK	PENN CENTREX INLINER MODEL SX958
EF #3	STEAM ROOM	ELECT./TELE. ROOM	325	.875"	1/3	120	1#	1565	V-BELT	12 1/4"	-	H.O.A./T.C.	PENN CENTREX INLINER MODEL SX958
EF #4	STEAM ROOM	MECH./FIRE/STEAM ROOM	880	.625"	1/2	120	1#	1700	V-BELT	12 1/4"	-	H.O.A./T.C.	PENN CENTREX INLINER MODEL SX958
EF #5	MAINTENANCE	MANAGERS OFFICE TR.	75	.5"	1/20	120	1#	1622	DIRECT DRIVE	-	-	WALL SWITCH	PENN ZEPHYR MODEL Z-7 WITH SPEED SW.
EF #6	ELEV. MACH. RM.	ELEVATOR MACHINE RM.	7400	.25"	1	208	3#	775	V-BELT	30"	-	R.A. STAT.	PENN BREZZWAY #BBK30
RAF #1	AHU ROOM	OFFICES (AHU-1)	9070	.5"	3	480	3#	870	V-BELT	36"	-	A.T.C.	GREENHECK SOUNDTRAP VANE AXIAL #VPS-36H14-3C

MISC. HEATING UNIT SCHEDULE														
DES.	CFM	FAN MOTOR			BTU/H CAPACITY	WPD FT.	GPM	ENTERING WATER TEMP. DEG. F.	WATER LEAVES DEG. F.	ENTERING AIR TEMP. DEG. F.	LEAVING AIR TEMP. DEG. F.	TOTAL AMPS	MFR/MODEL	
		H.P.	VOLTS	PHASE										
CONV. #1	-	-	-	-	3180	-	.34	200	180	65	-	-	VULCAN MODEL RFG-A 38"Lx4"Dx20"H	
CH #1	230	1/10	120	1	60	10,900	.08	.5	200	180	65	111	VULCAN MODEL RC-1200-02	
UH #1	550	16 WATTS	120	1	60	21,685	.02	2.7	200	160	70	103	VULCAN MODEL HV-38	
UH #2	450	9 WATTS	120	1	60	14,440	.005	1.8	200	160	70	96	VULCAN MODEL HV-24	
UH #3	750	1/30	120	1	60	28,885	.03	3.5	200	160	70	103	VULCAN MODEL HV-48	
UH #4	350	1/100	208	3	60	12,600	-	-	-	-	-	18.0	CHROMALOX MODEL MUH-05-2	
UH #5	650	1/30	208	3	60	25,600	-	-	-	-	40	77	36	CHROMALOX MODEL MUH-07-8
WH #1	100	-	208	3	60	5120	-	-	-	-	-	8.5	CHROMALOX MODEL AWH-4204-2	

STEAM TO WATER HEAT EXCHANGER SCHEDULE											
HX NO.	SERVES	WATER SIDE				STEAM SIDE			CONDENSATE SIDE		MFR/MODEL
		MBH	GPM	WATER ENTERS DEG. F.	WATER LEAVES DEG. F.	MAX. P.D. FT.	INITIAL PRESSURE	LBS/HR	TRAP CAPACITY (#/HR)		
1	PRIMARY HEATING	1000	50	160	200	1.44	50 PSI	1000	3000	TACO 6" DIA. 2 PASS MODEL #6208	
2	PRIMARY HEATING	1000	50	160	200	1.44	50 PSI	1000	3000	TACO 6" DIA. 2 PASS MODEL #6208	

TERMINAL REHEAT BOX SCHEDULE												
NOM CFM	INLET SIZE	OUTLET SIZE	INLET MAX. S.P.	W.P.D. FT. HD.	ΔT AIR	MBH	EWI	GPM	PIPE SIZE			
0-200	4"	12"x8"	.45"	2'	30	0-6.5	200	0-.33	3/4"			
201-300	5"	12"x8"	.45"	2'	30	6.5-9.7	200	.33-.49	3/4"			
301-400	6"	12"x8"	.45"	2'	30	9.7-13.0	200	.49-.65	3/4"			
401-550	7"	12"x10"	.45"	2'	30	13.0-17.8	200	.65-.89	3/4"			
551-700	8"	12"x10"	.45"	2'	30	17.8-22.7	200	.89-1.14	3/4"			
701-950	9"	14"x12"	.45"	2'	30	22.7-30.8	200	1.14-1.54	3/4"			
951-1150	10"	14"x12"	.45"	2'	30	30.8-37.3	200	1.54-1.87	3/4"			

NOTE: ENT. AIR TEMP. SHALL BE 55°F (TYP. OF ALL)

ELECTRIC WATER HEATER SCHEDULE							
DESIG.	VOLT	PHASE	KW	FLA	RECOVERY RATE	TANK CAPACITY	MANUFACTURER & MODEL
WATER HEATER #1	208	3	6	16.7	31 GPH @ 80° RISE	40	A.O. SMITH MODEL DSE-40
WATER HEATER #2	120	1	1.5	-	6.9 GPH @ 90° RISE	15	A.O. SMITH MODEL ELSF-15

FIN TUBE RADIATION SCHEDULE									
SYMBOL	BTU PER L.F.	GPM @ 20°F ΔT	WATER ENTERS DEG. F.	WATER LEAVES DEG. F.	ACTIVE LENGTH	RUNOUT SIZES	MFR/MODEL	REMARKS	
◇	1000	.4	200	180	4'-0"	3/4"	VULCAN DURA-VANE STYLE DVS	1" C-4 1/4"-33/2"FIN	
◇	1000	.8	200	180	7'-6"	3/4"	VULCAN DURA-VANE STYLE DVS	1" C-4 1/4"-33/2"FIN	
◇	1000	.8	200	180	6'-0"	3/4"	VULCAN DURA-VANE STYLE DVS	1" C-4 1/4"-33/2"FIN	
◇	550	.33	200	180	6'-0"	3/4"	VULCAN DURA-VANE STYLE DVS	3/4" C-2 3/4"x3"-33/016"FIN	

NOTE: ENCLOSURE SHALL BE 12" HIGH, SUITABLE FOR 3 PIPE ARRANGEMENT (SEE DWGS. FOR DETAIL)

AIR DEVICE SCHEDULE						
TYPE	SIZE	CFM RANGE	INLET/NECK SIZE	MAX. NC	MFR/MODEL	
S.A.D.	24"x24"	0 - 175	6"x6"	25	TITUS #PAS	
S.A.D.	24"x24"	176 - 250	8"x8"	25	TITUS #PAS	
S.A.D.	24"x24"	251 - 350	10"x10"	30	TITUS #PAS	
L.B.D.	36"x4"	0 - 150	①	10	TITUS #CT-581	
L.B.D.	48"x4"	151 - 200	①	10	TITUS #CT-581	
L.B.D.	72"x4"	201 - 300	①	10	TITUS #CT-581	
L.B.D.	84"x4"	301 - 350	①	10	TITUS #CT-581	
L.B.D.	72"x3"	410	①	10	TITUS #CT-580	
S.A.R.	12"x8"	0 - 230	12"x8"	10	TITUS #271-FS	
S.A.R.	12"x8"	231 - 400	12"x8"	20	TITUS #271-FS	
R.A.R.	24"x24"	0 - 1800	22"x22"	15	TITUS #PAR	
L.B.R.	48"x6"	880	①	25	TITUS #CT-580	
E.A.G.	8"x8"	0 - 125	8"x8"	30	TITUS #4FL	
E.A.G.	10"x10"	126 - 240	10"x10"	30	TITUS #4FL	

NOTE: ① SEE FLOOR PLANS FOR ACTUAL DUCT SIZES.

PLUMBING FIXTURE SCHEDULE											
P #	DESCRIPTION	CW	HW/TW	DOMESTIC FU	SAN	VENT	TRAP	SANITARY FU	REMARKS		
		CW	HW	TOT				PUBLIC	NON		
P-1	WALL HUNG WATER CLOSET (HDCP.)	1"	-	10	-	10	4"	2"	INT.	6	4
P-2	WALL HUNG WATER CLOSET	1"	-	10	-	10	4"	2"	INT.	6	4
P-3	URNAL	3/4"	-	5	-	5	2"	1 1/2"	INT.	4	4
P-4	COUNTERTOP LAVATORY	1/2"	1/2"	1.5	1.5	2	1 1/2"	1 1/2"	P	1	1
P-5	MOP SINK	3/4"	3/4"	2.25	2.25	3	3"	1 1/2"	P	2	2
P-6	ELECTRIC WATER COOLER HANDICAPPED ACCESSIBLE	1/2"	-	1	-	1	1 1/2"	1 1/2"	P	1	1
P-7	FLOOR MOUNTED WATER CLOSET (HDCP.)	1"	-	10	-	10	4"	2"	INT.	6	4
P-8	WALL HUNG LAVATORY (HDCP.)	1/2"	1/2"	1.5	1.5	2	1 1/2"	1 1/2"	P	1	1

MECHANICAL LEGEND

- 1000 COLD WATER (CW) _____
- 1001 HOT WATER (HW) _____
- 1010 PRIMARY SUPPLY _____ PRIM.SUP. _____
- 1011 PRIMARY RETURN _____ PRIM.RET. _____
- 1012 HEATING WATER SUPPLY _____ HS _____
- 1013 HEATING WATER RETURN _____ HR _____
- 1014 REHEAT WATER SUPPLY _____ RHS _____
- 1015 REHEAT WATER RETURN _____ RHR _____
- 1016 PERIMETER HEATING SUPPLY _____ PHS _____
- 1017 PERIMETER HEATING RETURN _____ PHR _____
- 1018 CHILLED WATER SUPPLY _____ CWS _____
- 1019 CHILLED WATER RETURN _____ CWR _____
- 1020 MEDIUM PRESSURE STEAM _____ MPS 50# _____
- 1021 MEDIUM PRESSURE RETURN _____ MPR 50# _____
- 1022 HIGH PRESSURE STEAM _____ HPS 150# _____
- 1023 HIGH PRESSURE RETURN _____ HPR 150# _____
- 1024 PUMPED DISCHARGE _____ PD _____
- 1025 AIR CONDITIONING DRAIN _____ A/C COND. _____
- 1026 SANITARY PIPING _____
- 1027 STORM WATER PIPING _____ SW _____
- 1028 VENT PIPING _____
- 1029 FIRE LINE _____ F _____
- 1030 CHECK VALVE _____
- 1031 BALL VALVE _____
- 1032 BUTTERFLY VALVE _____
- 1033 BALANCING VALVE _____
- 1034 INLINE CIRCULATING PUMP _____
- 1035 UNION _____
- 1036 FLOOR DRAIN _____ F.D. _____
- 1037 PIPE GUIDE OR SLEEVE _____
- 1038 PIPE ANCHOR _____
- 1039 PIPING ELBOW DOWN _____
- 1040 PIPING ELBOW UP _____
- 1041 AIR FLOW DIRECTION INDICATOR _____
- 1042 SUPPLY AIR DUCT UP (DASHED LINES FOR DOWN) _____
- 1043 RETURN & EXHAUST AIR DUCT UP (DASHED LINES FOR DOWN) _____
- 1044 OUTSIDE AIR DUCT UP (DASHED LINES FOR DOWN) _____
- 1045 DUCTWORK WITH SOUND LINING _____
- 1046 FLEXIBLE DUCT AND EQUIPMENT CONNECTOR _____
- 1047 DOUBLE THICKNESS TURNING VANES _____
- 1048 DUCT TRANSITION ROUND TO RECTANGULAR _____
- 1049 DUCT TRANSITION _____
- 1050 SUPPLY AIR DUCT UP (DASHED LINES FOR DOWN) _____
- 1051 RETURN & EXHAUST AIR DUCT UP (DASHED LINES FOR DOWN) _____
- 1052 OUTSIDE AIR DUCT UP (DASHED LINES FOR DOWN) _____
- 1053 BALANCING DAMPER _____
- 1054 MOTOR OPERATED DAMPER _____
- 1055 FIRE DAMPER W/ ACCESS PANEL _____
- 1056 BACKDRAFT DAMPER _____
- 1057 THERMOSTAT _____
- 1058 REVERSE ACTING THERMOSTAT _____

WHITING-TURNER
CONTRACTING COMPANY
DESIGN ASSOCIATES
ARCHITECTS ENGINEERS


BURDETTE, KOEHLER, MURPHY &
ASSOCIATES, INC.
CONSULTING ENGINEERS
100 N. CALVERT STREET, BALTIMORE, MD 21202

PENN STREET PARKING FACILITY
UNIVERSITY OF MARYLAND AT BALTIMORE

NO. DATE BY
REVISIONS


SCHEDULES & LEGEND
DRAWING NO.
M-19

SCALE: NONE
DATE: 6-24-1993
PROJECT NO. J-343
DESIGN DRAWN CHKD.
GEJ DAT MKA

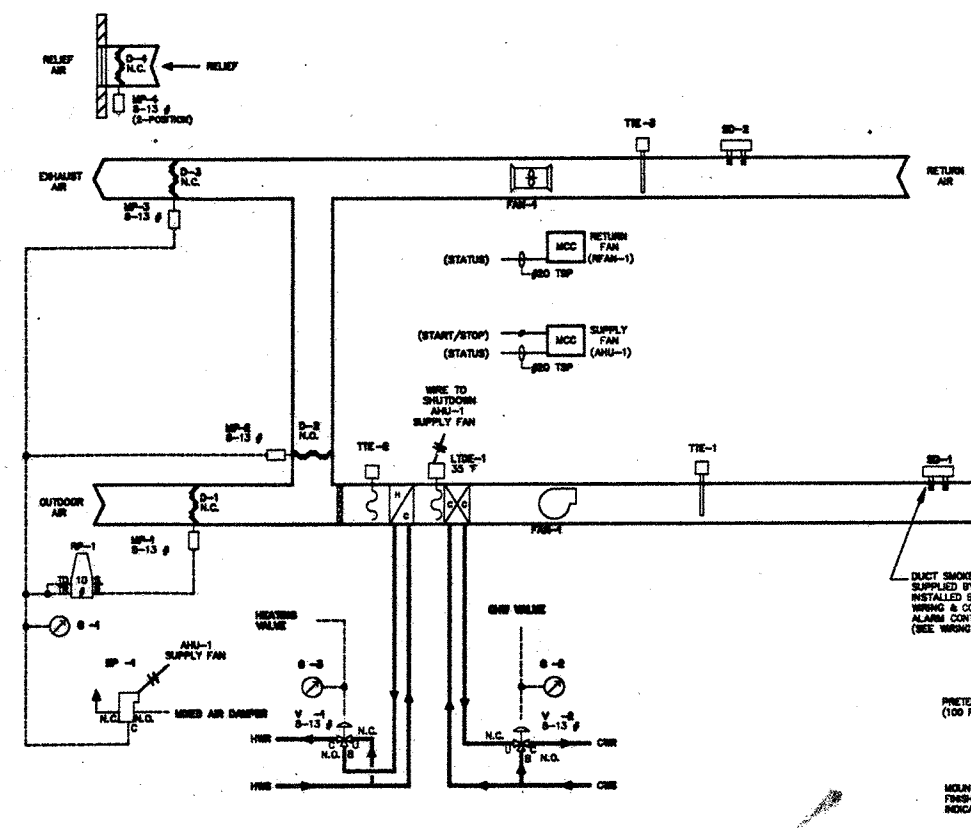

IMPORTANT !!
AIR VELOCITY SENSOR TO BE LOCATED A MINIMUM OF 3 TO 5 STRAIGHT DUCT DIAMETERS FROM ANY MAJOR TRANSITION OR TAKEOFF FOR PROPER SENSOR READING.

CONSTANT VOLUME BOX
SEE INSTALLATION NOTES

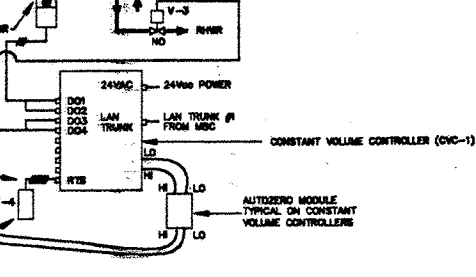

SEQUENCE OF OPERATION

OPERATIONAL MODES
DURING UNOCCUPIED HOURS THE CENTRAL CONTROL SYSTEM WILL INDEX THE AIR HANDLER TO SHUTDOWN MODE. DURING THE UNOCCUPIED HOURS WHEN THE SPACE TEMPERATURE FALLS BELOW NIGHT SETPOINT THE CENTRAL CONTROL SYSTEM WILL INDEX THE AIR HANDLER TO SILENT BACK MODE. DURING THE PRE-OCCUPANCY PERIOD, WHEN THE SPACE TEMPERATURE IS BELOW THE OCCUPIED SETPOINT, THE CENTRAL CONTROL SYSTEM WILL INDEX THE AIR HANDLER TO WARMUP MODE. DURING OCCUPIED HOURS, THE CENTRAL CONTROL SYSTEM WILL INDEX THE AIR HANDLER TO THE NORMAL MODE.

THE AIR HANDLER WILL BE INDEXED TO THE MODES DEFINED IN THE TABLE BELOW BY A SINGLE SOFTWARE POINT. THIS SOFTWARE POINT AND ALL INDIVIDUAL EQUIPMENT POINTS WILL BE OPERATOR COMMANDABLE.

MODEL THE RETURN FAN (RAH-1) WILL ENERGIZE SIMULTANEOUSLY WITH THE AHU-1 SUPPLY FAN VIA AUXILIARY CONTACT INTERLOCK. FAN STATUS TO BE MONITORED BY THE BMS PANEL.

AIR HANDLER EQUIPMENT	UNOCCUPIED	OCCUPIED	SETBACK	WARMUP
SUPPLY FAN	OFF	ON	ON	ON
RETURN FAN	OFF	ON	ON	ON
CW COIL VALVE	CLOSED	CONTROLLED	CLOSED	CLOSED
PREHEAT VALVE	OPEN	CONTROLLED	CONTROLLED	CONTROLLED
MIXING DAMPERS	NORMAL	CONTROLLED	NORMAL	NORMAL

TEMPERATURE CONTROL
THE PREHEAT COIL TEMPERATURE SENSOR (TTE-2) WILL MODULATE PREHEAT VALVE (V-1) TO MAINTAIN THE PREHEAT COIL DISCHARGE SETPOINT (ADJUSTABLE), DURING SETBACK MODE ONLY.

THE SUPPLY AIR TEMPERATURE SENSOR (TTE-1) WILL MODULATE COOLING VALVE (V-2) TO MAINTAIN THE SUPPLY AIR TEMPERATURE SETPOINT (ADJUSTABLE).

THE MIXED AIR TEMPERATURE SENSOR (TTE-3) WILL MODULATE THE OUTDOOR, RETURN AND EXHAUST DAMPERS TO MAINTAIN THE MIXED AIR TEMPERATURE SETPOINT (ADJUSTABLE). START-UP TO PREVENT INTERNAL WIND-UP FROM THE SUPPLY AIR CONTROL LOOP, THE OUTDOOR AIR DAMPERS WILL BE PLACED AT MINIMUM POSITION FOR 120 SECONDS, AND THEN RELEASED FOR NORMAL CONTROL.


CONSTANT VOLUME W/REHEAT APPLICATION #33 (TYPICAL OF 8)

ROOM TEMP	CONTROL SCHEDULE	MODE
FULL	DAY	HEAT
NIGHT	NIGHT	HEAT
W/REHEAT	DAY	HEAT
SUPPLY AIR	DAY	HEAT
W/REHEAT	NIGHT	HEAT
W/REHEAT	DAY	HEAT
W/REHEAT	NIGHT	HEAT

GENERAL BMS CONTROLLER INSTALLATION NOTES

- AIR VELOCITY SENSOR AND DAMPER TO BE PROVIDED BY BMS MANUFACTURER.
- AIR VELOCITY SENSOR TO BE LOCATED A MINIMUM OF 3 TO 5 STRAIGHT DUCT DIAMETERS FROM ANY MAJOR TRANSITION OR TAKEOFF FOR PROPER SENSOR READING.
- TERMINAL BMS CONTROLLER AND DAMPER ACTUATOR TO BE FACTORY INSTALLED.
- REHEAT COIL VALVE TO BE FIELD INSTALLED BY MECHANICAL CONTRACTOR.


AIR HANDLING UNIT #1

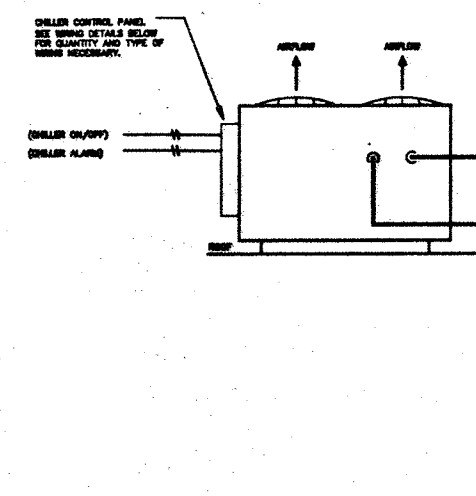

AIR COOLED CHILLER

SEQUENCE OF OPERATION


- CHILLED WATER PUMPS SHALL BE ENERGIZED THROUGH THE BMS CONTROL SYSTEM. UPON PROOF OF FLOW AND CURRENT DETECTORS AND FLOWMETER (FC-1), THE CHILLER WILL BE CHARGED TO START BY THE CONTROL SYSTEM. THE CHILLER WILL THEN OPERATE UNDER ITS PACKAGED CONTROLS.
- THE CONTROL SYSTEM WILL MONITOR THE CHILLED WATER SUPPLY AND RETURN TEMPERATURES. FAN WILL BE ENERGIZED IF EITHER PUMP FAILS, THE WATER TEMPERATURE EXCEEDS AN OPERATOR SPECIFIED TEMPERATURE RANGE (CALL) OR THE CHILLER FAILS.

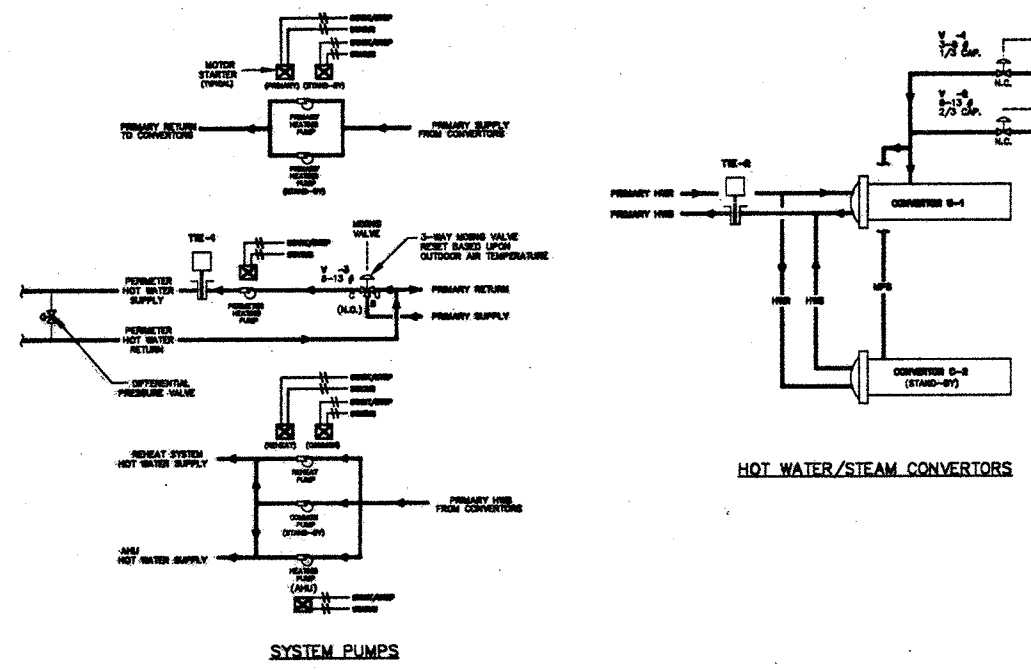


SEQUENCE OF OPERATION

- HOT WATER PRIMARY HEATING PUMPS WILL BE ENERGIZED BY THE CONTROL SYSTEM. LEAD/LAG OPERATION SHALL BE PERFORMED. CONVERTER HOT WATER SUPPLY TEMPERATURE SENSOR (TTE-2) SHALL MODULATE STEAM CONTROL VALVES (V-1) AND (V-2) TO OPEN IN SEQUENCE TO ENABLE STEAM TO FLOW TO THE CONVERTERS (1/3-2/3 CAPACITY CONTROL). WHEN THE CONVERTER HOT WATER SUPPLY TEMPERATURE IS SATISFIED, THE STEAM VALVES WILL CLOSE. ALARMS SHALL BE GENERATED IF EITHER PUMP FAILS. THE COMMON STAND-BY PUMP HAS MANUAL ISOLATION VALVES.
- THE AIR HANDLING UNIT AND REHEAT HEATING WATER PUMPS SHALL BE ENERGIZED BY THE CONTROL SYSTEM. ALARMS SHALL BE GENERATED IF EITHER PUMP FAILS.
- THE PERIMETER HEATING WATER PUMP SHALL BE ENERGIZED BY THE CONTROL SYSTEM. THE HEATING WATER SUPPLY TEMPERATURE (TTE-1) SHALL BE RESET BY MODULATING THE MIXING VALVE (V-3) BASED ON OUTDOOR AIR TEMPERATURE. ALARMS SHALL BE GENERATED IF THE PUMP FAILS OR THE HEATING WATER SUPPLY TEMPERATURE EXCEEDS AN OPERATOR SPECIFIED (ADA) TEMPERATURE RANGE. INDIVIDUAL ZONE CONTROL VALVES (TYPICAL OF 3), SHALL BE 2-WAY OPEN CLOSE TYPE, CONTROLLABLE FROM DOC/COMB.


HOT WATER HEATING SYSTEM

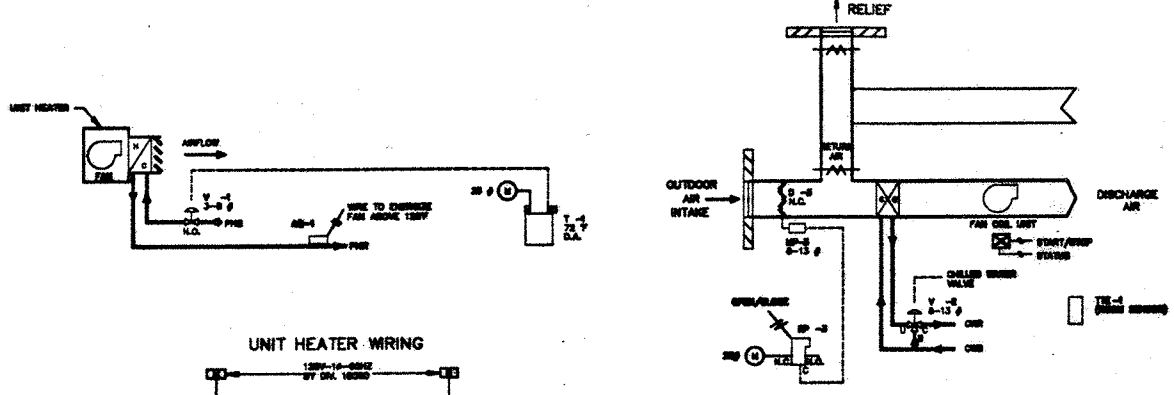


UNIT HEATERS & CABINET HEATERS

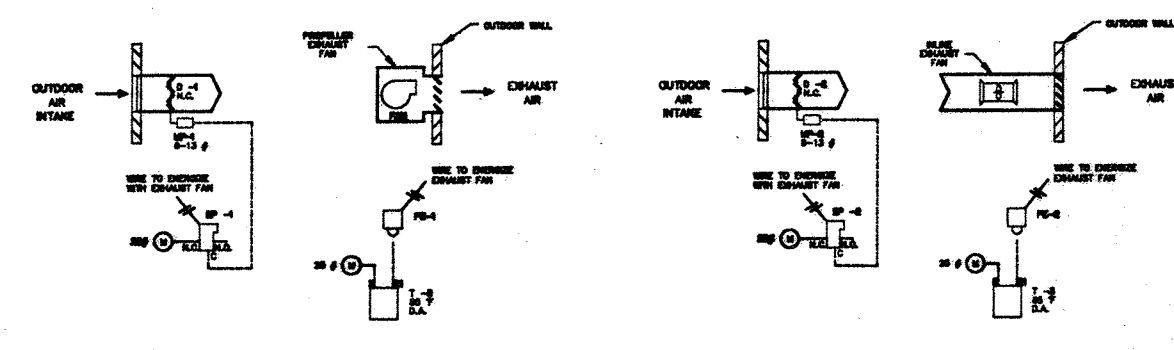

WALL PROPELLER EXHAUST FANS

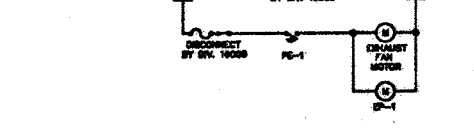

INLINE EXHAUST FAN WIRING

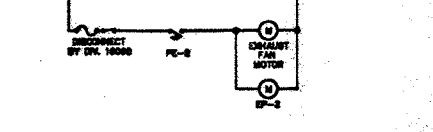

INLINE EXHAUST FAN

SEQUENCE OF OPERATION

UNIT HEATERS
ON A FALL IN SPACE TEMPERATURE BELOW THE SETPOINT OF ROOM THERMOSTAT (T-1), THE HEATER'S FAN WILL ENERGIZE.

ON A RISE IN SPACE TEMPERATURE ABOVE THE SETPOINT OF ROOM THERMOSTAT (T-1), THE HEATER'S FAN WILL DE-ENERGIZE.

ON A FALL IN HOT WATER SUPPLY TEMPERATURE BELOW THE SETPOINT OF ADJUSTED (AD-1), THE HEATER'S FAN WILL DE-ENERGIZE.

EXHAUST FANS
FAN SHALL RUN CONTINUOUSLY DURING OCCUPIED HOURS AND SHALL BE DE-ENERGIZED DURING UNOCCUPIED HOURS.

EXHAUST FANS
DURING OCCUPIED HOURS, FANS SHALL RUN CONTINUOUSLY. DURING UNOCCUPIED HOURS, FANS SHALL BE CONTROLLED BY ROOM THERMOSTATS. ON A RISE IN SPACE TEMP ABOVE SETPOINT, FAN SHALL BE ENERGIZED. ON A DROP IN SPACE TEMP, THE REVERSE SHALL OCCUR.

EXHAUST FANS
FAN SHALL BE ENERGIZED BY LOCAL SWITCH.

AIR HANDLING UNIT #2
WHEN CHILLED WATER IS AVAILABLE, OA DAMPER & RELIEF DAMPER SHALL BE CLOSED. UNIT SHALL BE 100% RECIRCULATING, USING 55F L.A.T.


WHEN CHILLED WATER IS NOT AVAILABLE, RETURN AIR DAMPER, OA DAMPER & RELIEF AIR DAMPER SHALL MODULATE TO PROVIDE 55F L.A.T.

DRAWING DELETED


AUTOMATIC TEMPERATURE CONTROLS

NO.	DATE	BY
1	5/26/95	
2		
3		
4		
5		
6		
7		
8		
9		
10		

SCALE: NONE
DATE: 5-24-93
PROJECT NO. J-343
DESIGN DRAWN GPKD.
GEJ DAT MKA

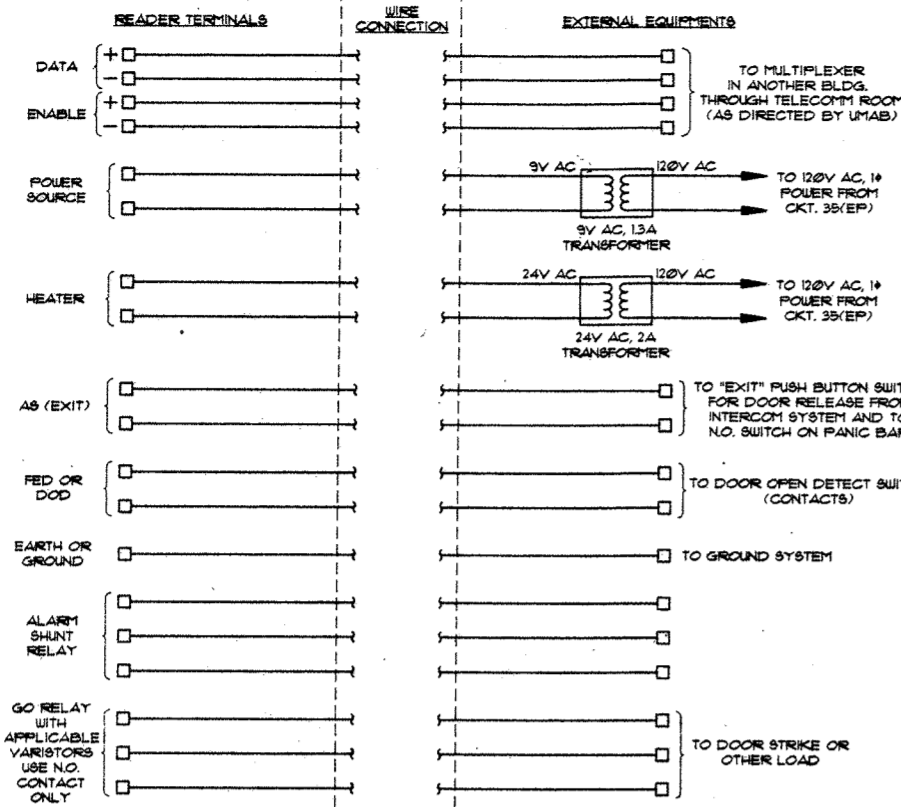

1 EXTERNAL WIRING DIAGRAM - SECURITY SYSTEM
E-1 NO SCALE

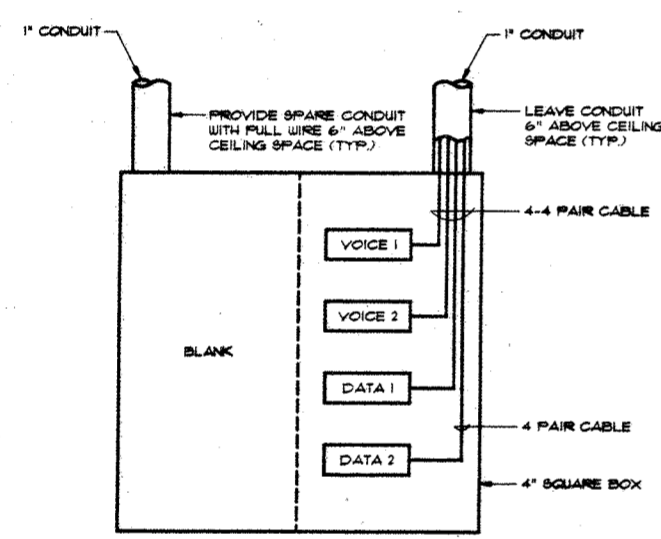


2 TYP. COMMUNICATION OUTLET
E-1 NO SCALE


NOTE: THE ABOVE DETAIL IS MEANT FOR PERMANENT OFFICE AREAS AND NOT FOR MODULAR OFFICE AREAS. PRE-WIRED MODULAR FURNITURES ARE PROVIDED BY THE USER. CONTRACTOR SHALL VERIFY THE OUTLET LOCATION AND LEAVE SUFFICIENT CABLE LENGTH AT THE TELE-POWER AND COMMUNICATION POLES ACCORDINGLY.

- GENERAL NOTES:**
- FOR FIRE ALARM COMPONENTS SEE BASE DWG. E-3 DATED 6-24-93.
 - FOR CABINET HEATER (CH 4) SEE BASE DWG. E-3 DATED 6-24-93.
 - MOUNTING HEIGHT OF RECEPTACLES ON THE EXTERIOR WALLS TO COORDINATE WITH THE PERIMETER HEATING UNITS AS SHOWN ON MECHANICAL DRAWING.
 - FOR ELECTRICAL LEGEND/ABBREVIATION, SEE BASE DWG. E-1 DATED 11-24-93.
 - ACTUAL LOCATION OF TELE-POWER & COMMUNICATION POLES SHALL BE FIELD DETERMINED TO SUIT THE BEST CONDITION BASED ON THE USER PROVIDED MODULAR FURNITURE LAYOUT. THE MODULAR POSITIONS WILL BE SUPPLIED PREWIRED AND THE INTENT OF THIS DRAWING IS TO DIVIDE ALL 3 POWER CIRCUITS EVENLY IN THIS AREA.
 - COMMUNICATION CABLE TRAY LAYOUT IS SHOWN APPROXIMATE AND THE INTENT IS TO STAY ABOVE THE CORRIDOR FOR EASE OF ACCESSIBILITY. THE ABOVE CEILING SPACE IS VERY CROWDED WITH DUCTS, PIPES, VENTS, LIGHTS ETC. CONTRACTOR HAS TO COORDINATE CLOSELY FOR THE FINAL ROUTING OF THE TRAY. REFER TO MECHANICAL DRAWING FOR SECTIONAL DETAILS AT DUCT CROSSING ETC.
 - REFER TO THE SPECIFICATION SECTIONS UNDER BASE CONTRACT.
 - FOR PANELBOARD (PPB) SCHEDULE, SEE DRAWING E-2.
 - PROVIDE SEPARATE NEUTRALS TO RECEPTACLE CIRCUITS AS SHOWN.

- DRAWING NOTES (APPLY TO THIS DWG. ONLY):**
- PROVIDE AND INSTALL TELE-POWER POLES AS SHOWN. TELE-POWER POLE SHALL BE WIREMOLD TYPE AHTP-4 OR EQUAL.
 - PROVIDE AND INSTALL COMMUNICATION POLES AS SHOWN. COMMUNICATION POLE SHALL BE WIREMOLD TYPE ALTC-4 OR EQUAL.
 - 2#0 & #2(3) IN 3/4" CONDUIT.
 - PROVIDE MAGNETIC LOCKS (ML) AT TOP OF THE DOOR TO BE RELEASED AND CONTROLLED BY FIRE ALARM CONTROL SYSTEM THROUGH PULL STATION OPERATION. ALSO PROVIDE A DIRECT BYPASS POWER TO OPERATE THIS MAGNETIC LOCK THROUGH A PUSH BUTTON LOCATED AT NEAREST PULL STATION AS A BACK UP IN FA CONTROL SYSTEM FAILS.

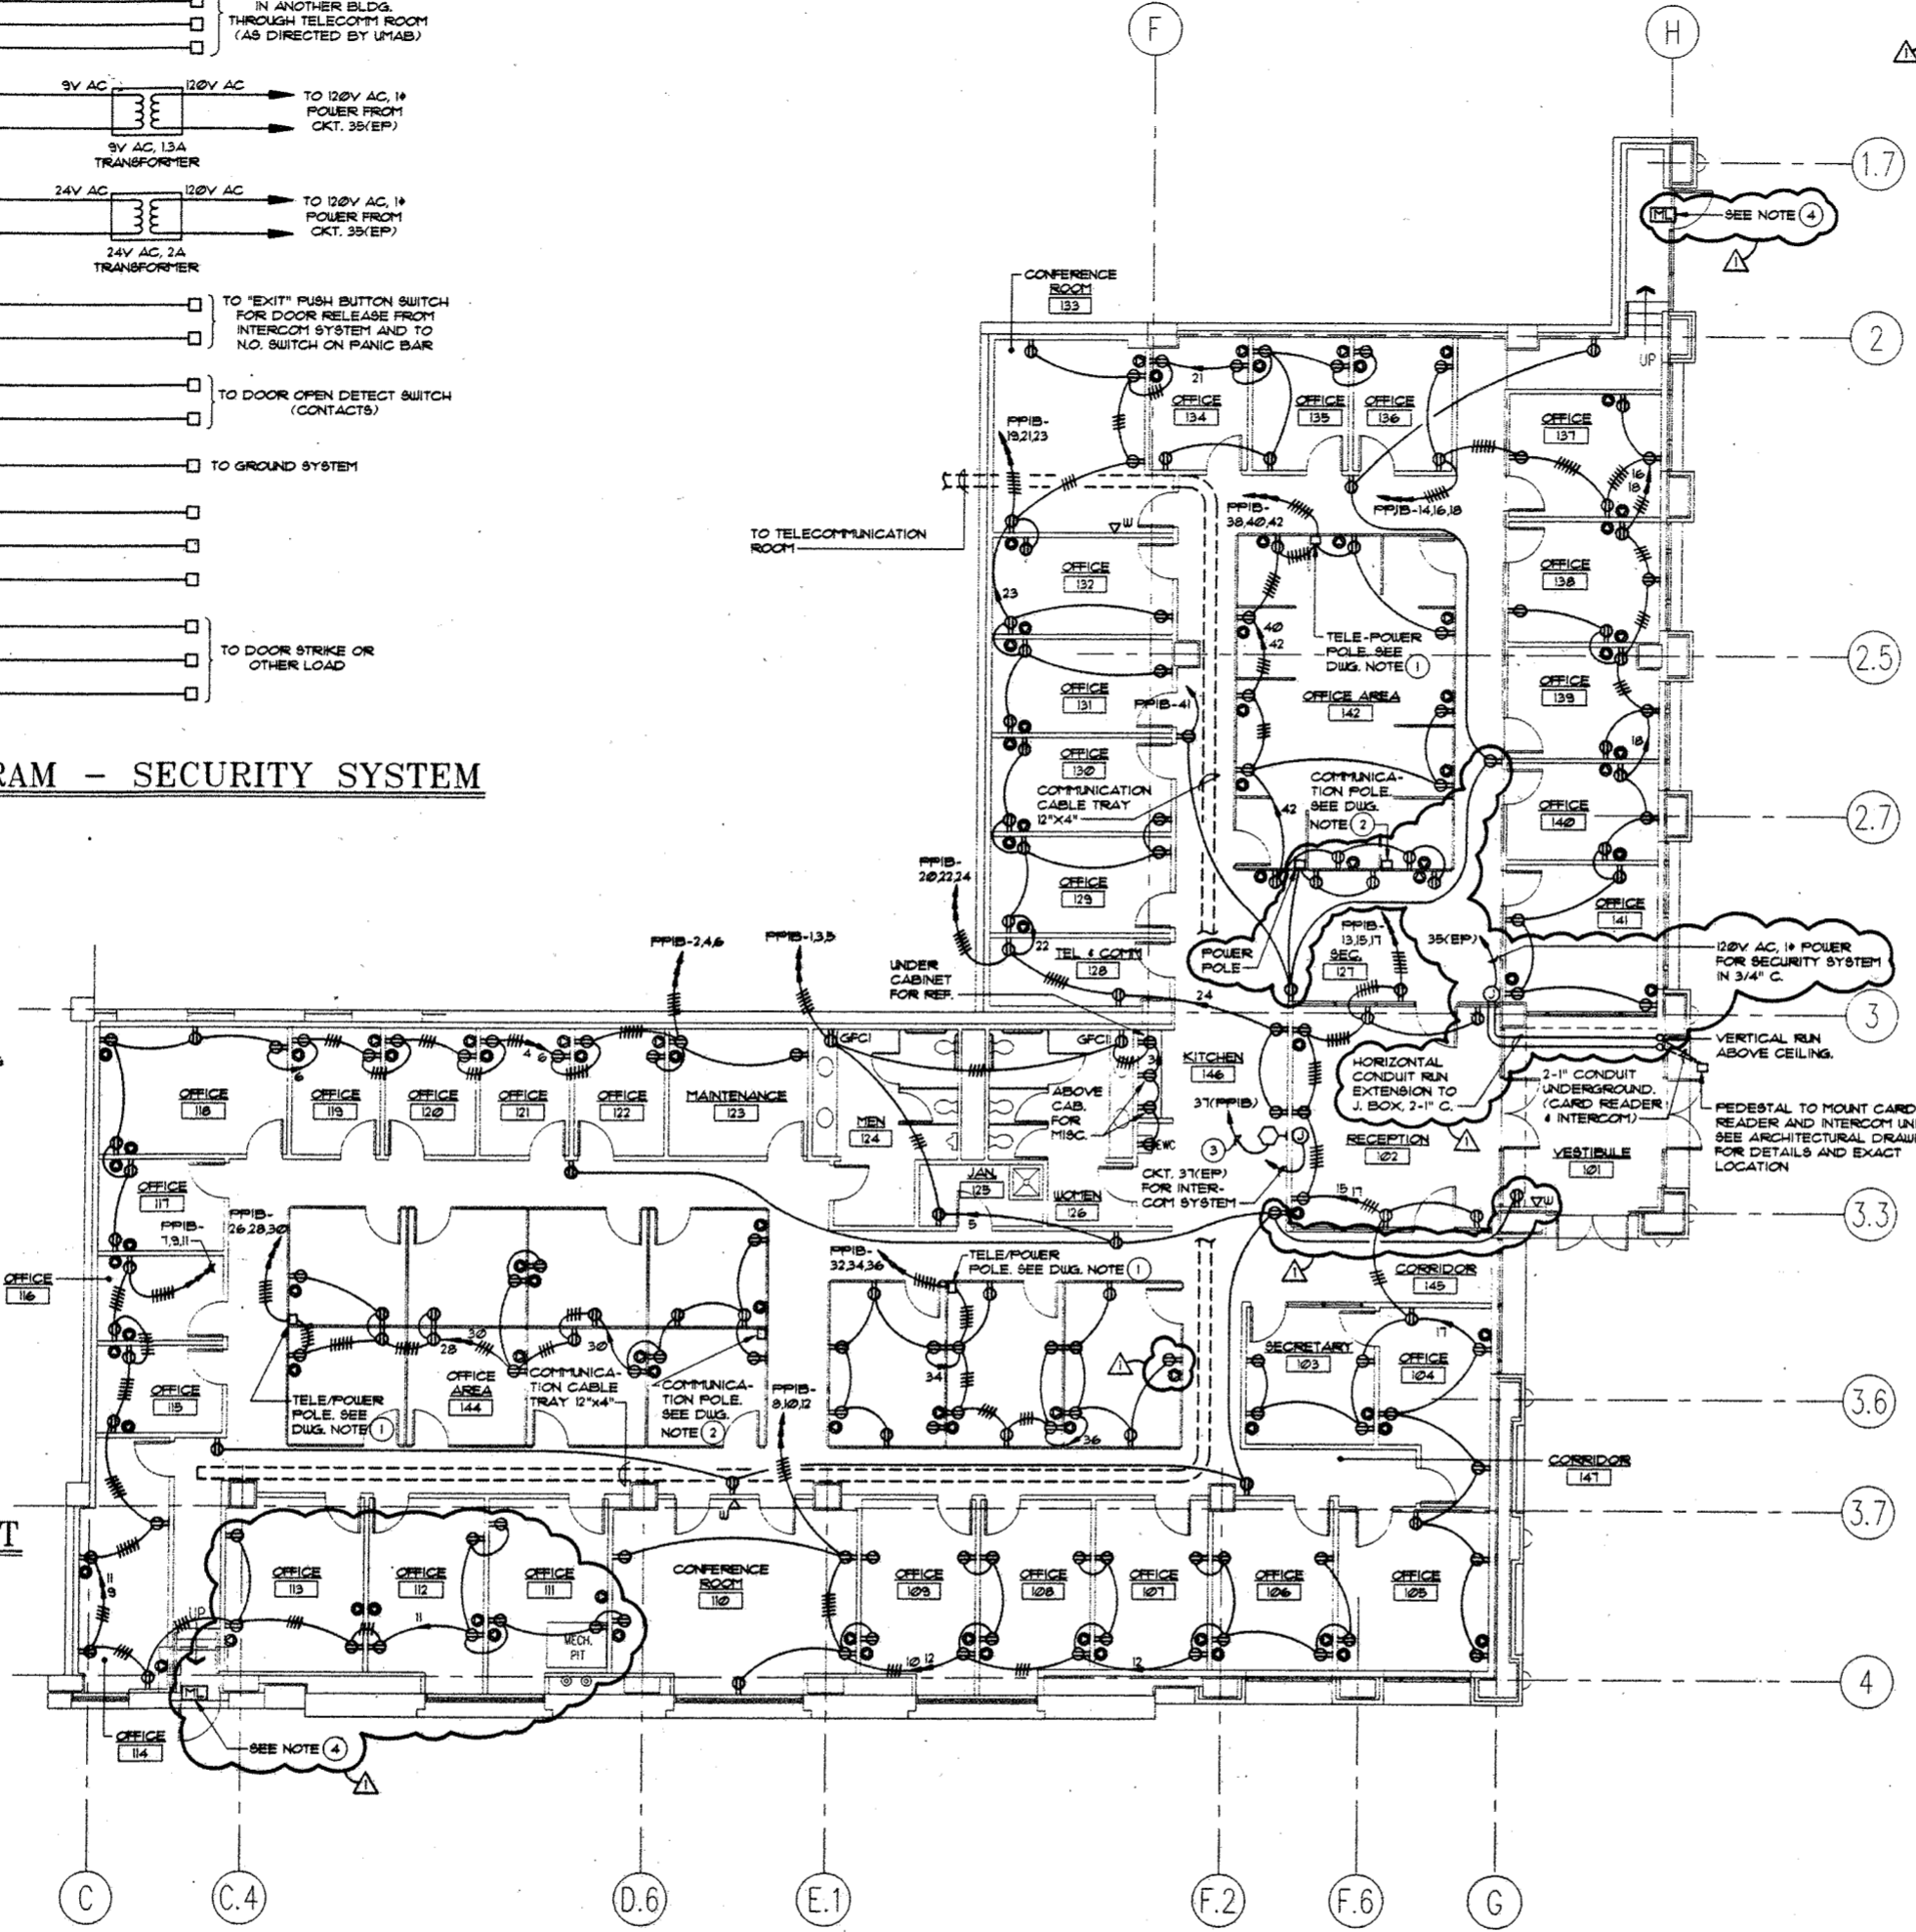


3 OFFICE FLOOR PLAN - POWER
E-1 SCALE: 1/8" = 1'-0"
GROUND FLOOR

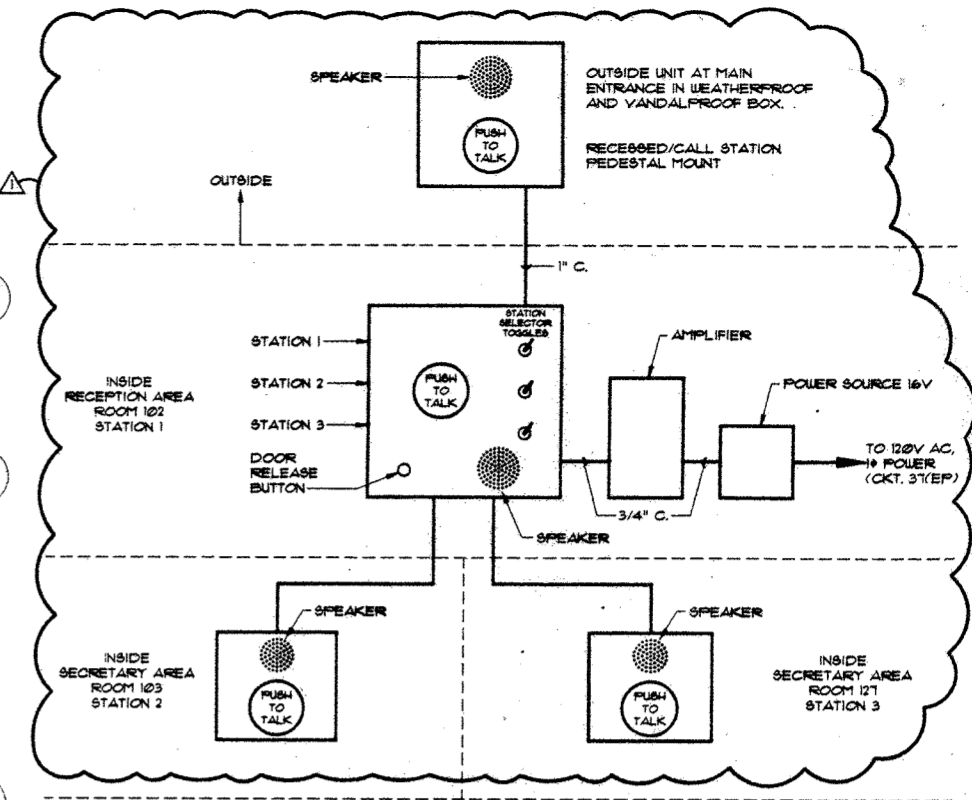

4 INTERCOM SYSTEM SCHEMATIC
E-1 NO SCALE

- INTERCOM NOTES:**
- THE SYSTEM SHALL CONSIST OF ONE MASTER STATION (NO.1) WITH CONTROL TOGGLE SWITCHES TO BE USED AS SELECTOR SWITCHES AMONG STATIONS 1, 2 AND 3 TO ANSWER CALL FROM EXTERIOR UNIT.
 - AMPLIFIER.
 - POWER SOURCE UNIT.
 - TWO REMOTE STATIONS NO. 2 AND 3.
 - EXTERIOR UNIT PEDESTAL MOUNT.
 - THE INSTALLATION SHALL COMPLY WITH ADA CODE REQUIREMENTS.
 - THE WIRING SHALL MEET THE MANUFACTURER'S REQUIREMENTS & RECOMMENDATIONS, INCLUDING VOLTAGE DROPS CONSIDERATION.
 - THE SYSTEM SHALL MATCH THE UMAB STANDARDS OR BE APPROVED BY UMAB.
 - THE EXACT LOCATION OF THE DESK TOP UNITS IN THE RESPECTIVE ROOMS SHALL BE FIELD DETERMINED BASED ON FURNITURE LAYOUT.
 - THE SYSTEM SHALL BE MANUFACTURED BY HOUSING DEVICES INC. OR EXECUTIVE OR EQUAL.

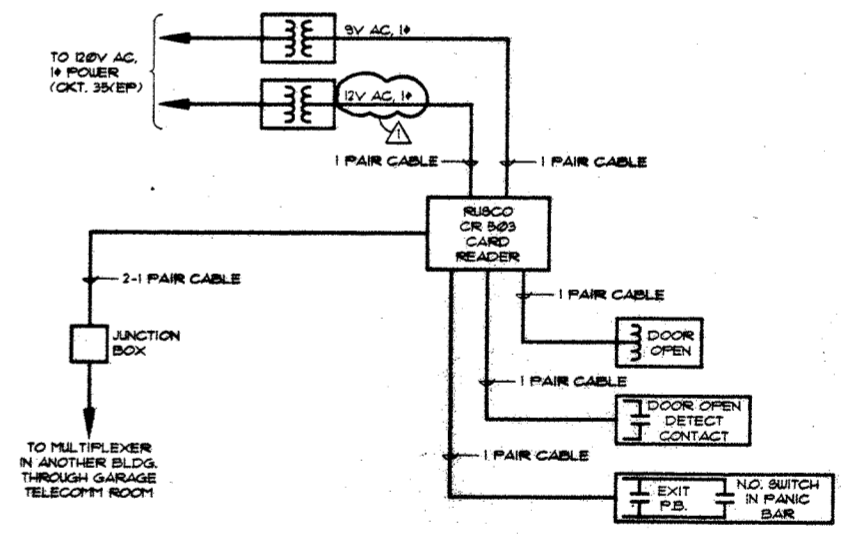

5 SECURITY ONE-LINE DIAGRAM
E-1 NO SCALE

- SECURITY NOTES:**
- USE CABLES AS RECOMMENDED BY THE MANUFACTURER.
 - INSTALLATION AND GROUNDING SHALL BE MADE AS RECOMMENDED BY THE MANUFACTURER.
 - CARD READER SYSTEM SHALL MATCH THE UMAB STANDARDS TO INTERFACE THEIR CAMPUS SYSTEM AND SHALL BE RUBCO CARD READER SERIES CR-505.
 - CARD READER SHALL BE MOUNTED FLUSH IN THE PEDESTAL MEETING ALL ADA REQUIREMENTS. SEE ARCHITECTURAL DRAWING FOR PEDESTAL DETAILS.
 - CARD READER ENCLOSURE SHALL BE WEATHERPROOF AND VANDALPROOF.
 - THE FOLLOWING OPTIONS SHOULD BE INCLUDED WITH THE CARD READER:
 - (AS) ALARM SHUNT FEATURE
 - (TPS) TAMPER ALARM SWITCH
 - (ROB) READER OVERRIDE FEATURE
 - (FED) FORCED ENTRY DETECTION
 - (DMS) DEGRADED MODE FEATURE
 - WEATHERIZED KIT INCLUDING HEATER

SCALE: 1/8" = 1'-0"

APRIL 3, 1995 AS-BUILTS

WHITING-TURNER
CONTRACTING COMPANY
DESIGNER


BWJ
DESIGNER

PENN STREET PARKING FACILITY
UNIVERSITY OF MARYLAND AT BALTIMORE

REVISIONS		
NO.	DATE	BY
	4/21/94	R.P.

OFFICE FLOOR PLAN POWER
DRAWING NO. E-1
SCALE: 1/8" = 1'-0"
DATE: APRIL 21, 1994
PROJECT NO. 93001
DESIGN DRAWN. C.Y.K.D.
R.P. RSB R.P.

G:\PROJECTS\924702\1 04/27/94 08:25

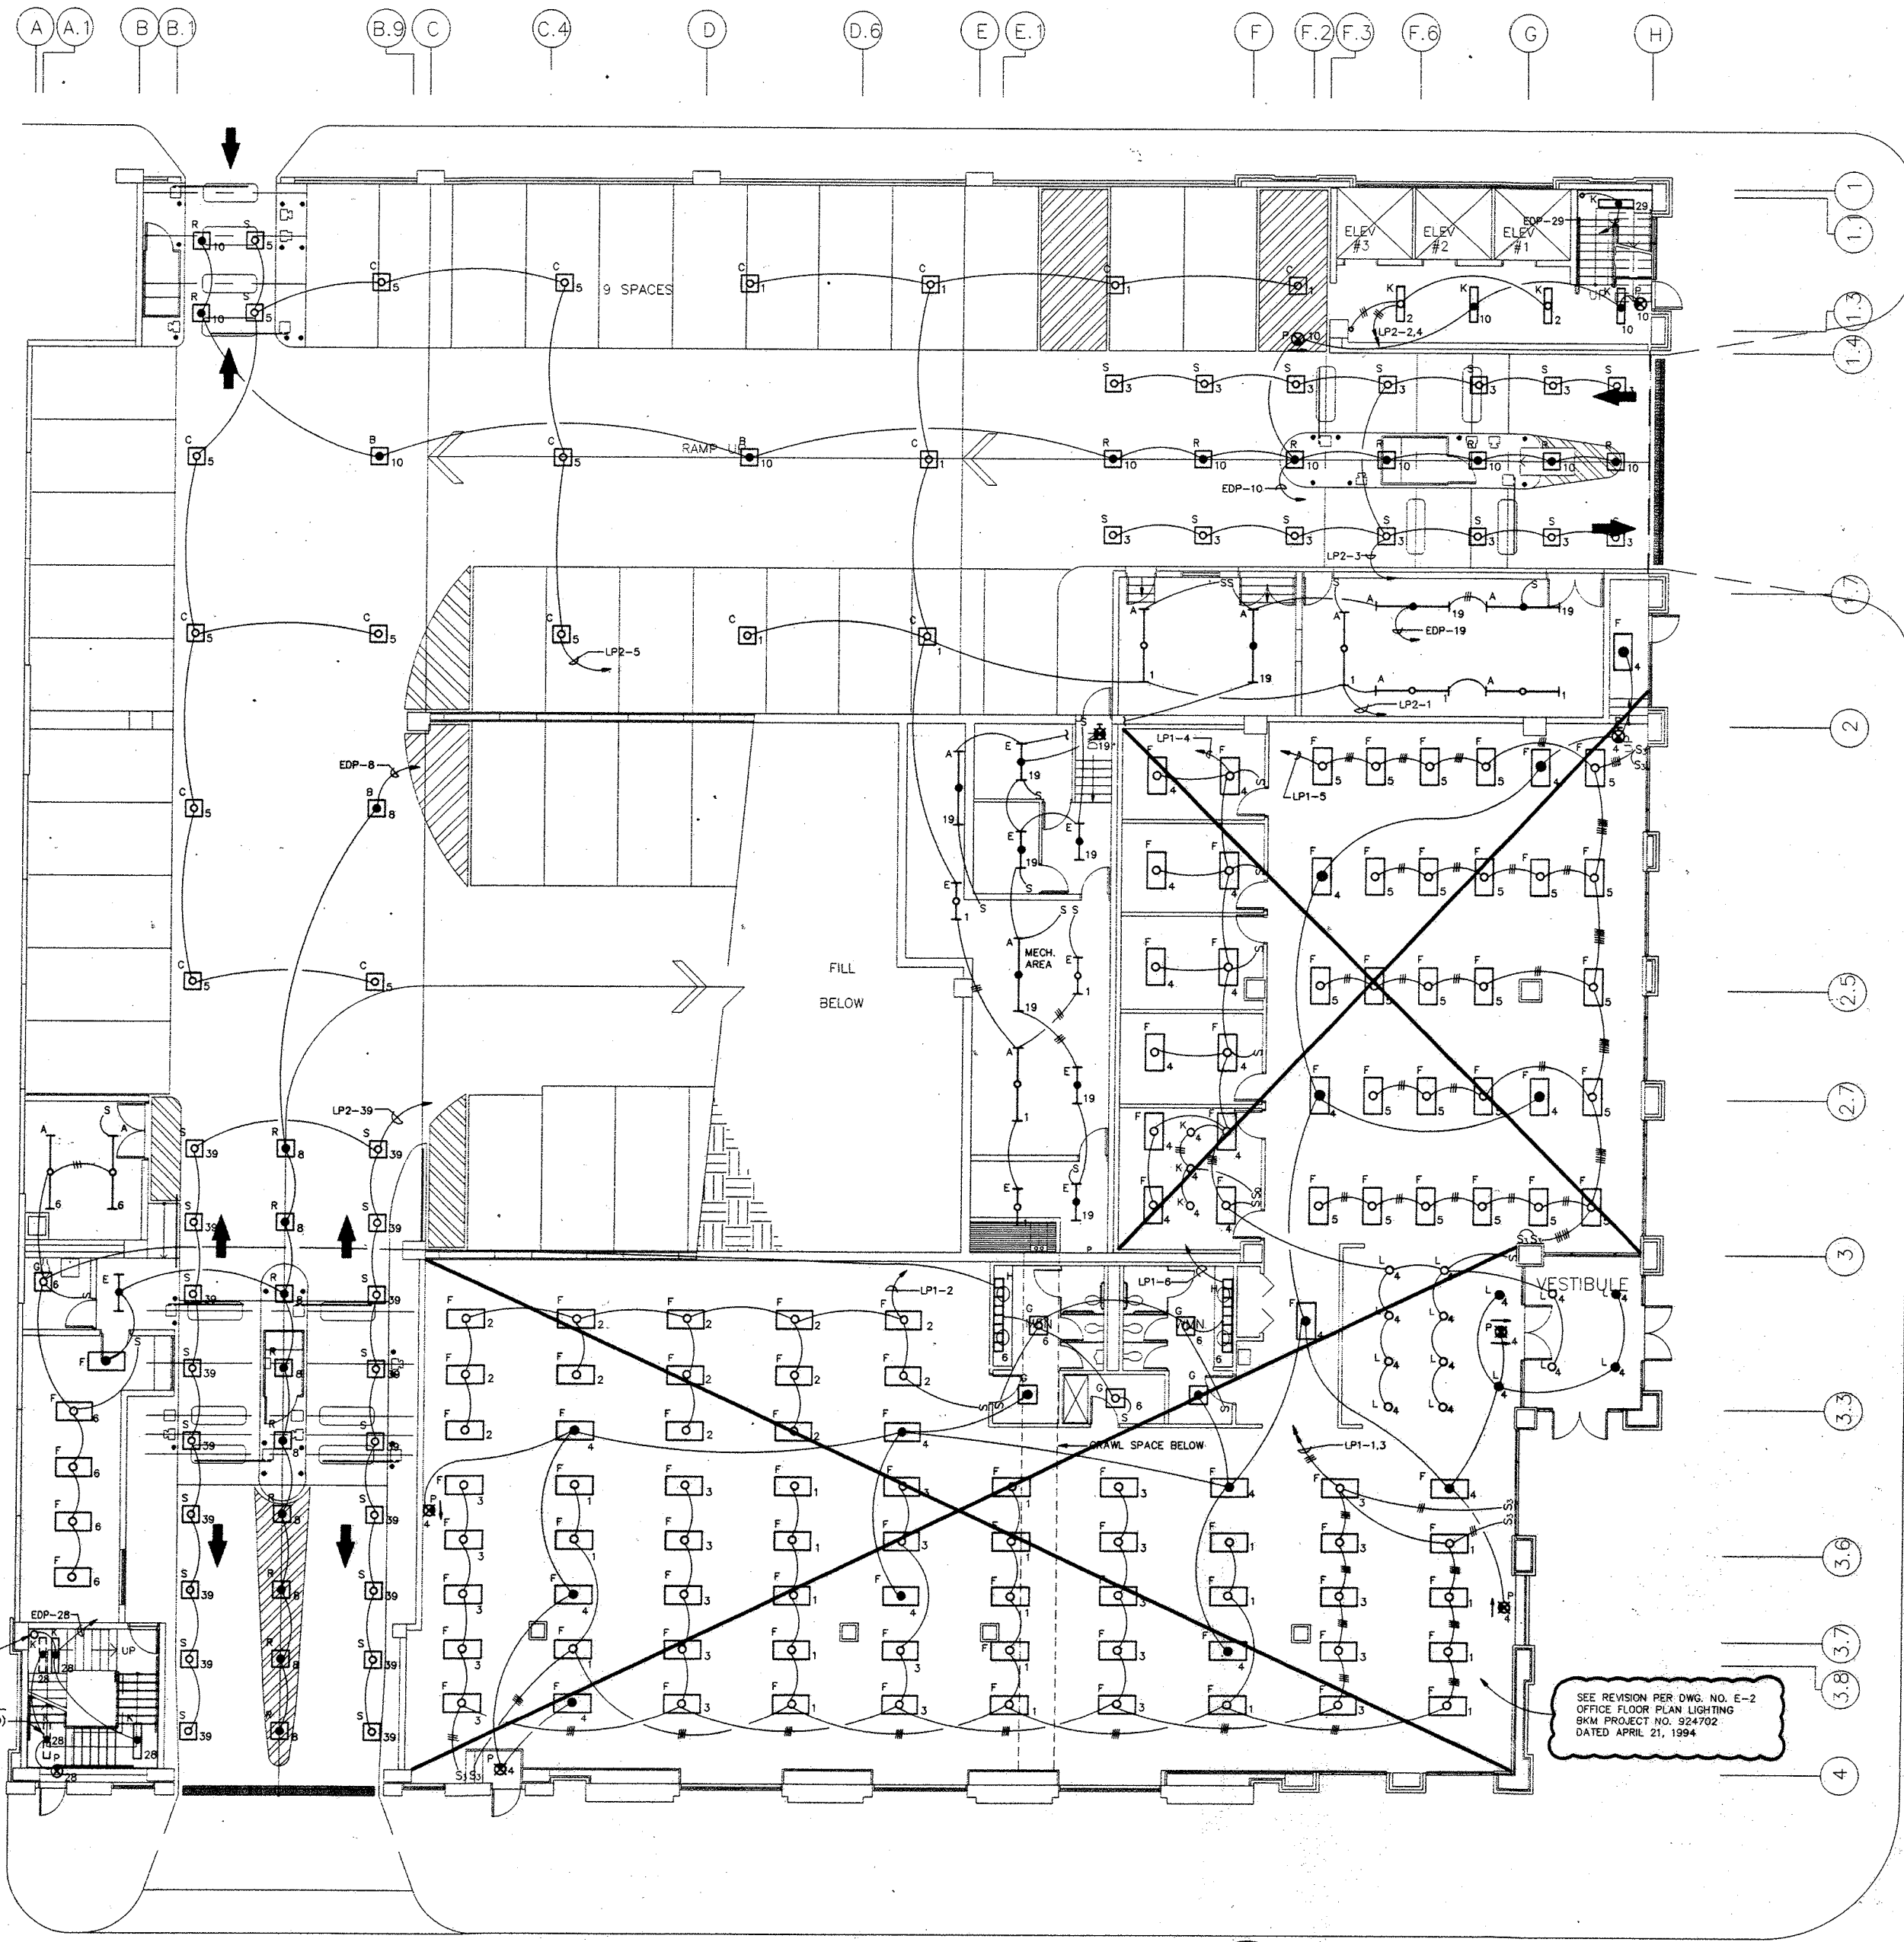

CONDUIT UP TO NEXT FLOOR FOR LIGHTING
 LIGHTING FIXTURE UNDER THE STAIRWAY (TYP. OF TWO)

SEE REVISION PER DWG. NO. E-2
 OFFICE FLOOR PLAN LIGHTING
 BKM PROJECT NO. 924702
 DATED APRIL 21, 1994

GRADE FLOOR PLAN - LIGHTING
 SCALE: 1/8"=1'-0"



G:\PROJECTS\924700\EA4 03/23/95 10:23

WHITING-TURNER
 CONTRACTING COMPANY
 DESMAN ASSOCIATES
 ARCHITECTS ENGINEERS

BURDETTE, KOEHLER, MURPHY &
 ASSOCIATES, INC.
 CONSULTING CONTRACTOR
 100 N. WASHINGTON ST., BALTIMORE, MD 21201
 TEL. 410.524.1100 FAX 410.524.1101

PENN STREET PARKING FACILITY
 UNIVERSITY OF MARYLAND AT BALTIMORE

REVISIONS		
NO.	DATE	BY
11-24-93		R.P.
6-24-1993		

GRADE FLOOR PLAN LIGHTING

DRAWING NO. **E-4**

SCALE: 1/8"=1'-0"


DATE: 6-24-1993

PROJECT NO. J-343

DESIGN	DRAWN	CHKD.
R.P.	L.P.	R.N.S.

APRIL 3, 1995 AS-BUILTS

G:\PROJECTS\924760\ESA_03/23/95_10:22

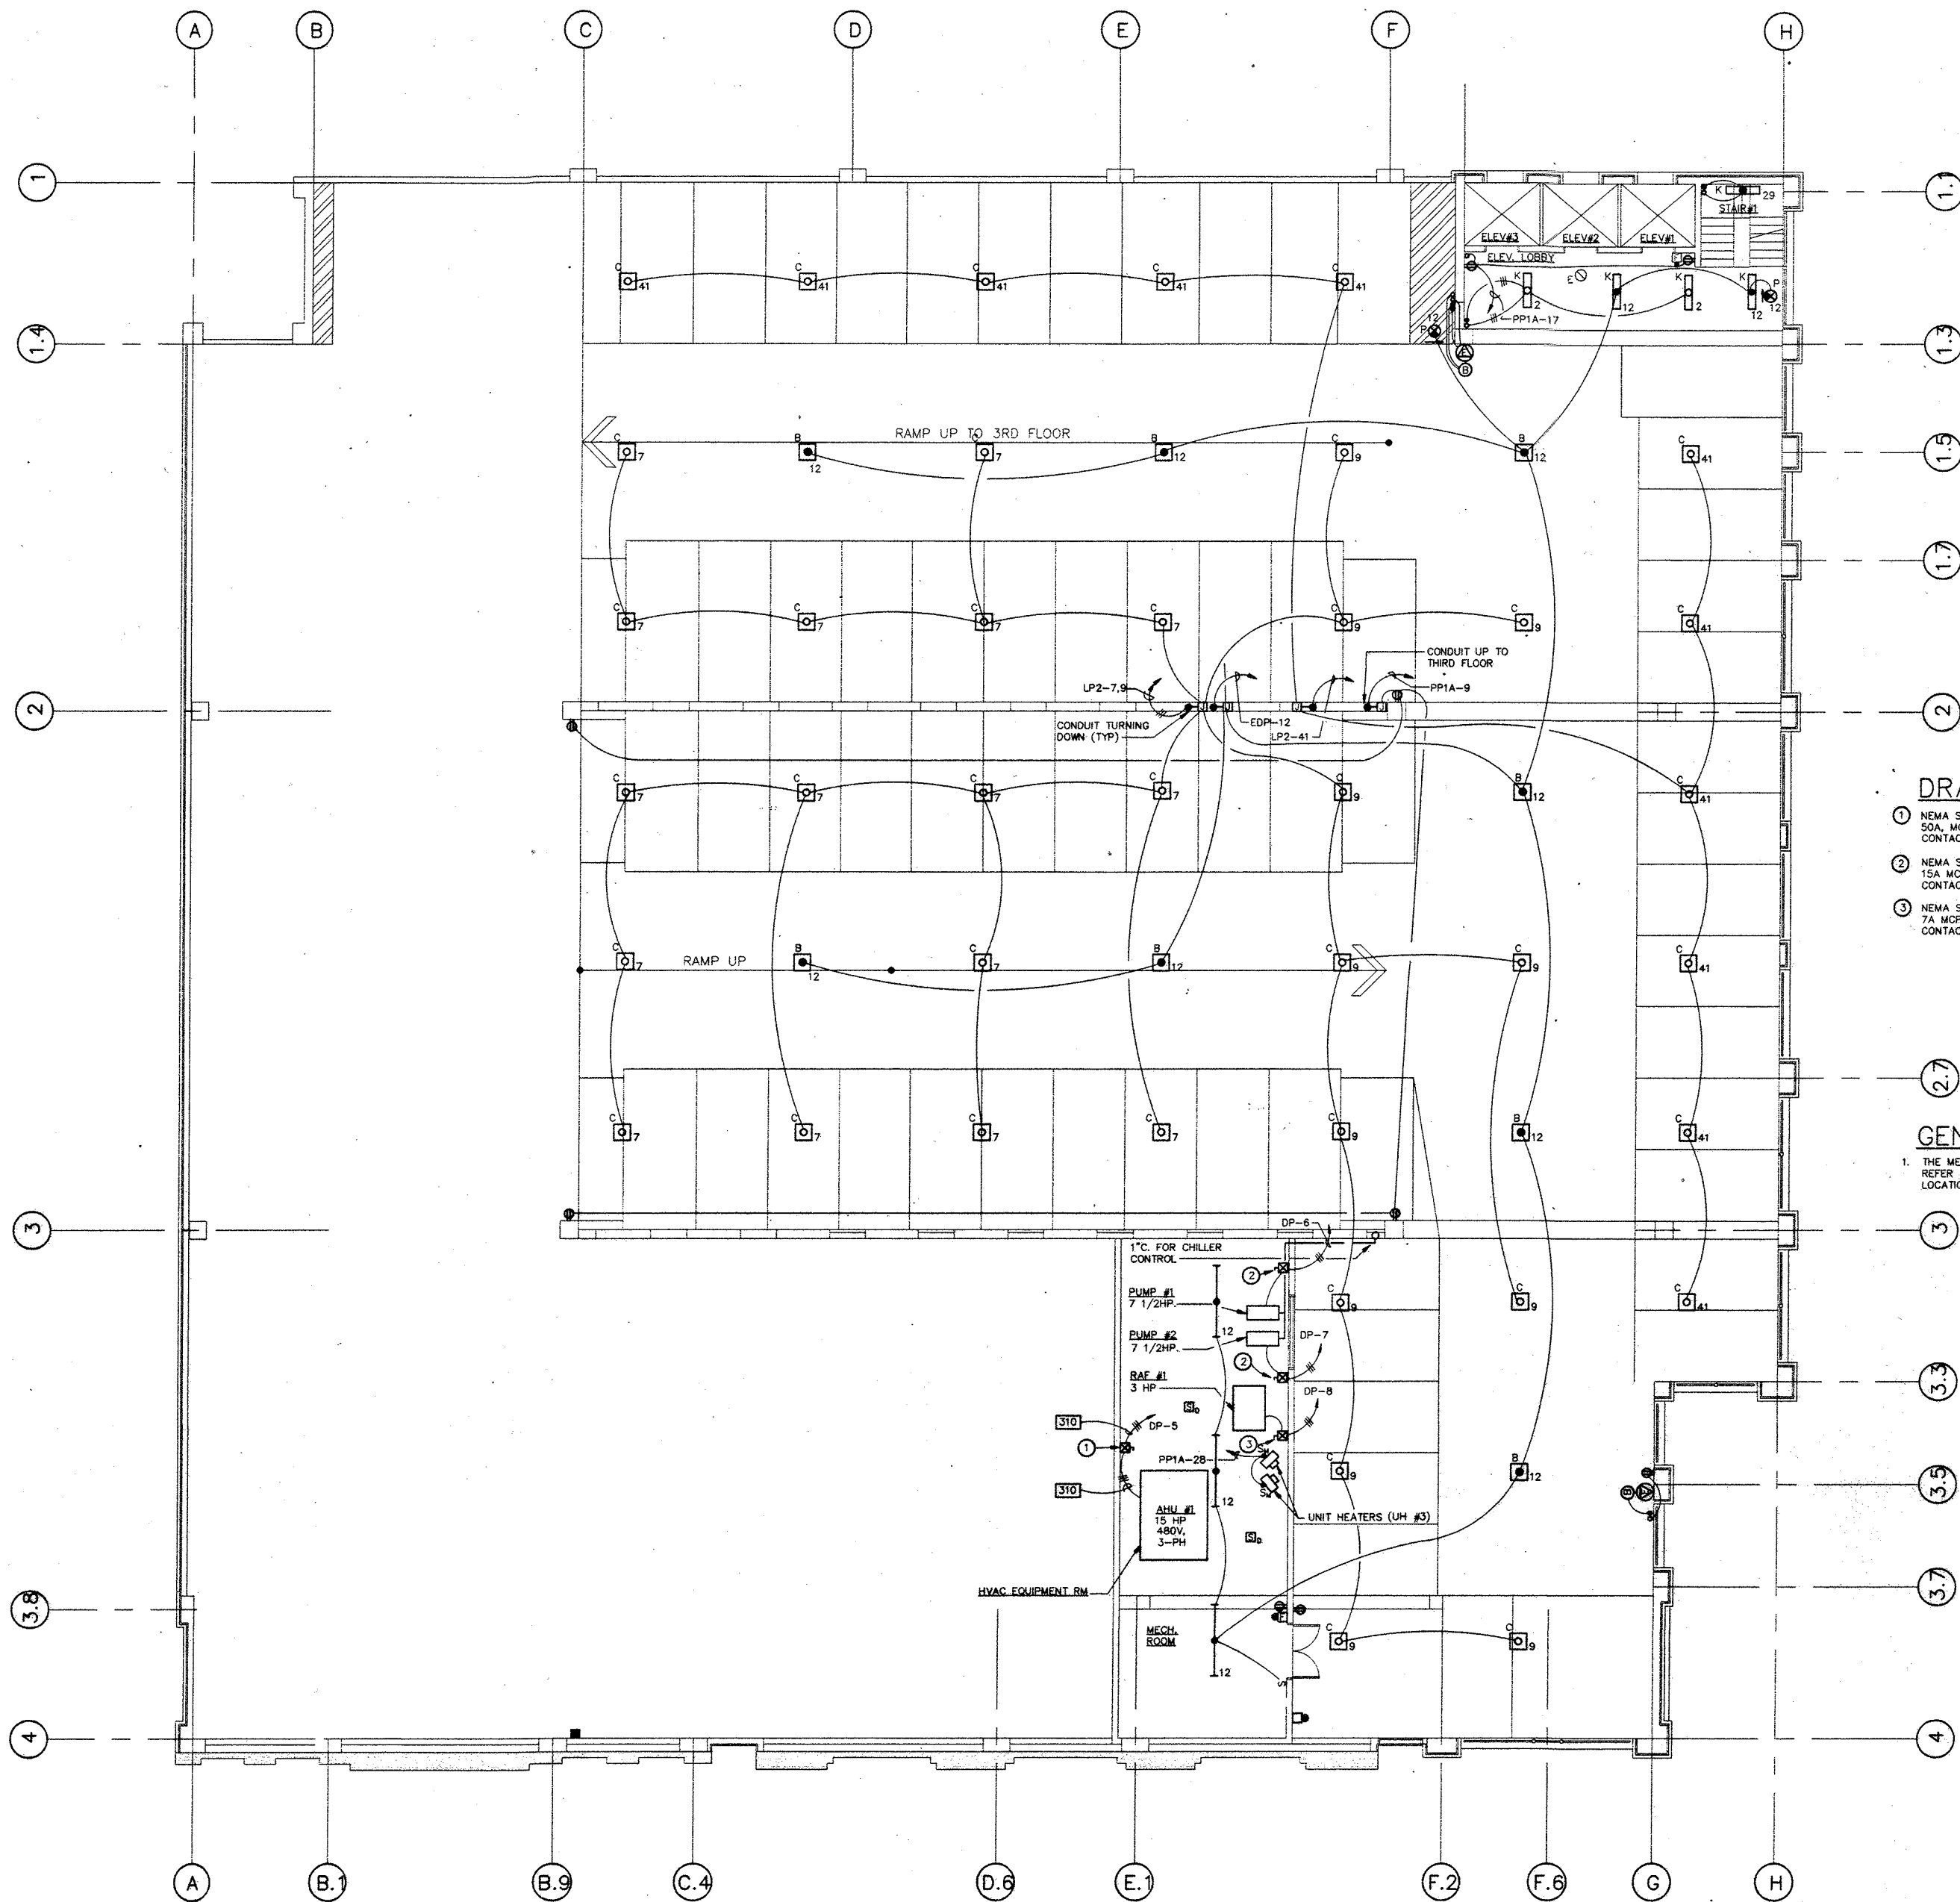

SECOND FLOOR PLAN - POWER & LIGHTING
SCALE: 1/8"=1'-0"




DRAWING NOTES:

- ① NEMA SIZE 2, 480V, 3P, COMBINATION MAGNETIC MOTOR STARTER WITH 50A MCP ADJ 150-500A IN NEMA 1 ENCLOSURE. PROVIDE AUXILIARY CONTACTS FOR ATC CONNECTION.
- ② NEMA SIZE 1, 480V, 3P, COMBINATION MAGNETIC MOTOR STARTER WITH 15A MCP ADJ 50-180A IN NEMA 1 ENCLOSURE. PROVIDE AUXILIARY CONTACTS FOR ATC CONNECTION.
- ③ NEMA SIZE 1, 480V, 3P, COMBINATION MAGNETIC MOTOR STARTER WITH 7A MCP ADJ 18-70A IN NEMA 1 ENCLOSURE. PROVIDE AUXILIARY CONTACTS FOR ATC CONNECTION.

GENERAL NOTES:

1. THE MECHANICAL SYSTEM EQUIPMENT ARE SHOWN APPROXIMATE. REFER TO CORRESPONDING MECHANICAL DRAWINGS FOR EXACT LOCATION.

GRAPHIC SCALE:

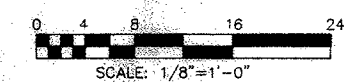

WHITING-TURNER
CONTRACTING COMPANY
DESIGN ASSOCIATES
ARCHITECTS ENGINEERS

BURDETTE, KOEHLER, MURPHY &
ASSOCIATES, INC.
CONSULTING ENGINEERS
REGISTERED PROFESSIONAL ENGINEERS
STATE OF MARYLAND, LICENSE NO. 11167

PENN STREET PARKING FACILITY
UNIVERSITY OF MARYLAND AT BALTIMORE

NO.	DATE	BY	R.P.

REVISIONS


SECOND FLOOR PLAN
POWER & LTG

DRAWING NO.
E-5

SCALE: 1/8"=1'-0"
DATE: 6-24-1993
PROJECT NO. J-343
DESIGN | DRAWN | CHKD.
R.P. | I.P. | R.N.S.

APRIL 3, 1995 AS-BUILTS

PROJECTS\924701-ESA 02/13/95 14:15

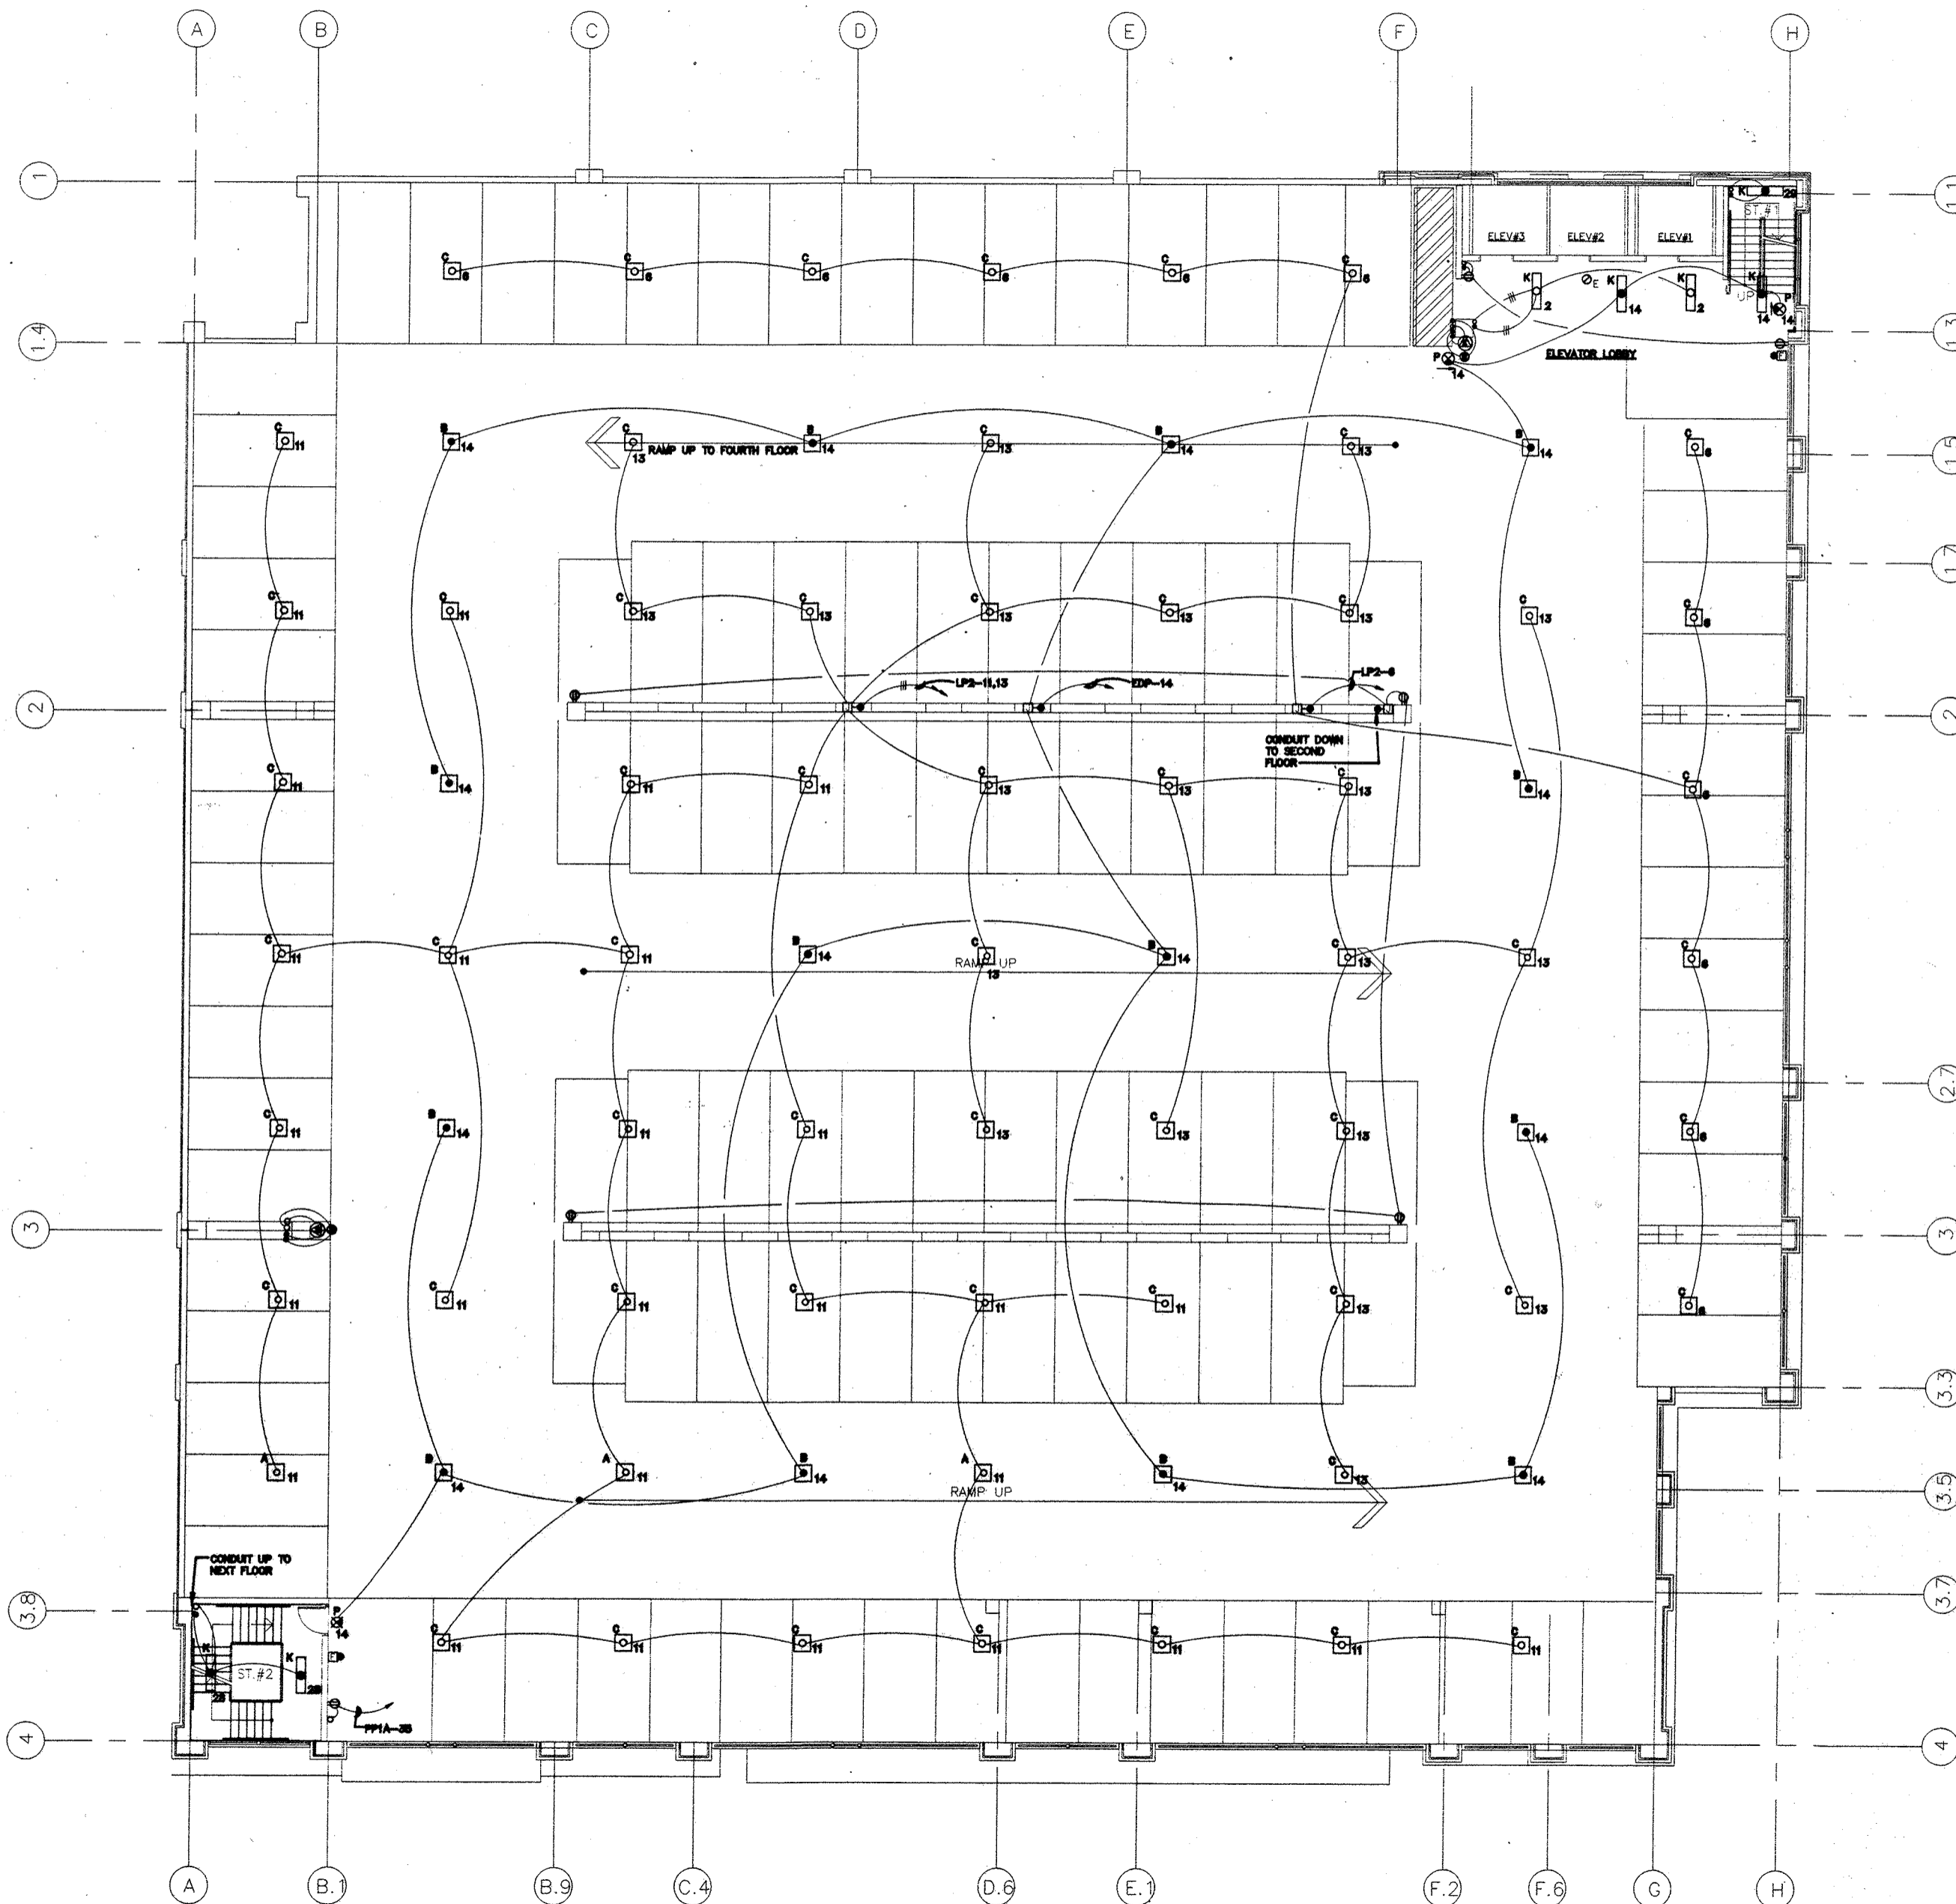

THIRD FLOOR PLAN - POWER AND LIGHTING

SCALE: 1/8"=1'-0"



WHITING-TURNER
CONTRACTING COMPANY
DISMAN ASSOCIATES
ARCHITECTS ENGINEERS

BURDETTE KOEHLER MURPHY &
ASSOCIATES, INC.
CONSULTING ENGINEERS
100 N. WASHINGTON ST., SUITE 1000
BALTIMORE, MARYLAND 21201

PENN STREET PARKING FACILITY
UNIVERSITY OF MARYLAND AT BALTIMORE

NO.	DATE	BY


THIRD FLOOR PLAN
POWER & LTG

DRAWING NO.
E-6

SCALE: 1/8"=1'-0"
 DATE: 6-24-1993
 PROJECT NO.: J-343
 DESIGN: R.P. DRAWN: L.P. CHKD: R.N.S.

APRIL 3, 1995 AS-BUILTS

PROJECTS\924700\ETA 02/13/95 14:17

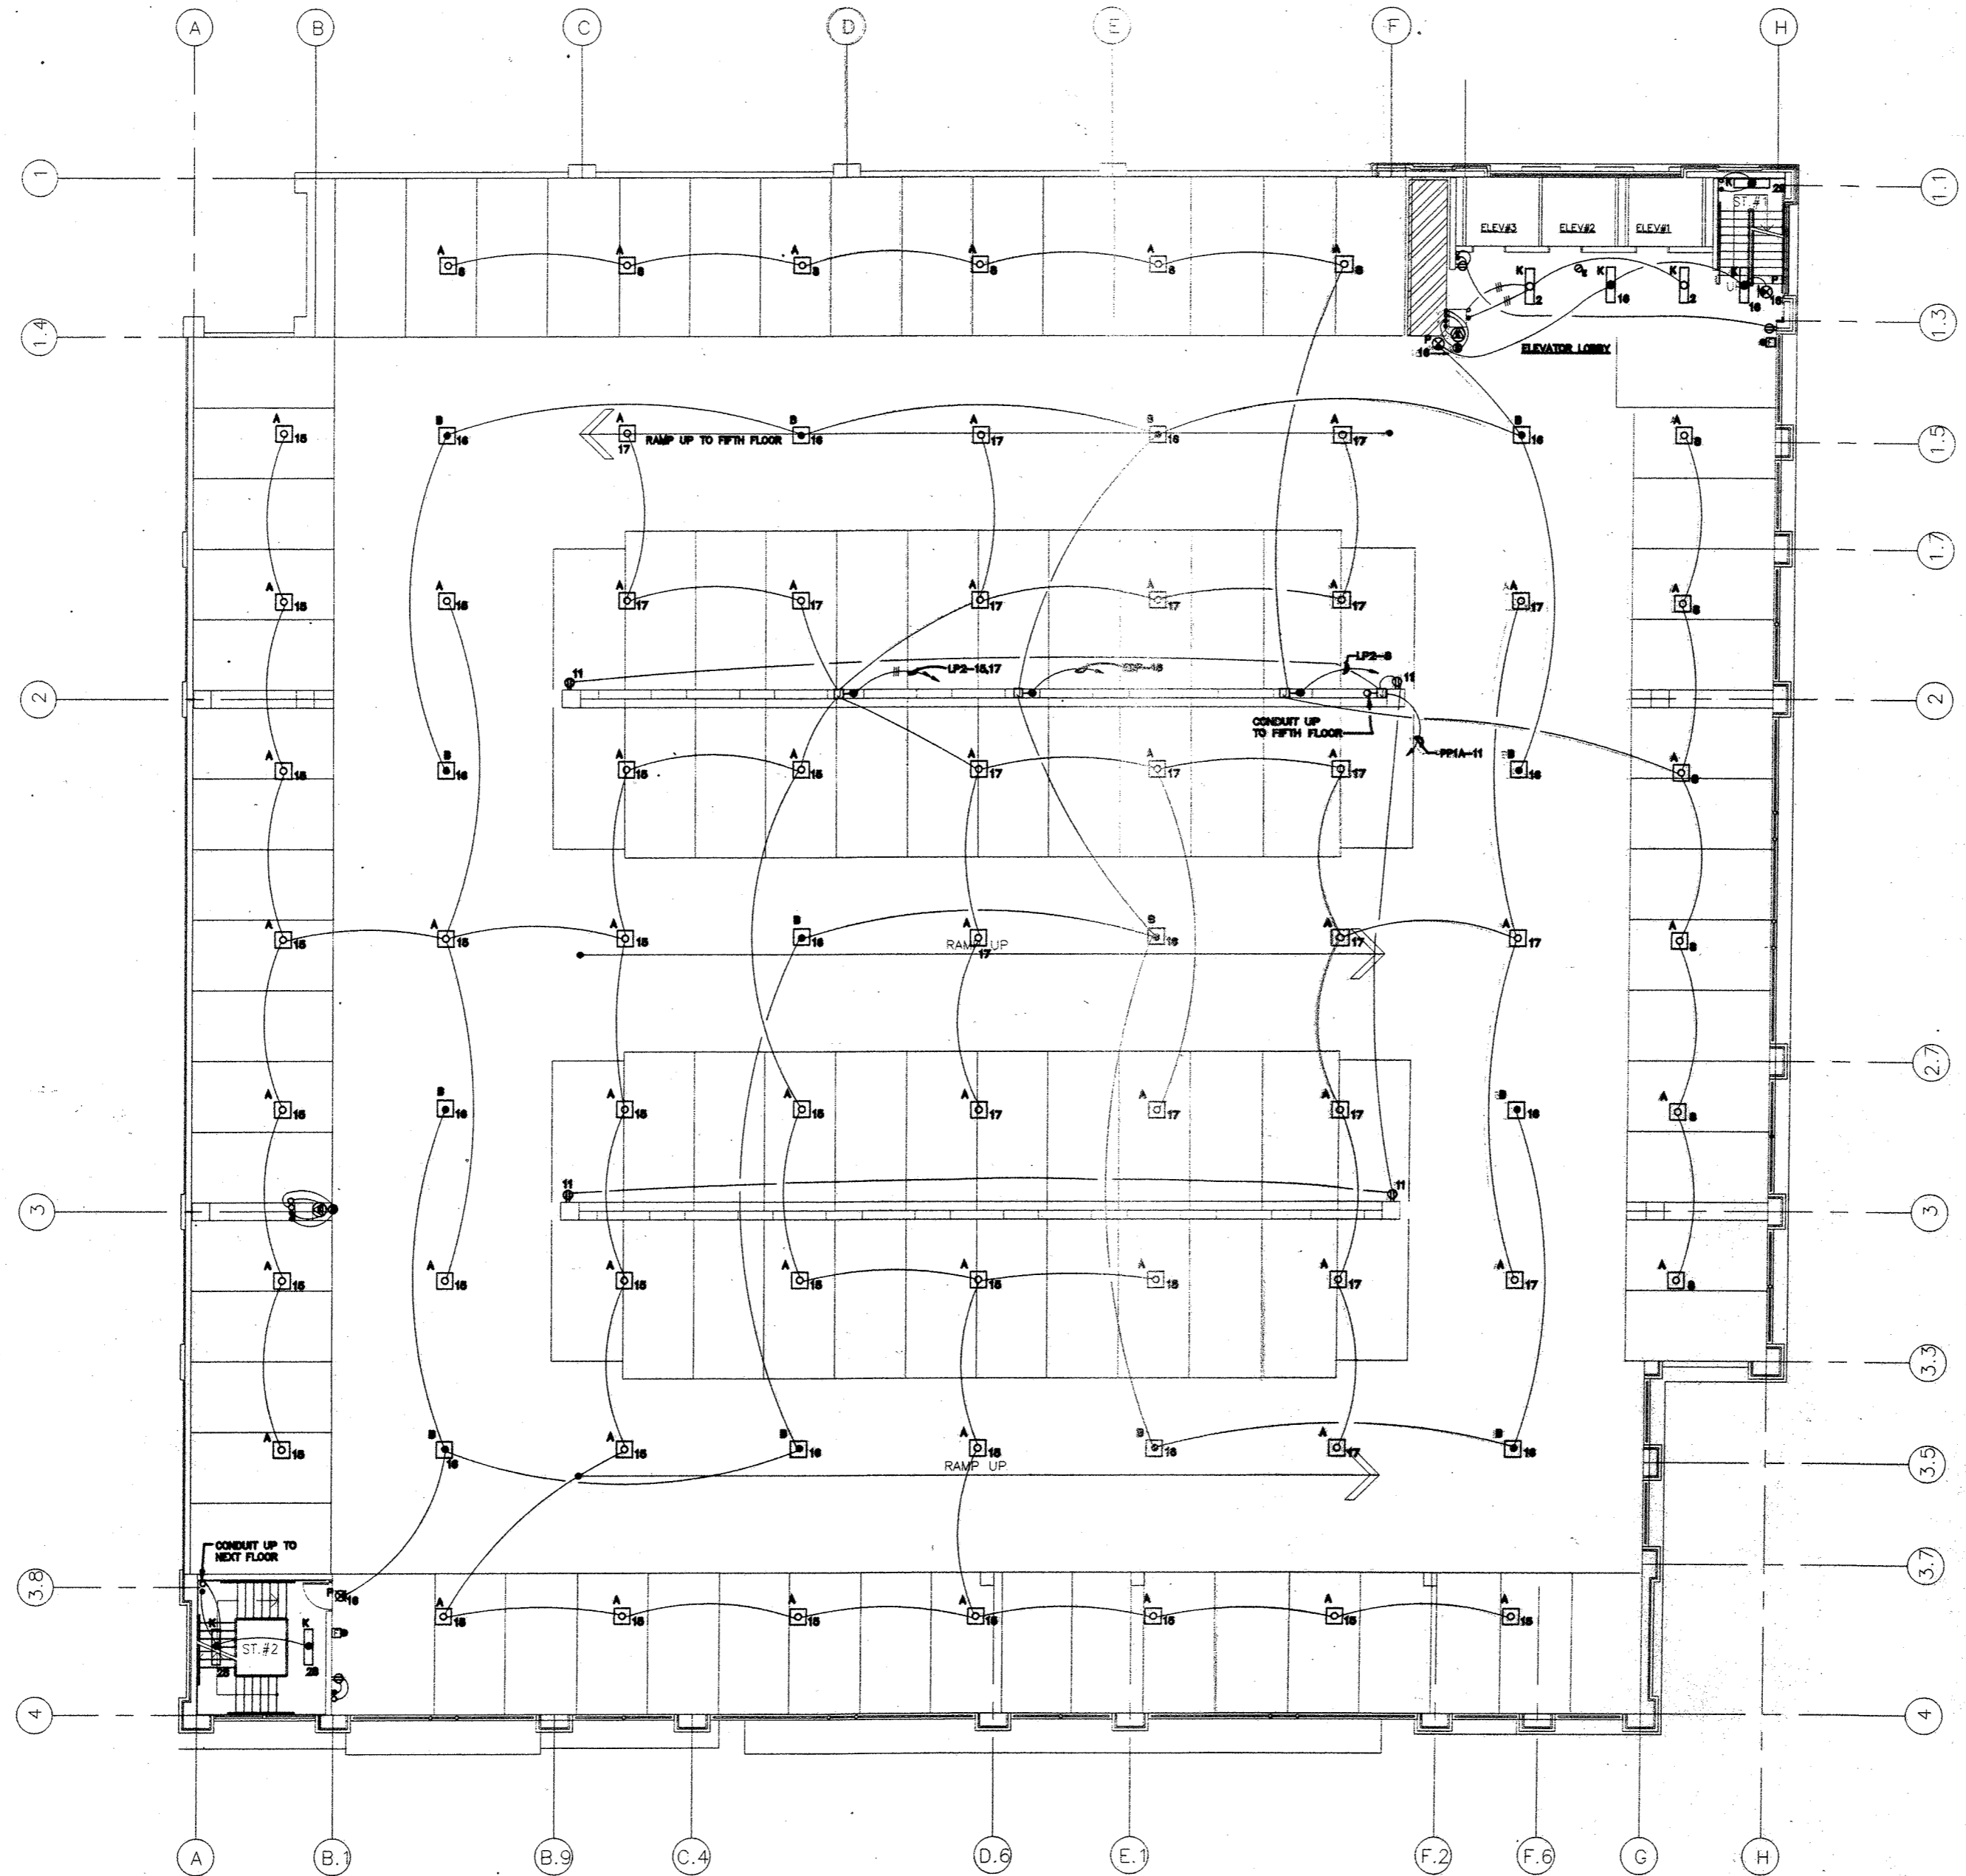

FOURTH FLOOR PLAN - POWER & LIGHTING
 SCALE: 1/8"=1'-0"



APRIL 3, 1995 AS-BUILTS

WHITING-TURNER
 CONTRACTING COMPANY
 DESMAN ASSOCIATES
 ARCHITECTS ENGINEERS

BURDETTE KOELLER MURPHY &
 ASSOCIATES, INC.
 CONSULTING ENGINEERS
 200 N. WASHINGTON ST., BALTIMORE, MD 21201

PENN STREET PARKING FACILITY
 UNIVERSITY OF MARYLAND AT BALTIMORE

NO.	DATE	BY
1	11-24-93	R.P.


REVISIONS		
NO.	DATE	BY

FOURTH FLOOR PLAN
 POWER & LTG
 DRAWING NO.
E-7

SCALE: 1/8"=1'-0"
 DATE: 6-24-1993
 PROJECT NO. J-343
 DESIGN DRAWN CHYKD.
 R.P. I.P. R.N.S.

BKM #924700

PROJECTS\024700\50A 02/13/95 14:19

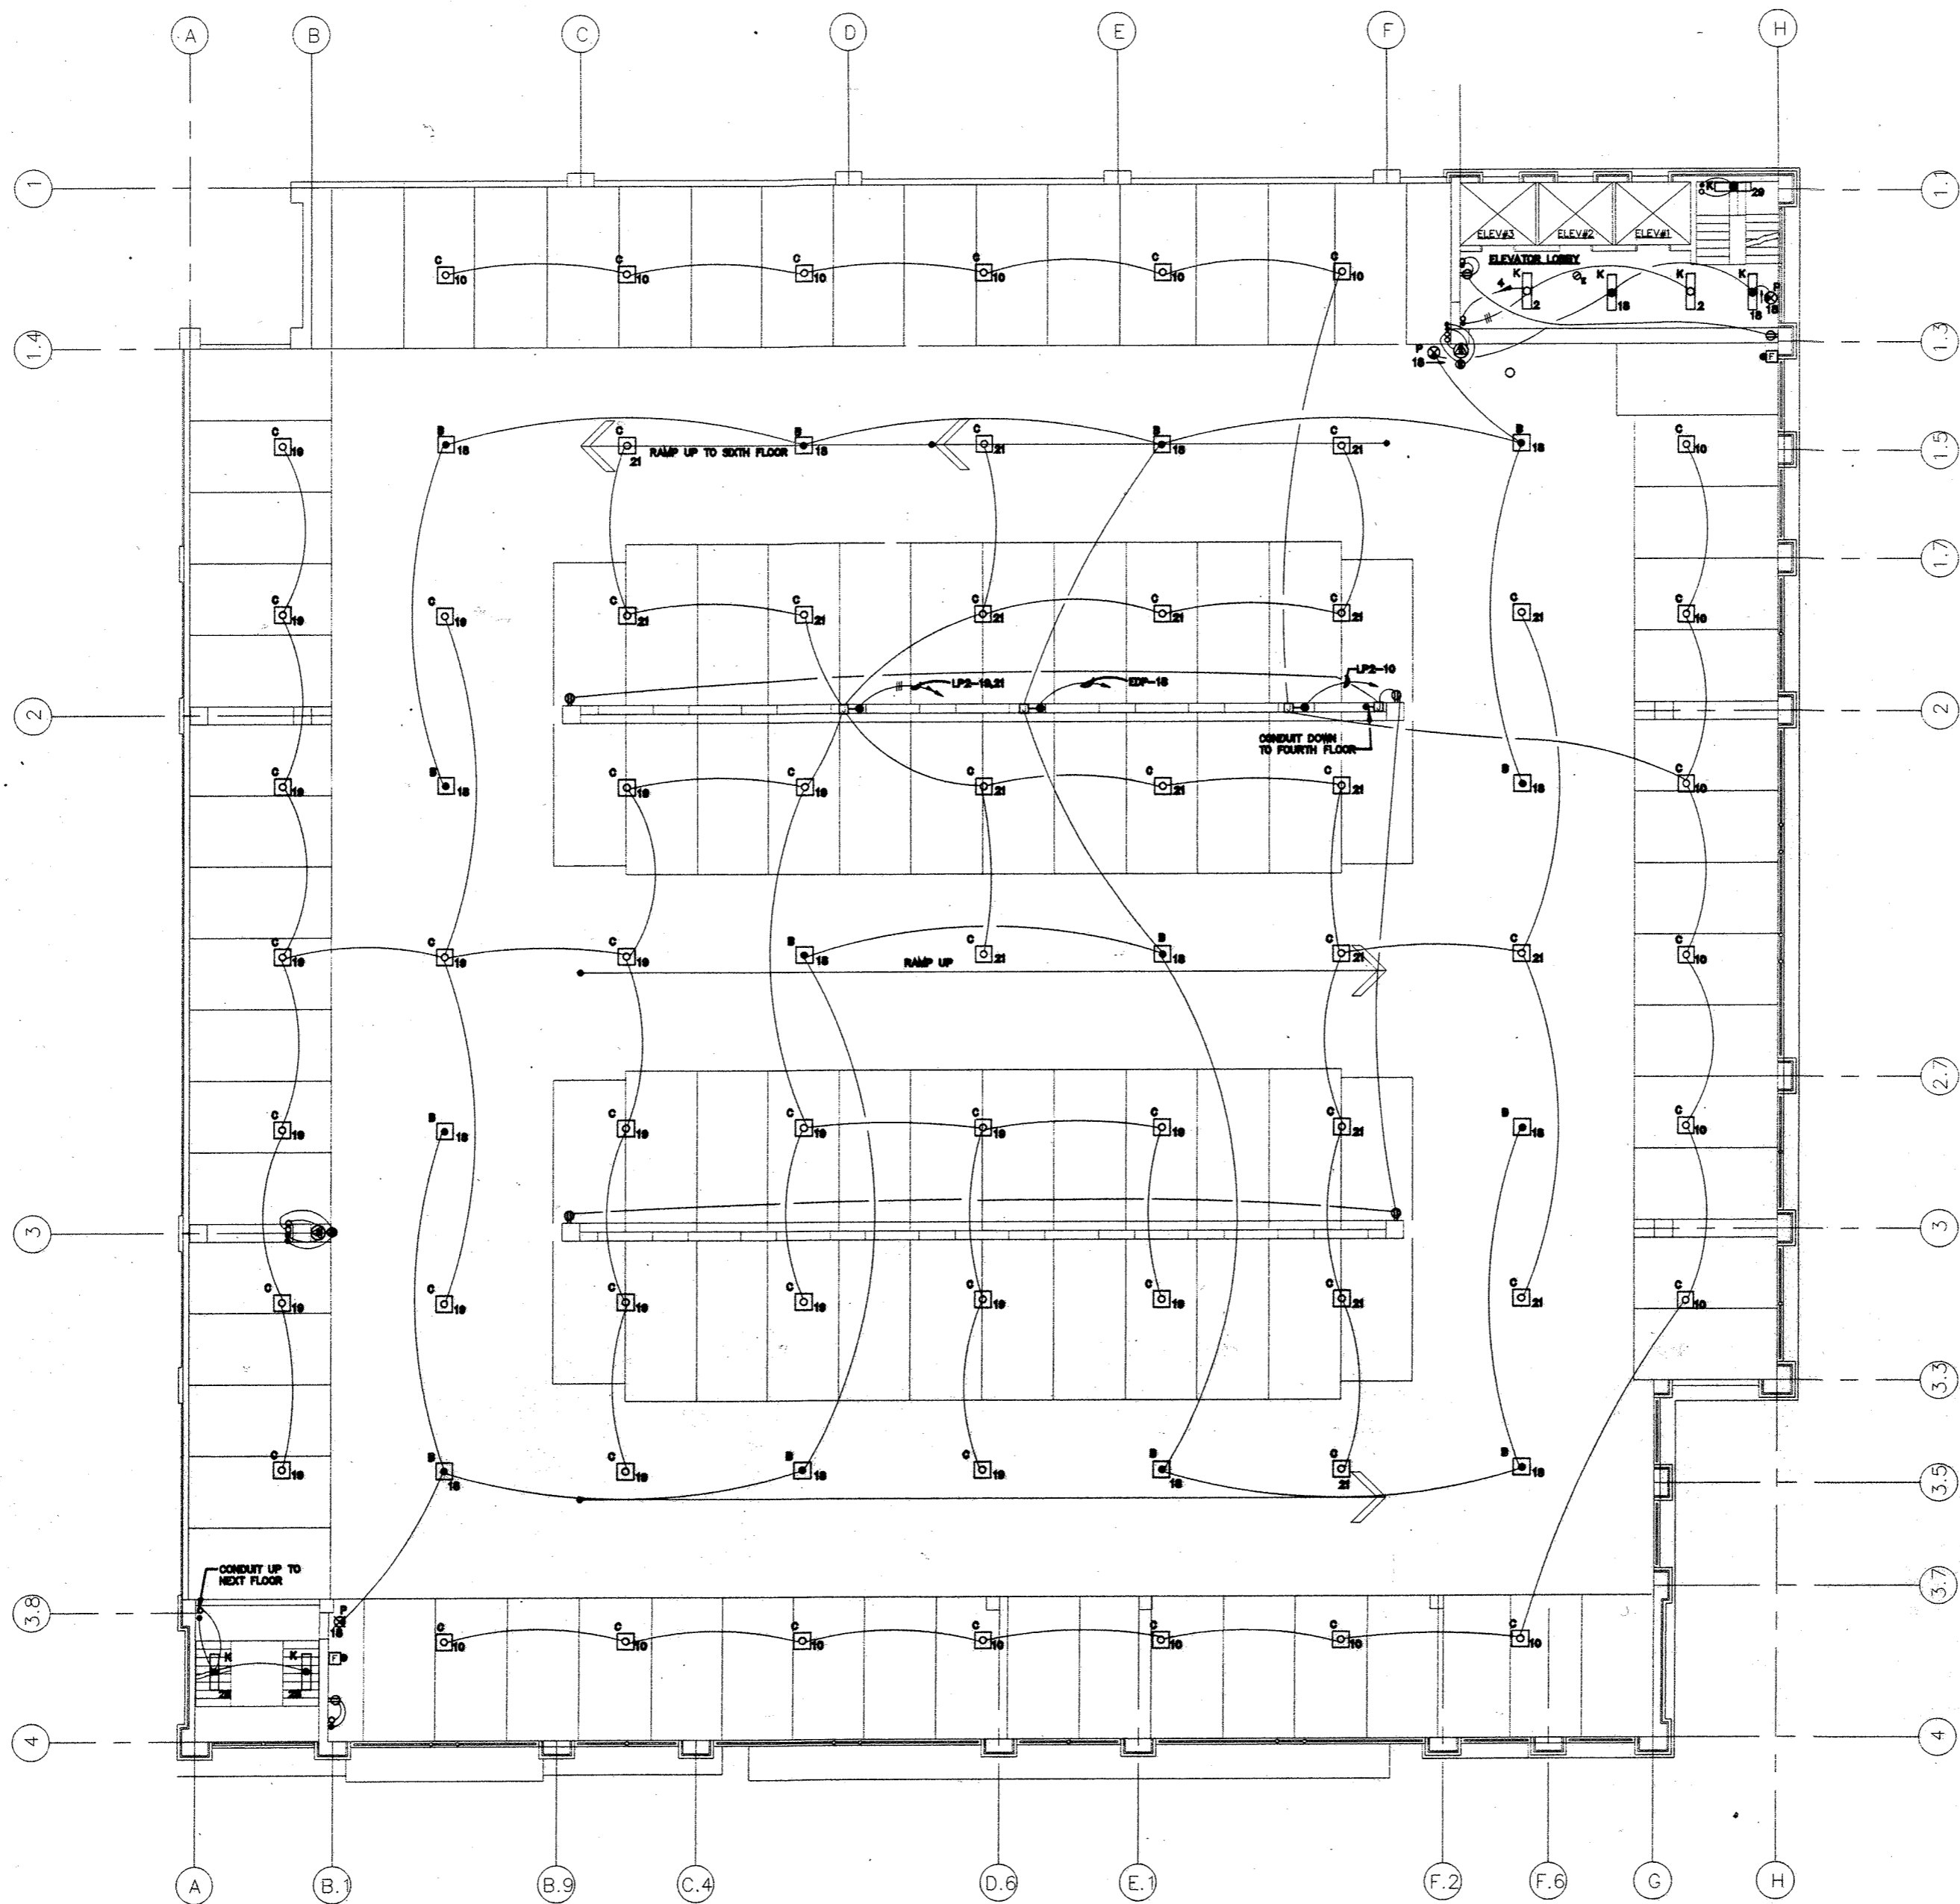

FIFTH FLOOR PLAN - POWER & LIGHTING
 SCALE: 1/8"=1'-0"



APRIL 3, 1995 AS-BUILTS

WHITING-TURNER
 CONTRACTING COMPANY
 DASMAN ASSOCIATES
 ARCHITECTS ENGINEERS

BURDETTE, KOEHLER, MURPHY &
 ASSOCIATES, INC.
 CONSULTING ENGINEERS
 200 N. CALVERT ST., BALTIMORE, MD 21202
 TEL. 410.524.2200 FAX 410.524.2201

PENN STREET PARKING FACILITY
 UNIVERSITY OF MARYLAND AT BALTIMORE

NO.	DATE	BY


FIFTH
 FLOOR PLAN
 POWER & LTG

DRAWING NO.
E-8

SCALE:	1/8"=1'-0"
DATE:	6-24-1993
PROJECT NO.:	J-343
DESIGN:	IP. CHYO.
R.P.:	R.N.S.

BKM #924700

C:\PROJECTS\024700\EDA 02/13/95 14:20

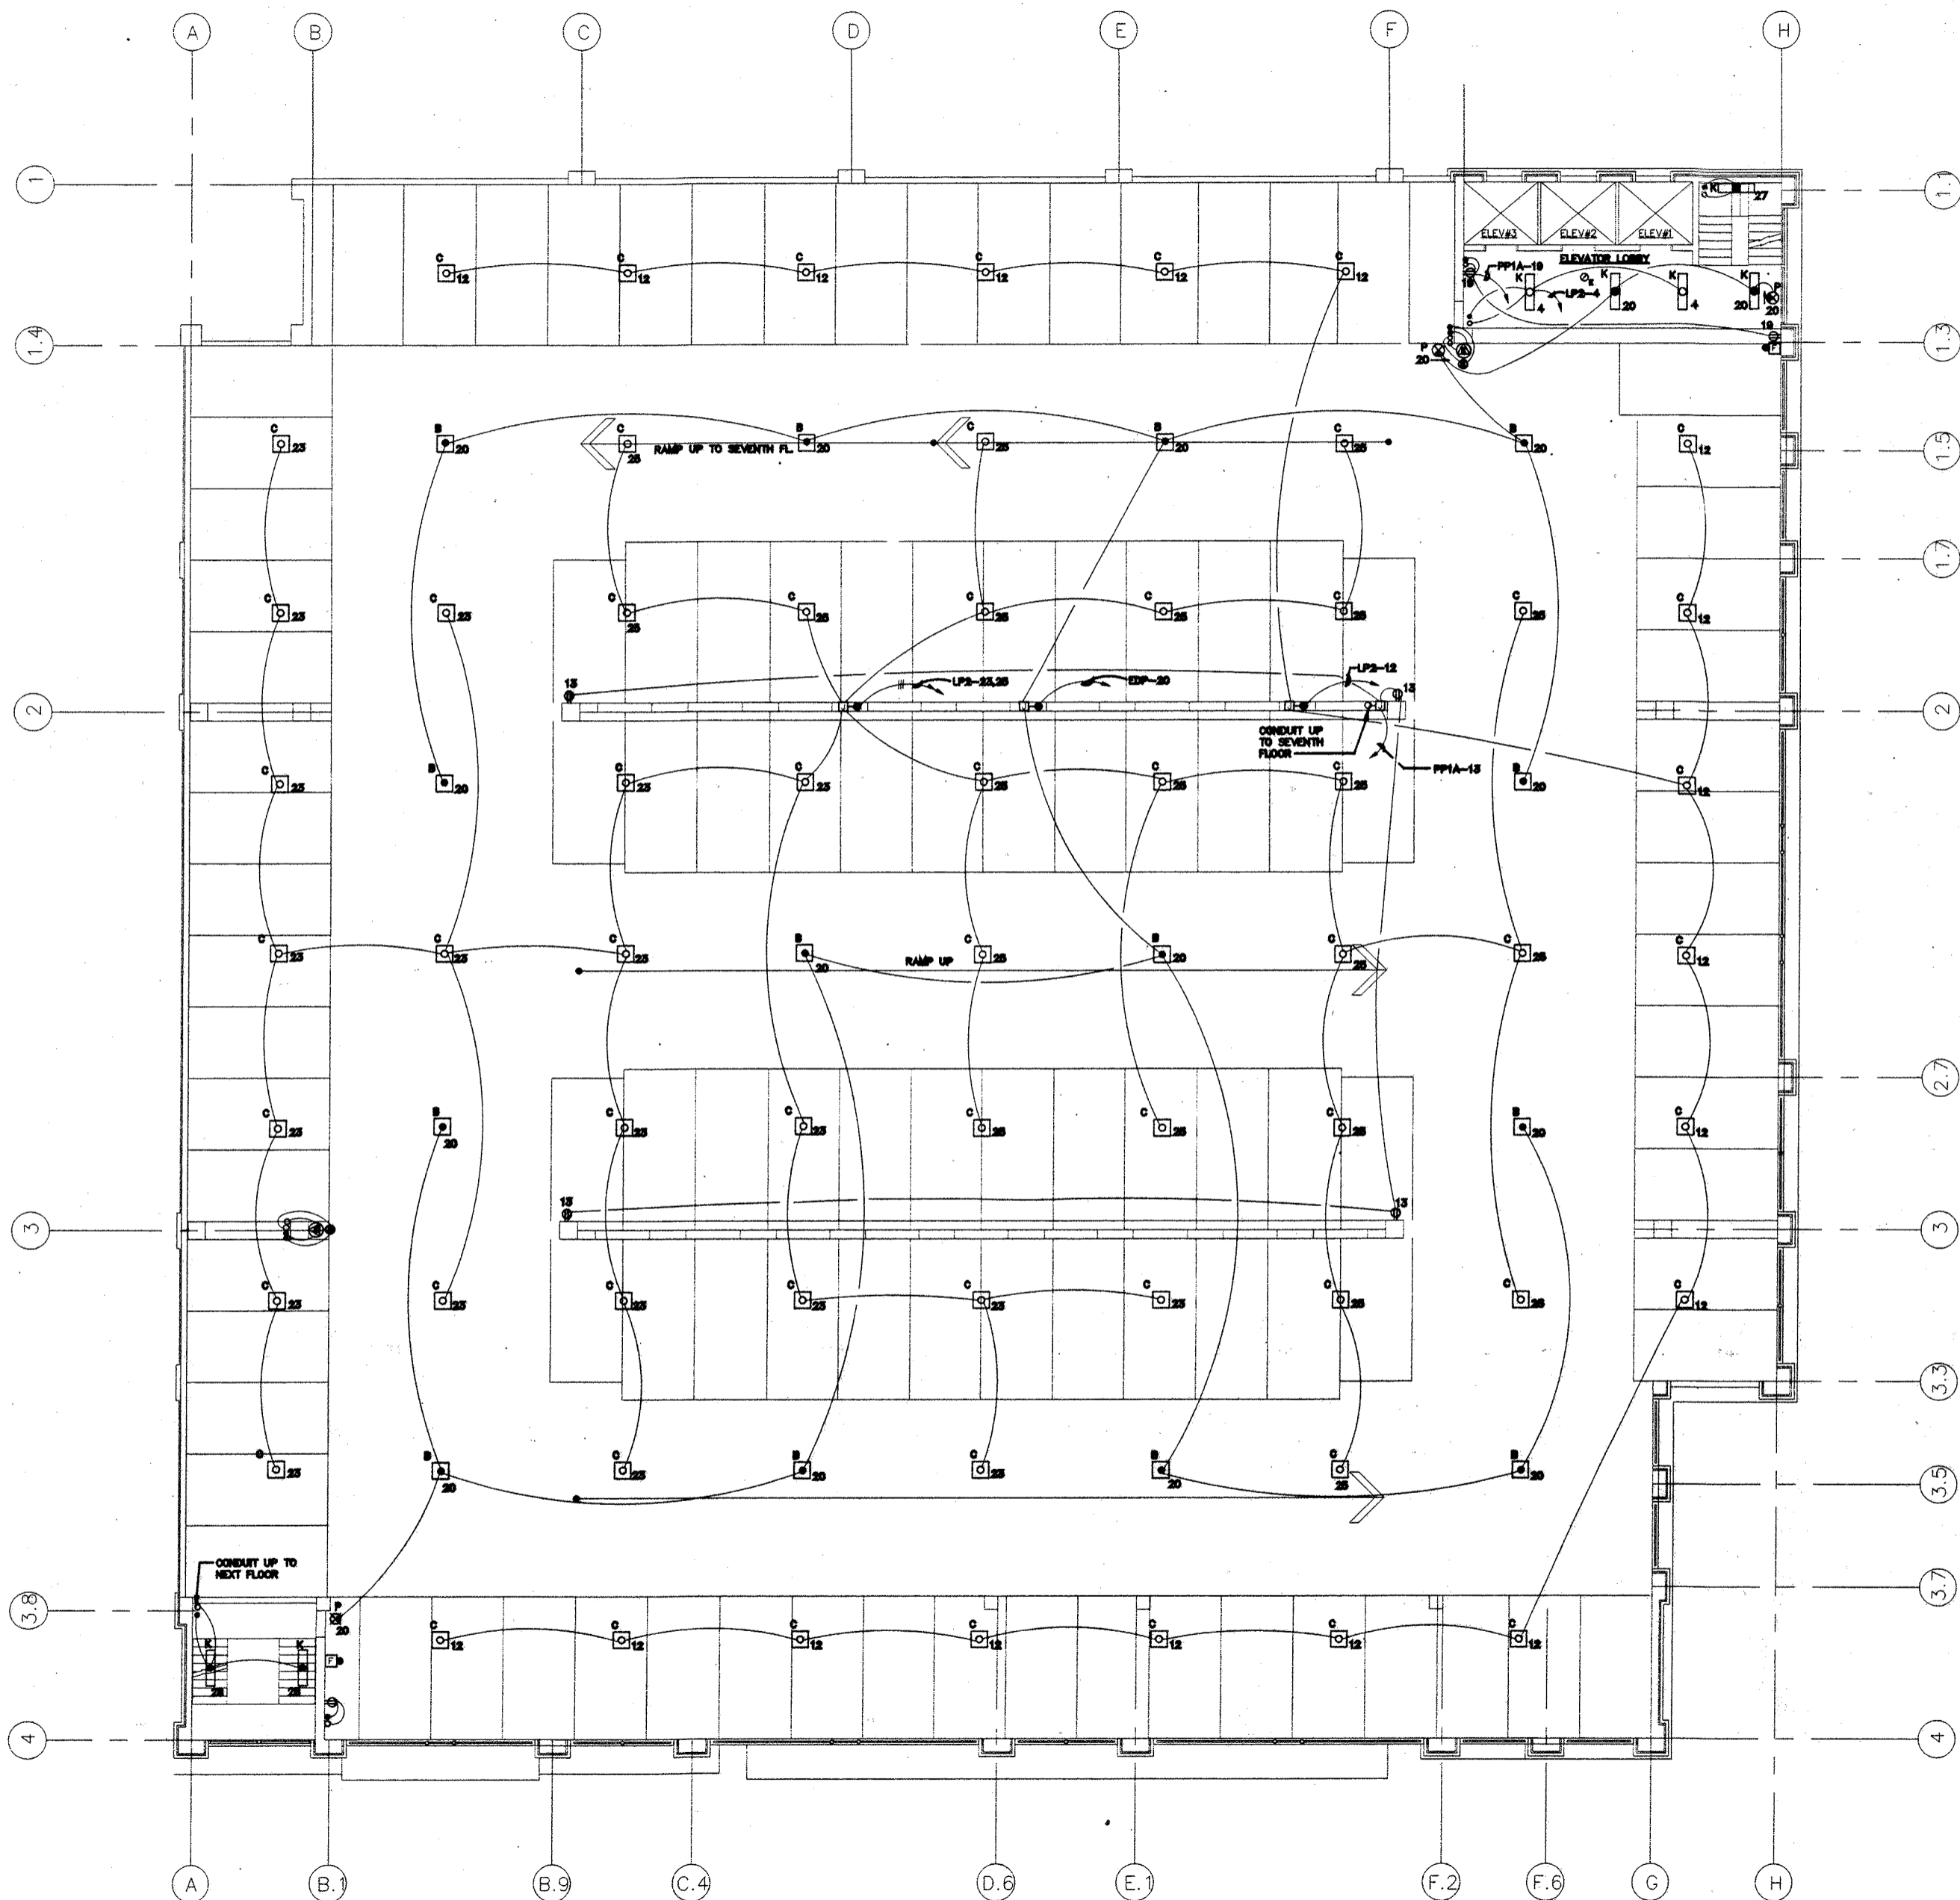

SIXTH FLOOR PLAN - POWER & LIGHTING

SCALE: 1/8"=1'-0"



WHITING-TURNER
CONTRACTING COMPANY
DESIGN ASSOCIATES
ARCHITECTS ENGINEERS

BURDETTE, KOEHLER, MURPHY &
ASSOCIATES, INC.
CONSULTING ENGINEERS
REGISTERED PROFESSIONAL ENGINEERS
STATE OF MARYLAND, LICENSE NO. 10107

PENN STREET PARKING FACILITY
UNIVERSITY OF MARYLAND AT BALTIMORE

NO.	DATE	BY	R.P.


SIXTH FLOOR PLAN
POWER & LTG

DRAWING NO.
E-9

SCALE:	1/8"=1'-0"	
DATE:	6-24-1993	
PROJECT NO.:	J-343	
DESIGN	DRAWN	CHKD.
R.P.	I.P.	R.N.S.

APRIL 3, 1995 AS-BUILTS

P:\PROJECTS\924700-E10A 02/13/95 14:11

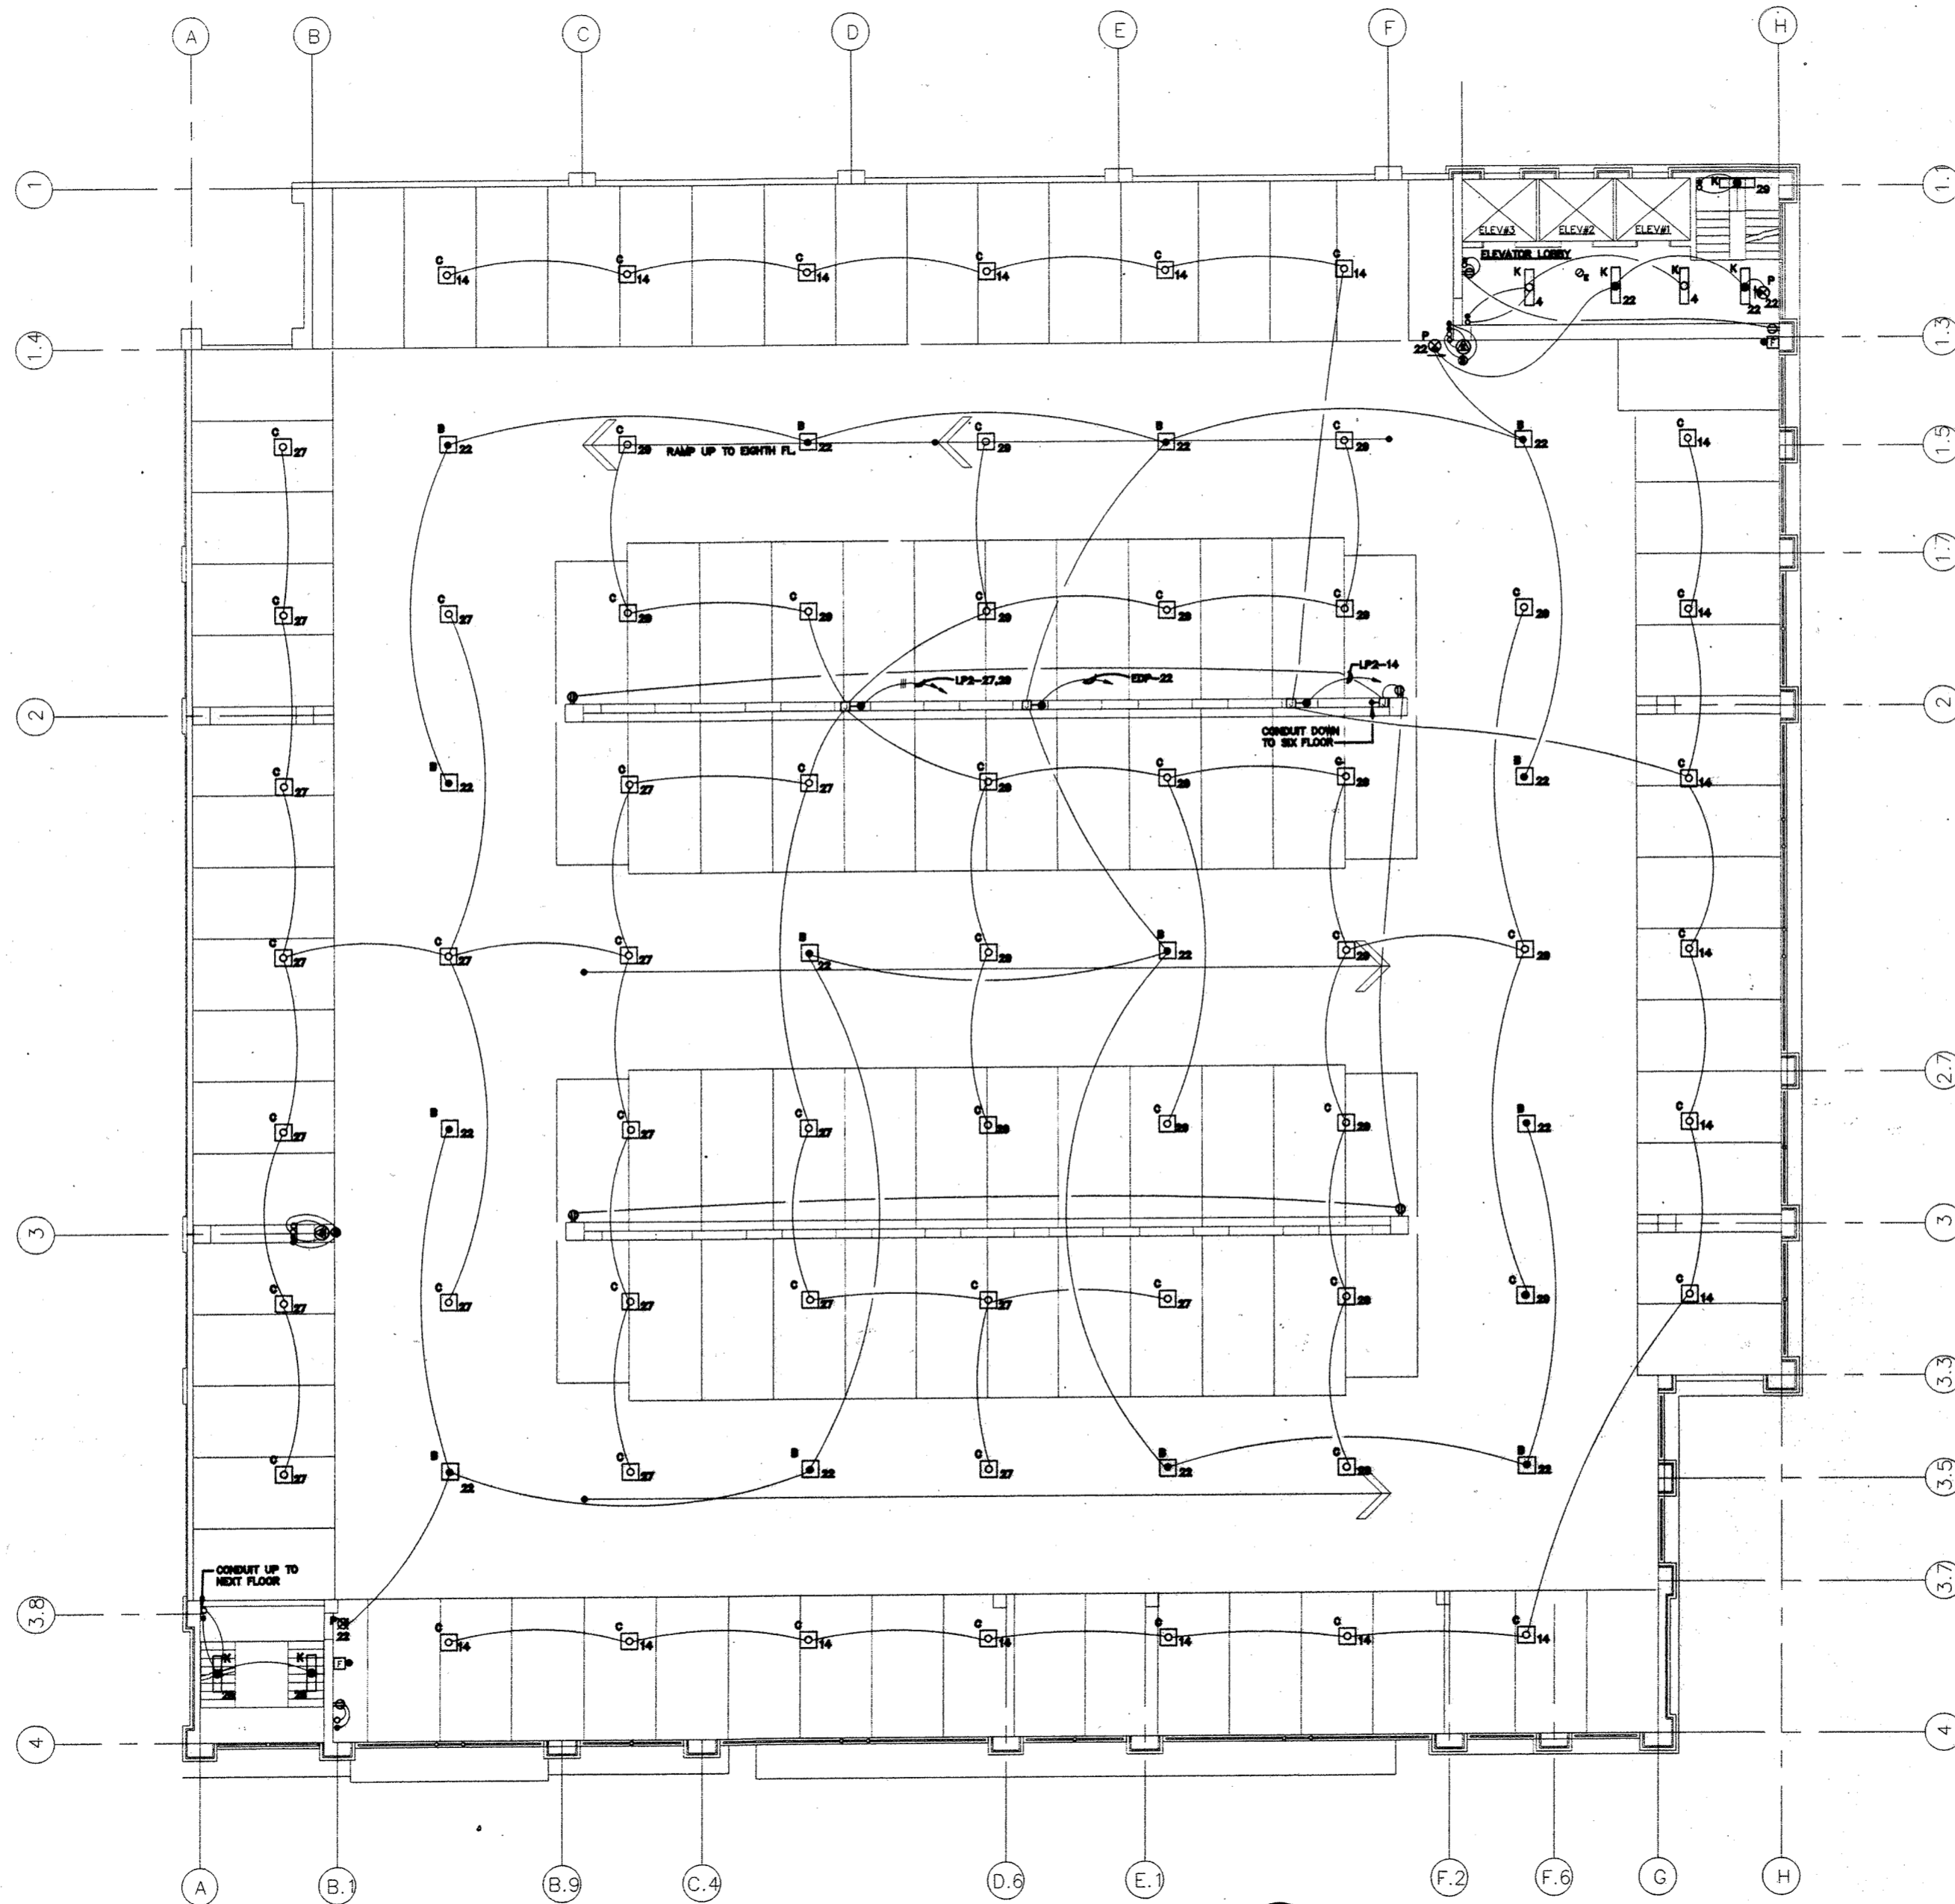

SEVENTH FLOOR PLAN - POWER & LIGHTING

SCALE: 1/8"=1'-0"



WHITTING-TURNER
CONTRACTING COMPANY
DESIGN ASSOCIATES
ARCHITECTS ENGINEERS

BURDETTE, KOEHLER, MURPHY &
ASSOCIATES, INC.
CONSULTING ENGINEERS

PENN STREET PARKING FACILITY
UNIVERSITY OF MARYLAND AT BALTIMORE

NO.	DATE	BY	R.P.


SEVENTH FLOOR PLAN
POWER & LTG

DRAWING NO.
E-10

SCALE: 1/8"=1'-0"
DATE: 6-24-1993
PROJECT NO. J-343
DESIGN | DRAWN | CHKD.
R.P. | I.P. | R.N.S.

APRIL 3, 1995 AS-BUILTS

G:\PROJECTS\924700\--E12A 02/13/95 15:56

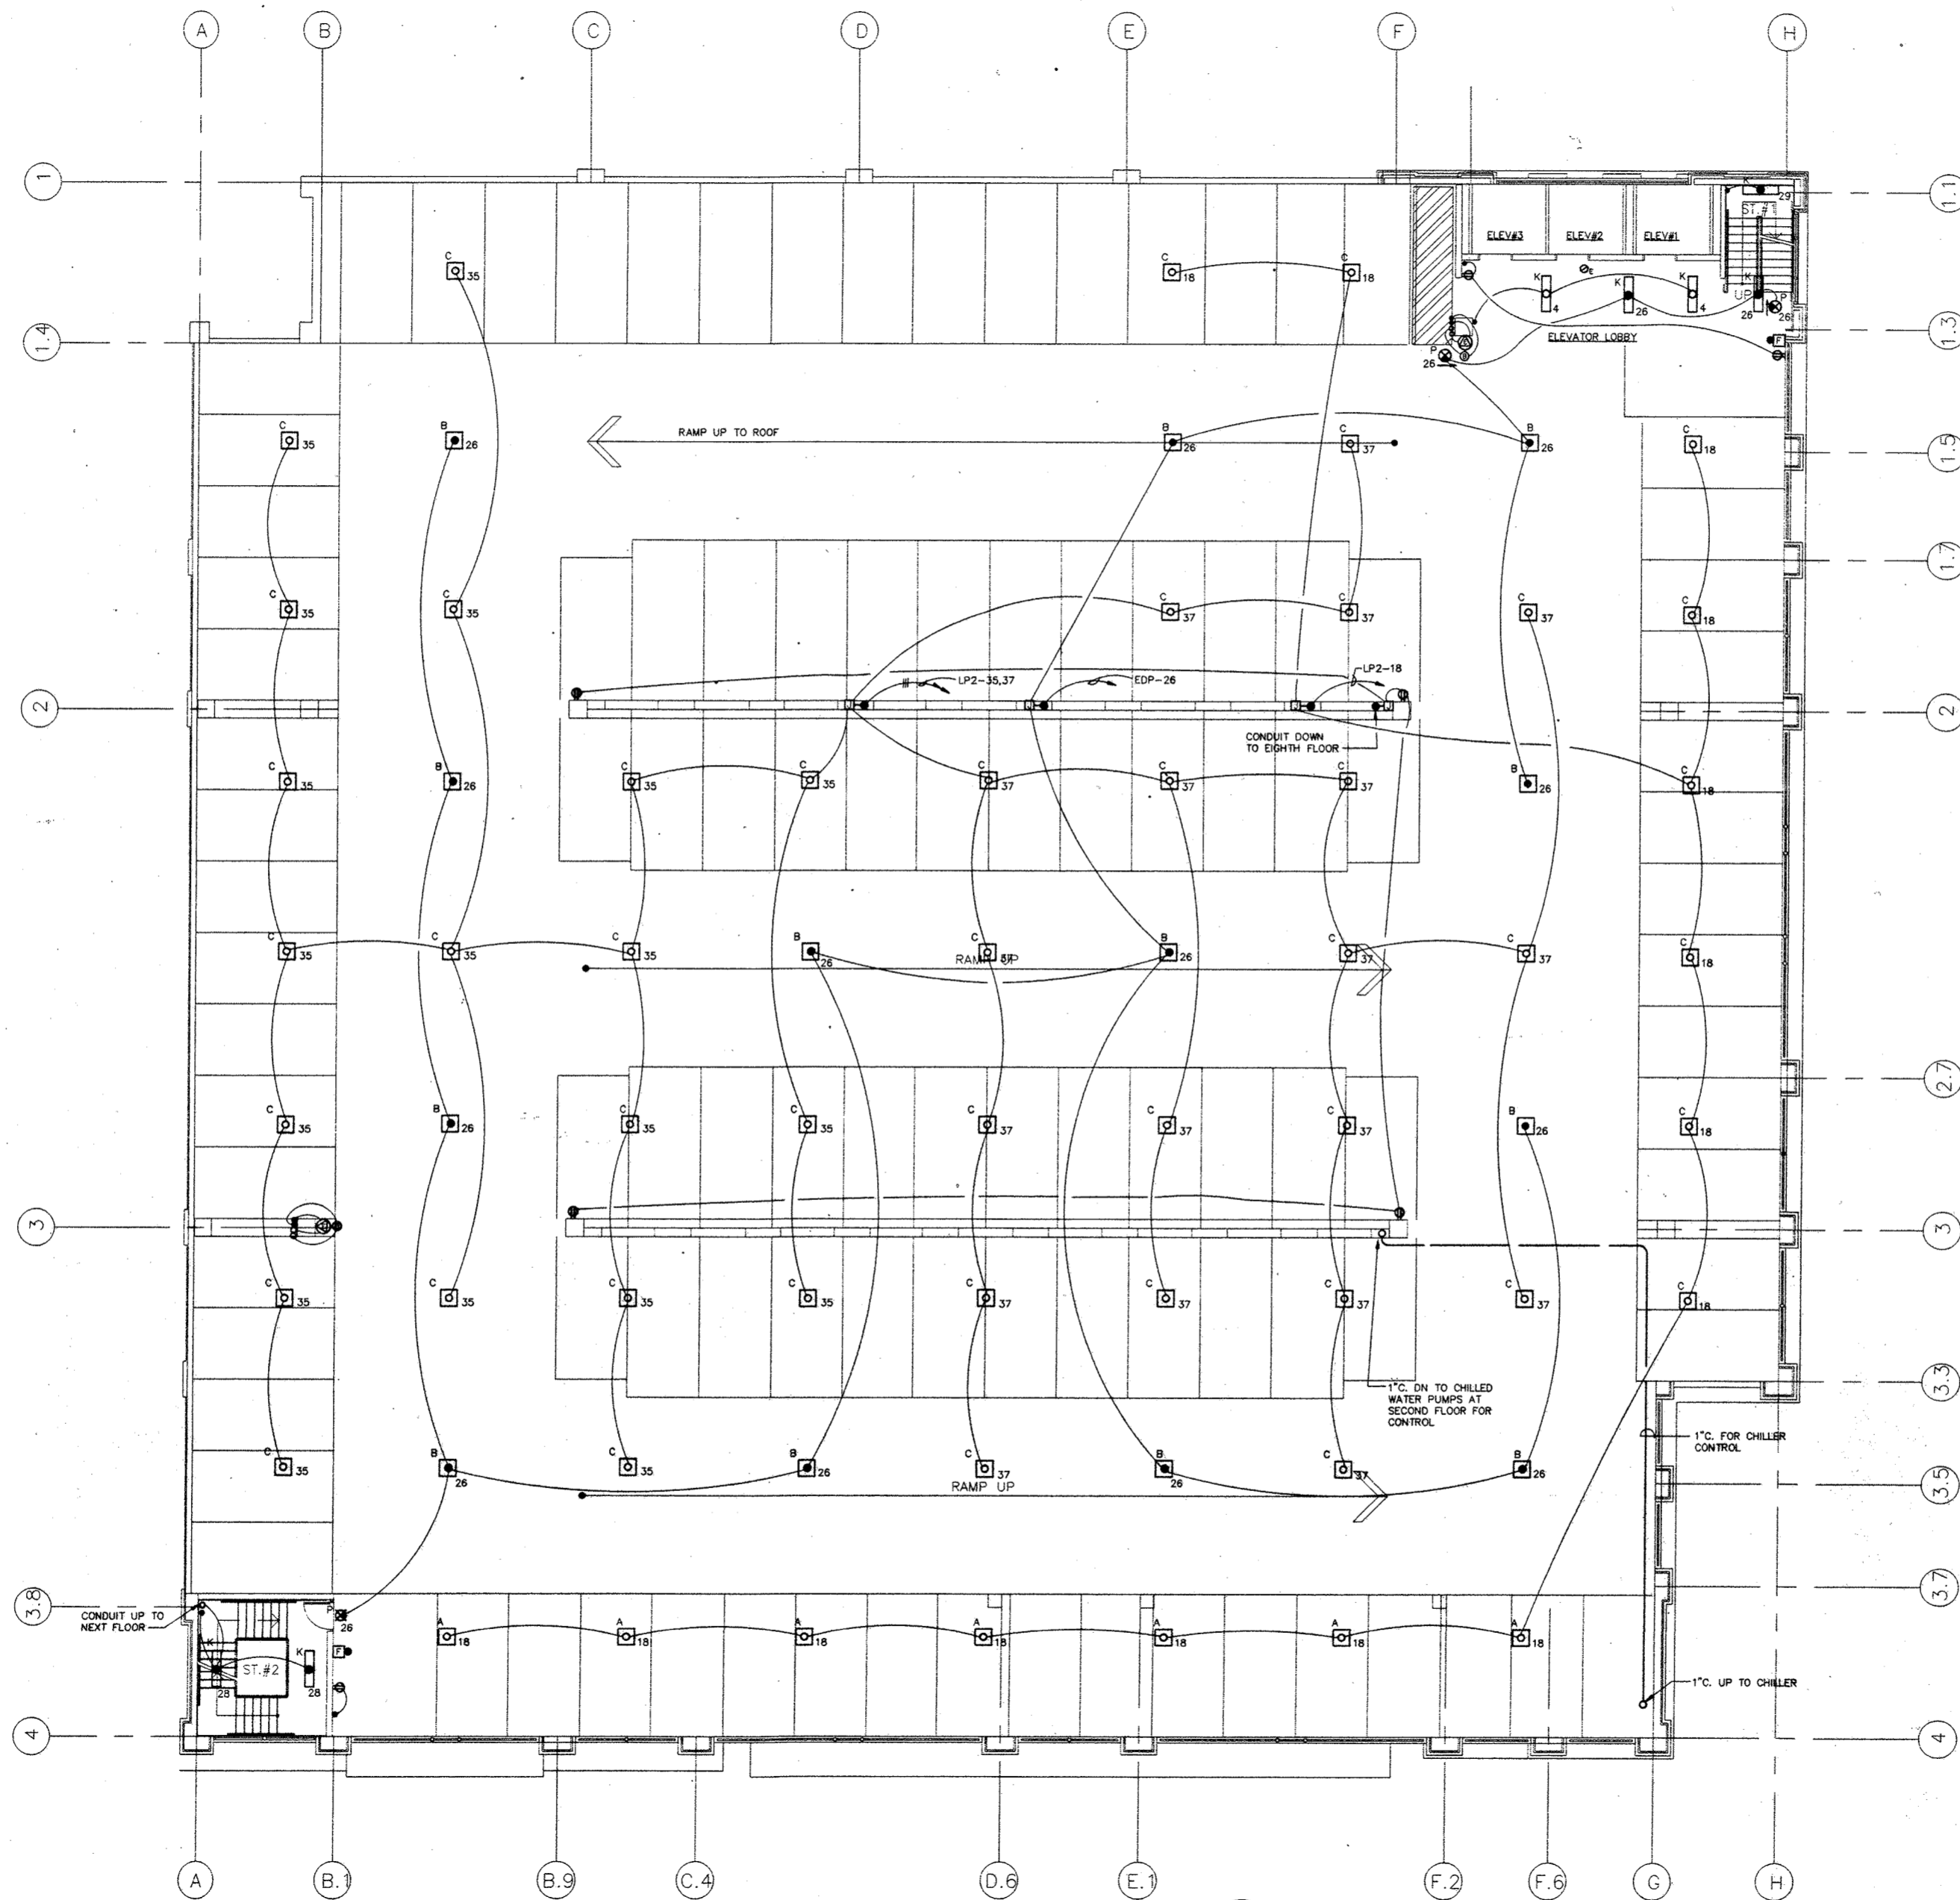

NINTH FLOOR PLAN - POWER & LIGHTING

SCALE: 1/8"=1'-0"



WHITING-TURNER
CONTRACTING COMPANY
DESMAN ASSOCIATES
ARCHITECTS ENGINEERS

BURDETTE, KOEHLER, MURPHY &
ASSOCIATES, INC.
CONSULTING ENGINEERS
200 N. CALVERT STREET, BALTIMORE, MD 21202
(410) 528-2200

PENN STREET PARKING FACILITY
UNIVERSITY OF MARYLAND AT BALTIMORE



NO.	DATE	BY

NINTH
FLOOR PLAN
POWER & LTG


DRAWING NO.
E-12

SCALE: 1/8"=1'-0"
DATE: 6-24-1993
PROJECT NO. J-343
DESIGN DRAWN CHKD.
R.P. I.P. R.N.S.

APRIL 3, 1995 AS-BUILTS

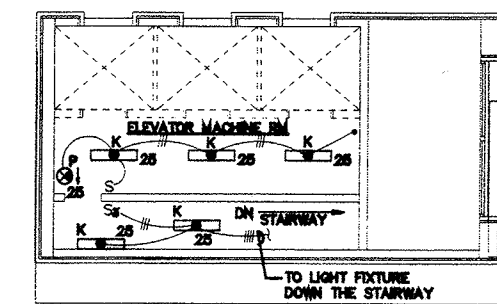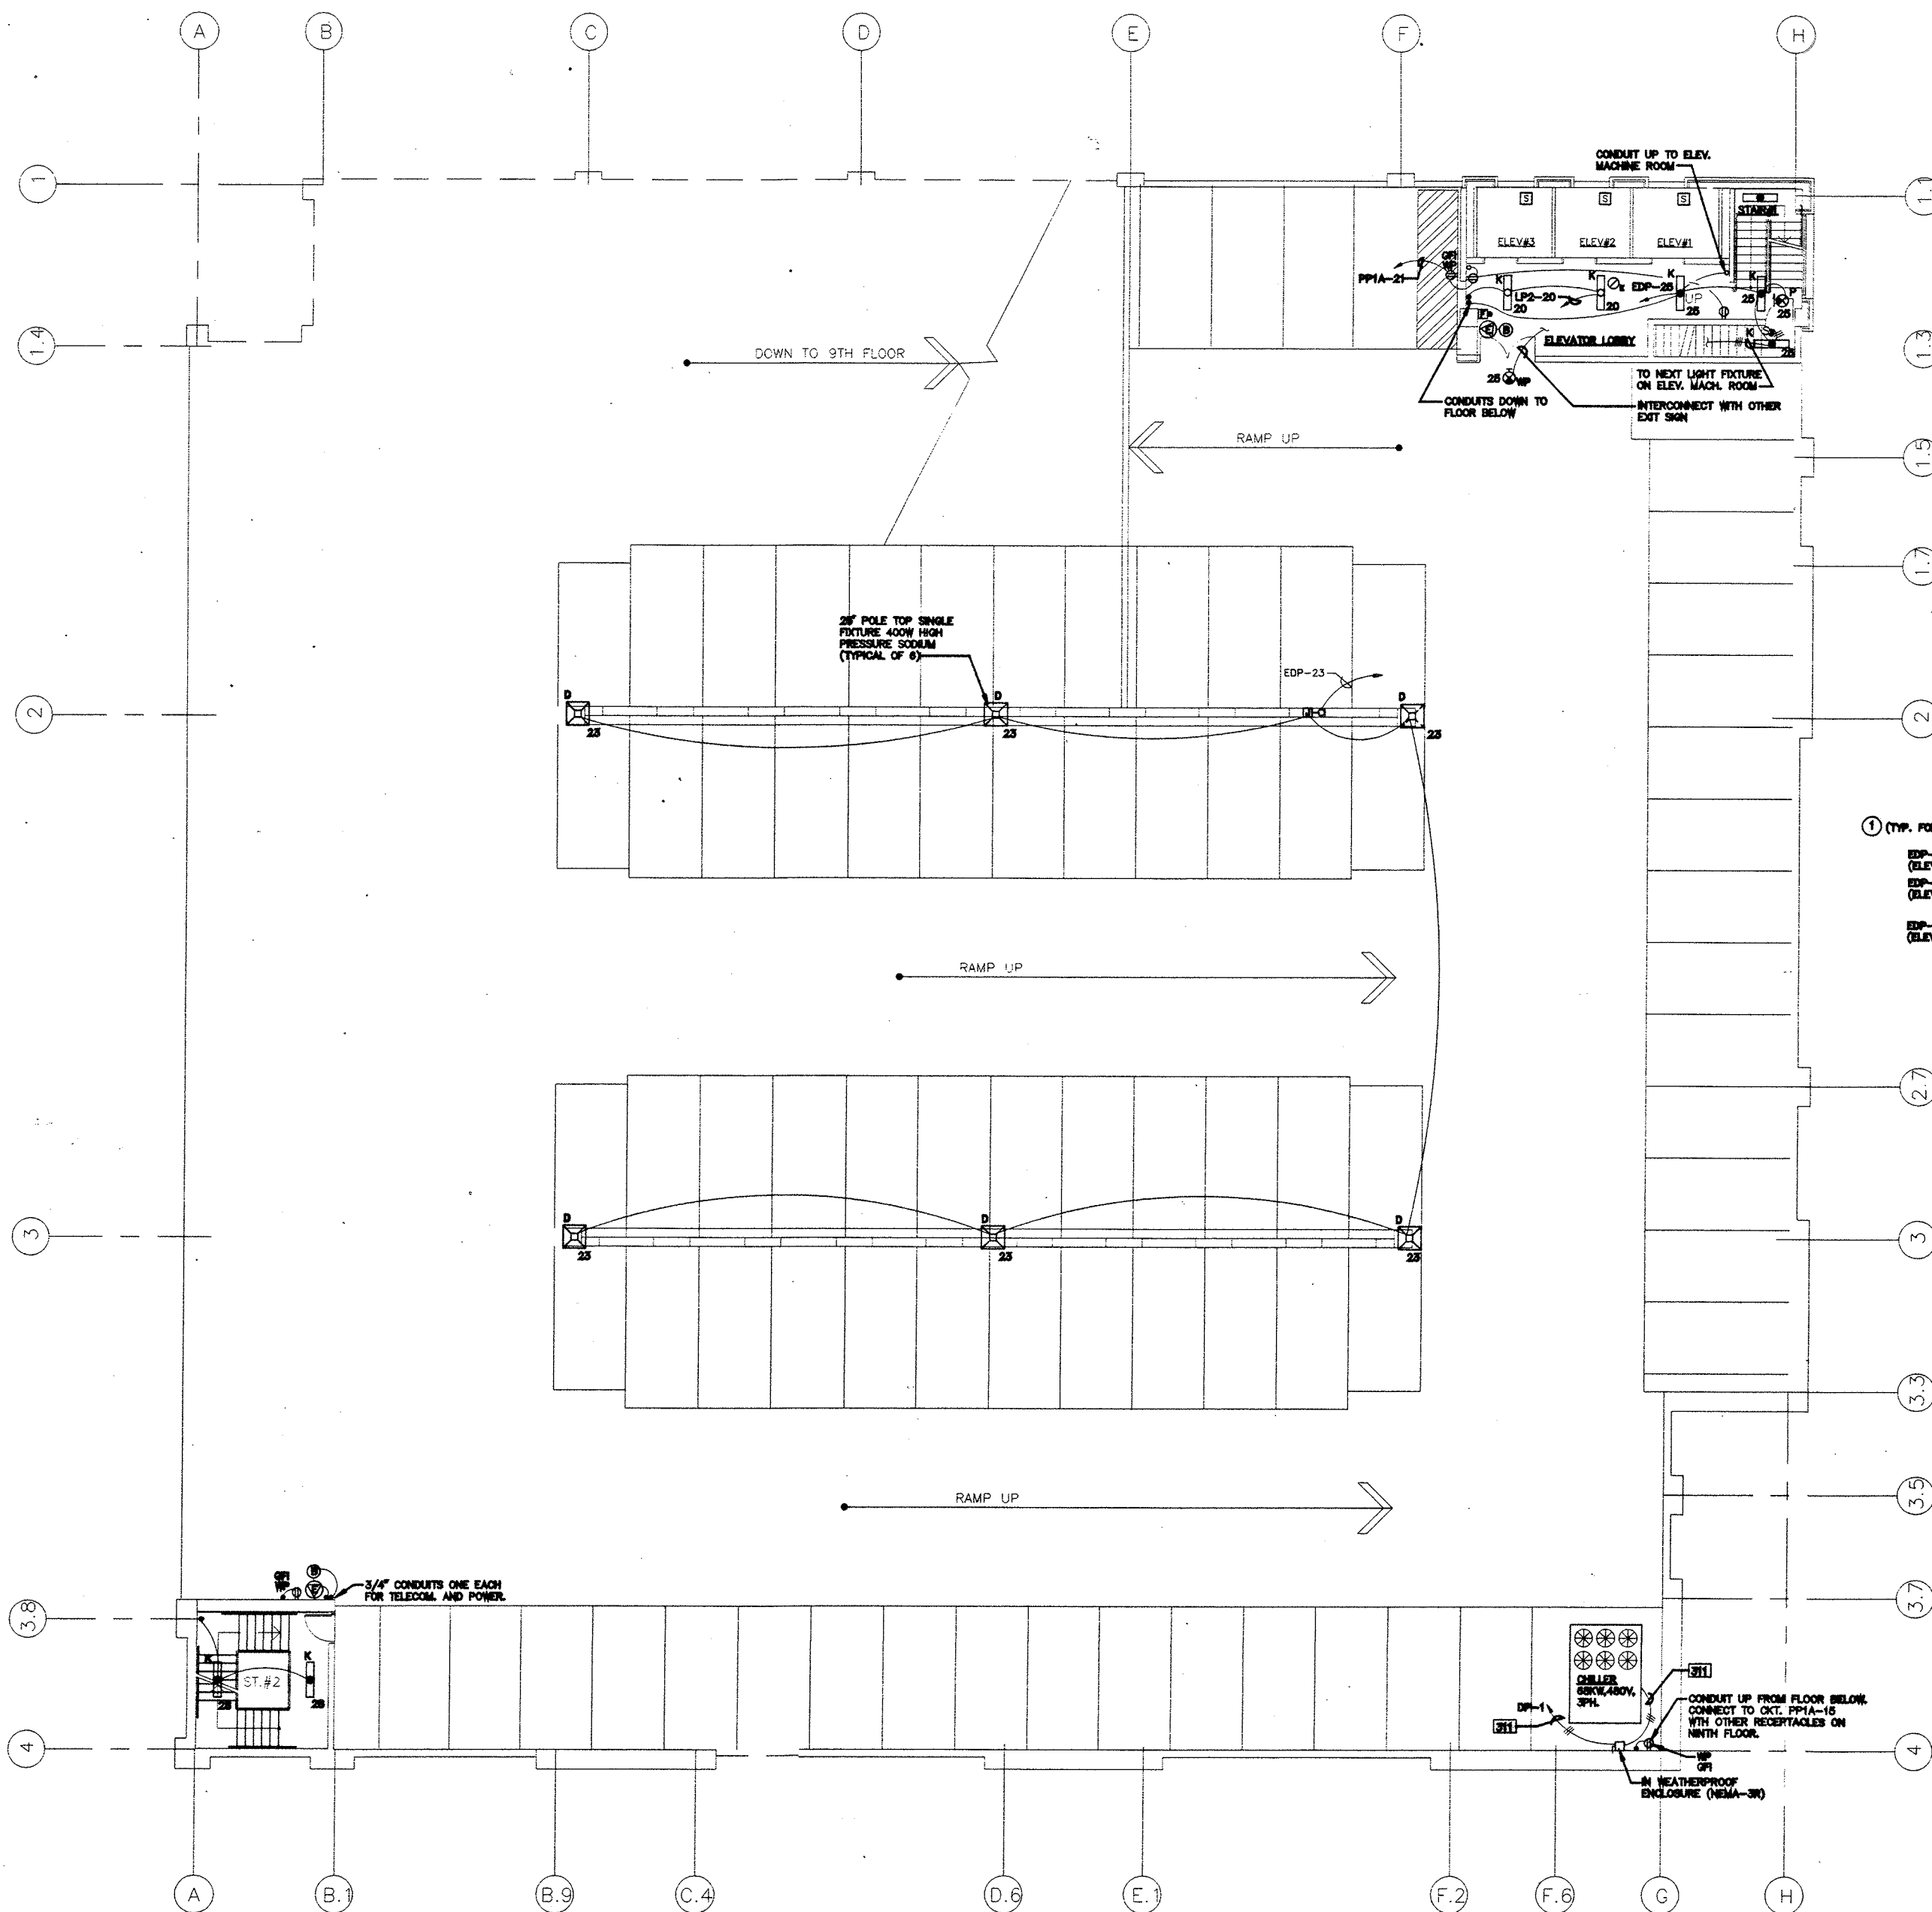

**ELEVATOR MACHINE ROOM
PLAN - LIGHTING**
SCALE: 1/8"=1'-0"

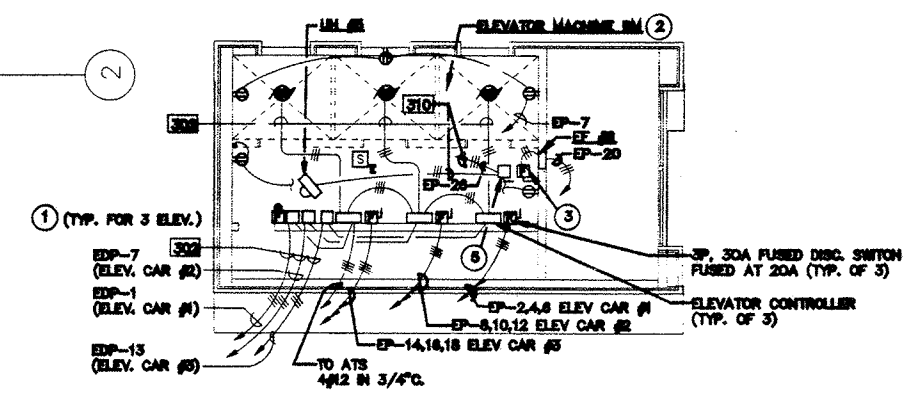

**ELEVATOR MACHINE ROOM
PLAN - POWER**
SCALE: 1/8"=1'-0"


DRAWING NOTES:

- ① 125A, 480V, 3P ENCLOSED UNIT CIRCUIT BREAKER.
- ② ALL DISCONNECTS FOR ELEV. CIRCUITS SHALL HAVE PROVISIONS FOR PADLOCKING IN THE OPEN POSITION.
- ③ NEMA 1 ENCLOSURE, 30A, 3P, FUSED AT 8 AMP, 250VAC DISCONNECT.
- ④ NEMA-3R ENCLOSURE, 200A, 3P, 600VAC DISCONNECT.
- ⑤ NEMA 1 ENCLOSURE, 30A, 3P, 250VAC DISCONNECT. INSTALL THIS DISCONNECT BELOW THE DISCONNECT AS NOTED IN NOTE 3 ABOVE.

ROOF LEVEL FLOOR PLAN - POWER & LIGHTING
SCALE: 1/8"=1'-0"



APRIL 3, 1995 AS-BUILTS

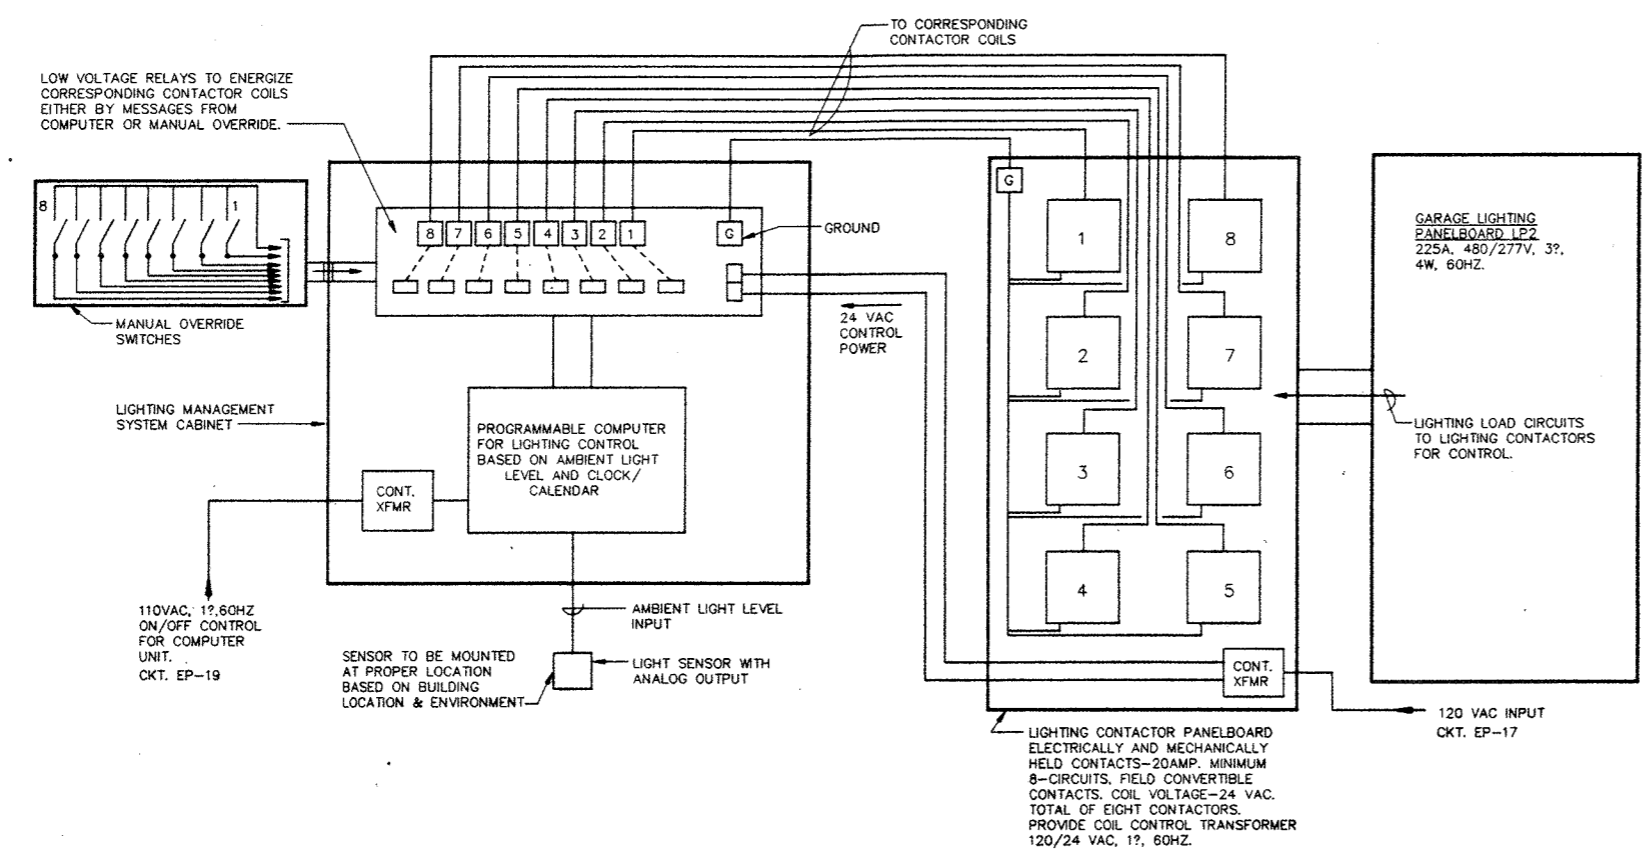

LIGHTING CONTROL SCHEMATIC
NO SCALE

LIGHTING CONTACTOR RELAY #	AREA SERVED	LIGHTING CIRCUIT # WITH PANELBOARD	REMARK
1	ROOF DECK	EDP-6	ON-AT DUSK OFF-AT DAWN AND ALSO ON/OFF BASED ON CLOCK/CALENDAR
2	EXTERIOR	EDP-21,23,25	ON-AT DUSK OFF-AT DAWN
3	PERIMETER LIGHTING SECOND FLOOR THRU FIFTH FLOOR	LP2-6,8,10,41	ON-AT DUSK OFF-AT DAWN
4	PERIMETER LIGHTING SIXTH FLOOR THRU NINTH FLOOR	LP2-12,14,16,18	ON-AT DUSK OFF-AT DAWN
5	INTERIOR LIGHTING SECOND FLOOR THRU FIFTH FLOOR	LP2-7,9,11,13,15,17,19,21	ON/OFF BASED ON CLOCK/CALENDAR
6	INTERIOR LIGHTING SIXTH FLOOR THRU NINTH FLOOR	LP-23,25,27,29,31,33,35,37	ON/OFF BASED ON CLOCK/CALENDAR
7	PRATT AND PENN STREET ENTRANCE LIGHTING	LP2-3,39	ON-AT DAWN OFF-AT DUSK
8	SPARE	-	-

LIGHTING CIRCUIT CONTROL SCHEDULE

DRAWING NOTES:

- LIGHTING MANAGEMENT SYSTEM CABINET, MANUAL OVERRIDE SWITCH CABINET AND CONTACTOR RELAY CABINET SHALL BE LOCATED IN MAIN ELECTRICAL ROOM ADJACENT TO LIGHTING PANEL-LP2. REFER TO DRAWING E-19.
- EACH CONTACTOR RELAY TO CONTROL EIGHT LIGHTING CIRCUITS THROUGH NO OR NC CONTACTS AS APPLICABLE, SQUARE D LIGHTING CONTACTORS CLASS 8903 OR EQUAL.
- PROVIDE BATTERY BACK-UP POWER FOR LIGHTING MANAGEMENT SYSTEM COMPUTER TO MAINTAIN THE PROGRAM AND NOT TO LOOSE THE CONTROL SCHEME.
- LIGHT SENSOR WITH ANALOG OUTPUT SHALL BE LOCATED IN A CRITICAL AREA BASED ON THE GARAGE SURROUNDING ENVIRONMENT TO SUIT THE BEST LIGHTING CONTROL. LIGHTING MANAGEMENT SYSTEM SUPPLIER SHALL RECOMMEND THE LOCATION OF THE SENSOR FOR THE BEST PERFORMANCE.
- LIGHTING MANAGEMENT SYSTEM COMPUTER, THROUGH IT'S PROGRAM AND UTILIZING LIGHT SENSOR INPUT, SHALL BE ABLE TO DEMARK THE LIGHTING LEVEL AS FOLLOWS:
0 THROUGH 100, 0 - BEING SUNNY DAY LIGHT AND 100 - BEING DARK AT NIGHT.


NO.	DATE	BY

LIGHTING CONTROL

DRAWING NO.
E-14


SCALE:	AS NOTED
DATE:	6-24-1993
PROJECT NO.:	4-343
DESIGN:	RP
DRAWN:	IP
CHKD.:	RNS

APRIL 3, 1995 AS-BUILTS

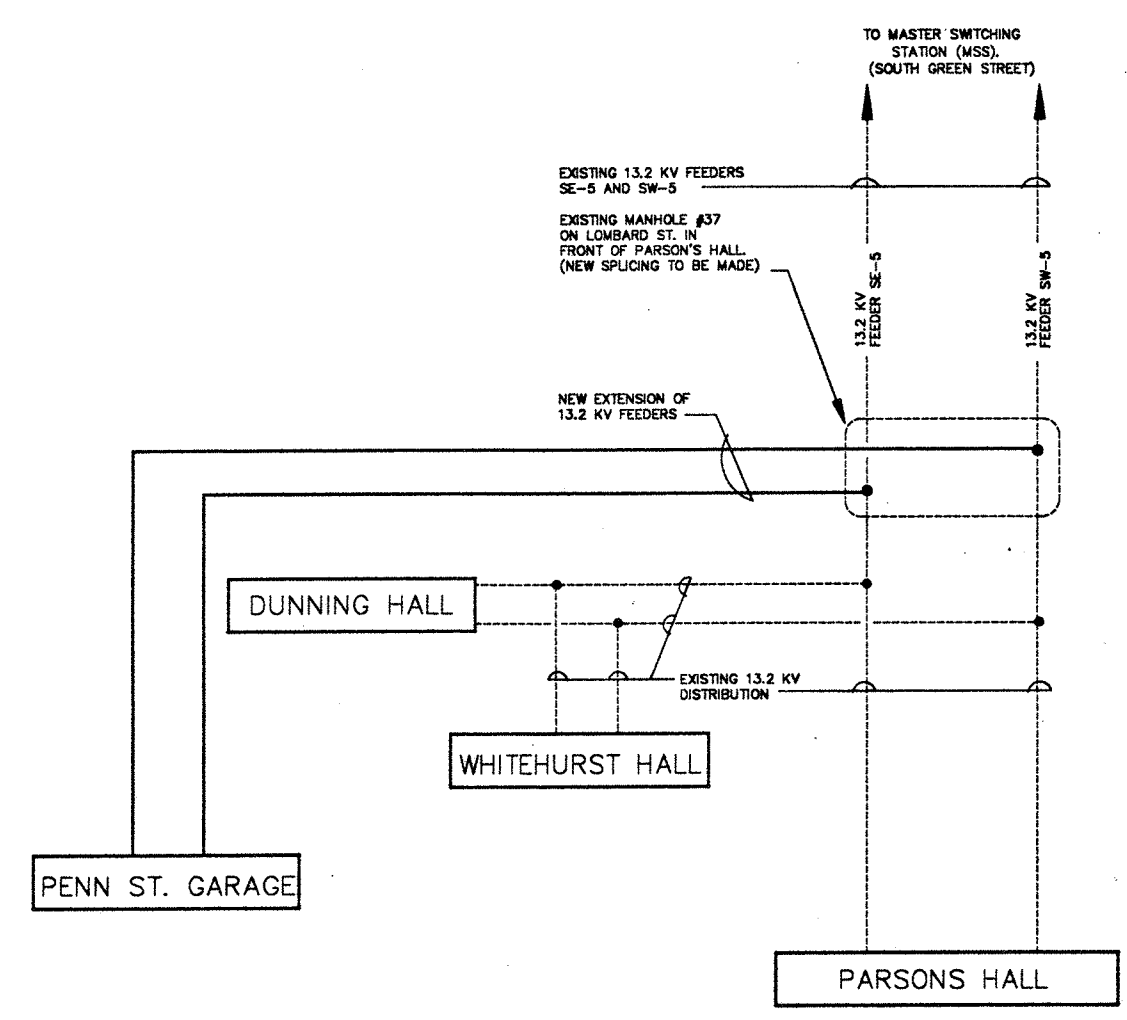

ONE-LINE DIAGRAM OF 13.2 KV DISTRIBUTION
NO SCALE

FEEDER SCHEDULE						
NOTES:						
1. PHASE CONDUCTORS, NEUTRAL GROUND AND CONDUIT SHOWN IN THE FEEDER SCHEDULE APPLY TO EACH SET WHEN MULTIPLE SETS ARE REQUIRED. ALL CONDUCTORS ARE COPPER UNLESS OTHERWISE NOTED.						
2. CONDUCTORS HAVE BEEN SELECTED IN ACCORDANCE WITH THE AMPACITIES LISTED IN TABLE 310-16 OF THE 1993 NEC. THIS TABLE APPLIES TO CONDUCTORS IN RACEWAYS IN FREE AIR. USE OF UNDERGROUND ELECTRICAL DUCTS MAY REQUIRE CHANGES IN CONDUCTOR AND CONDUIT SIZES.						
NUMBER	SETS	PHASE CONDUCTORS	NEUTRAL	GROUND	CONDUIT	REMARKS
335MV	1	3-1/C#350KCMIL CU	-	#2, 600V	*	CABLE SHALL BE EPRN PARTLY THROUGH EXISTING DPW DUCTBANK AND PARTLY THROUGH 4" CONDUIT IN NEW DUCT BANK
2435	2	3#350 KCMIL	#350 KCMIL	#1	3"	
450	1	3#500 KCMIL	#500 KCMIL	#3	3 1/2"	
425	1	3#250 KCMIL	#250 KCMIL	#4	3"	
444	1	3#4/0	#4/0	#4	2 1/2"	
301	1	3#1	-	#6	1 1/2"	
304	1	3#4	-	#8	1"	
433	1	3#3/0	#3/0	#6	2"	
308	1	3#8	-	#10	1"	
312	1	3#12	-	#12	3/4"	
306	1	3#8	-	#12	3/4"	
311	1	3#1/0	-	#8	1 1/2"	
401	1	3#1	#1	#8	1 1/2"	
310	1	3#10	-	#10	3/4"	
302	1	3#2	-	#8	1 1/4"	
206	1	2#8	-	#10	1"	

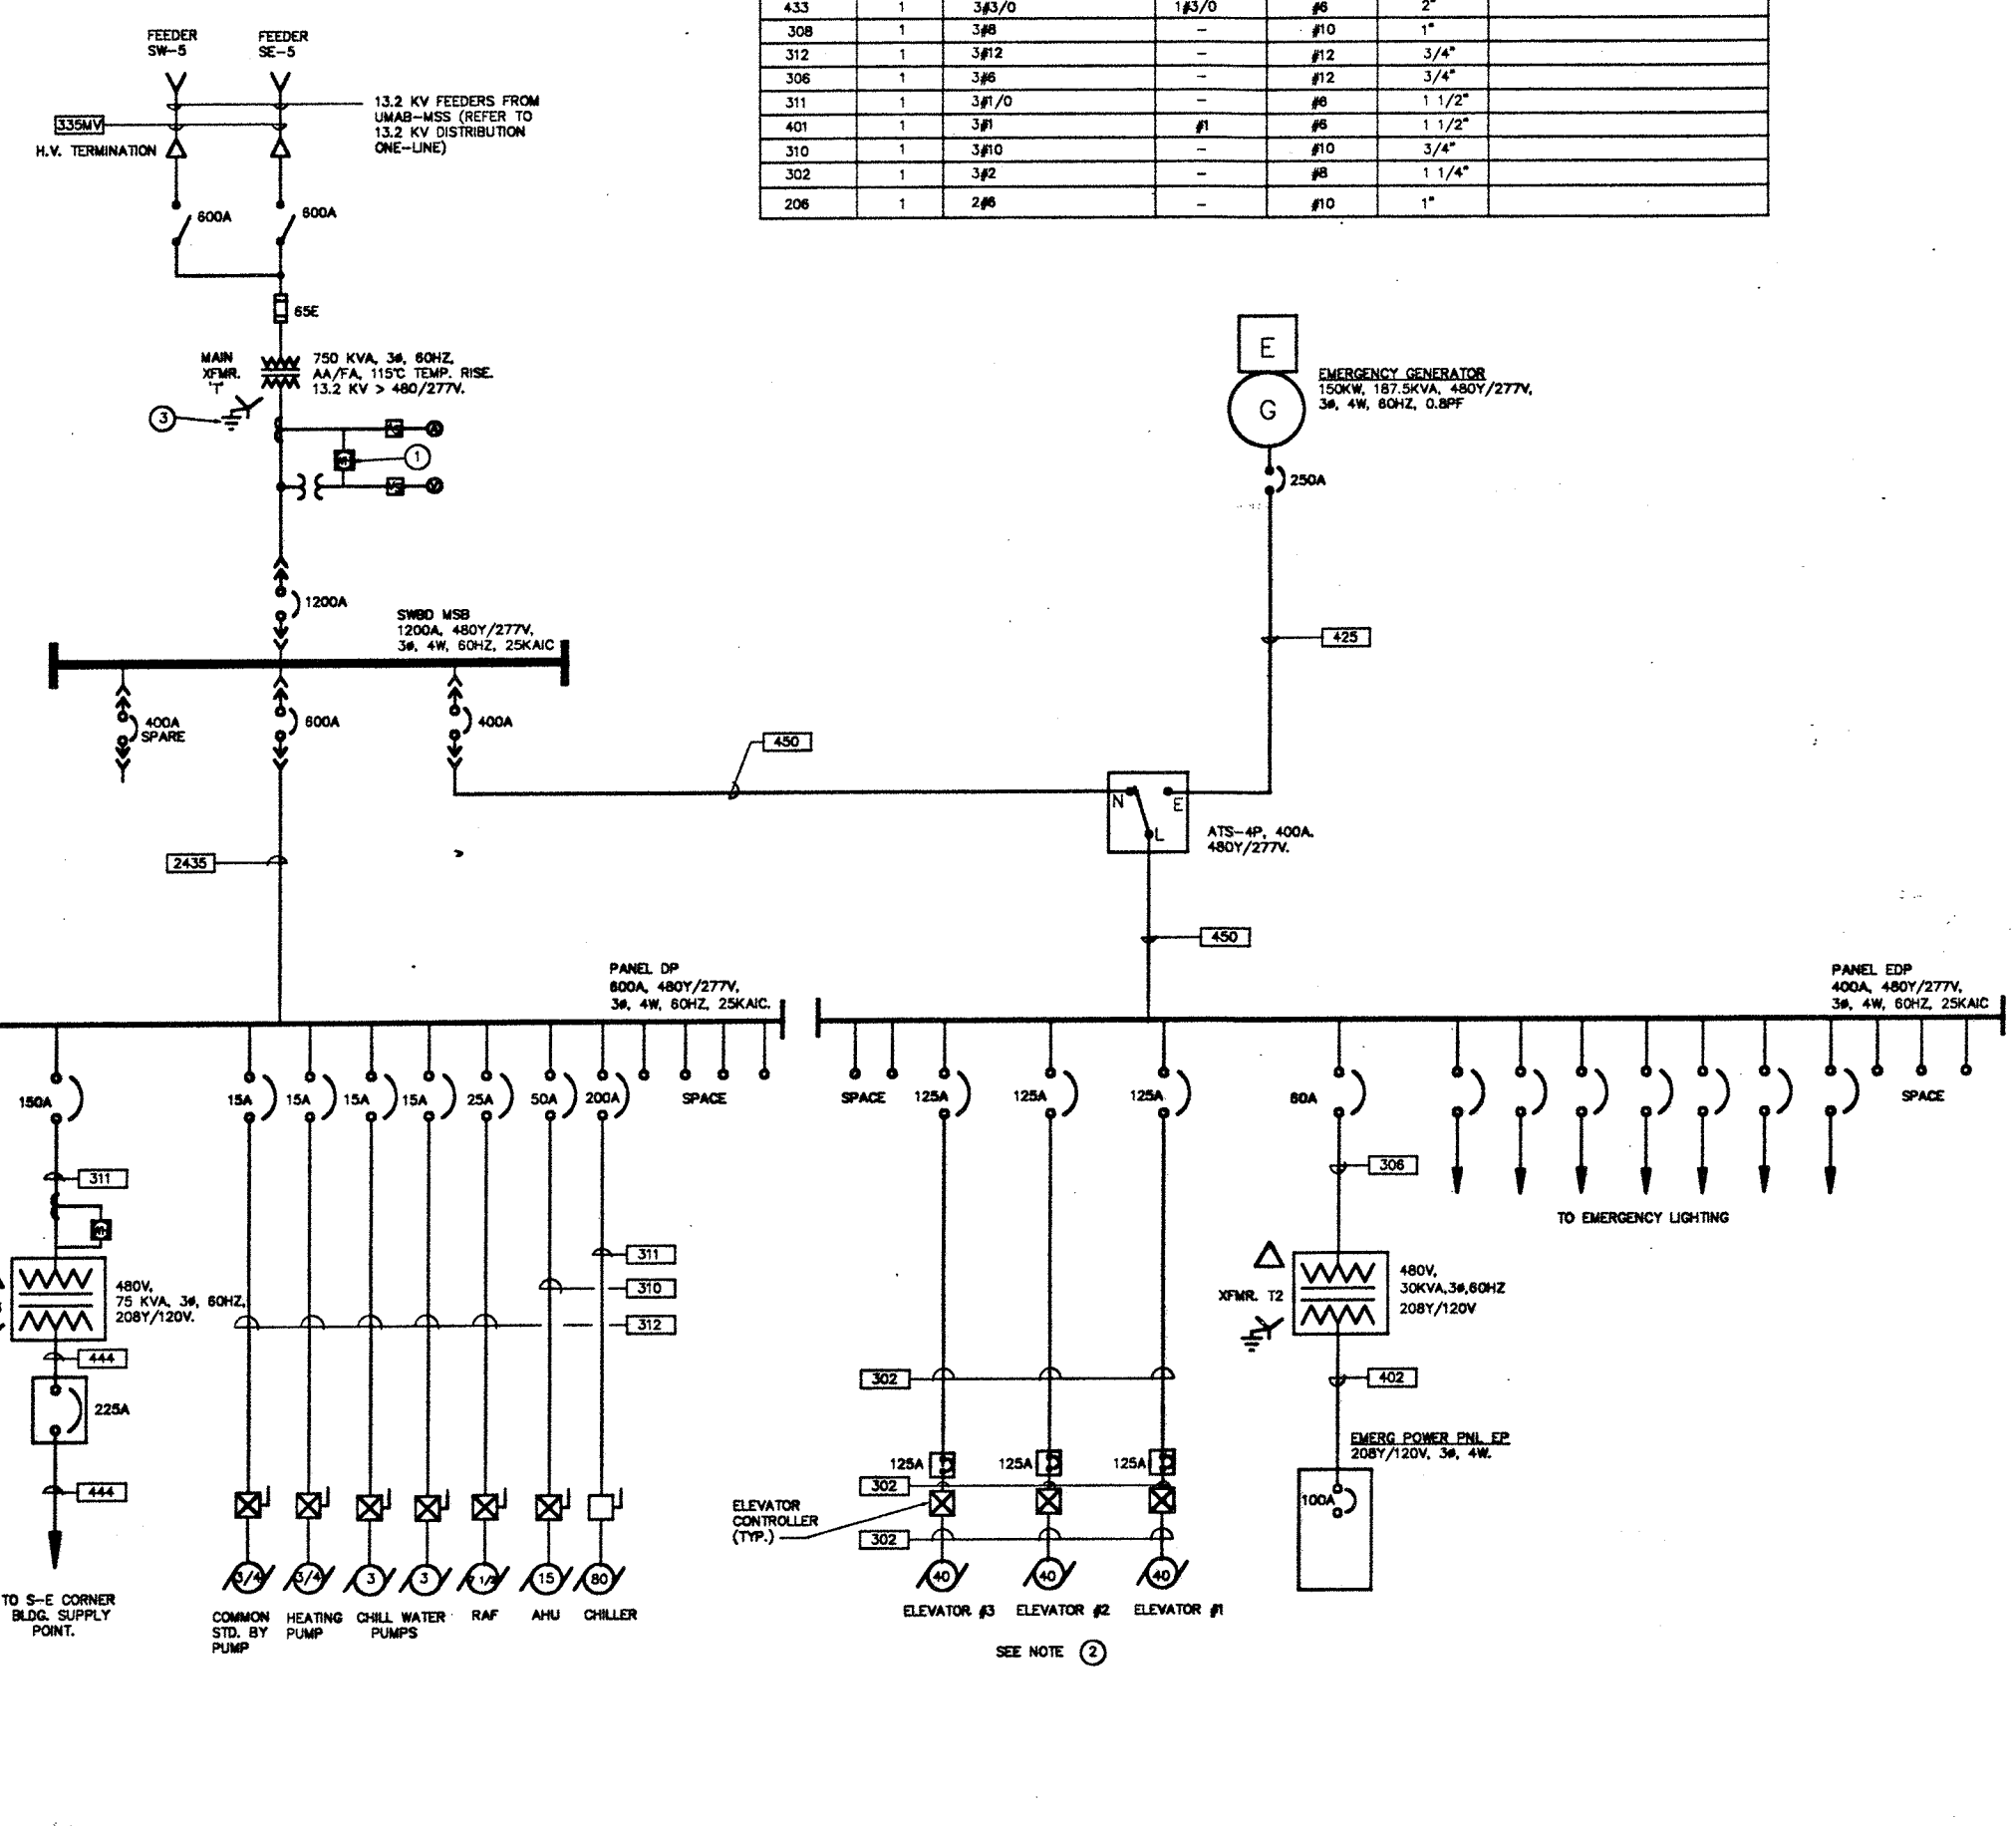

ONE - LINE DIAGRAM
NO SCALE

DRAWING NOTES:

- 1 THE WATTHOUR METER SHALL BE A MECHANICAL TYPE WITH CLOCK DIAL FACE AND SHALL HAVE TWO PULSE OUTPUTS OF SUITABLE VALUE FOR REMOTE METERING AND A DEMAND REGISTER. PROVIDE 1" C. TO TELECOM. ROOM WITH 3-4 PAIR CABLE FOR THREE METERS FOR REMOTE ENERGY MANAGEMENT.
- 2 DURING EMERGENCY, ONLY ONE ELEVATOR WILL OPERATE. ELEVATOR CONTROLS SHALL BE SET SUCH THAT ELEVATOR #1 WILL REMAIN FUNCTIONAL ON EMERGENCY POWER IN GENERAL. FOR SUSTAINED MECHANICAL PROBLEM OR BREAKDOWN OF ELEVATOR #1, CONTROL WILL SHIFT THE EMERGENCY OPERATION TO EITHER ELEVATOR #2 OR ELEVATOR #3 IN ORDER.
- 3 SEE GROUNDING REQUIREMENT ON DRAWING E-19.

NO.	DATE	BY

ONE-LINE DIAGRAMS


DRAWING NO.
E-15

SCALE: 1/8" = 1'-0"
DATE: 6-24-1993
PROJECT NO. J-343
DESIGN DRAWN CHK'D.
R.P. LP. R.N.S.

APRIL 3, 1995 AS-BUILTS


DRAWING NOTES:

- TENTATIVE CAMERA LOCATION OF UMAB BUILDING-EXTERIOR CCTV SURVEILLANCE SYSTEM. CAMERAS SHALL BE MOUNTED ON EXTERIOR WALL TO THE BUILDING. THE SELECTION OF EXACT LOCATION OF THE CAMERAS SHALL BE FIELD DETERMINED BY THE CONTRACTOR TO PROVIDE THE BEST COVERAGE OF THE CRITICAL AREAS AS DESIRED BY THE OWNER.
- THE CAMERA LOCATED ON 701W PRATT ST. BUILDING SHALL BE FOCUSED TO COVER PRATT ST. ENTRANCE AND SURROUNDINGS.
- THE CAMERA LOCATED ON SCHOOL OF NURSING SHALL BE FOCUSED TO COVER PENN. ST. ENTRANCE AND SURROUNDINGS.
- CAMERAS ARE TO BE SUPPORTED STRUCTURALLY WITH THE BUILDING WITHOUT AFFECTING THE INTEGRITY OF THE BUILDING STRUCTURE.
- CAMERAS ARE TO BE INDIVIDUALLY INTERFACED WITH THE UMAB CENTRAL SECURITY MONITORING CENTER AT PINE STREET BUILDING. THE EXISTING SPARE FIBER OPTIC CABLES CONNECTING THE RESPECTIVE BUILDINGS WITH THE PINE STREET BLDG. SHALL BE USED FOR CONTROL/MONITORING OF CAMERAS. CONTRACTOR SHALL PROVIDE THE NECESSARY FIBER OPTIC INTERCONNECTION INSIDE THE BUILDINGS BETWEEN THE CAMERA UNIT AND THE EXISTING BUILDING FIBER OPTIC SERVICE TERMINALS.
- CONTRACTOR SHALL PROVIDE AT LEAST TWO WEEKS NOTICE TO THE AUTHORITY OF THE FOLLOWING BUILDINGS BEFORE THE ACTUAL WORK STARTS:
 - 701W PRATT STREET.
 - SCHOOL OF NURSING.
- 110 VAC, 1-PHASE POWER TO CCTV CAMERA SHALL ALSO BE PROVIDED.

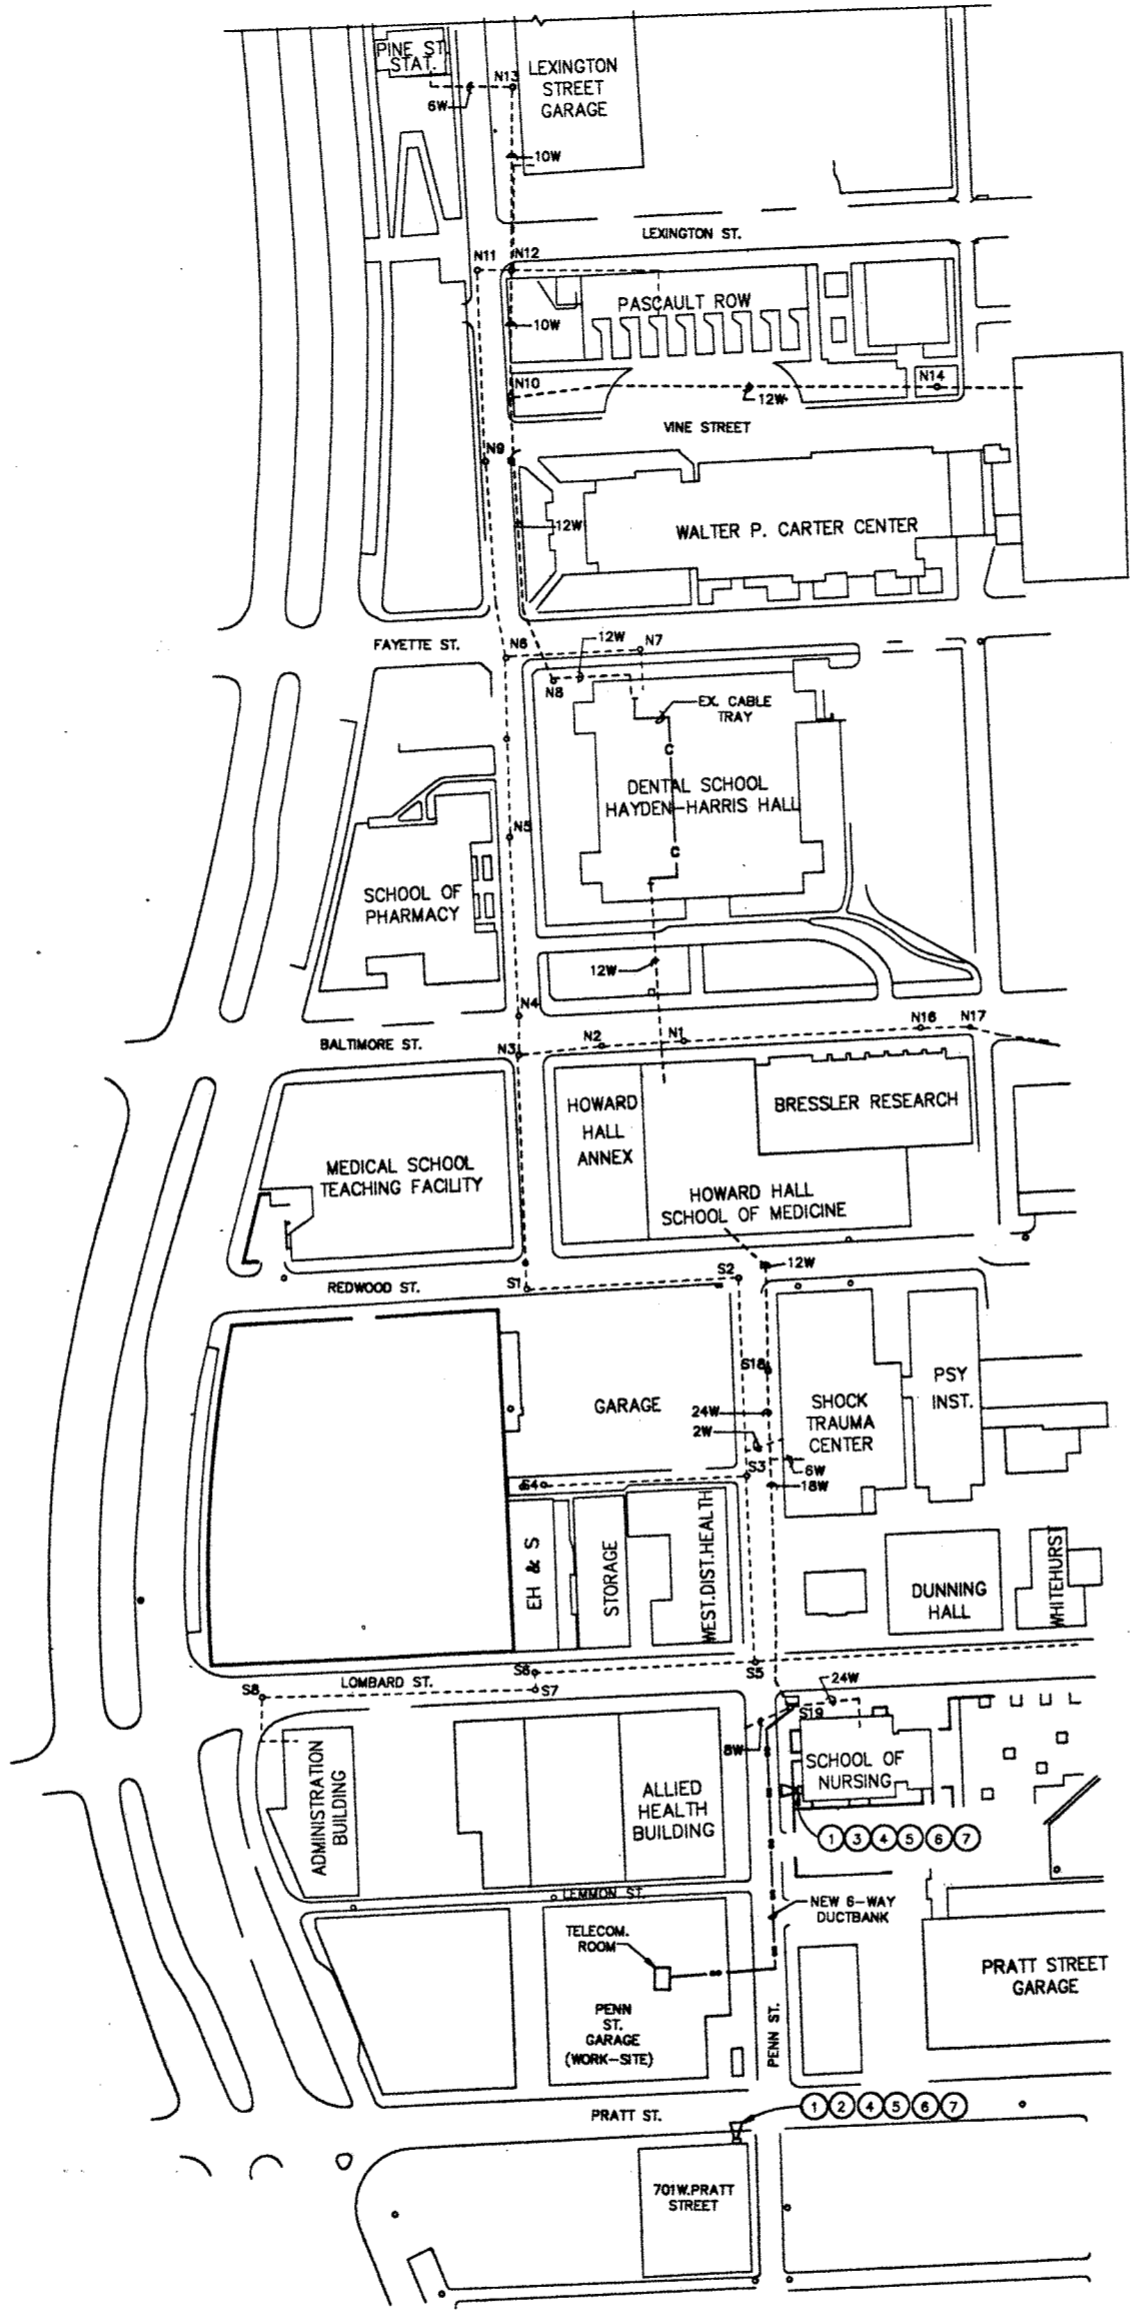




CAMPUS SITE PLAN
SCALE: 1"=100'-0"

- GENERAL NOTES:**
- ALL LOCATIONS ARE APPROXIMATE. CONTRACTOR TO VERIFY ITS CORRECTNESS AND CONDITIONS OF THE EXISTING DUCTBANKS TO REUSE.
 - CONTRACTOR TO RUN CABLES PARTLY THROUGH NEW & PARTLY THROUGH EXISTING UMAB OWNED DUCTBANK.
 - CONTRACTOR SHALL SUBMIT SKETCHES SHOWING THE EXISTING DUCTBANKS TO REUSE FOR OWNER/ENGINEER APPROVAL PRIOR TO START CABLING.






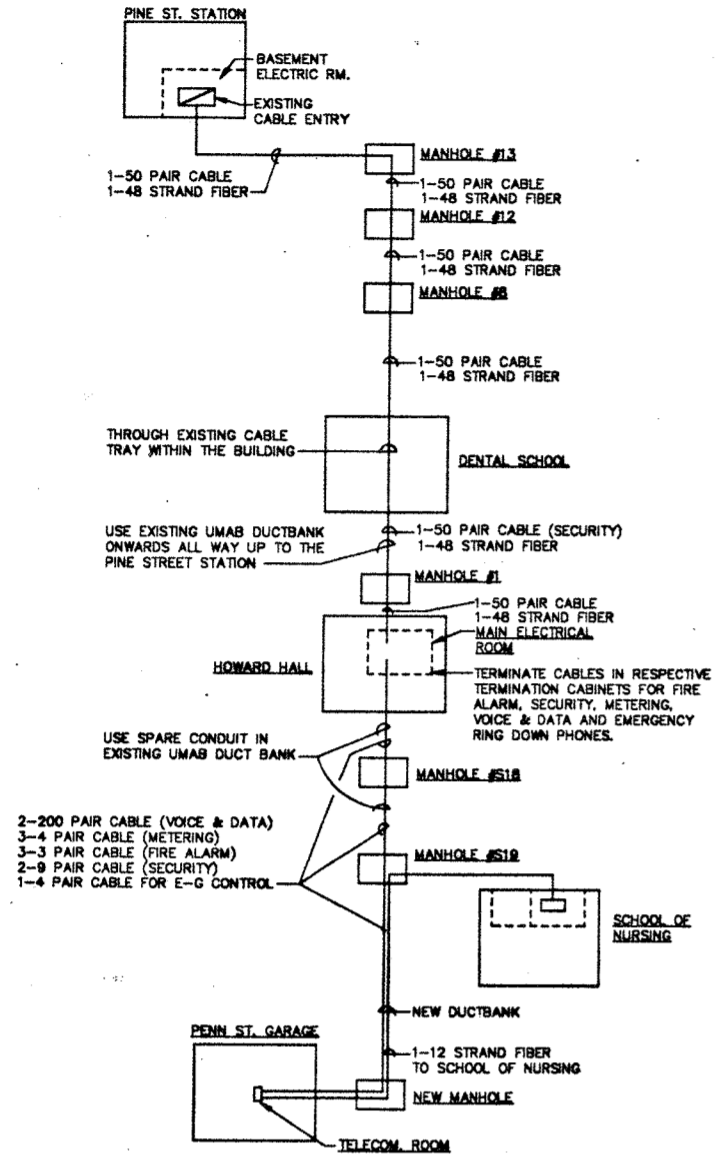


BUILDING INTERFACE-SINGLE LINE DIAGRAM
NO SCALE


SYMBOL	DESCRIPTION
---○---	EXISTING DUCTBANK & MANHOLE
---○---	EXISTING DUCTBANK & MANHOLE WITH NEW CABLING, REFER TO ONE LINE DIAGRAM AND BUILDING PLANS
---	NEW TELECOM. DUCT BANK
---	EXISTING CABLE TRAY WITH NEW CABLING, REFER TO SINGLE LINE DIAGRAM AND BUILDING PLANS
6W	6 WAY DUCTBANK
10W	10 WAY DUCTBANK
12W	12 WAY DUCTBANK
24W	24 WAY DUCTBANK
N1	MANHOLE NO. 1 NORTH OF HOWARD HALL
S1	MANHOLE NO. 1 SOUTH OF HOWARD HALL
□	CAMERA FOR UMAB BLDG. EXTERIOR CCTV SURVEILLANCE SYSTEM (QTY. TWO)

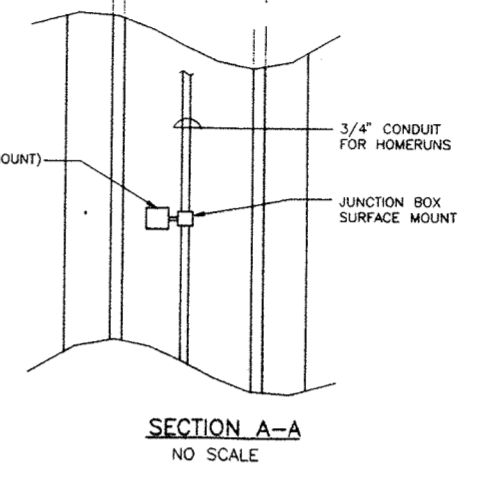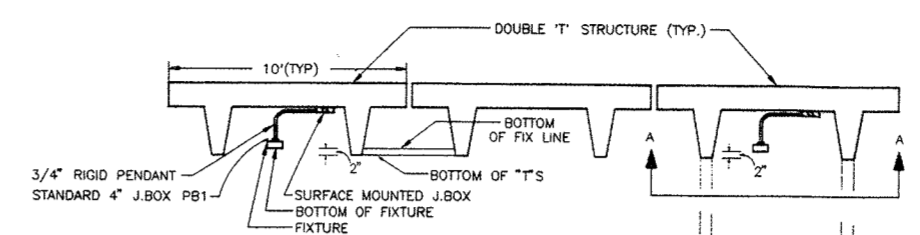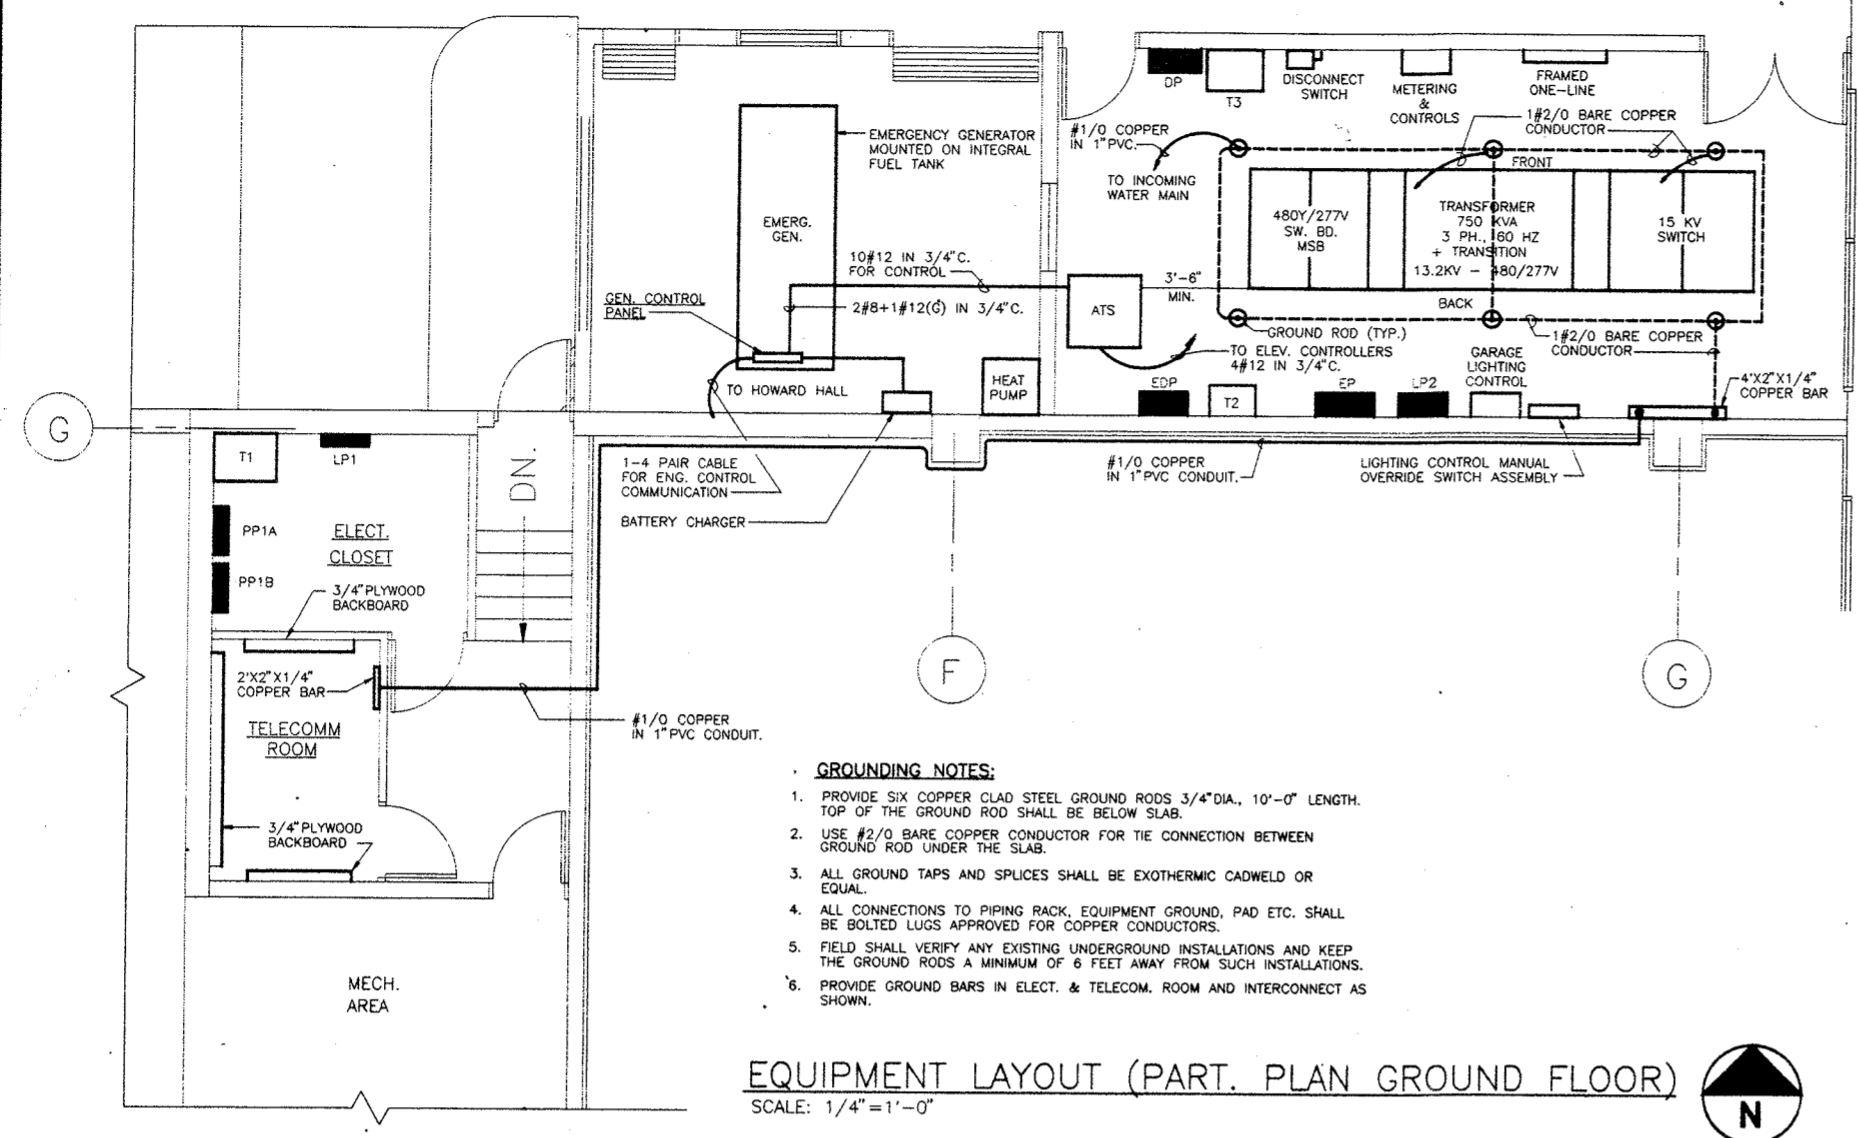

FIXTURE MOUNTING DETAIL
NO SCALE

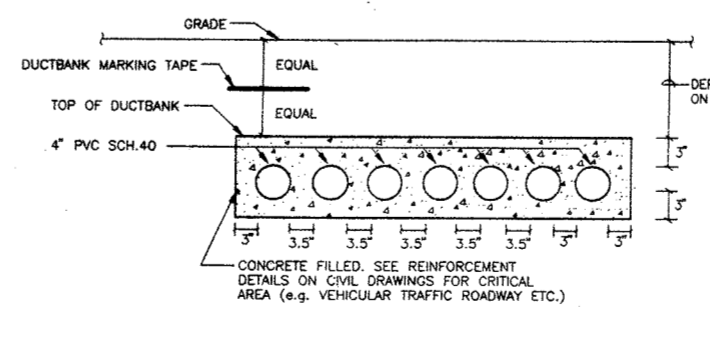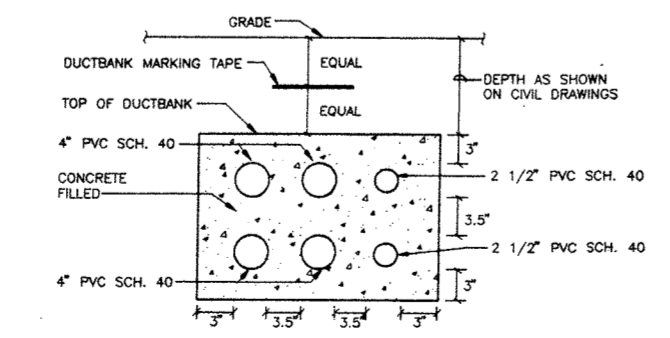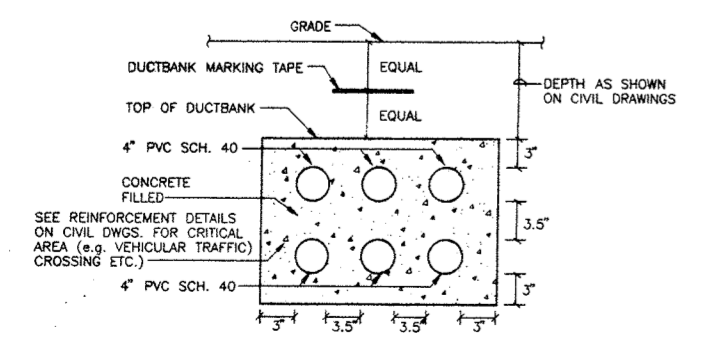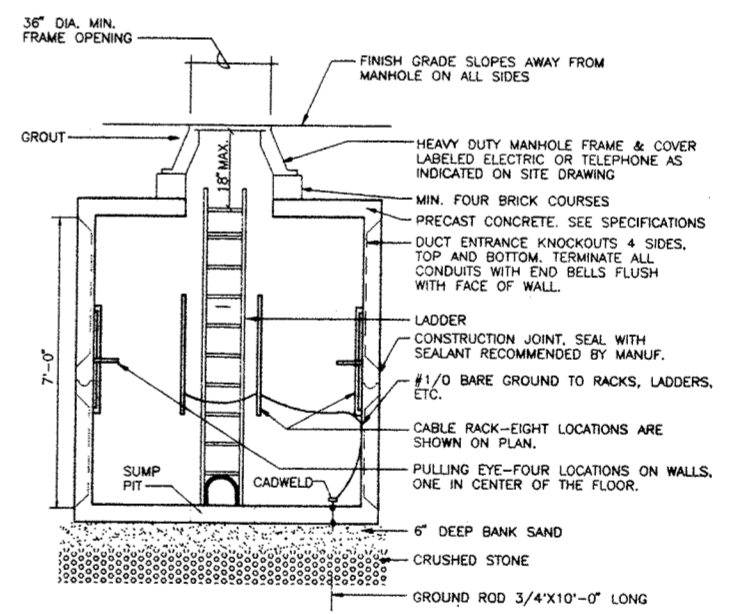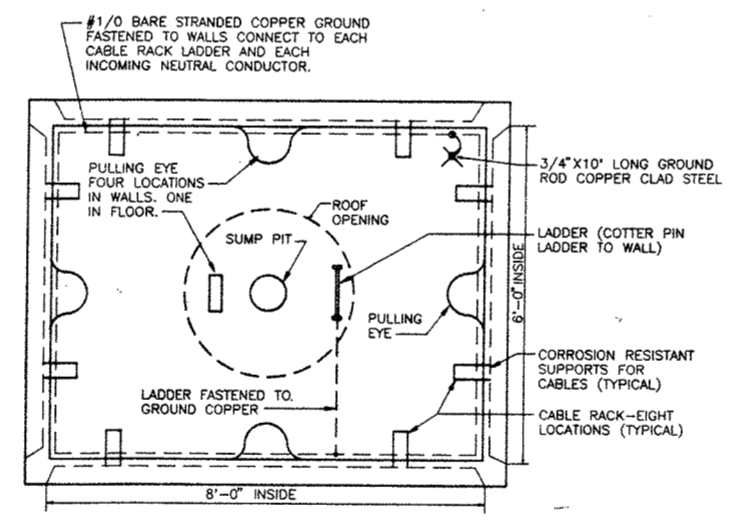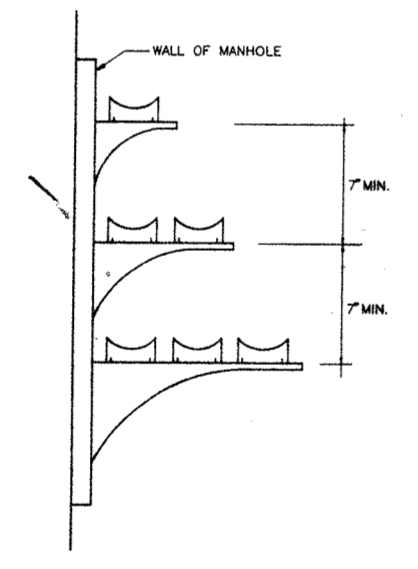

THE LAST AND SEVENTH CONDUIT SHALL BE KEPT RESERVED FOR C&P LINE. THIS CONDUIT IS NOT REQUIRED TO EXTEND TO MANHOLE. RATHER IT SHALL BE CARRIED AT GARAGE SIDE CURB OF PENN ST. ROAD FOR C&P ACCESSIBILITY WHEN REQUIRED.

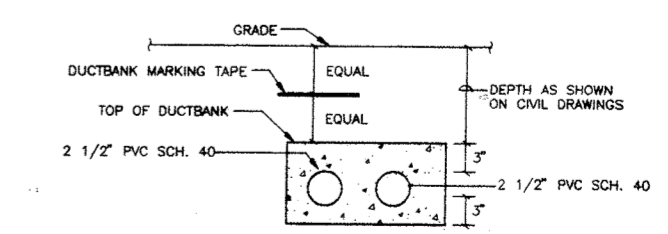

NOTE:
1) SEE CIVIL AND STRUCTURAL DRAWINGS FOR BOTH CONCRETE AND REINFORCED CONCRETE ENCASED DUCTWORK DETAILS AND ELEVATIONS.

ELECTRICAL DETAILS

DRAWING NO.
E-19

SCALE: 1/8"=1'-0"
DATE: 6-24-1993
PROJECT NO. J-343
DESIGN DRAWN: J-343
R.P. I.P. R.N.S.

APRIL 3, 1995 AS-BUILTS

G:\PROJECTS\92700\1-E19 11/23/93 11:59