

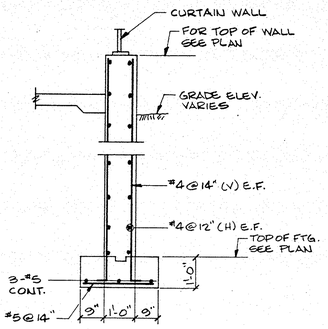



4B

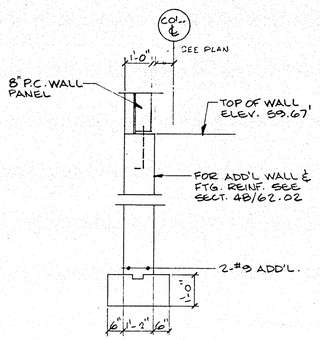


4E

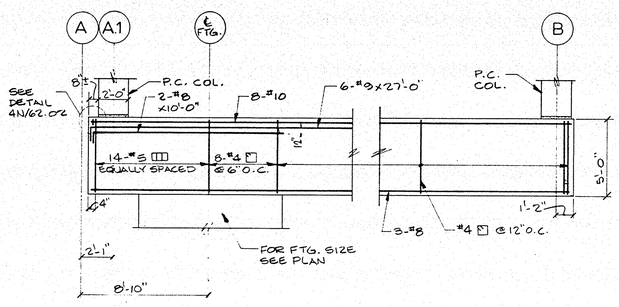


4K

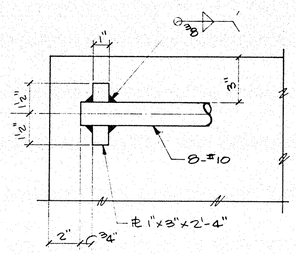


4N

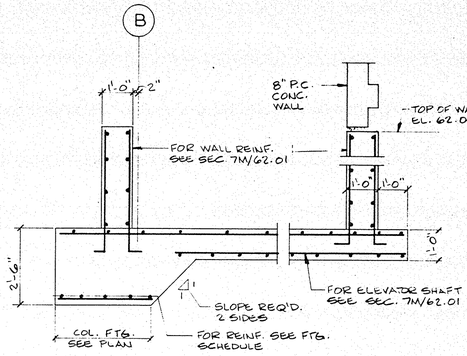


4S

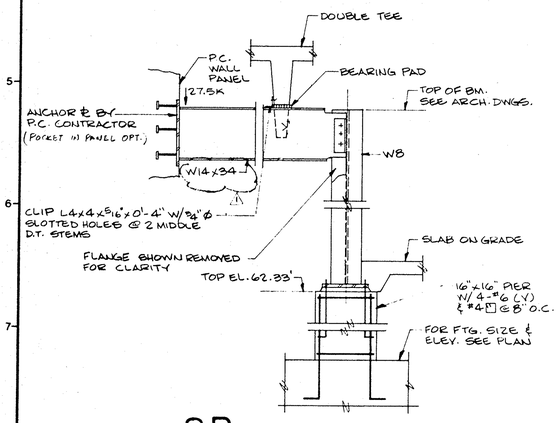

8B

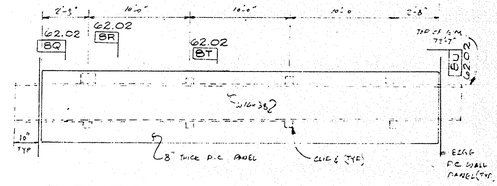

ELEVATION-PRECAST OVER ENTRANCE

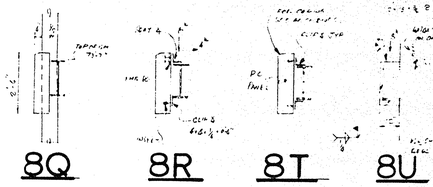

8Q 8R 8T 8U

AS-BUILT RECORD DRAWING

PEARL STREET GARAGE

UNIVERSITY of MARYLAND at BALTIMORE, MARYLAND 21201

UMAB project no. 85 304 A

Approvals

Director of Physical Plant

Project Architect

Department of General Services, Project Administrator

Director of Engineering and Construction

No.	Date	Item	No.	Date	Item

REVISIONS

Seal

Drawn | Checked

Approved


RTKL ASSOCIATES INC.
400 East Pratt Street
Baltimore Maryland 21202


Title: FOUNDATION SECTIONS AND DETAILS

Contr. No.	8527800
Scale	
Date	
Last Rev.	

62
02

RTKL DWG FORM NO. 14A D-5805 B

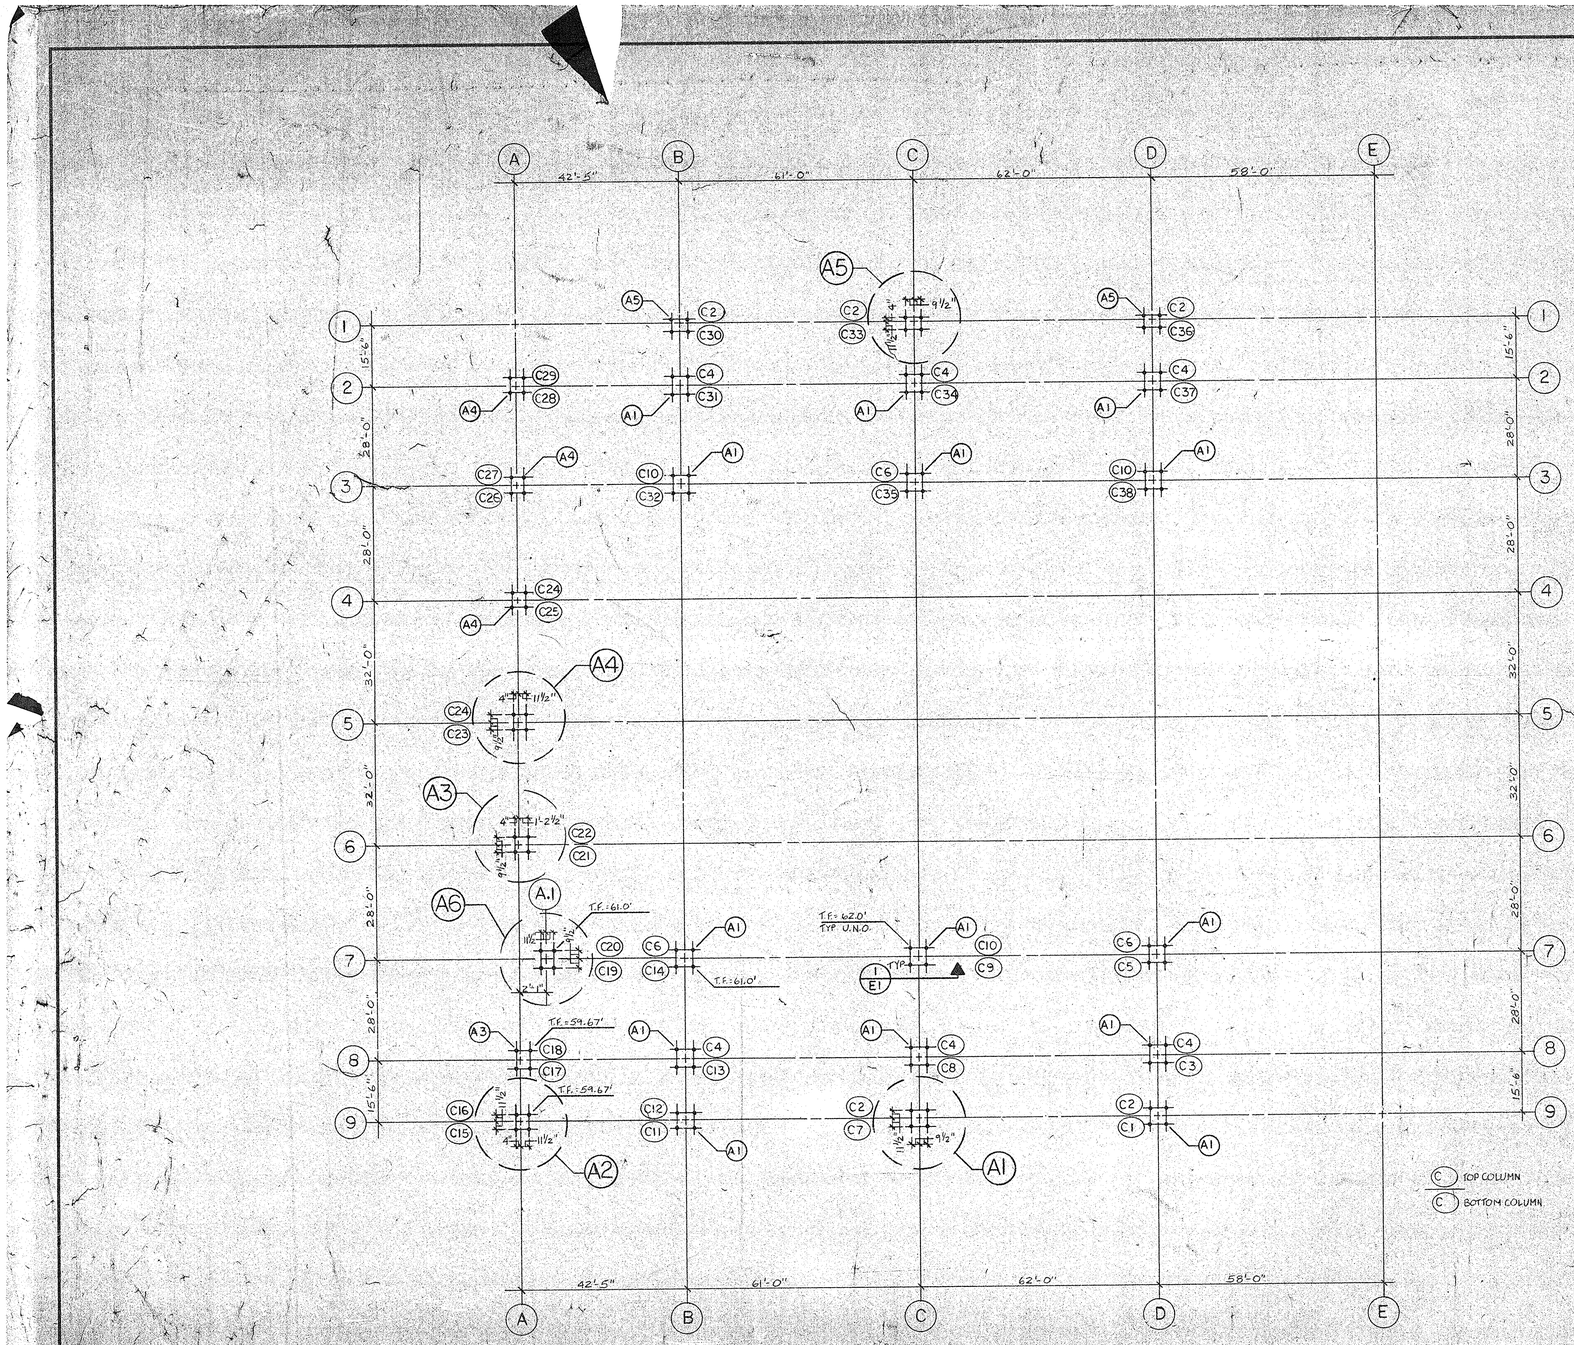

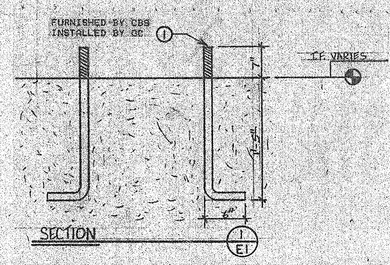

NO	DATE	REVISION/ACTION	BY
1	9-19-86	RELEASED FOR EXECUTION	
2	10-31-86	SENT TO GC/ARCH FOR APPROVAL	
3	11-28-86	REVISED PER APPROVED DRAWINGS DATED 10-31-86 AND RESUBMITTED FOR FINAL APPROVAL	TKO

C TOP COLUMN
C BOTTOM COLUMN

RECORD DRAWING
DATE: 3/2/88

APPROVED AS CORRECTED ( )
REVISE AND RESUBMIT ( )
NOT APPROVED ( )

CHECKING IS ONLY FOR CONFORMANCE WITH THE DESIGN CONCEPT OF THE PROJECT AND COMPLIANCE WITH THE INFORMATION GIVEN IN THE CONTRACT DOCUMENTS. CONTRACTOR IS RESPONSIBLE FOR DIMENSIONS TO BE CONFIRMED AND CORRELATED AT THE JOB SITE, FOR INFORMATION THAT PERTAINS SOLELY TO THE FABRICATION PROCESSES, TO THE TECHNIQUES OF CONSTRUCTION AND FOR COORDINATION OF THE WORK OF ALL TRADES.

DEPARTMENT OF HOUSING AND COMMUNITY DEVELOPMENT
BALTIMORE, MARYLAND

3/2/88 BY

RTKL Associates Inc.
Approval is for design only. Contractor is responsible for dimensions, quantities and coordination with other trades. Approval does not relieve contractor of contract requirements unless stated specifically in Change Order.
Approved — Rejected
Approved as noted — Returned for correction
Reference — Resubmit
By: — Date: 1.2.87
Architectural — Engineering

DRAWN: 8-8-86 BY
CHECKED: 9-10-86 BY
APPROVED: 10-10-86 BY
PROJECT NO: 6003
DWG NO: E-1

PROJECT: PEARL STREET GARAGE
BALTIMORE, MARYLAND
GENERAL CONTRACTOR: VINTON SCHAEFER & SONS
ARCHITECT: RTKL
DRAWING TITLE: ANCHOR BOLT PLAN

CONCRETE BUILDING SYSTEMS

PCI CERTIFIED PLANT


10/1/87


APPROVED AS CORRECTED ( )
REVISE AND RESUBMIT ( )
NOT APPROVED ( )

CHECKING IS ONLY FOR CONFORMANCE WITH THE DESIGN CONCEPT OF THE PROJECT AND COMPLIANCE WITH THE INFORMATION GIVEN IN THE CONTRACT DOCUMENTS. CONTRACTOR IS RESPONSIBLE FOR DIMENSIONS TO BE CONFIRMED AND CORRELATED AT THE JOB SITE; FOR INFORMATION THAT PERTAINS SOLELY TO THE FABRICATION PROCESSES OR TO TECHNIQUE OF CONSTRUCTION; AND FOR COORDINATION OF THE WORK OF ALL TRADES.

UNIVERSITY OF MARYLAND AT BALTIMORE
OFFICE OF FACILITIES MANAGEMENT

DATE 5/27/87 BY

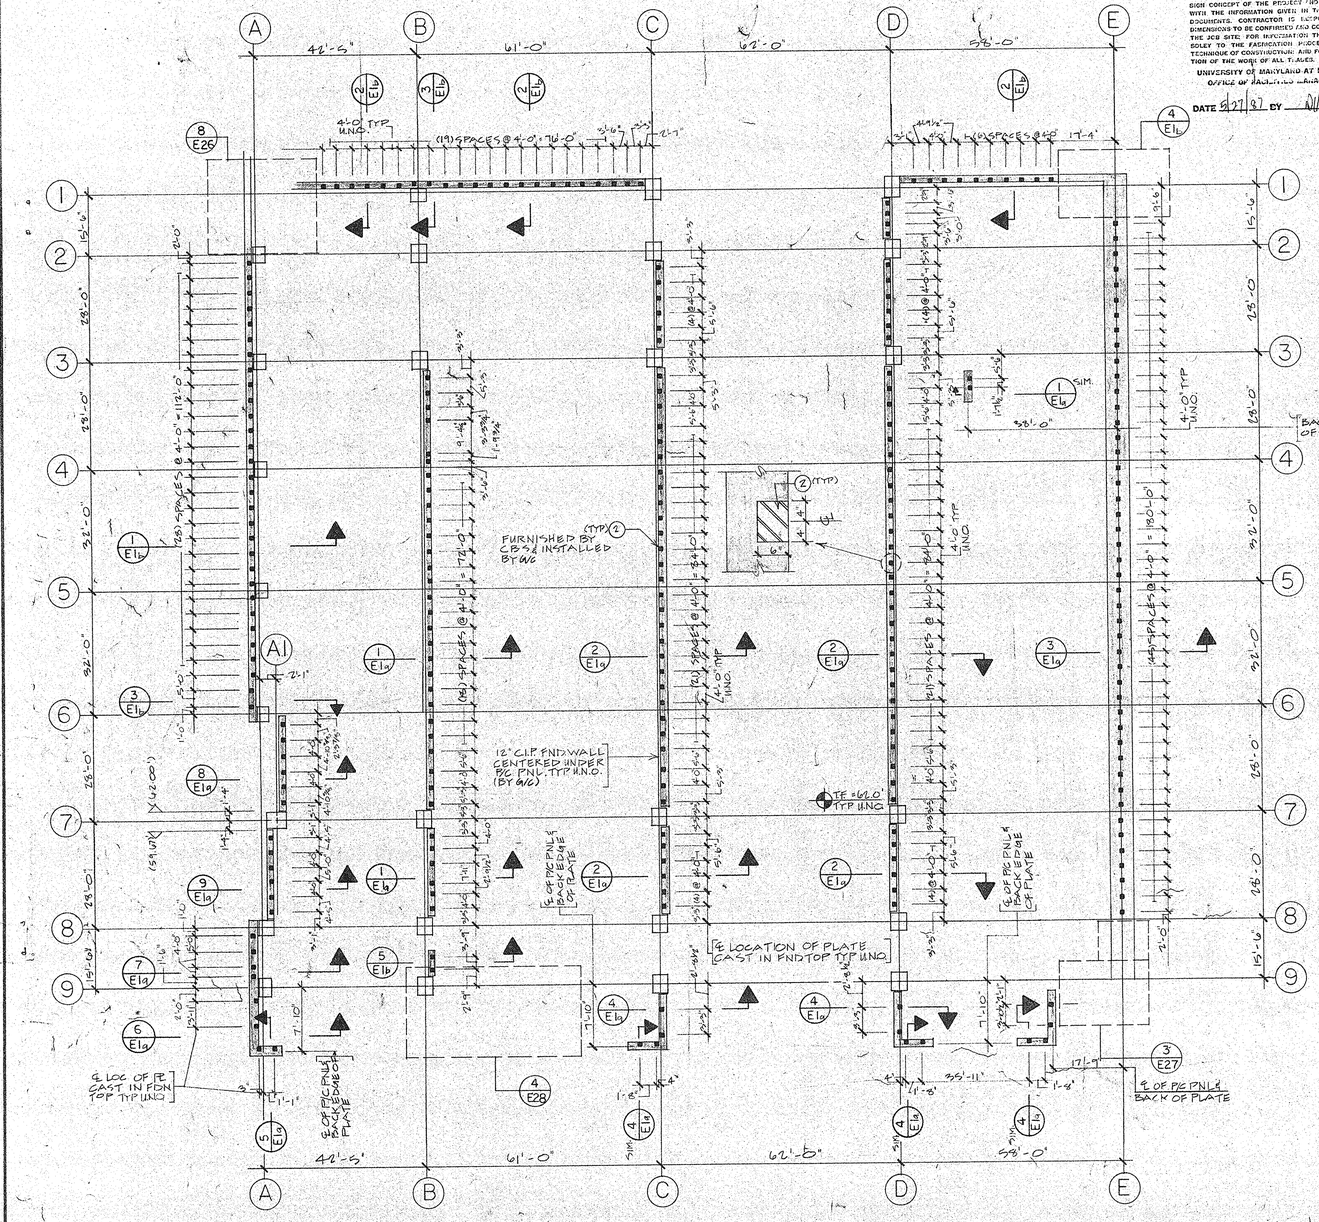

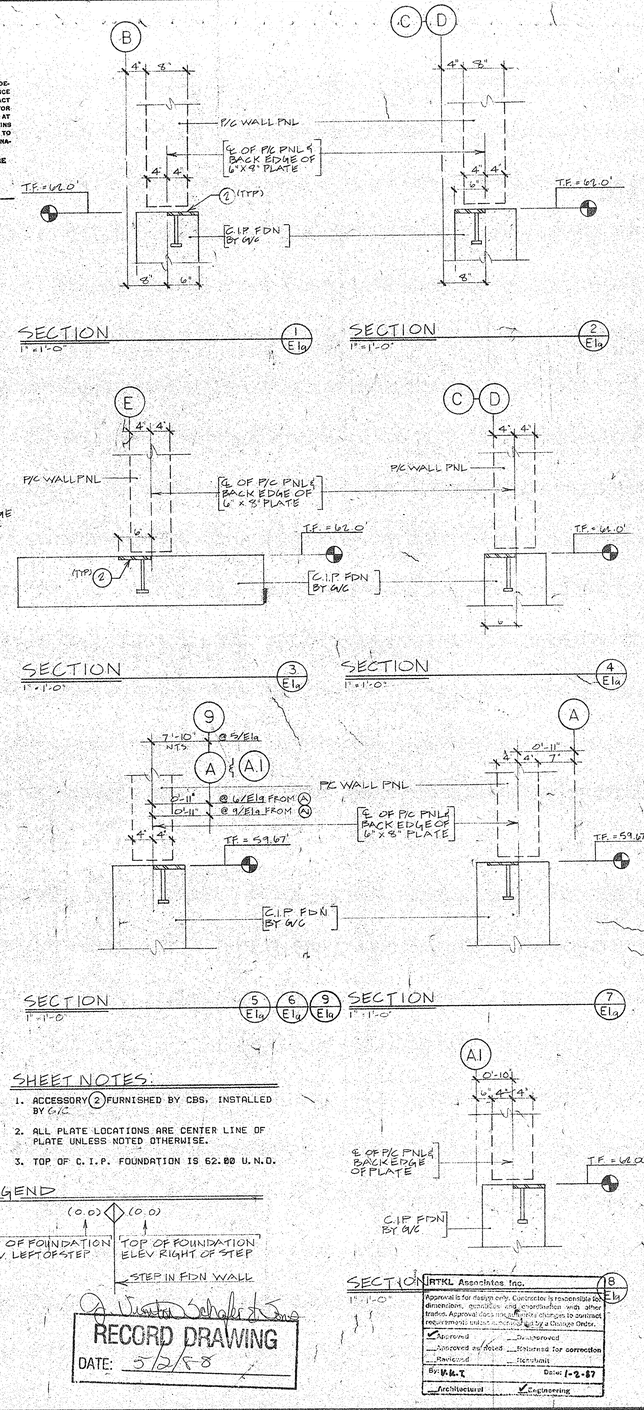

SHEET NOTES:

1. ACCESSORY (2) FURNISHED BY CBS, INSTALLED BY G/C.
2. ALL PLATE LOCATIONS ARE CENTER LINE OF PLATE UNLESS NOTED OTHERWISE.
3. TOP OF C.I.P. FOUNDATION IS 62.00 U.N.O.

LEGEND

(0.0) 'TOP OF FOUNDATION ELEV. LEFT OF STEP'
(0.0) 'TOP OF FOUNDATION ELEV. RIGHT OF STEP'
STEP IN FDN WALL

RECORD DRAWING
DATE: 5/2/88

NO	DATE	REVISION/ACTION	BY
3	11-25-86	REVISED PER APPROVED DRAWINGS DATED 9-24-86 & 10-1-86. RESUBMITTED FOR FINAL APPROVAL	JKO
2	10-10-86	RELEASED FOR ERECTION	JKO
1	9-17-86	SENT TO G/C FOR REVIEW/APPROVAL	BY

PCI CERTIFIED PLANT


CONCRETE BUILDING SYSTEMS
P.O. BOX 68, CEDAR, MD. 20619
(301) 884-5800


PROJECT: PEARL STREET GARAGE
BALTIMORE, MARYLAND
GENERAL CONTRACTOR: J. VINTON SCHAFER & SONS
ARCHITECT: RTKL
DRAWING TITLE: FOUNDATION PLAN

DRAWN: 9-19-86 BY GAH
CHECKED: 10-10-86 BY JKO
APPROVED: 10-10-86 BY JKO
PROJECT NO: 6003
DWG NO. E-1a

RTKL Associates Inc.
Approval is for design only. Contractor is responsible for dimensions, quantities and coordination with other trades. Approval does not relieve contractor of contract requirements unless authorized by a Change Order.
Approved / Disapproved
Approved as noted / Returned for correction
Reviewed / Returned
By: W.M.Z. Date: 1-2-87
Architectural / Engineering

1018.22

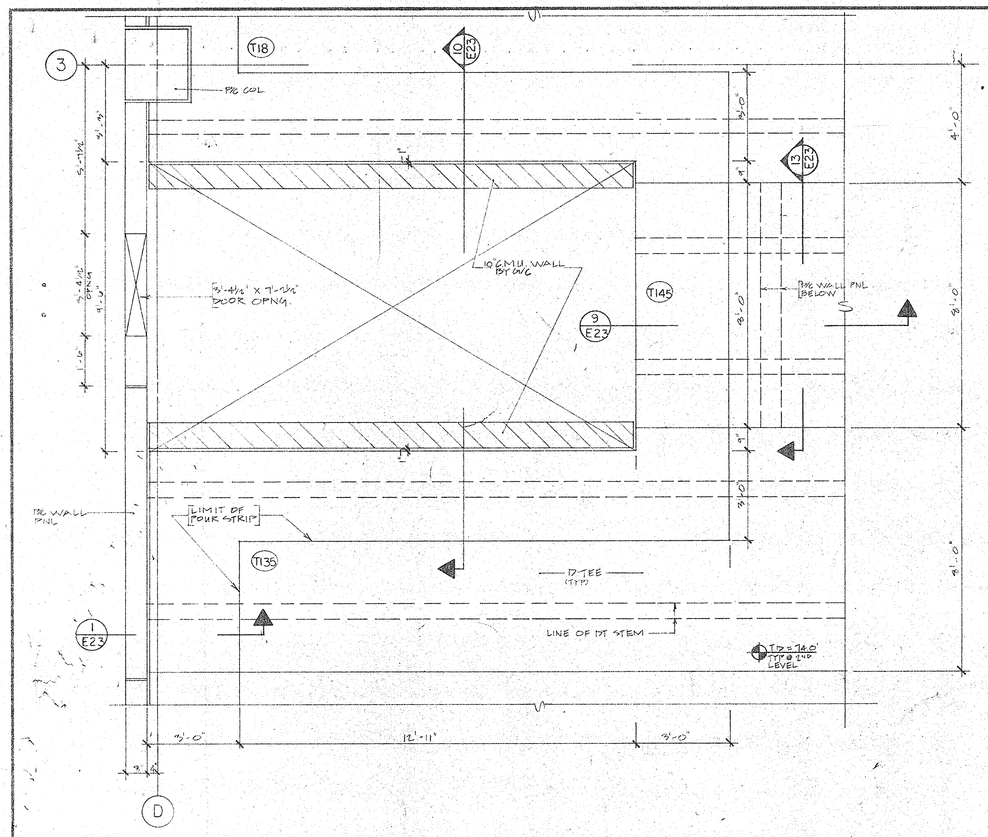


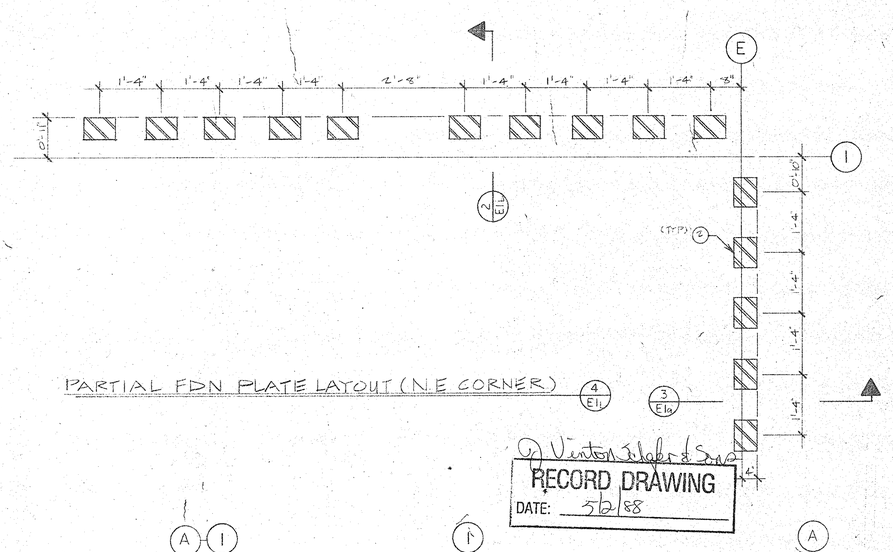

PARTIAL FDN PLATE LAYOUT (N.E CORNER) 4 E11 3 E1a

Vinton Schafer & Sons

RECORD DRAWING
DATE: 5/2/88

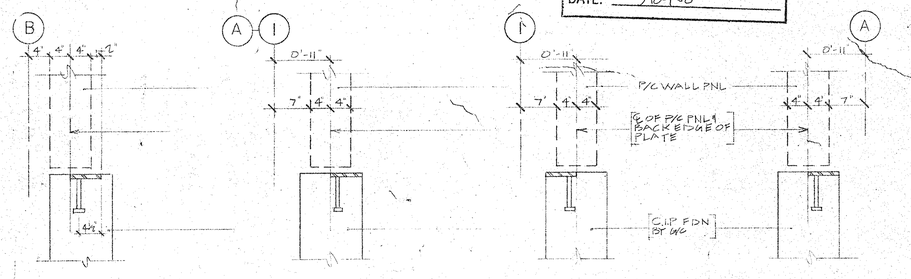



SECTION 5 E1b

SECTION 3 E1b


SECTION 2 E1b

SECTION 1 E1b

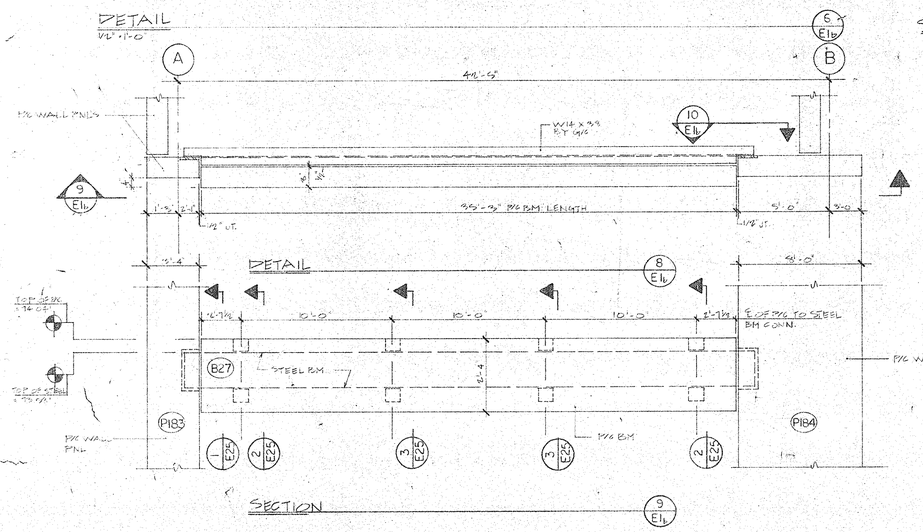

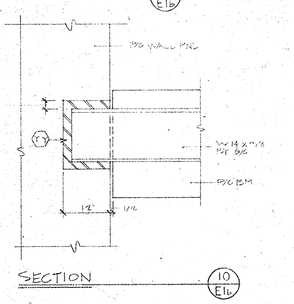

SECTION 10 E1b

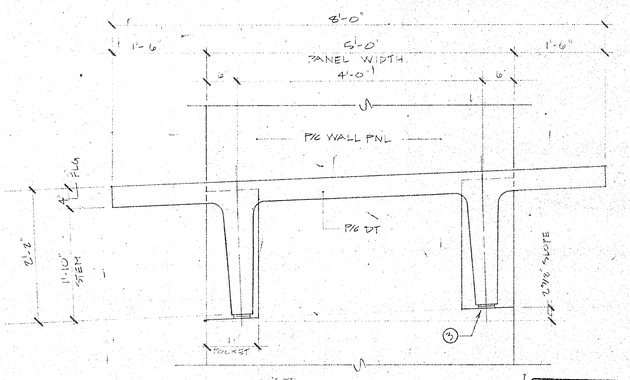

DETAIL
TYPICAL DT BRG. ON WALL PNL (5'-0" WIDE) POCKET

APPROVED AS CORRECTED	( )
REVISE AND RESUBMIT	( )
NOT APPROVED	( )

CHECKING IS ONLY FOR CONFORMANCE WITH THE DESIGN CONCEPT OF THE PROJECT AND COMPLIANCE WITH THE INFORMATION GIVEN IN THE CONTRACT DOCUMENTS. CONTRACTOR IS RESPONSIBLE FOR DIMENSIONS TO BE CONFIRMED AND CORRELATED AT THE JOB SITE. FOR INFORMATION THAT PERTAINS SOLELY TO THE FABRICATION PROCESSES OR TO TECHNIQUE OF CONSTRUCTION, AND FOR COORDINATION OF THE WORK OF ALL TRADES.

UNIVERSITY OF MARYLAND AT BALTIMORE
OFFICE OF FACILITIES MANAGEMENT

DATE 5/21/87 BY DHP

RTKL Associates Inc.

Approval is for design only. Contractor is responsible for dimensions, quantities and coordination with other trades. Approval does not authorize changes to contract requirements unless conspicuously noted by a Change Order.

Approved | Disapproved
Approved as noted | Returned for correction
Reviewed | Resubmit
By: RKT | Date: 5-28-87
Architectural | Engineering

NO	DATE	REVISION/ACTION	BY
2	4/15/87	REVISED PER APPROVED DRAWINGS DATED 3-26-87 & 4-15-87. RESUBMITTED FOR FINAL APPROVAL	WKS
1	3/5/87	ISSUED FOR CONSTRUCTION	GAH

PCI CERTIFIED PLANT

CONCRETE BUILDING SYSTEMS
P.O. BOX 48, DELMAR, DEL. 19940 302-846-3545

PROJECT: PEARL STREET GARAGE
BALTIMORE, MARYLAND

GENERAL CONTRACTOR: J. VINTON SCHAFER & SONS
ARCHITECT: RTKL
DRAWING TITLE: DETAILS & SECTIONS

DRAWN: 5-12-86 BY GAH
CHECKED: BY
APPROVED: BY
PROJECT NO: 6003
DWG. NO. E-1b


1018-89

NO.	DATE	REVISION/ACTION	BY
2	11-28-84	REVISED PER APPROVED DRAWINGS DATED 5-15-84 - SEE RESUBMITTED SHEET	GAH
1	5-15-84	SENT TO GC/ARCH FOR APPROVAL	GAH


APPROVED AS CORRECTED ( )
REVISE AND RESUBMIT ( )
NOT APPROVED ( )

CHECKING IS ONLY FOR CONFORMANCE WITH THE DESIGN CONCEPT OF THE PROJECT AND COMPLIANCE WITH THE INFORMATION GIVEN IN THE CONTRACT DOCUMENTS. CONTRACTOR IS RESPONSIBLE FOR DIMENSIONS TO BE CONFIRMED AND CORRELATED AT THE JOB SITE. FOR INFORMATION THAT PERTAINS SOLELY TO THE FABRICATION PROCESSES OR TO TECHNIQUE OF CONSTRUCTION; AND FOR COORDINATION OF THE WORK OF ALL TRADES.


UNIVERSITY OF MARYLAND AT BALTIMORE
OFFICE OF FACILITIES MANAGEMENT
DATE 5/27/87 BY

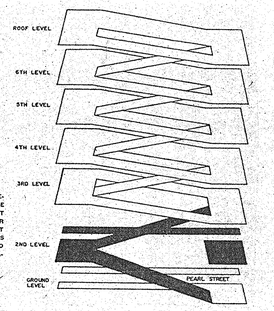

ISOMETRIC VIEW

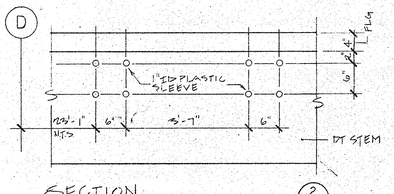

SECTION
SECTION APPLIES BOTH STEMS OF T-19

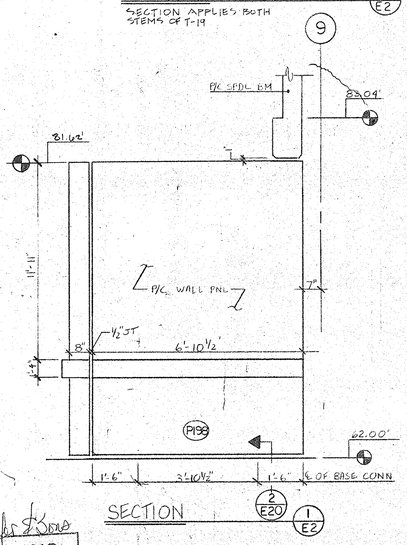

SECTION

RECORD DRAWING
DATE: 5/28/88

RTKL Associates Inc.
Approval is for design only. Contractor is responsible for dimensions, quantities and coordination with other trades. Approval does not authorize changes to contract requirements unless accompanied by a Change Order.
Approved / Disapproved
Approved as noted / Returned for correction
Reviewed / Resubmit
By: Date: 1.9.87
Architectural / Engineering

DESIGN LOADS

LEVEL	SUPERIMPOSED DEAD LOAD	LIVE LOAD
2ND LEVEL SHELL SPACE	0 *	100psf
TYPICAL PARKING DECK 3rd, 4th, 5th & 6th	0	50psf

* NOT INCLUDING 2" FUTURE TOPING

SECOND LEVEL FRAMING PLAN 1/16" = 1'-0"

SHEET NOTES

1. SEE SHEET E-25 FOR ACCESSORY KEY, ERECTION NOTES, GENERAL NOTES, ABBREVIATIONS, AND PRODUCT CONCRETE STRENGTH.
2. ALL DECK ELEVATIONS OCCUR ON TOP OF 4" FLANGE AT THE COLUMN CENTER LINES U.N.O.
3. H DENOTES DT BRG ON WALL PANEL OR SPDL HAUNCH.
4. P DENOTES DT BRG ON WALL POCKET.


PCI CERTIFIED PLANT


CONCRETE BUILDING SYSTEMS

PROJECT: PEARL STREET GARAGE
BALTIMORE, MARYLAND
GENERAL CONTRACTOR: J. VINTON SCHAFER & SONS
ARCHITECT: RTKL
DRAWING TITLE: SECOND LEVEL FRAMING PLAN


DRAWN: 8-8-86 BY JLS
CHECKED: 5-15-84 BY GAH
APPROVED: BY
PROJECT NO: 6003
DWG. NO. E-2

10/6 30

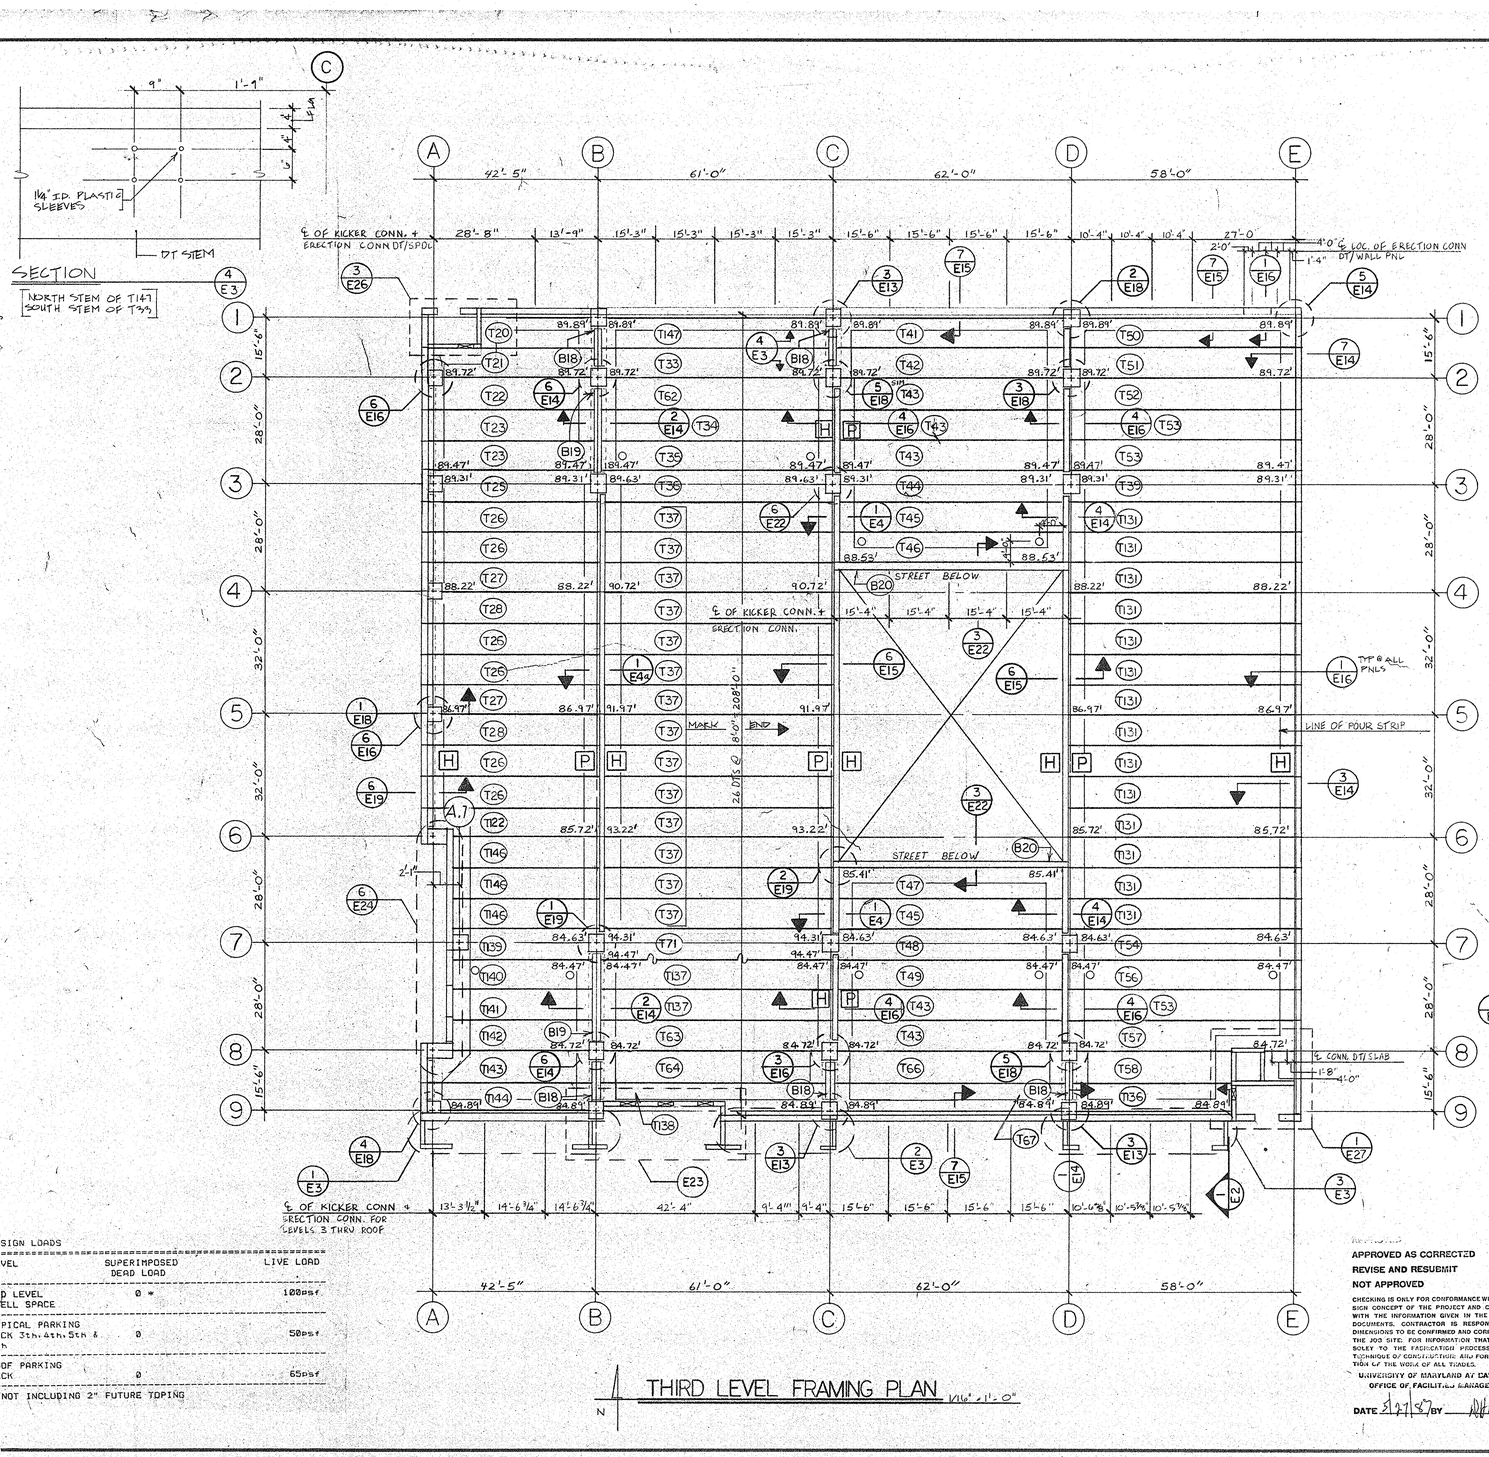

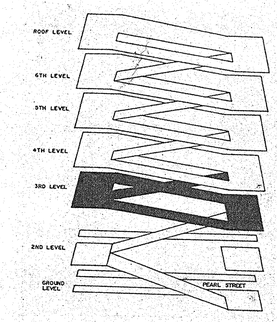

ISOMETRIC VIEW

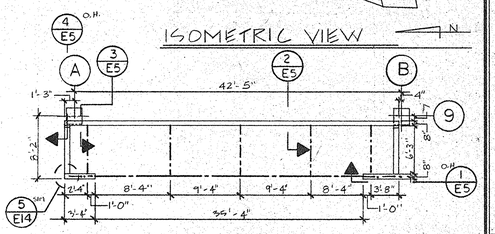

DESIGN LOADS

LEVEL	SUPERIMPOSED DEAD LOAD	LIVE LOAD
2ND LEVEL SHELL SPACE	0 *	100psf
TYPICAL PARKING DECK 3th, 4th, 5th & 6th	0	50psf
ROOF PARKING DECK	0	65psf

* NOT INCLUDING 2" FUTURE TOPING

APPROVED AS CORRECTED ( )
REVISE AND RESUBMIT ( )
NOT APPROVED ( )

CHECKING IS ONLY FOR CONFORMANCE WITH THE DESIGN CONCEPT OF THE PROJECT AND COMPLIANCE WITH THE INFORMATION GIVEN IN THE CONTRACT DOCUMENTS. CONTRACTOR IS RESPONSIBLE FOR DIMENSIONS TO BE CONFIRMED AND CORRELATED AT THE JOB SITE. FOR INFORMATION THAT PERTAINS SOLELY TO THE FABRICATION PROCESSES OR TO TECHNIQUES OF CONSTRUCTION, AND FOR COORDINATION OF THE WORK OF ALL TRADES.

UNIVERSITY OF MARYLAND AT BALTIMORE
OFFICE OF FACILITIES MANAGEMENT
DATE 5/27/87 BY

RECORD DRAWING
DATE: 5/6/88
Viston Schaefer & Sons

RTKL Associates Inc.
Approval is for design only. Contractor is responsible for dimensions, examining and coordination with other trades. Approval does not authorize changes to contract requirements without documentation by a Change Order.
✓ Approved ___ Disapproved
___ Approved as noted ___ Returned for correction
___ Resubmit ___ Received
By: U.H.T. Date: 1.2.87
___ Architecture ✓ Engineering

SHEET NOTES:


1. SEE SHEET E-25 FOR ACCESSORY KEY, ERECTION NOTES, GENERAL NOTES, ABBREVIATIONS, AND PRODUCT CONCRETE STRENGTH.
2. ALL DECK ELEVATIONS OCCUR ON TOP OF 4" FLANGE AT THE COLUMN CENTER LINES U.N.O.
3. [H] DENOTES DT BRG ON WALL PANEL OR SPDL HAUNCH.
4. [P] DENOTES DT BRG ON WALL PANEL POCKET.

NO.	DATE	REVISION/ACTION	BY
2	11-23-86	REVISED PER APPROVED DRAWINGS DATED 9-24-86 & 10-13-86. RESUBMITTED FOR FINAL APPROVAL	JSM
1	5-15-86	ISSUED FOR MARCH FOR APPROVAL	GAH

CONCRETE BUILDING SYSTEMS
P.O. BOX 48, DELMAR, DEL. 19940 302-846-3645

PROJECT: PEARL STREET GARAGE
BALTIMORE, MARYLAND
GENERAL CONTRACTOR: J VINTON SCHAFER & SONS
ARCHITECT: RTKL
DRAWING TITLE: THIRD LEVEL FRAMING PLAN

DRAWN: 8-8-86 BY
CHECKED: 5-15-86 BY GAH
APPROVED: BY
PROJECT NO: 6003
DWG. NO. E-3

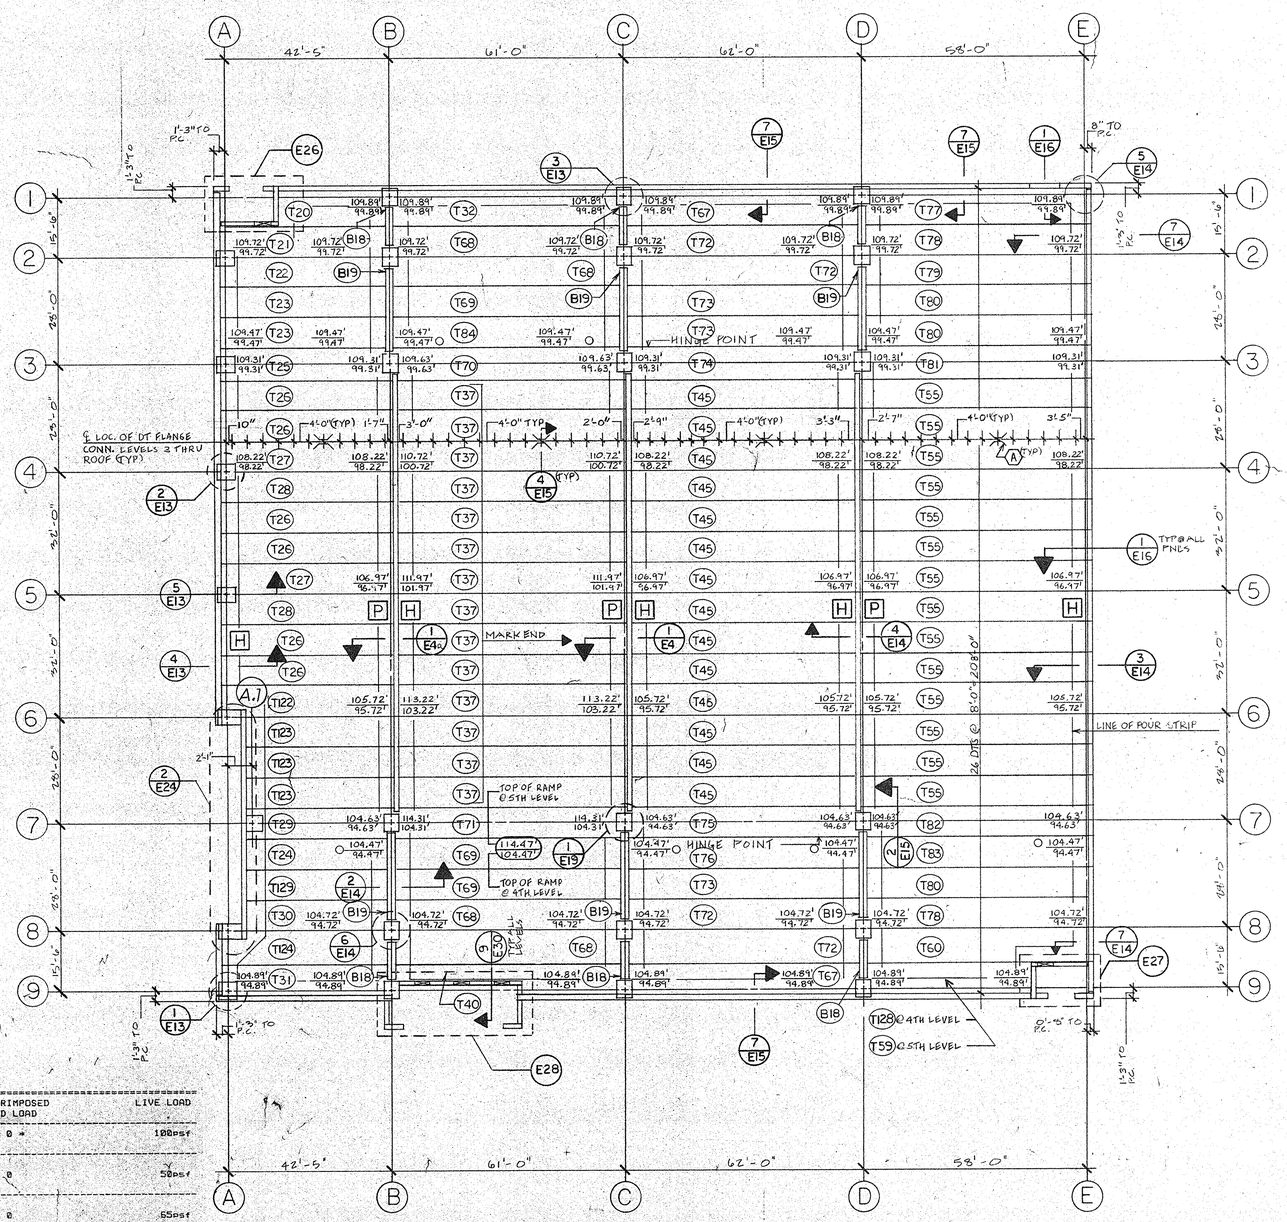


TYPICAL FRAMING PLAN
LEVELS 4&5
1/16" = 1'-0"

N

DESIGN LOADS


LEVEL	SUPERIMPOSED DEAD LOAD	LIVE LOAD
2ND LEVEL SHELL SPACE	0 *	100psf
TYPICAL PARKING DECK 3th, 4th, 5th & 6th	0	50psf
ROOF PARKING DECK	0	65psf

* NOT INCLUDING 2" FUTURE TOPING

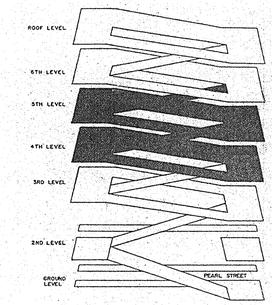

ISOMETRIC VIEW

N

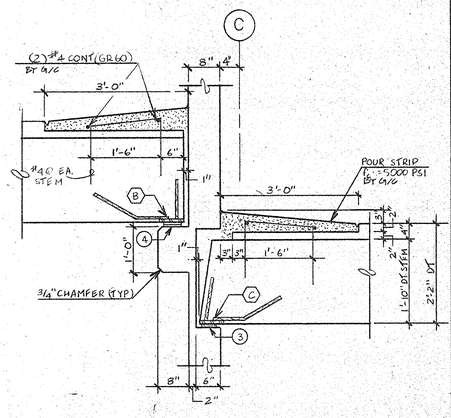

SECTION 1/E4

SEE 8/E14 FOR POUR STRIP DETAIL

J. Vinton Schafer & Sons
RECORD DRAWING
DATE: 5/2/88

APPROVED
APPROVED AS CORRECTED
REVISE AND RESUBMIT
NOT APPROVED

CHECKING IS ONLY FOR CONFORMANCE WITH THE DESIGN CONCEPT OF THE PROJECT AND COMPLIANCE WITH THE INFORMATION GIVEN IN THE CONTRACT DOCUMENTS. CONTRACTOR IS RESPONSIBLE FOR DIMENSIONS TO BE CONFIRMED AND CORRELATED AT THE JOB SITE. FOR INFORMATION THAT PERTAINS SOLELY TO THE FABRICATION PROCESSES OR TO TECHNIQUE OF CONSTRUCTION; AND FOR COORDINATION OF THE WORK OF ALL TRADES.

UNIVERSITY OF MARYLAND AT BALTIMORE
OFFICE OF FACILITIES MANAGEMENT

DATE 5/27/87 BY [signature]

RTKL Associates Inc.

Approval is for design only. Contractor is responsible for dimensions, quantities and coordination with other trades. Approval does not authorize changes to contract requirements unless countersigned by a Change Order.

☑ Approved ☐ Disapproved
☐ Approved as noted ☐ Returned for comments
☐ Reviewed ☐ Resubmit
By: [signature] Date: 5/27/87
☐ Architectural ☑ Engineering

XXXX - DENOTES ELEV. @ 5TH LEVEL
XXXX - DENOTES ELEV. @ 4TH LEVEL

SHEET NOTES

1. SEE SHEET E-25 FOR ACCESSORY KEY. ERECTION NOTES. GENERAL NOTES, ABBREVIATIONS, AND PRODUCT CONCRETE STRENGTH.
2. ALL DECK ELEVATIONS OCCUR ON TOP OF 4" FLANGE AT THE COLUMN CENTER LINES U.N.O.
3. H DENOTES DT BRG ON WALL PANEL OR SPDL HAUNCH.
4. P DENOTES DT BRG ON WALL PANEL POCKET.

NO.	DATE	BY
4	4.22.87	GAH
	REVISED PER APPROVED DRAWINGS DATED 3-24-87 & 4-14-87. RESUBMITTED FOR FINAL APPROVAL	
3	3.16.87	GAH
	SENT TO DRAFTSMAN FOR APPROVAL REVISION/ADDITION	

PCI CERTIFIED PLANT


CONCRETE BUILDING SYSTEMS
10840 - 301-846-3645

PROJECT: PEARL STREET GARAGE
BALTIMORE, MARYLAND

GENERAL CONTRACTOR: J. VINTON SCHAFER & SONS
ARCHITECT: RTKL
DRAWING TITLE: 4TH & 5TH LEVEL FRAMING PLAN

DRAWN: 4-13-87 BY GAH
CHECKED: 4-13-87 BY GAH
APPROVED: BY


PROJECT NO: 6003
DWG. NO. E-4.

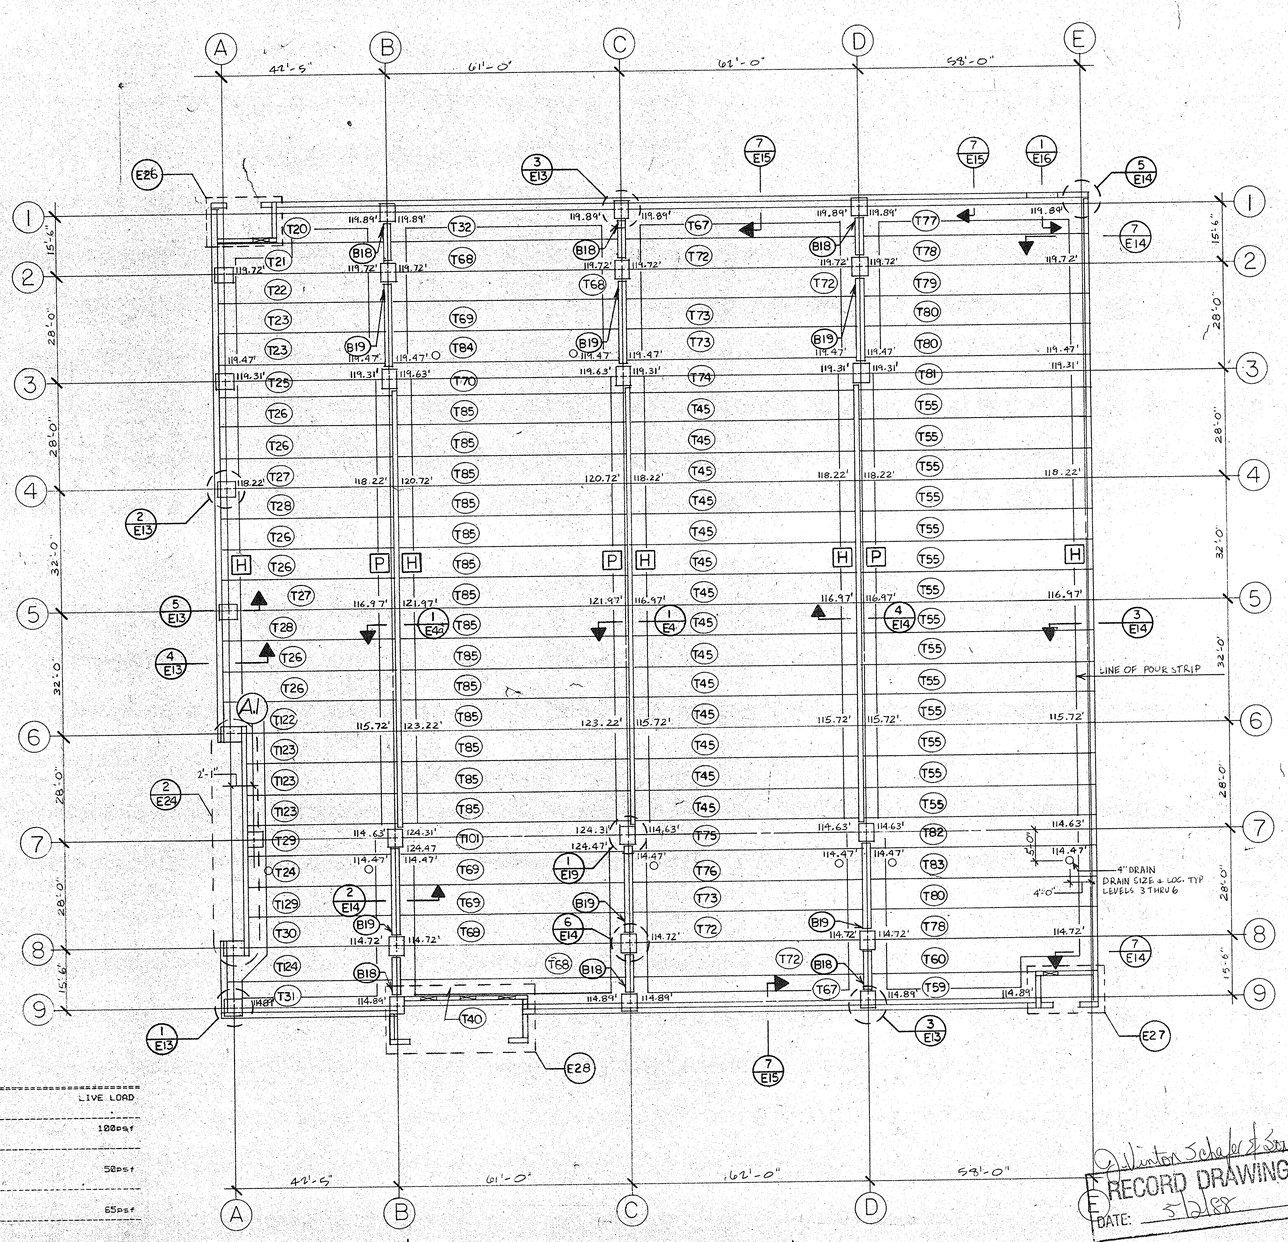


SIXTH LEVEL FRAMING PLAN 1/16"=1'-0"

DESIGN LOADS		
LEVEL	SUPERIMPOSED DEAD LOAD	LIVE LOAD
2ND LEVEL SHELL SPACE	0 *	100psf
TYPICAL PARKING DECK 3th, 4th, 5th & 6th	0	50psf
ROOF PARKING DECK	0	65psf

* NOT INCLUDING 2" FUTURE TOPING

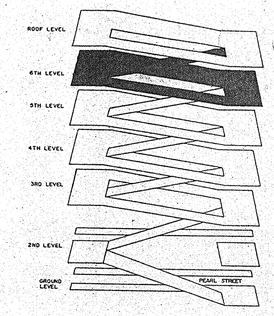

ISOMETRIC VIEW

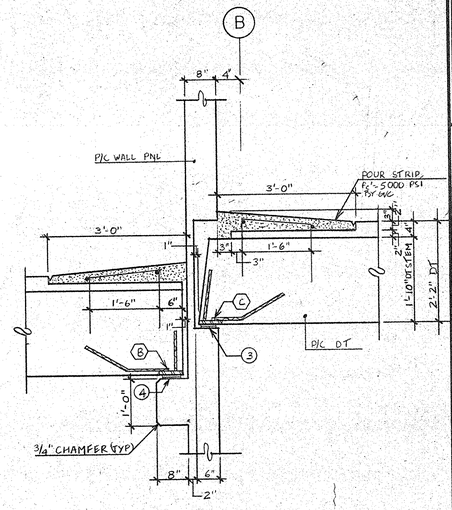

SECTION 1/E44

SEE 8/E14 FOR POUR STRIP DETAIL

APPROVED (/)
APPROVED AS CORRECTED ( )
REVISE AND RESUBMIT ( )
NOT APPROVED ( )

CHECKING IS ONLY FOR CONFORMANCE WITH THE DESIGN CONCEPT OF THE PROJECT AND COMPLIANCE WITH THE INFORMATION GIVEN IN THE CONTRACT DOCUMENTS. CONTRACTOR IS RESPONSIBLE FOR DIMENSIONS TO BE CONFIRMED AND CORRELATED AT THE JOB SITE. FOR INFORMATION THAT PERTAINS SOLELY TO THE FABRICATION PROCESSES OR TO TECHNIQUE OF CONSTRUCTION, AND FOR COORDINATION OF THE WORK OF ALL TRADES.

UNIVERSITY OF MARYLAND AT BALTIMORE
OFFICE OF FACILITIES MANAGEMENT

DATE 5/27/87 BY [signature]

RTKL Associates Inc.

Approval is for design only. Contractor is responsible for dimensions, quantities and coordination with other trades. Approval does not substitute changes to contract requirements unless authorized by a Change Order.

☑ Approved ☐ Disapproved
☐ Approved as noted ☐ Returned for correction
☐ Reviewed ☐ Receipted
By: [illegible] Date: 5.27.87
☐ Architectural ☑ Engineering

SHEET NOTES

1. SEE SHEET E-25 FOR ACCESSORY KEY, ERECTION NOTES, GENERAL NOTES, ABBREVIATIONS, AND PRODUCT CONCRETE STRENGTH.
2. ALL DECK ELEVATIONS OCCUR ON TOP OF 4" FLANGE AT THE COLUMN CENTER LINES U.N.O.
3. [H] DENOTES DT BRG ON WALL PANEL OR SPDL HAUNCH.
4. [P] DENOTES DT BRG ON WALL PANEL POCKET.

RECORD DRAWING
DATE: 5/6/88


NO	DATE	REVISION/ACTION	BY
2	11-24-86	REVISED PER APPROVED DRAWINGS DATED 9-26-86 & 10-31-86. RESUBMITTED FOR FINAL APPROVAL	GAH
1	5-15-86	SENT TO ROCKVILLE FOR APPROVAL	GAH

1018-33

CONCRETE BUILDING SYSTEMS

PROJECT: PEARL STREET GARAGE
BALTIMORE, MARYLAND
GENERAL CONTRACTOR: J. VINTON SCHAFER & SONS
ARCHITECT: RTKL
DRAWING TITLE: SIXTH LEVEL FRAMING PLAN

DRAWN: 5-13-86 BY GAH
CHECKED: 5-13-86 BY GAH
APPROVED: BY
PROJECT NO. 6003
DWG. NO. E-4a

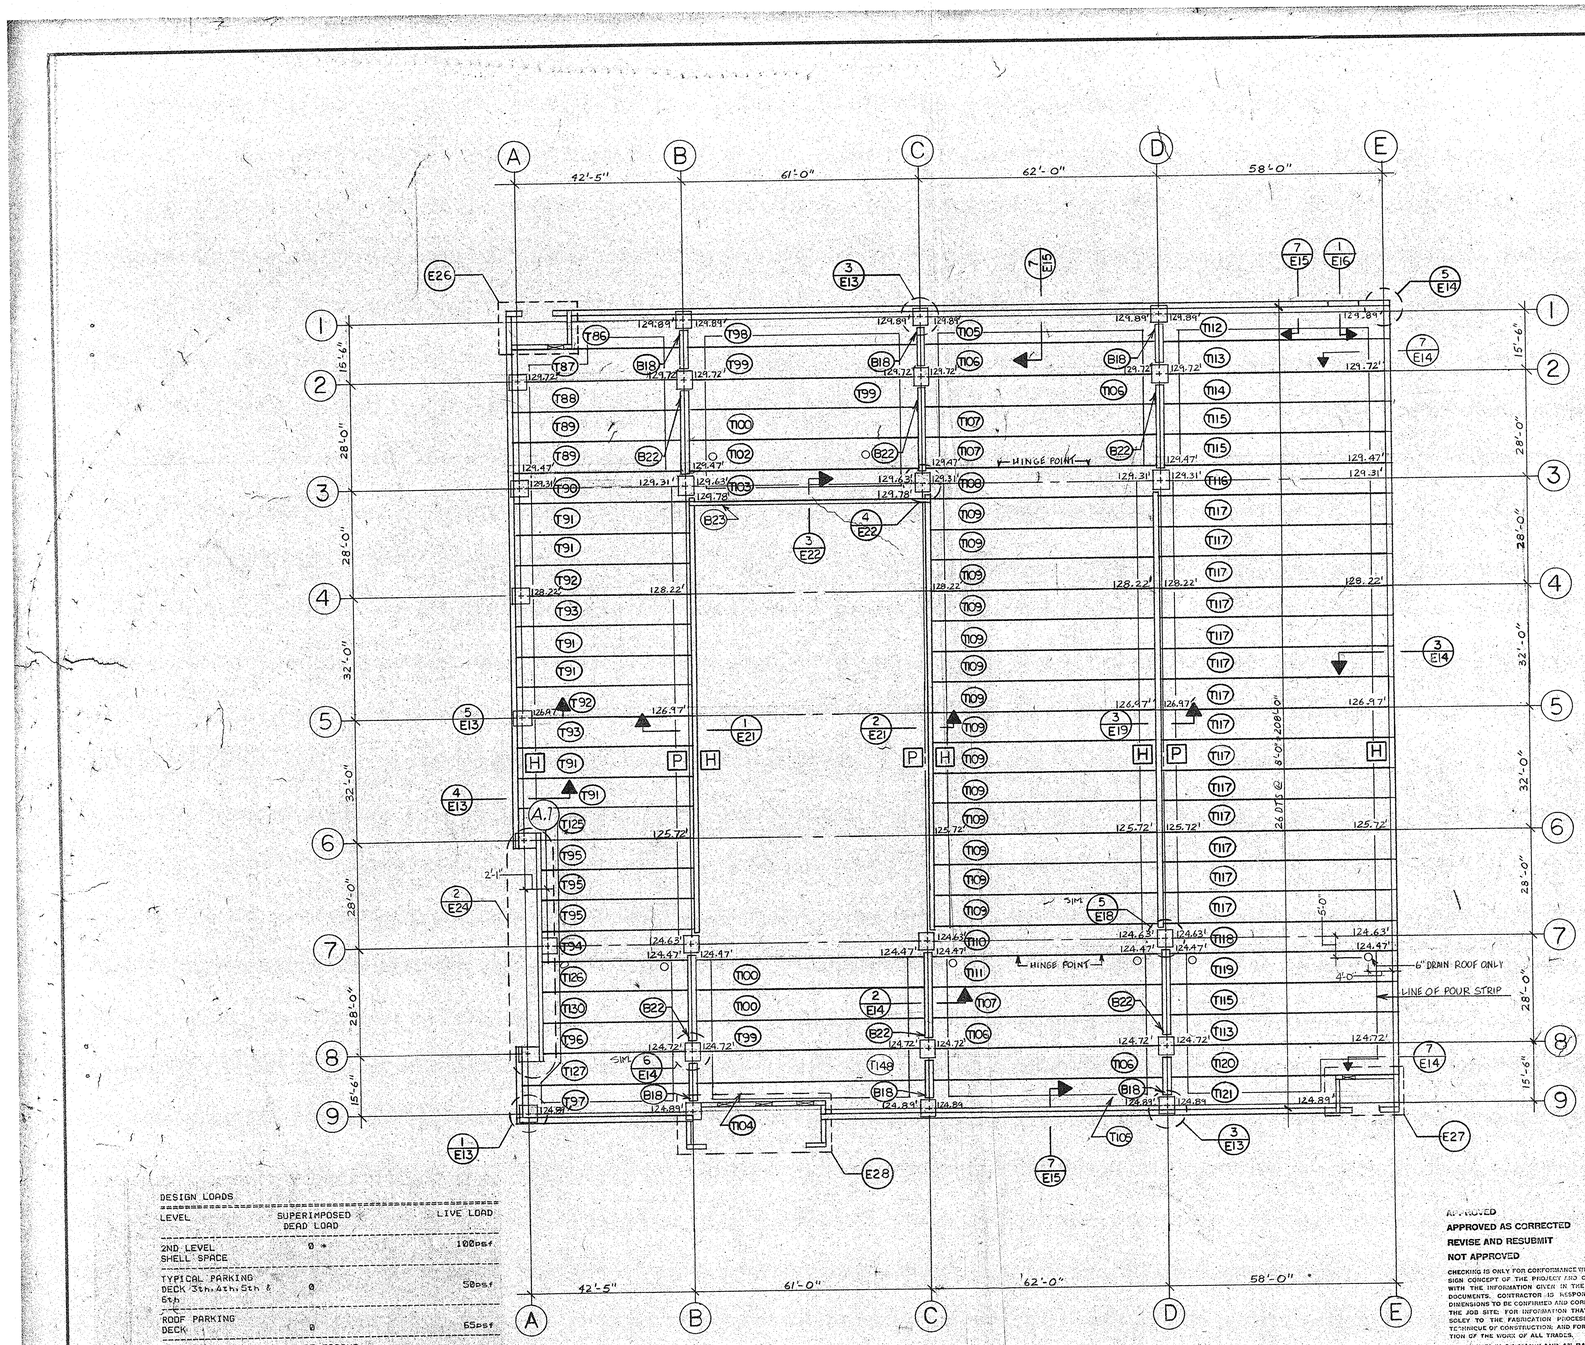


ROOF LEVEL FRAMING PLAN

N


DESIGN LOADS

LEVEL	SUPERIMPOSED DEAD LOAD	LIVE LOAD
2ND LEVEL SHELL SPACE	0 *	100psf
TYPICAL PARKING DECK 3th, 4th, 5th & 6th	0	50psf
ROOF PARKING DECK	0	65psf


* NOT INCLUDING 2" FUTURE TOPING

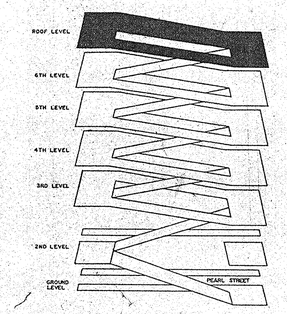


ISOMETRIC VIEW N

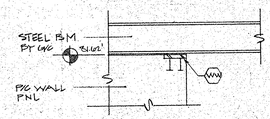


SECTION 1/E5

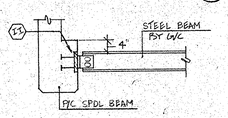

SECTION 2/E5

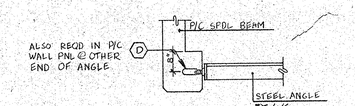

SECTION 3/E5

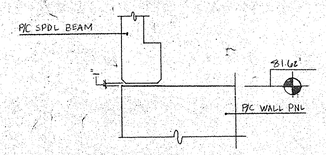

SECTION 4/E5

31.62 ELEVATION IS TYP FOR ALL WALL PNLS IN DETAILS 1, 2, & 3 ON SHT E-3

RECORD DRAWING
DATE: 5/2/88

J. Vinton Schafer & Sons

10/87

NO.	DATE	REVISION/ACTION	BY
6	8-26-86	REVISED PER APPROVED DRAWINGS DATED 8-26-86 & 10-1-86. RESUBMITTED FOR FINAL APPROVAL	MO
1	5-15-86	SENT TO DOT/SHA FOR APPROVAL	GAH

APPROVED (✓)
APPROVED AS CORRECTED ( )
REVISE AND RESUBMIT ( )
NOT APPROVED ( )

CHECKING IS ONLY FOR CONFORMANCE WITH THE DESIGN CONCEPT OF THE PROJECT AND COMPLIANCE WITH THE INFORMATION GIVEN IN THE CONTRACT DOCUMENTS. CONTRACTOR IS RESPONSIBLE FOR DIMENSIONS TO BE CONFIRMED AND CORRELATED AT THE JOB SITE; FOR INFORMATION THAT PERTAINS SOLELY TO THE FABRICATION PROCESSES OR TO TECHNIQUE OF CONSTRUCTION; AND FOR COORDINATION OF THE WORK OF ALL TRADES.

UNIVERSITY OF MARYLAND AT BALTIMORE
OFFICE OF FACILITIES MANAGEMENT
DATE 5/27/87 BY

SHEET NOTES:

1. SEE SHEET E-25 FOR ACCESSORY KEY, ERECTION NOTES, GENERAL NOTES, ABBREVIATIONS, AND PRODUCT CONCRETE STRENGTH.
2. ALL DECK ELEVATIONS OCCUR ON TOP OF 4" FLANGE AT THE COLUMN CENTER LINES U.N.O.
3. [H] DENOTES DT BRG ON WALL PANEL OR SPDL HAUNCH.
4. [P] DENOTES DT BRG ON WALL PANEL POCKET.

ATKL Associates Inc.


Approval is for design only. Contractor is responsible for dimensions, quantities and coordination with other trades. Approval does not authorize changes to contract requirements unless countersigned by a Change Order.

- ✓ Approved — Disapproved
- Approved as noted — Returned for correction
- Reviewed — Marked
- By: T.K.T — Date: 12.87
- Architectural — ✓ Engineering

CONCRETE BUILDING SYSTEMS
P.O. BOX 438, DELMAR, DEL. 19940 302-846-3645

PROJECT: PEARL STREET GARAGE
BALTIMORE, MARYLAND
GENERAL CONTRACTOR: J. VINTON SCHAFER & SONS
ARCHITECT: RTKL
DRAWING TITLE: ROOF LEVEL FRAMING PLAN

DRAWN: 8-8-86 BY JBE
CHECKED: 4-13-87 BY GAH
APPROVED: BY
PROJECT NO: 6003
DWG. NO: E-6

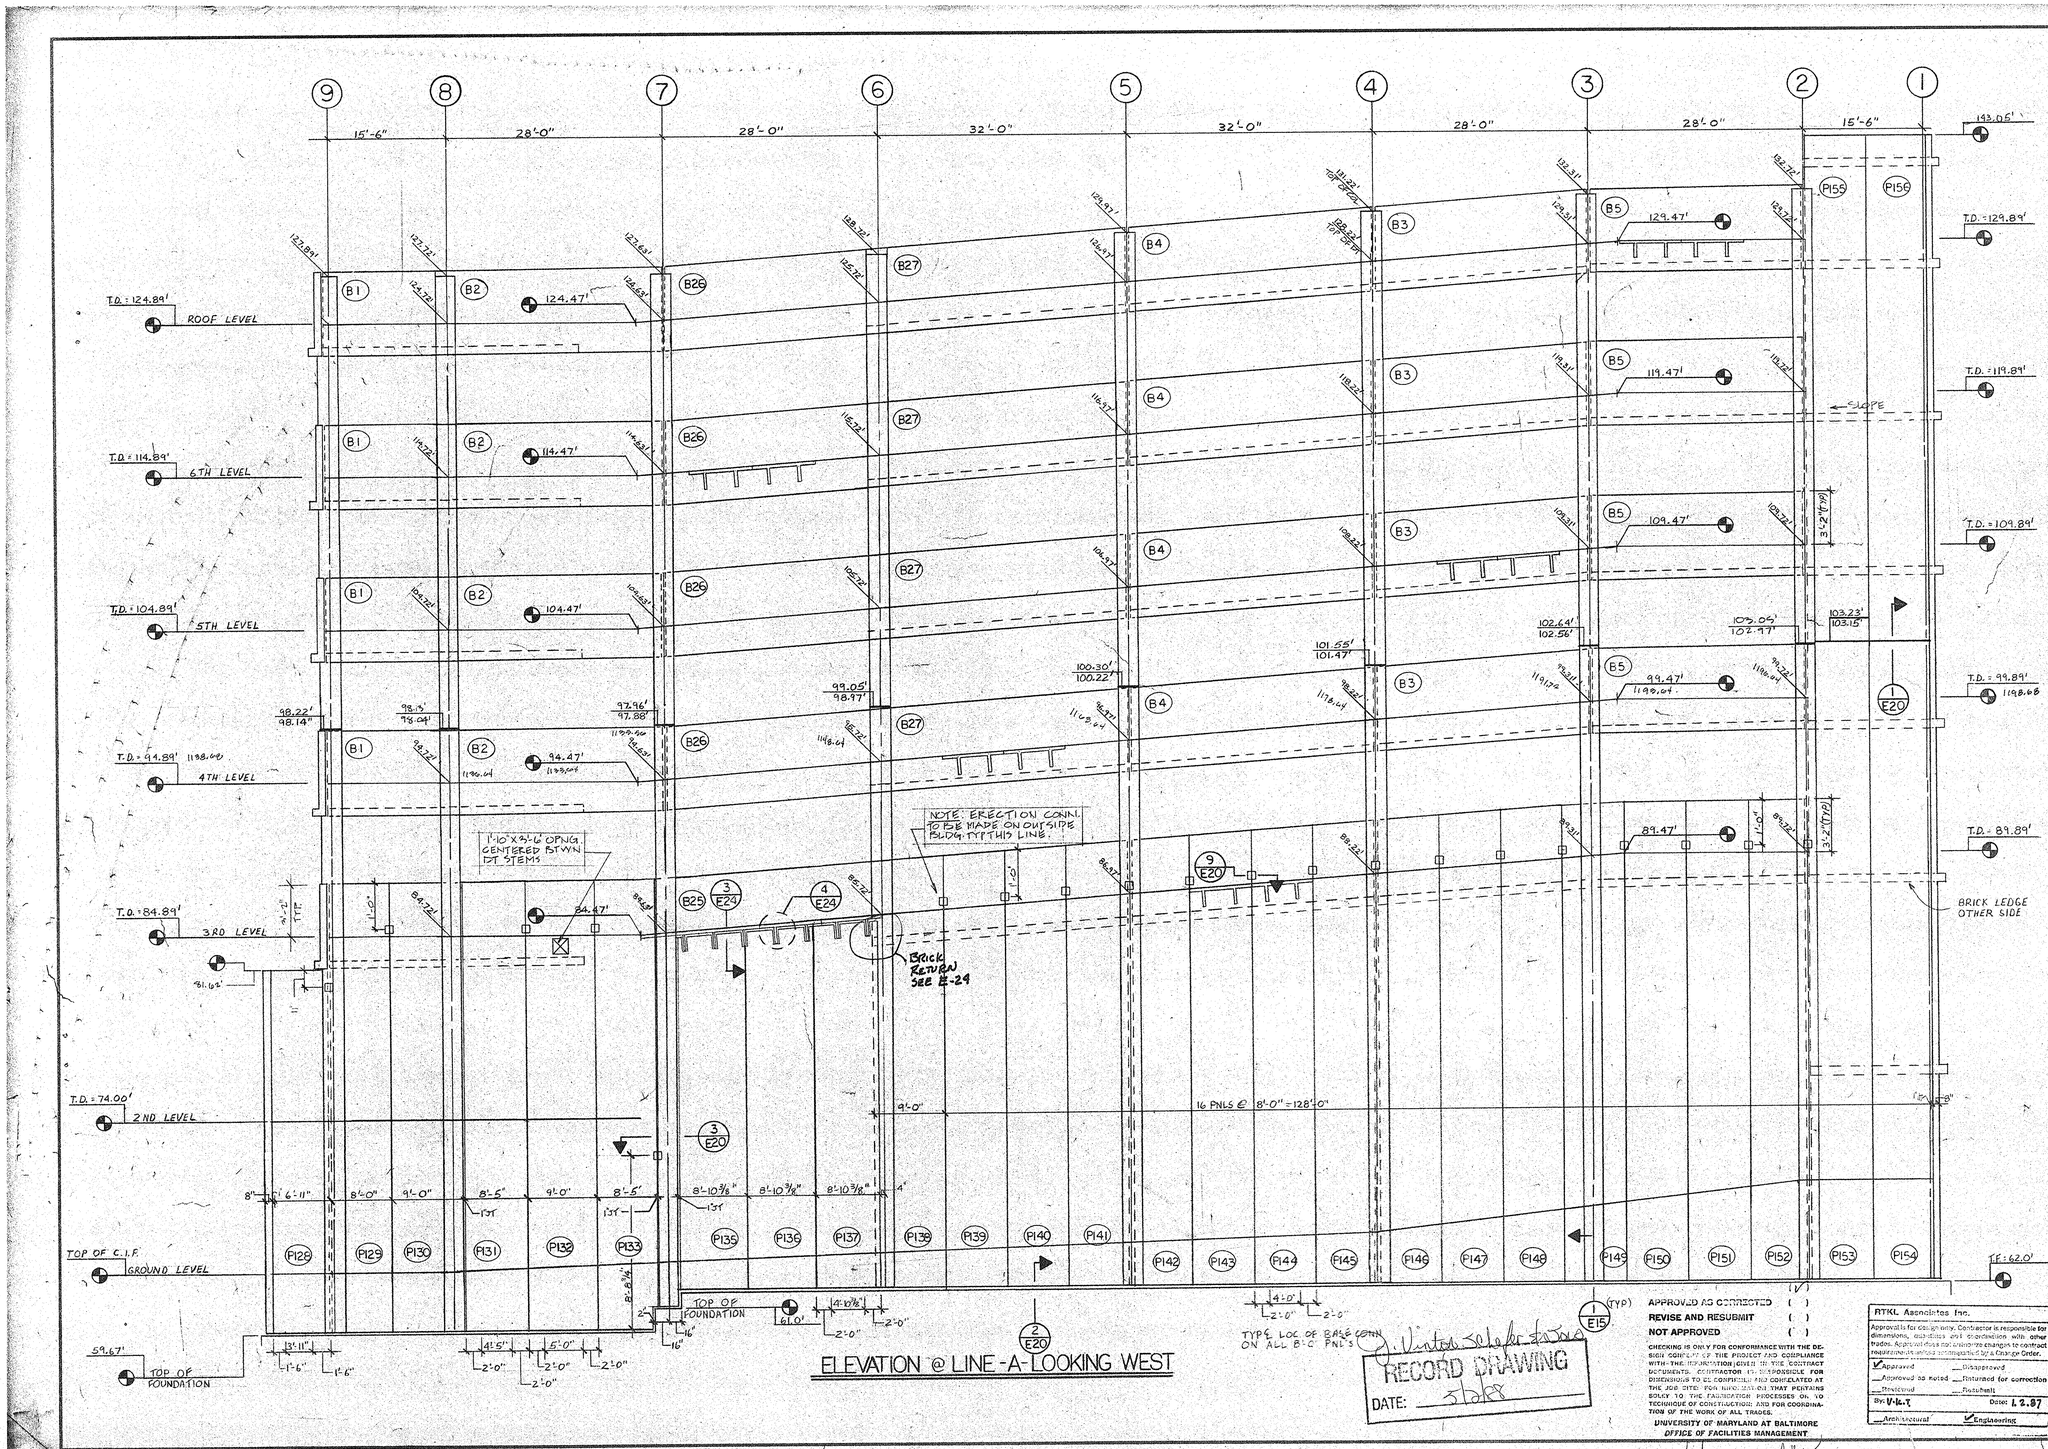

NO.	DATE	REVISION/ACTION	BY
1	12-15-86	SENT TO GC/ARCH FOR APPROVAL	JWM
2	1-28-87	REVISED PER APPROVED DRAWINGS DATED 3-20-86 & 11-21-86. RESUBMITTED FOR FINAL APPROVAL	JWM

RECORD DRAWING
DATE: 5/28/87

APPROVED AS CORRECTED ( )
REVISE AND RESUBMIT ( )
NOT APPROVED ( )

CHECKING IS ONLY FOR CONFORMANCE WITH THE DESIGN CONCEPT OF THE PROJECT AND COMPLIANCE WITH THE INFORMATION GIVEN IN THE CONTRACT DOCUMENTS. CONTRACTOR IS RESPONSIBLE FOR DIMENSIONS TO BE CONFIRMED AND CORRELATED AT THE JOB SITE; FOR INFORMATION THAT PERTAINS SOLELY TO THE FABRICATION PROCESSES OR TO TECHNIQUE OF CONSTRUCTION; AND FOR COORDINATION OF THE WORK OF ALL TRADES.

UNIVERSITY OF MARYLAND AT BALTIMORE
OFFICE OF FACILITIES MANAGEMENT

DATE 5/27/87 BY

RTKL Associates Inc.

Approval is for design only. Contractor is responsible for dimensions, quantities and coordination with other trades. Approval does not authorize changes to contract requirements unless incorporated by a Change Order.

☑ Approved ☐ Disapproved
☐ Approved as noted ☐ Returned for correction
☐ Resubmit
By V.W.T. Date 1.2.87
☐ Announcement ☑ Engineering

PCI CERTIFIED PLANT

CONCRETE BUILDING SYSTEMS
P.O. BOX 68, DELAWARE, OHIO 43015
614/369-4431 302/846-3645

PROJECT: PEARL STREET GARAGE
BALTIMORE, MARYLAND

GENERAL CONTRACTOR: J. VINTON SCHAFER & SONS
ARCHITECT: RTKL
DRAWING TITLE: ELEVATION AT LINE A

DRAWN: 8-8-86 BY JWM
CHECKED: 11-19-86 BY GAM
APPROVED: BY
PROJECT NO. 6003
DWG. NO. E-6

ELEVATION @ LINE-B-LOOKING WEST N.T.S.

NO.	DATE	REVISION/ACTION	BY
1	5-15-87	SENT TO GC/ARCH. FOR APPROVAL	GAH
2	11-25-87	REVISED PER APPROVED DRAWINGS DATED 11-24-87 + 12-1-87 — RESUBMITTED FOR FINAL APPROVAL.	GAH

PROJECT: PEARL STREET GARAGE
BALTIMORE, MARYLAND

GENERAL CONTRACTOR: J. VINTON SCHAFER & SONS
ARCHITECT: RTKL

DRAWING TITLE: ELEVATION AT LINE B

DRAWN: 5-15-87 BY: GAH
CHECKED: BY:
APPROVED: BY:
PROJECT NO: 6003
DWG. NO. E-7

CONCRETE BUILDING SYSTEMS
P.O. BOX 48, DELMAR, DEL. 19940 302-846-3545

PCI CERTIFIED PLANT


APPROVED ( )
APPROVED AS CORRECTED ( )
REVISE AND RESUBMIT ( )
NOT APPROVED ( )

CHECKING IS ONLY FOR CONFORMANCE WITH THE DESIGN CONCEPT OF THE PROJECT AND COMPLIANCE WITH THE INFORMATION GIVEN IN THE CONTRACT DOCUMENTS. CONTRACTOR IS RESPONSIBLE FOR DIMENSIONS TO BE CONFIRMED AND CORRELATED AT THE JOB SITE; FOR INFORMATION THAT PERTAINS SOLELY TO THE FABRICATION PROCESSES OR TO TECHNIQUE OF CONSTRUCTION; AND FOR COORDINATION OF THE WORK OF ALL TRADES.

UNIVERSITY OF MARYLAND AT BALTIMORE
DIVISION OF FACILITIES MANAGEMENT
DATE 5/27/87 BY

RECORD DRAWING
DATE: 5/2/88

RTKL Associates Inc.
Approval is for design only. Contractor is responsible for dimensions, clearances and coordination with other trades. Approval does not relieve the drawings to contract requirements unless such compliance is by a Change Order.
☑ Approved ☐ Disapproved
☐ Approved as noted ☐ Returned for correction
☐ Reviewed ☐ Resubmit
By: Date: 1.9.87
☐ Architectural ☑ Engineering

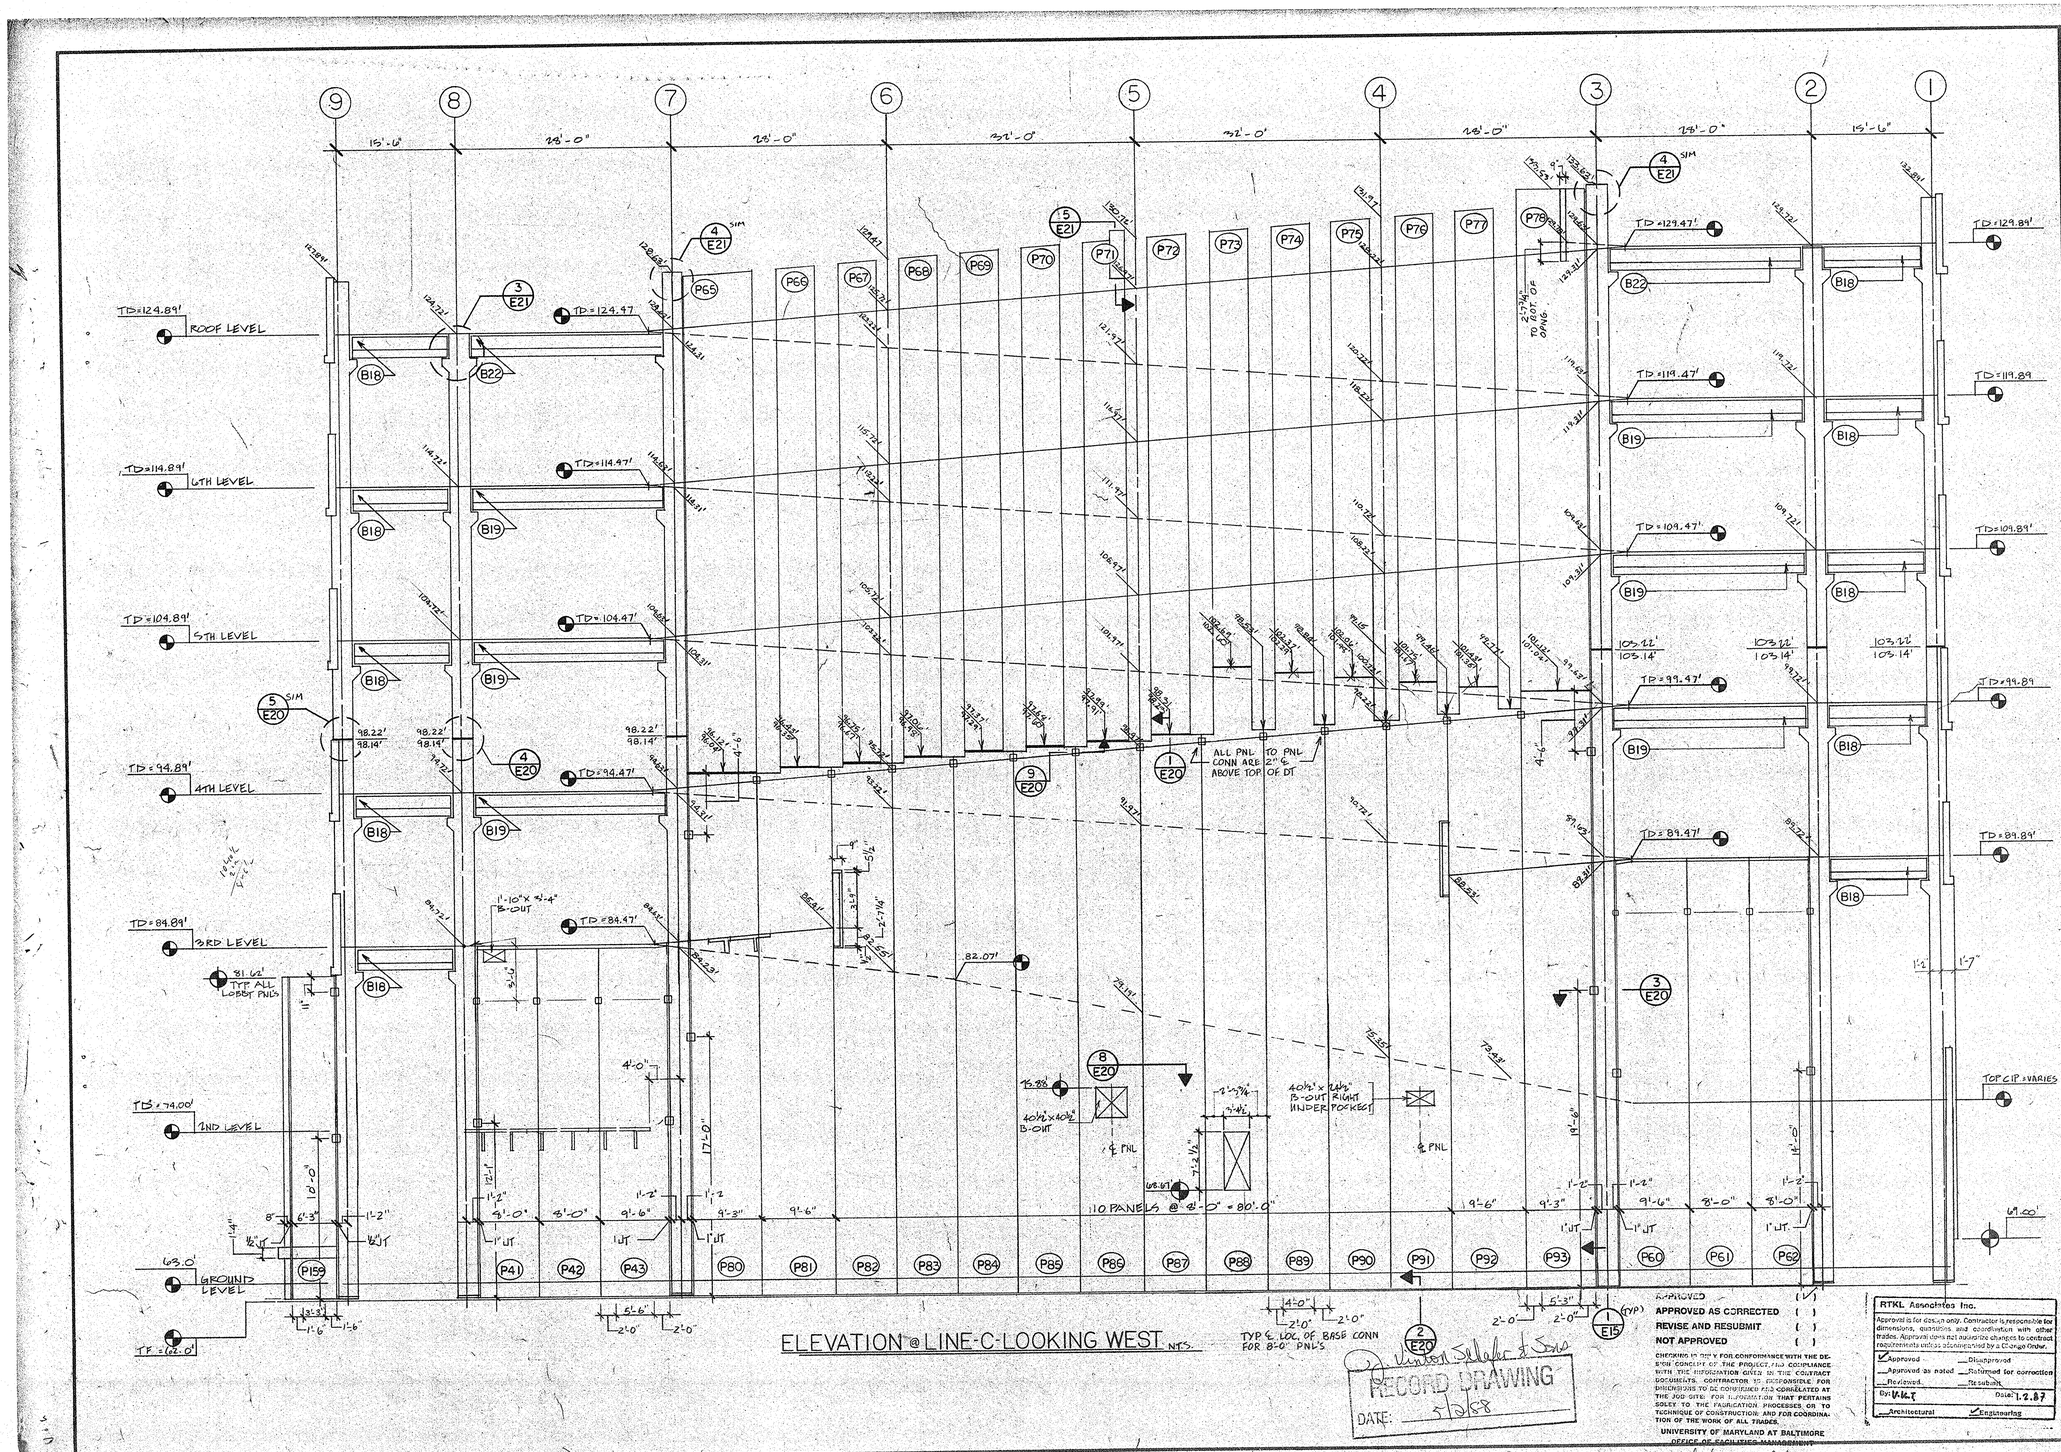

ELEVATION @ LINE-C-LOOKING WEST NTS.

NO.	DATE	REVISION/ACTION
2	11-26-86	REVISED PER APPROVED DRAWINGS DATED 11-26-86, RESUBMITTED FOR FINAL APPROVAL
1	9-15-86	SENT TO ISC/ARCH FOR APPROVAL

PCI CERTIFIED PLANT

CONCRETE BUILDING SYSTEMS
ICS LOCKHEED BLVD. DEL. 19940 302-846-3645

PROJECT: PEARL STREET GARAGE
BALTIMORE, MARYLAND

GENERAL CONTRACTOR: J. VINTON SCHAFER & SONS
ARCHITECT: RTKL
DRAWING TITLE: ELEVATION AT LINE C

DRAWN: 9-15-86 BY GAH
CHECKED: 9-15-86 BY GAH
APPROVED: BY
PROJECT NO: 6003
DWG NO. E-8

APPROVED ( )
APPROVED AS CORRECTED ( )
REVISE AND RESUBMIT ( )
NOT APPROVED ( )

CHECKING IS ONLY FOR CONFORMANCE WITH THE DESIGN CONCEPT OF THE PROJECT AND COMPLIANCE WITH THE INFORMATION GIVEN IN THE CONTRACT DOCUMENTS. CONTRACTOR IS RESPONSIBLE FOR DIMENSIONS TO BE CONFIRMED AND CORRELATED AT THE JOB SITE. FOR FABRICATION THAT PERTAINS SOLELY TO THE FABRICATION PROCESSES, OR TO TECHNIQUE OF CONSTRUCTION AND FOR COORDINATION OF THE WORK OF ALL TRADES.

UNIVERSITY OF MARYLAND AT BALTIMORE
OFFICE OF FACILITIES MANAGEMENT
DATE 5/27/87 DHH

RTKL Associates Inc.
Approval is for design only. Contractor is responsible for dimensions, quantities, and coordination with other trades. Approval does not authorize changes to contract requirements unless countersigned by a Change Order.
☑ Approved ☐ Disapproved
☐ Approved as noted ☐ Returned for correction
☐ Reviewed. ☐ Resubmit
By: [illegible] Date: 1.2.87
☐ Architectural ☑ Engineering

RECORD DRAWING
DATE: 5/28/87

J. Vinton Schafer & Sons

10/87

NO.	DATE	REVISION/ACTION	BY
1	4-12-88	SENT TO GC/RACK FOR APPROVAL	GAH
2	4-28-88	REVISED PER APPROVED DRAWINGS DATED 9-24-86 & 10-1-86. RESUBMITTED FOR FINAL APPROVAL.	

PGI CERTIFIED PLANT

CONCRETE BUILDING SYSTEMS

GENERAL CONTRACTOR: J. VINTON SCHAEFER & SONS
ARCHITECT: RTKL
DRAWING TITLE: ELEVATION AT LINE D

PROJECT: PEARL STREET GARAGE
BALTIMORE, MARYLAND


DRAWN: 9-15-86 BY GAH
CHECKED: 9-15-86 BY GAH
APPROVED: BY
PROJECT NO. 6003
DWG NO. E-9

RTKL Associates Inc.
Reviewed for conformance with design concept and compliance with information given in the Contract Documents. Contractor is responsible for dimensions, construction means, methods, techniques, coordination and safety precautions. Review does not relieve Contractor from responsibility for errors or omissions in Shop Drawings.
☐ Approved ☐ Disapproved
☐ Approved as noted ☐ Returned for corrections
☐ Resubmit ☐ Received
By: Date: 4.28.88
☐ Architectural ☐ Engineering

APPROVED AS CORRECTED
APPROVED
REVISE AND RESUBMIT
NOT APPROVED
- CHECKING IS ONLY FOR CONFORMANCE WITH THE DESIGN CONCEPT OF THE PROJECT AND COMPLIANCE WITH THE INFORMATION GIVEN IN THE CONTRACT DOCUMENTS. DIMENSIONS SHOWN ON SHOP DRAWINGS ARE TO BE CONFIRMED AND CORRELATED AT THE JOB SITE. FOR INFORMATION THAT PERTAINS SOLELY TO THE FABRICATION PROCESSES OF THE CONTRACTOR'S TECHNIQUE OF CONSTRUCTION, AND FOR COORDINATION OF THE WORK WITH THAT OF ALL OTHER TRADES.
THE CONTRACTOR SHALL MAKE ALL CORRECTIONS NOTED HEREON
OFFICE OF FACILITIES MANAGEMENT
UNIVERSITY OF MARYLAND AT BALTIMORE
By: Date: 4.28.88

RECORD DRAWING
DATE: 5/2/88

ELEVATION @ LINE-D-LOOKING WEST

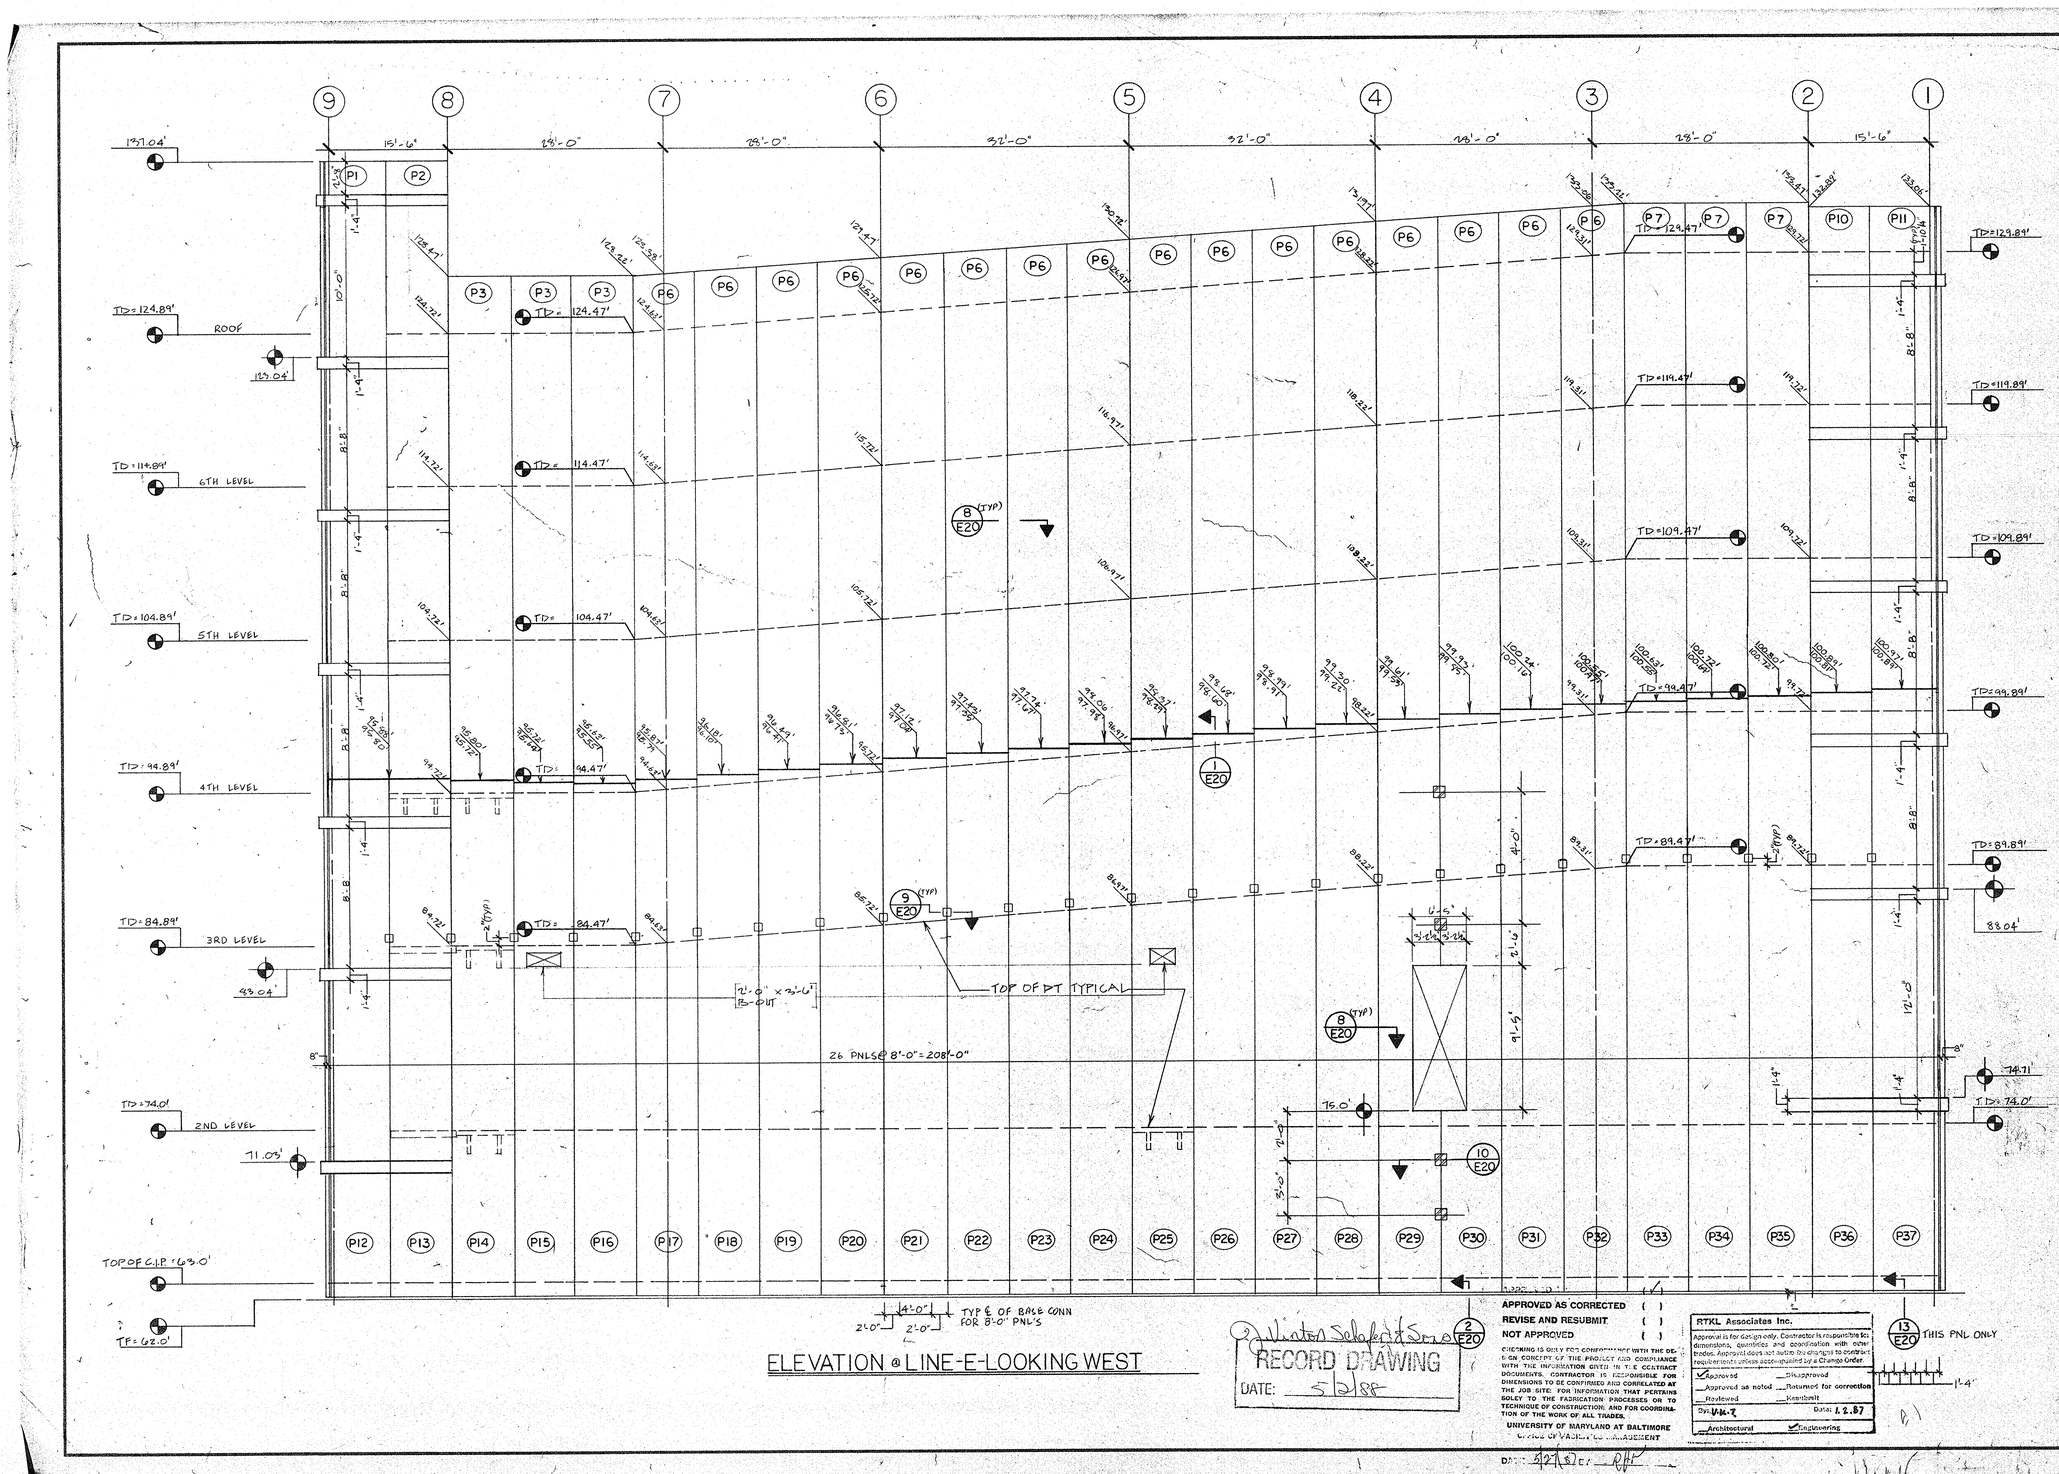

ELEVATION @ LINE-E-LOOKING WEST

RECORD DRAWING
DATE: 5/2/88

APPROVED AS CORRECTED ( )
REVISE AND RESUBMIT ( )
NOT APPROVED ( )

CHECKING IS ONLY FOR CONFORMANCE WITH THE DESIGN CONCEPT OF THE PROJECT AND COMPLIANCE WITH THE INFORMATION GIVEN IN THE CONTRACT DOCUMENTS. CONTRACTOR IS RESPONSIBLE FOR DIMENSIONS TO BE CONFIRMED AND CORRELATED AT THE JOB SITE; FOR INFORMATION THAT PERTAINS SOLELY TO THE FABRICATION PROCESSES OR TO TECHNIQUE OF CONSTRUCTION; AND FOR COORDINATION OF THE WORK OF ALL TRADES.

UNIVERSITY OF MARYLAND AT BALTIMORE
OFFICE OF FACILITIES MANAGEMENT

DATE: 5/2/88 BY: RHF

RTKL Associates Inc.
Approval is for design only. Contractor is responsible for: dimensions, quantities and coordination with other trades. Approval does not relieve this drawing of its compliance requirements unless approved by a Change Order.
☑ Approved ___ Disapproved
___ Approved as noted ___ Returned for correction
___ Reviewed ___ Resubmit
By: WHT Date: 1.2.87
___ Architectural ☑ Engineering

NO.	DATE	REVISION/ACTION	BY
1	4-25-86	REVISED PER APPROVED DRAWINGS DATED 4-14-86. RESUBMITTED FOR APPROVAL	WHT
2	11-22-86	SENT TO GC/ARCH. FOR APPROVAL	GAH

PCI CERTIFIED PLANT

CONCRETE BUILDING SYSTEMS


PROJECT: PEARL STREET GARAGE
BALTIMORE, MARYLAND

GENERAL CONTRACTOR: J. VINTON SCHAFER & SONS

ARCHITECT: RTKL

DRAWING TITLE: ELEVATION AT LINE E

DRAWN: 4-15-86 BY GAH
CHECKED: 5-13-86 BY GAH
APPROVED: BY
PROJECT NO: 6003
DWG. NO. E-10

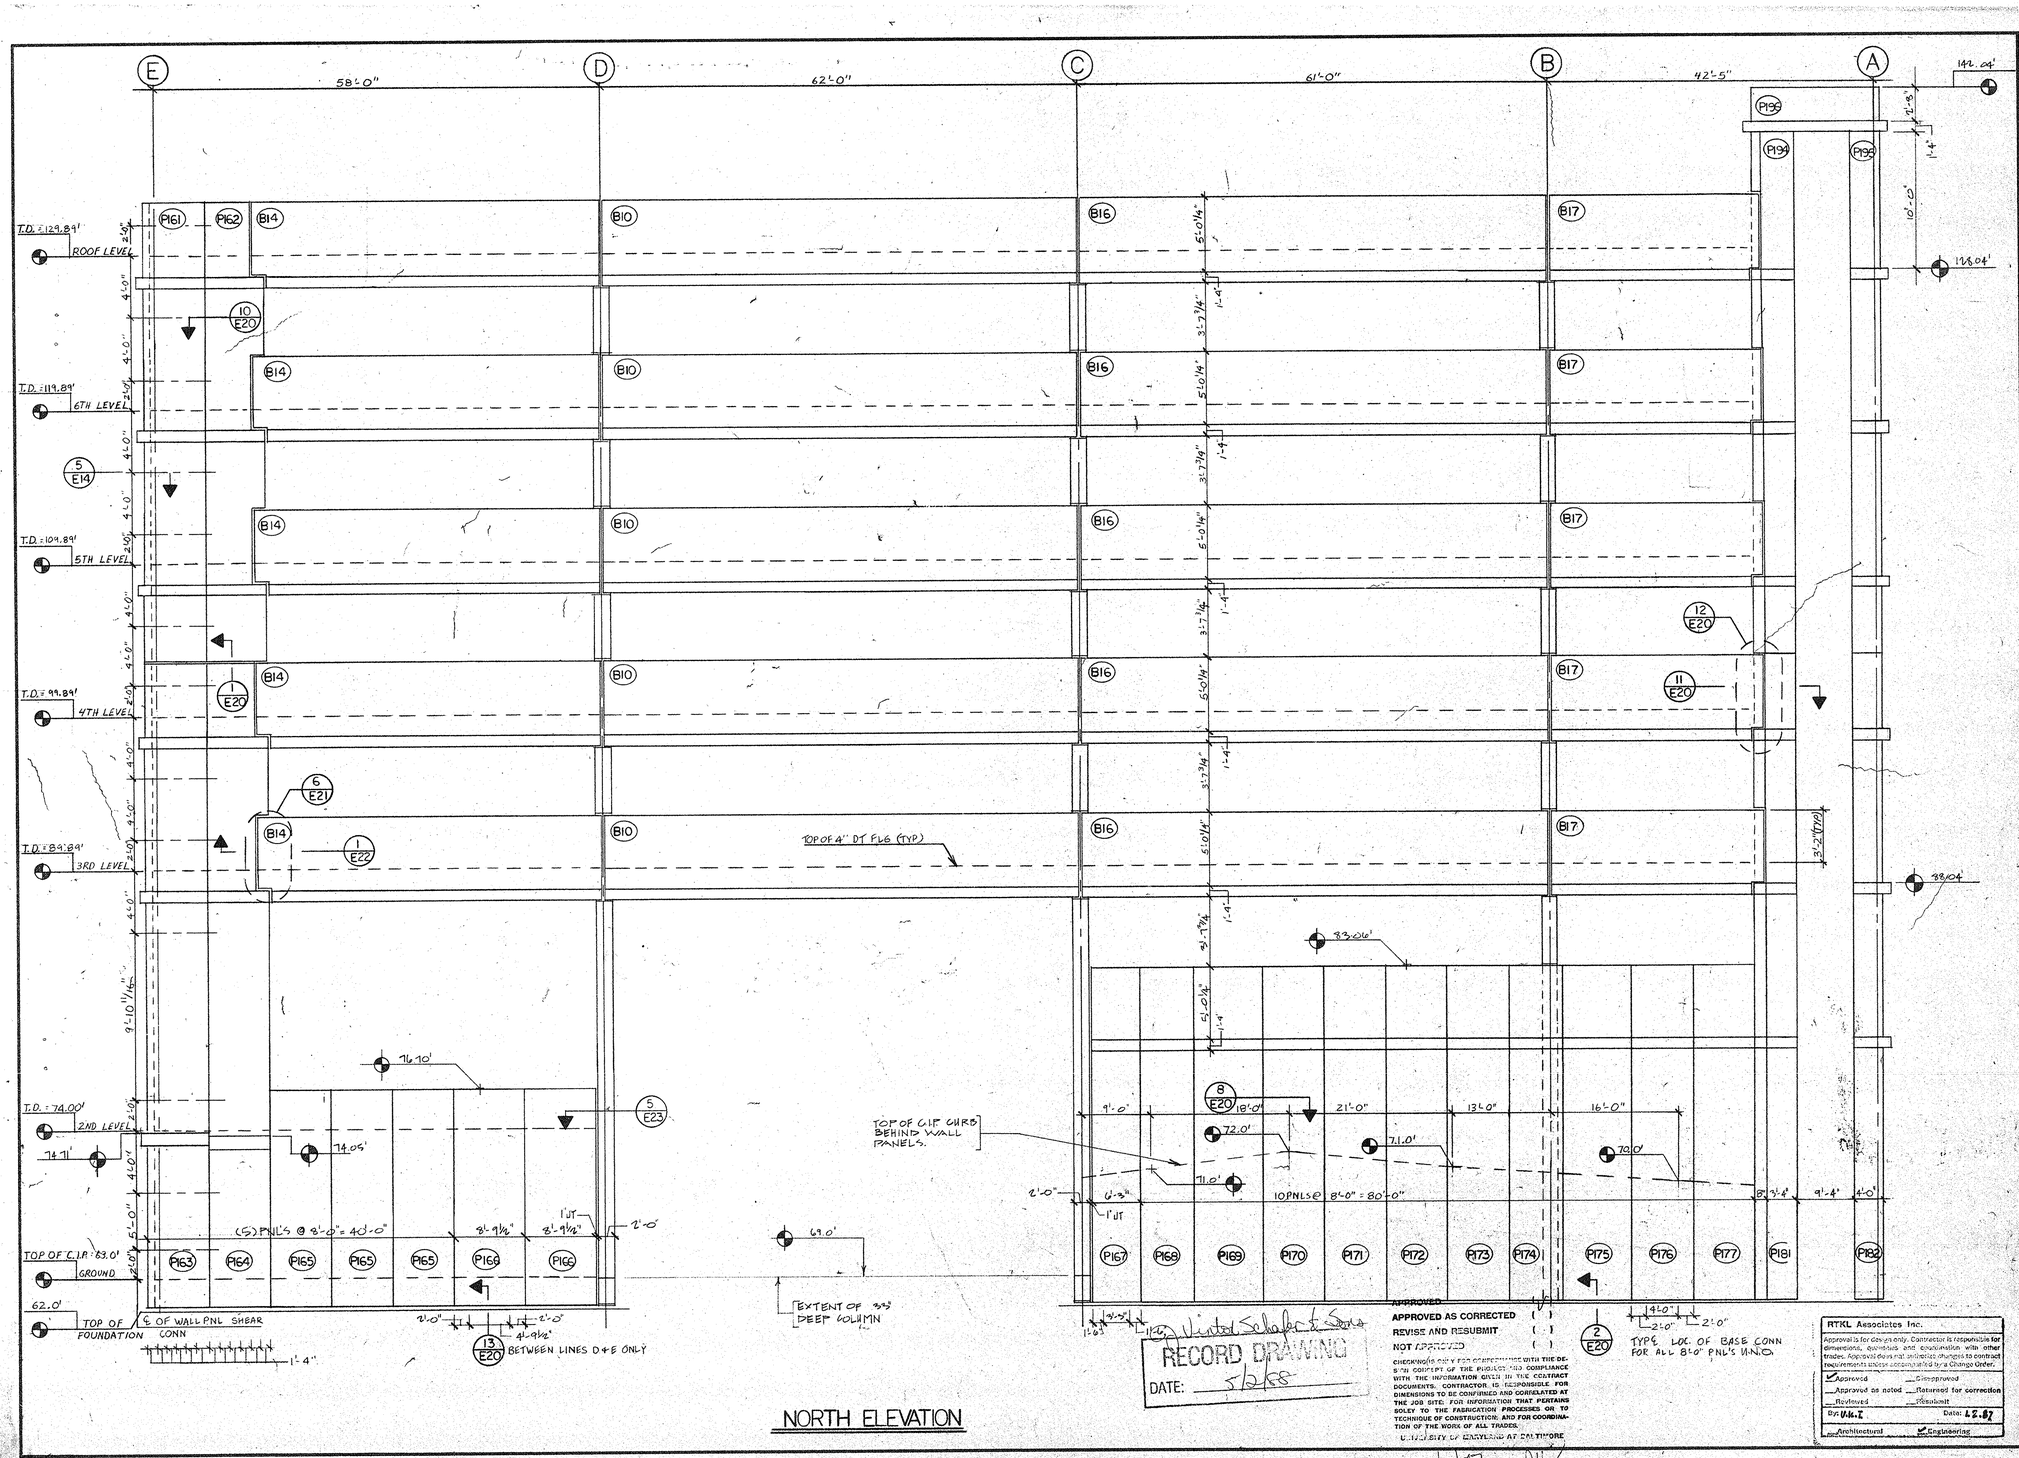

NORTH ELEVATION

NO.	DATE	REVISION/ACTION	BY
2	11-25-86	REVISED PER APPROVED DRAWINGS DATED 9-24-86 & 10-1-86. RESUBMITTED FOR FINAL APPROVAL.	GAH
1	10-15-86	SENT TO GC/AREA FOR APPROVAL	GAH

RECORD DRAWING
DATE: 5/2/88

APPROVED
APPROVED AS CORRECTED ( )
REVISE AND RESUBMIT ( )
NOT APPROVED ( )
CHECKING IS ONLY FOR CONFORMANCE WITH THE DESIGN CONCEPT OF THE PROJECT AND COMPLIANCE WITH THE INFORMATION GIVEN IN THE CONTRACT DOCUMENTS. CONTRACTOR IS RESPONSIBLE FOR DIMENSIONS TO BE CONFIRMED AND CORRELATED AT THE JOB SITE. FOR INFORMATION THAT PERTAINS SOLEY TO THE FABRICATION PROCESSES OR TO TECHNIQUE OF CONSTRUCTION; AND FOR COORDINATION OF THE WORK OF ALL TRADES.
UNIVERSITY OF MARYLAND AT BALTIMORE

RTKL Associates Inc.
Approval is for design only. Contractor is responsible for dimensions, quantities and coordination with other trades. Approval does not authorize changes to contract requirements unless accomplished by a Change Order.
Approved / Disapproved
Approved as noted / Returned for correction
Reviewed / Resubmit
By: [illegible] Date: 4.8.87
Architectural / Engineering

PCI CERTIFIED PLANT

CONCRETE BUILDING SYSTEMS
P.O. BOX 48 DELMAR, DEL. 19940 302-846-9548

PROJECT: PEARL STREET GARAGE
BALTIMORE, MARYLAND
GENERAL CONTRACTOR: J. VINTON SCHAFER & SONS
ARCHITECT: RTKL
DRAWN TITLE: NORTH ELEVATION

DRAWN: 8-8-86 BY GAH
CHECKED: 8-13-86 BY GAH
APPROVED: BY
PROJECT NO. 6003
DWG. NO. E-11

10'-8"-10"